
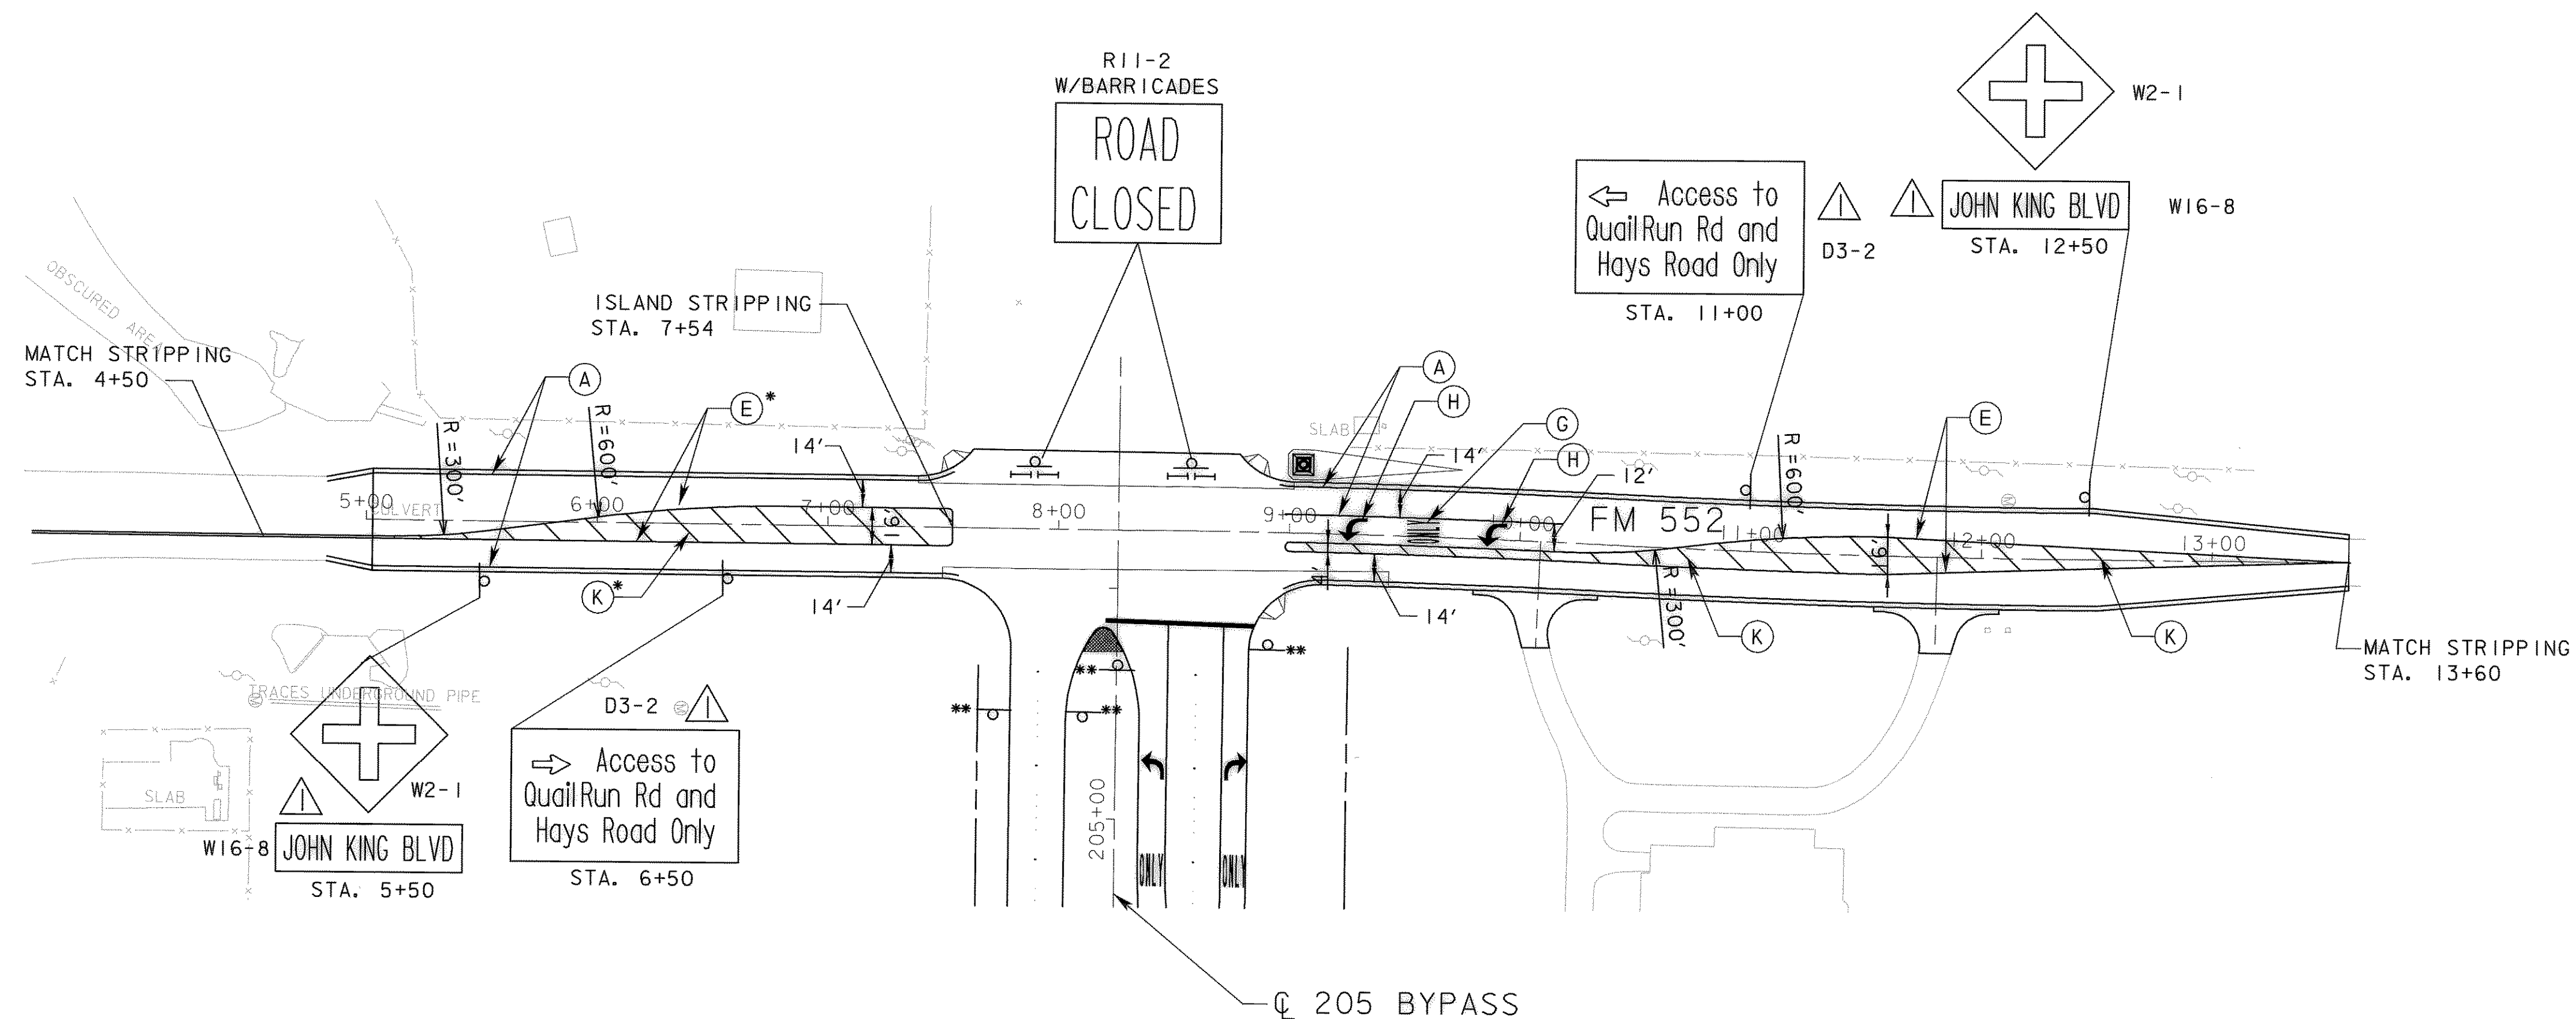


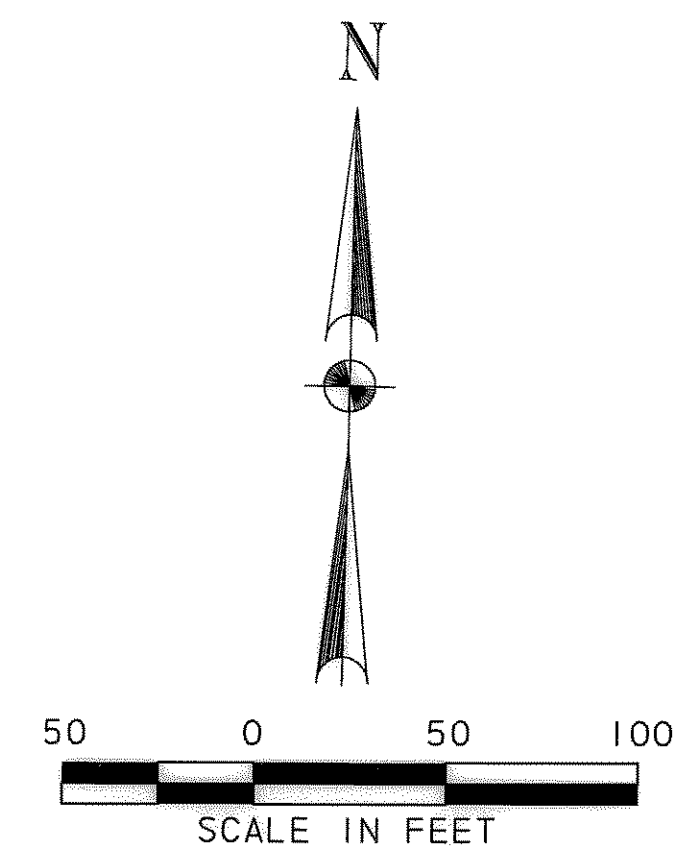

** REFER TO SIGNING & PAVEMENT MARKING LAYOUT SHEET 3 (OF 4) FOR ADDITIONAL INFORMATION.

LEGEND

- (A) 4" WHITE SOLID
- (B) WHITE BUTTON TYPE LANE LINE
SEE MISC. ROADWAY DETAIL SHEET 2 OF 2 FOR MORE INFORMATION.
- (C) WHITE BUTTON TURN BAY LINE.
SEE MISC. ROADWAY DETAIL SHEET 2 OF 2 FOR MORE INFORMATION.
- (D) 4" YELLOW SOLID
- (E) 4" DOUBLE YELLOW SOLID
- (F) 24" WHITE STOP BAR
- (G) "ONLY" WHITE
- (H) WHITE LEFT TURN ARROW
- (I) WHITE RIGHT TURN ARROW
- (J) 12" WHITE SOLID
- (K) 12" YELLOW SOLID
- (L) WHITE ARROW
- * DENOTES TEMPORARY MARKING

RECORD DRAWING

This drawing is a compilation of the original sealed engineering drawing and modifications by addenda, change orders and information furnished by the contractor. Information shown that was provided by the contractor and others not associated with the design engineer cannot be verified for accuracy or completeness. Original sealed drawing is on file at the office of AECOM USA Group, Inc., TBPE REG. NO. F-3082

ORIGINAL DRAWING
SEALED & SIGNED BY
T. H. Gaertner, P.E.
TX NO. 37124

I	ADDED OR REVISED SIGN	THG	8/12/08
NO.	REVISION	BY	DATE
 City of Rockwall, Texas			
205 BYPASS SECTION 1			
SIGNING & PAVEMENT MARKING LAYOUT			
4 OF 4			
TCB INC. AECOM WWW.TCB.AECOM.COM 17300 DALLAS PARKWAY, SUITE 1010 DALLAS, TEXAS 75248			
Unit	PW-DAL-FW	Scales	Horiz: AS SHOWN Vert: AS SHOWN
Designed	THG	Checked	TCB
Drawn	TCB	Approved	TCB
Date	11/17/2009	Project No.	60004153
		Sheet	115 of 217