


WATERLINE REPLACEMENT PROJECTS


DICKEY ST, JOE WHITE ST, NORTH GOLIAD, SOUTH GOLIAD, WILLIAMS

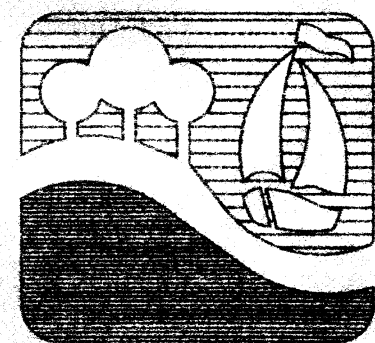

CITY OF ROCKWALL

"THE NEW HORIZON"

JANUARY 2011

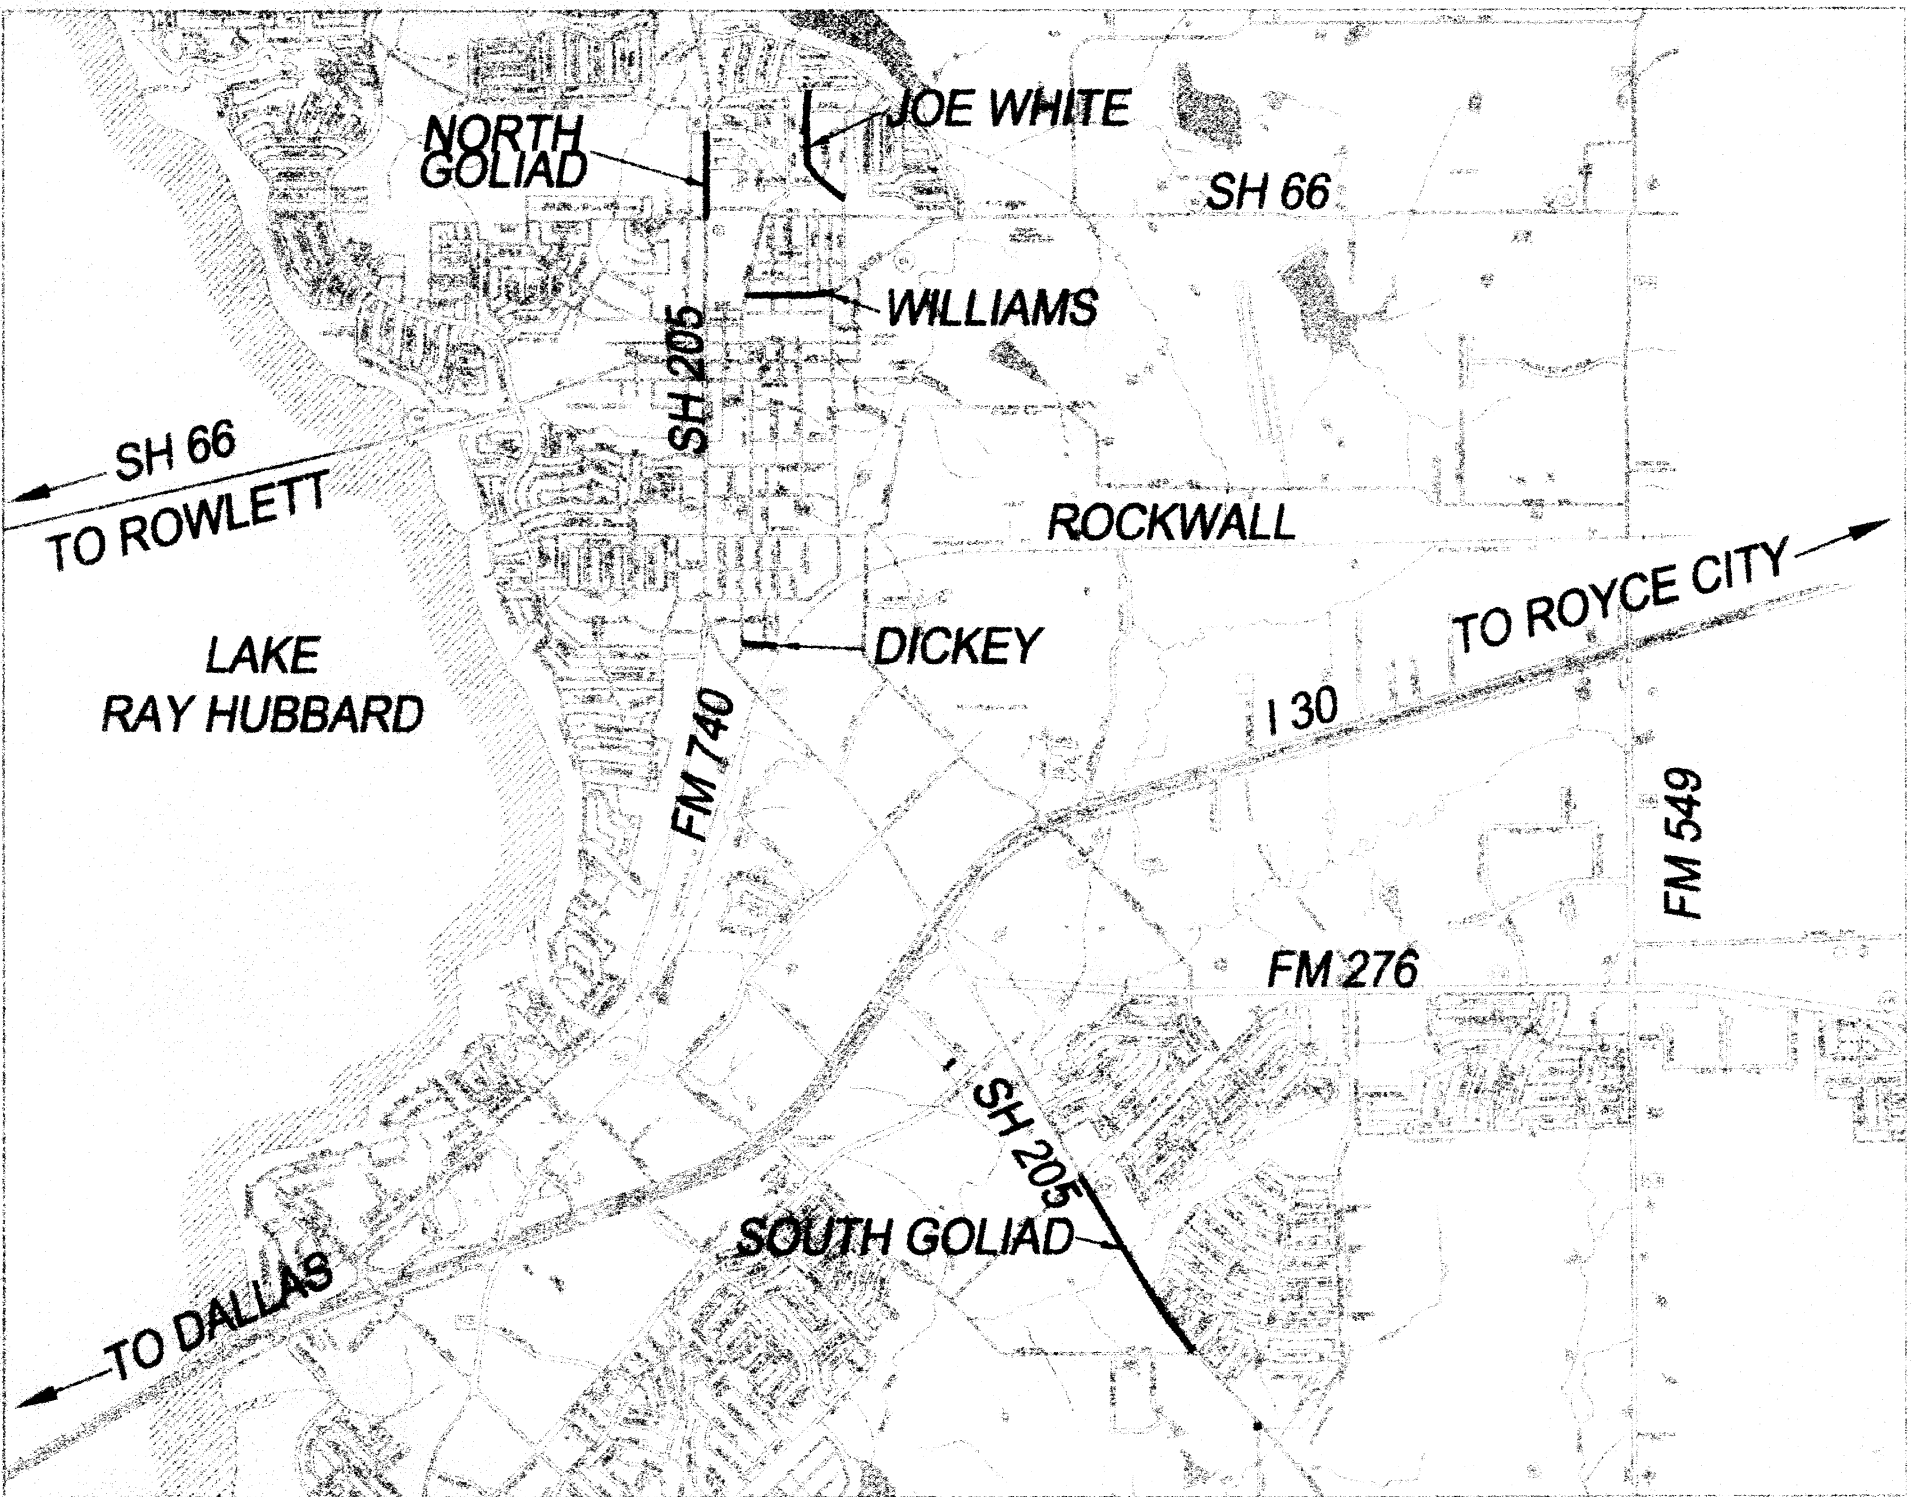


VICINITY MAP
N.T.S.

SHEET INDEX


SHEET NO.	DESCRIPTION
1	COVER SHEET
2	GENERAL NOTES
3	QUANTITY SUMMARY SHEET
4	DICKEY WATERLINE STA 0+00 TO STA 5+14
5	JOE WHITE WATERLINE STA 0+00 TO STA 10+00
6	JOE WHITE WATERLINE STA 10+00 TO STA 18+42
7	NORTH GOLIAD STA 0+00 TO STA 10+00
8	NORTH GOLIAD STA 10+00 TO STA 12+13
9	SOUTH GOLIAD STA 0+00 TO STA 10+00
10	SOUTH GOLIAD STA 10+00 TO STA 20+00
11	SOUTH GOLIAD STA 20+00 TO STA 28+75
12	KERNODLE STA 0+00 TO STA 4+80
13	WILLIAMS STA 0+00 TO STA 7+72

BILL CECIL - MAYOR
DAVID SWEET
MARK RUSSO
GLEN FARRIS - MAYOR PRO-TEM
CLIFF SEVIER
MATT SCOTT
MARGO NIELSEN
CITY COUNCIL
JULIE COUCH
CITY MANAGER
CHUCK TODD, P.E.
DIRECTOR OF PUBLIC WORKS

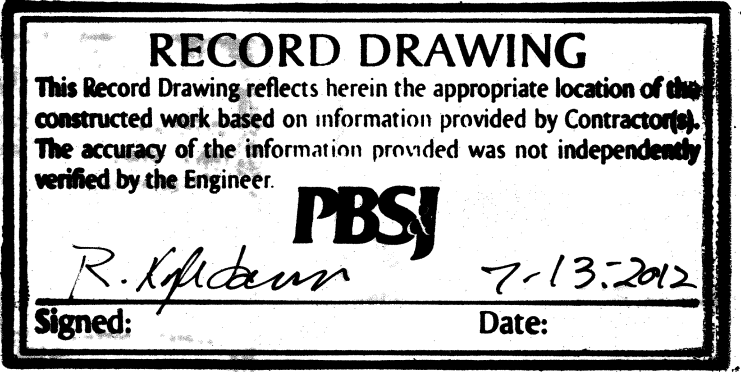

18383 PRESTON ROAD, SUITE 500
DALLAS, TEXAS 75252
972-818-7275



TBPE REG. #F-474

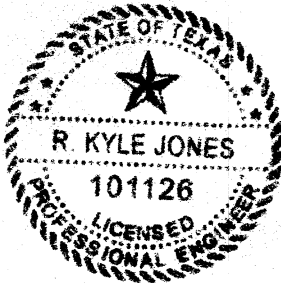

R. K. Jones, P.E.
1-13-2011

QUANTITY SUMMARY SHEET																
ITEM NO.	DESCRIPTION	UNIT			DICKEY 01	JW 01	JW 02	NG 01	NG 02	SG 01	SG 02	SG 03	KER 01	WILL 01	ACTUAL TOTAL	
	WATER UTILITIES															
300	Mobilization	LS													1	
301	6" C-900 Class 200 PVC Water Pipe	LF					10								10	
302	8" C-900 Class 200 PVC Water Pipe	LF			527	1010	843	1055	212	136	7	17	480	497	4784	
303	12" C-900 Class 200 PVC Water Pipe	LF								1000	1000	875			2875	
304	2" C-900 Class 200 PVC Water Pipe	LF											295	102	397	
305	6" Gate Valve	EA				1		1	1						3	
306	8" Gate Valve	EA			3	3	5	7	3	3	1		3	1	29	
307	12" Gate Valve	EA								2	1	1			4	
308	6" Tapping Sleeve & Valve	EA				2			1	1		1			5	
309	8" Tapping Sleeve & Valve	EA					1			2	1		2		6	
310	16"x8" Tapping Sleeve & Valve	EA							1						1	
311	Install Fire Hydrant Assembly including 6" Valve	EA			1	3	3	5	1	1			2	1	17	
312	1" Service including Metering Box and Connection to Existing Service	EA			10	20	13	7	1	3			2	4	60	
313	2" Service including Metering Box and Connection to Existing Service	EA			9								4	1	14	
314	Meter Box	EA			1	2									3	
315	Abandon Existing Valve	EA					3			3					6	
316	Connect to Existing 2" WL	EA											1		1	
317	Connect to Existing 6" WL	EA				2				1		1			4	
318	Connect to Existing 8" WL	EA			1		1	1		2			2	2	9	
319	Connect to Existing 12" WL	EA										1			1	
320	Remove Existing 12" Plug	EA										1			1	
321	Remove Existing 8" Plug	EA												1	1	
322	Bore 1" Service Line	LF			52									58	110	
323	Bore 2" WL	LF											30	42	72	
324	Bore 8" WL	LF				112	269	178	35	27			127		748	
325	Bore 12" WL	LF								227	60				287	
326	Concrete Encasement	LF							180					21	201	
327	4" Steel Encasement for 1" Service	LF												58	58	
328	6" Steel Encasement for 2" Service	LF											30	42	72	
329	16" Steel Encasement	LF						51		99	60		37		247	
330	12" CMP	LF											7		7	
331	Remove & Replace Conc Pmnt	SY			26	88	55							5	174	
332	Remove & Replace Asphalt Pmnt	SY			17				28				267		312	
333	Remove & Replace Conc Driveway Pmnt	SY			65	166	80	127	9				7	41	495	
334	Remove & Replace Exposed Aggregate	SY			10										10	
335	Remove & Replace Gravel	SY			12										12	
336	Remove & Replace Conc Sidewalk	SF				635	58	2836					102	12	3643	
337	Install 4' Conc Sidewalk	SF				285									285	
338	Remove & Replace Steps	EA						2							2	
339	Ductile Iron Fittings	TON	(lb)	(lb tot)											5.35	
	6" 90° Bend	EA	85	85					1							
	8" 11-1/4° Bend	EA	110	440			2							2		
	8" 45° Bend	EA	110	2750	6	9		10								
	8" 90° Bend	EA	125	500		1			1				2			
	12" 45° Bend	EA	200	800						2		2				
	12" 11-1/4° Bend	EA	215	215						1						
	8" x 6" Reducer	EA	95	1140		2	4	5				1				
	12" x 8" Reducer	EA	165	165						1						
	8" x 6" Tee	EA	170	1360	1	3			2				2			
	8" x 8" Tee	EA	180	900	1	1		1	1	1						
	12" x 6" Tee	EA	325	325						1						
	12" x 8" Tee	EA	340	1360						2	1	1				
	12" X 12" Tee	EA	390	390						1						
	2" Plug	EA	5	5									1			
	6" Plug	EA	25	50		2										
	8" Plug	EA	45	135	1				1	1						
	12" Plug	EA	85	85						1						
340	Trench Safety & Support	LF			527	898	584	877	177	882	947	892	323	455	6562	
341	SWPPP	LS													1	
342	Traffic Control	LS													1	



NOTE:
QUANTITIES SHOWN ARE FOR INFORMATIONAL PURPOSES ONLY.
ANY DISCREPANCIES BETWEEN THIS SHEET AND QUANTITIES
APPEARING IN THE BID PROPOSAL SHALL BE OVERRULED BY
VALUES IN THE BID PROPOSAL.

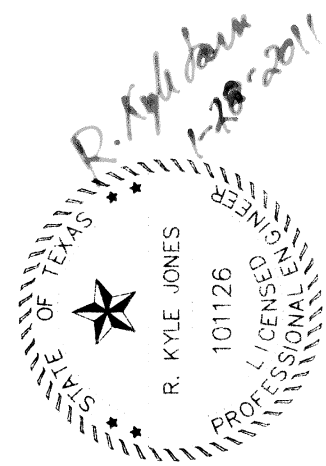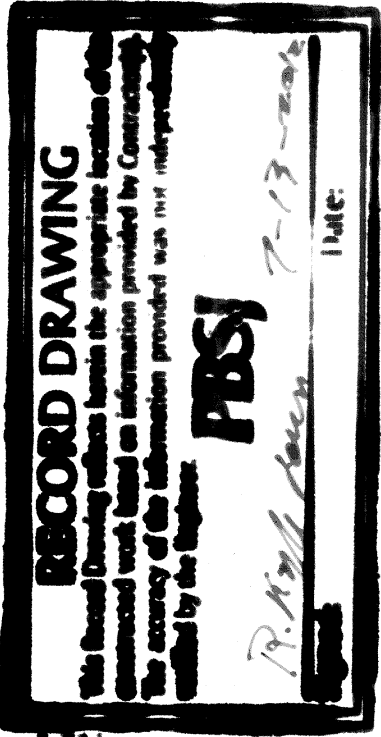

CITY OF ROCKWALL
WATERLINE REPLACEMENT PROJECTS
QUANTITY SUMMARY SHEET

DATE: 1/18/2011
BY: RKJ
REVISION: 1/18/2011
REVISED QUANTITIES: 1/18/2011
DESIGN: RKJ
DRAWN: RKJ
CHECKED: TBS
APPROVED: PBS&J

TBPE #F-474
18383 PRESTON ROAD - SUITE 500
DALLAS, TEXAS 75252
TEL: (972) 818-2275 FAX: (972) 880-2809
PBS&J JOB NO. 100010908
DATE: JANUARY 2011
FILE:

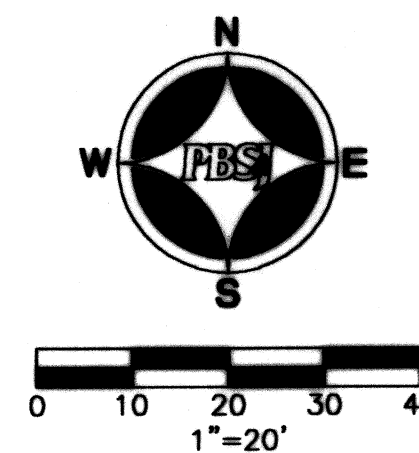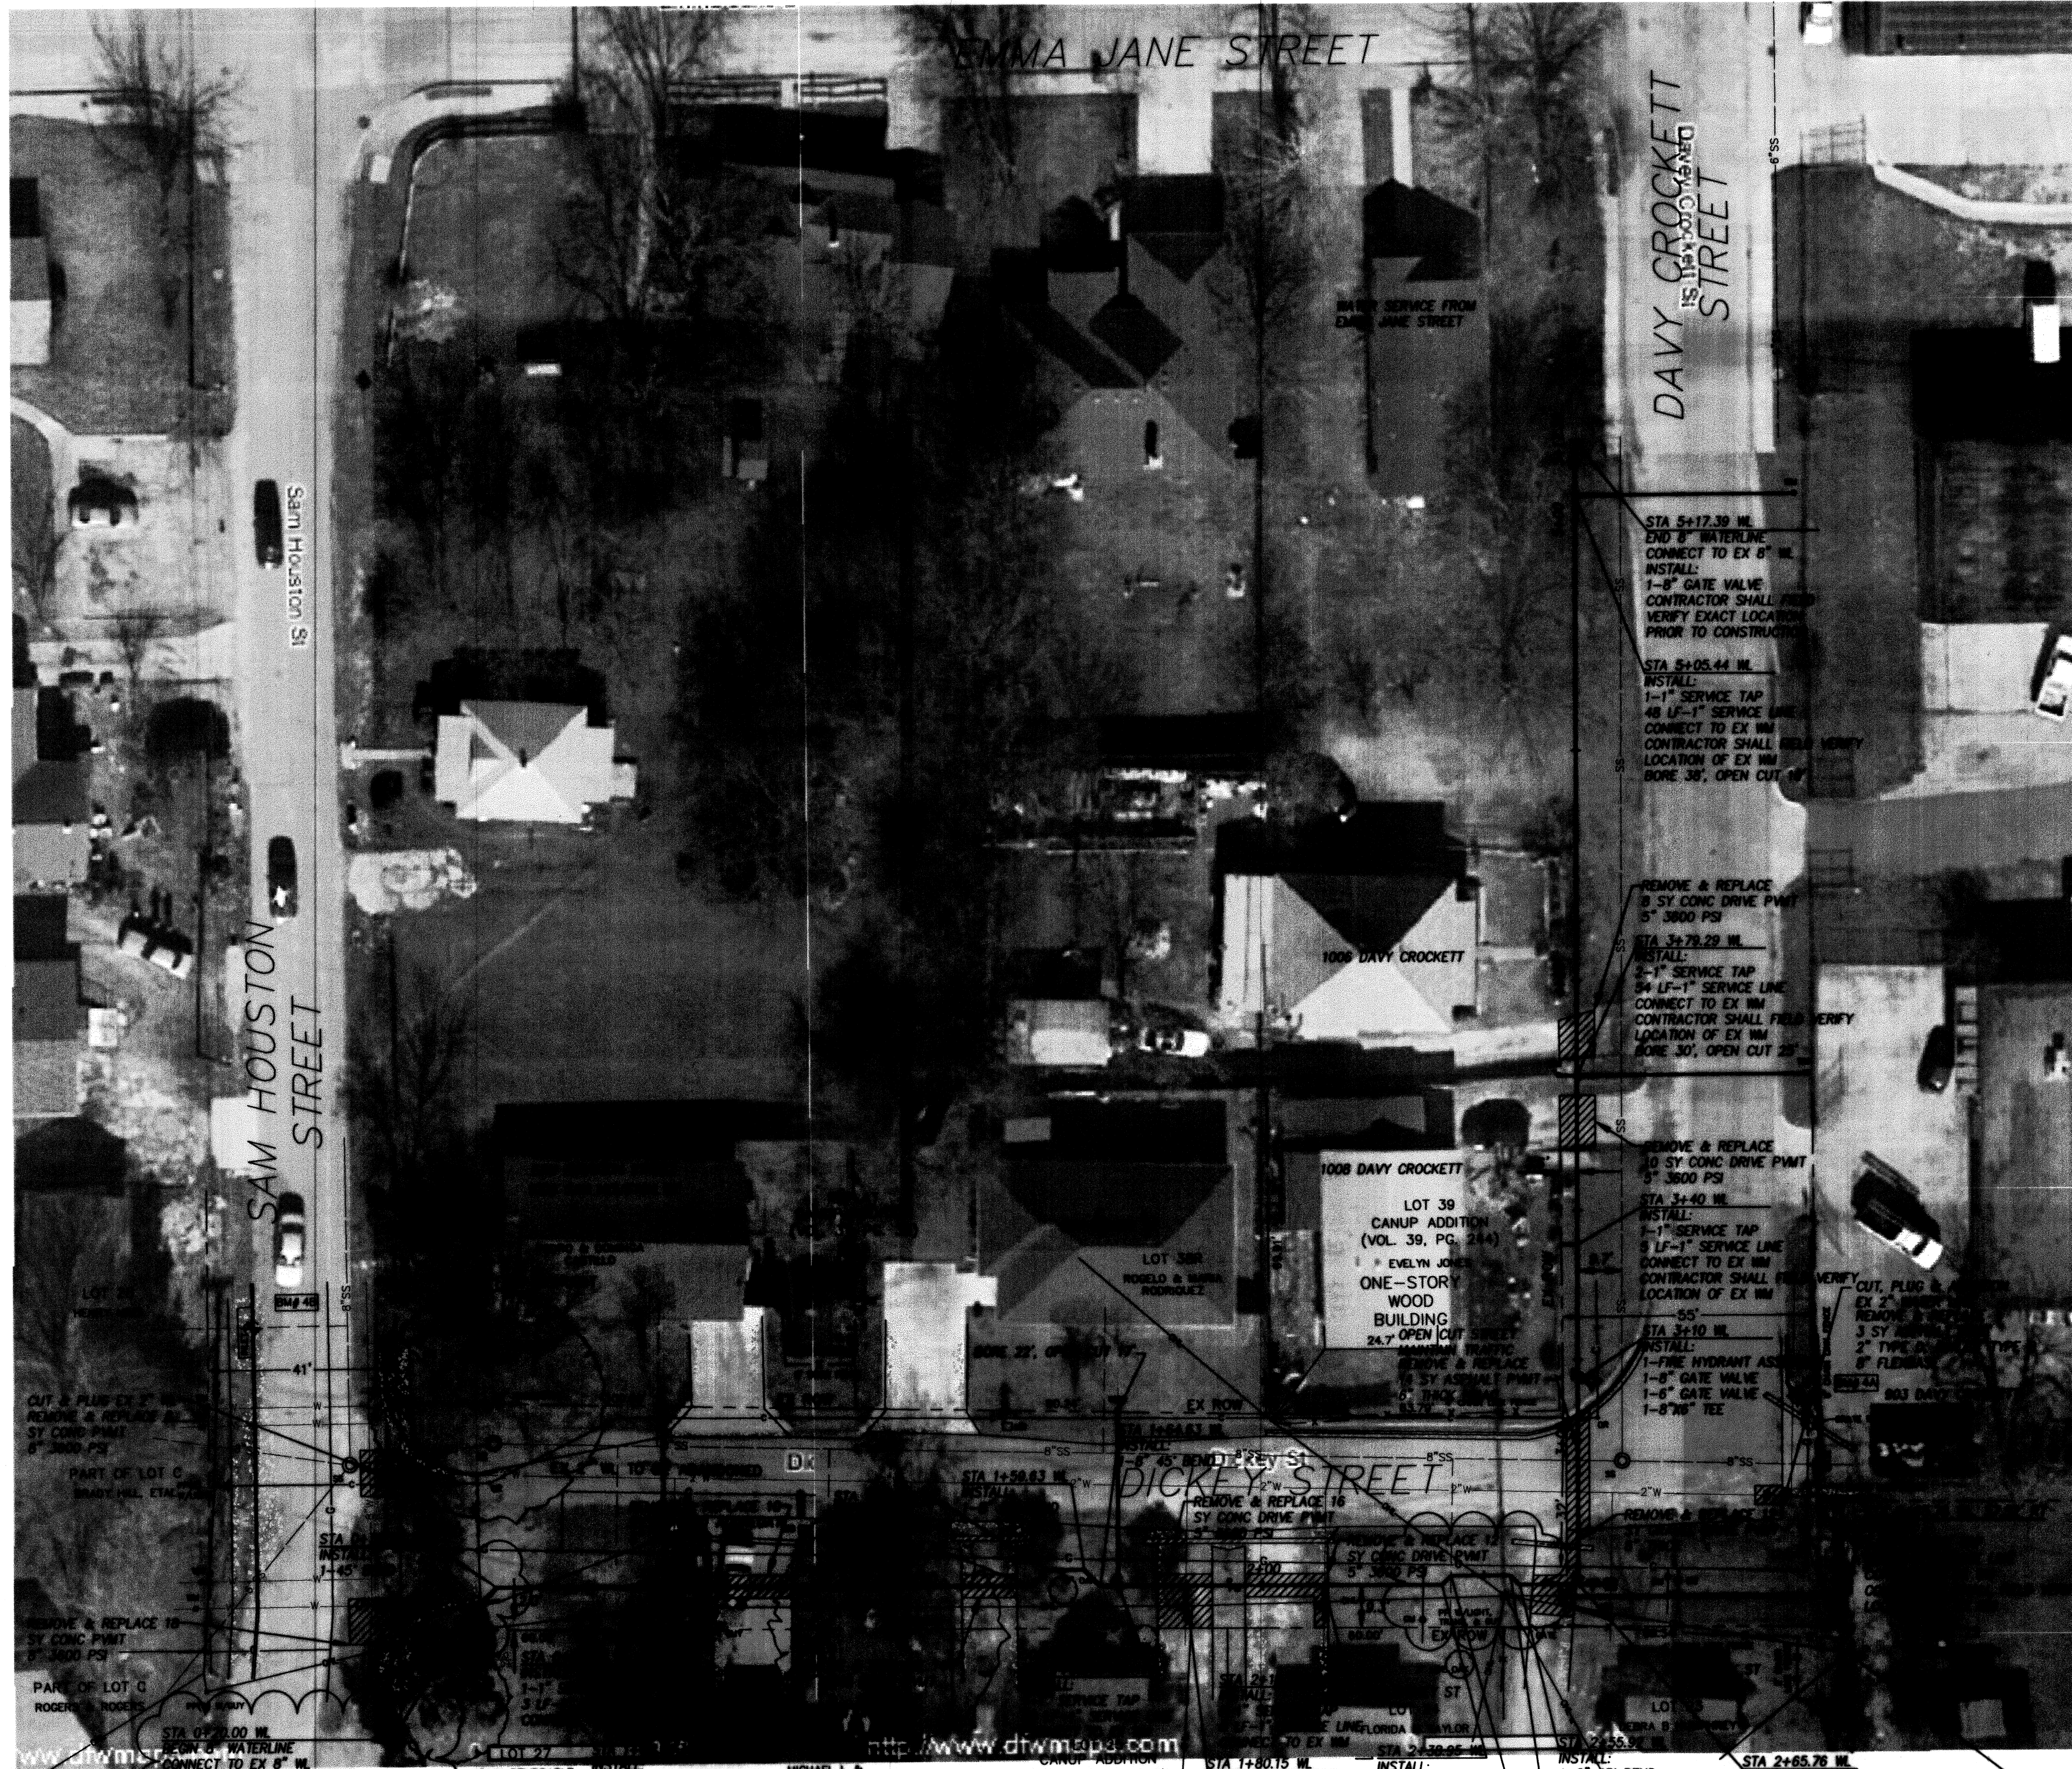


ALIGNMENT DATA-DICKEY



STATION	NORTHING	EASTING	DESC.	BEARING
0+00.00	7023754.69	2594812.99	POB	S 89°33'49" E
0+50.00	7023754.31	2594862.99	PI	N 45°26'11" E
0+60.33	7023761.55	2594870.35	PI	S 89°33'49" E
1+46.63	7023760.89	2594956.65	PI	N 45°26'11" E
1+51.63	7023764.40	2594960.21	PI	S 89°33'49" E
1+59.63	7023764.34	2594968.21	PI	S 44°33'49" E
1+64.53	7023760.78	2594971.72	PI	S 89°33'49" E
2+68.69	7023759.99	2595075.77	PI	N 00°26'11" E
5+17.39	7024008.68	2595077.67	POE	

BENCHMARK DATA-DICKEY


POINT	NORTHING	EASTING	ELEV	STATION/OFFSET
BM #4A	7023800.40	2595123.88	555.63	3+06.53, 47.80' RT
BM #4B	7023818.72	2594787.61	562.08	3+22.29, 288.6' LT

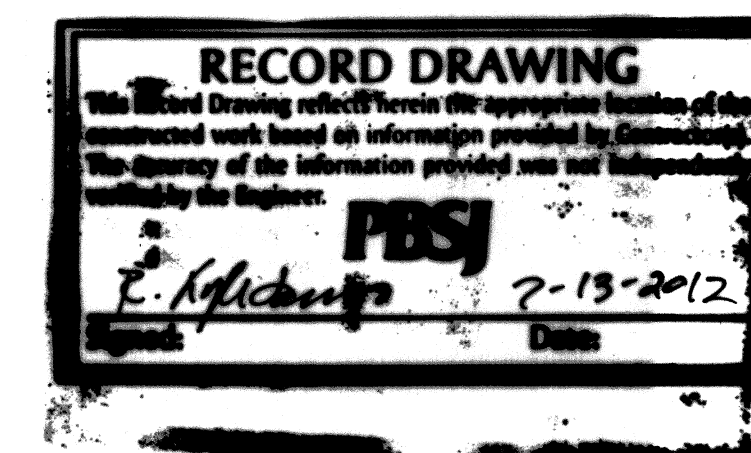

STA 2+65.76 DETAIL

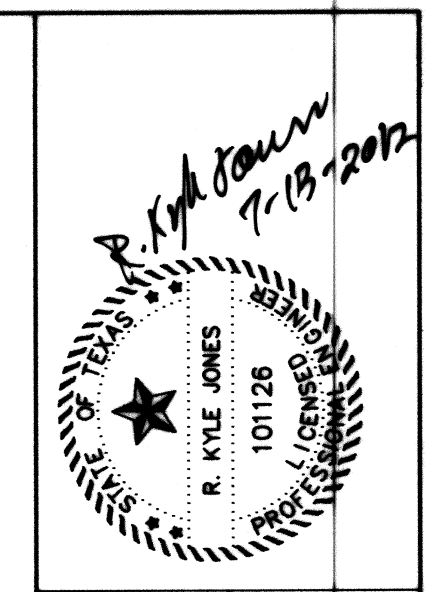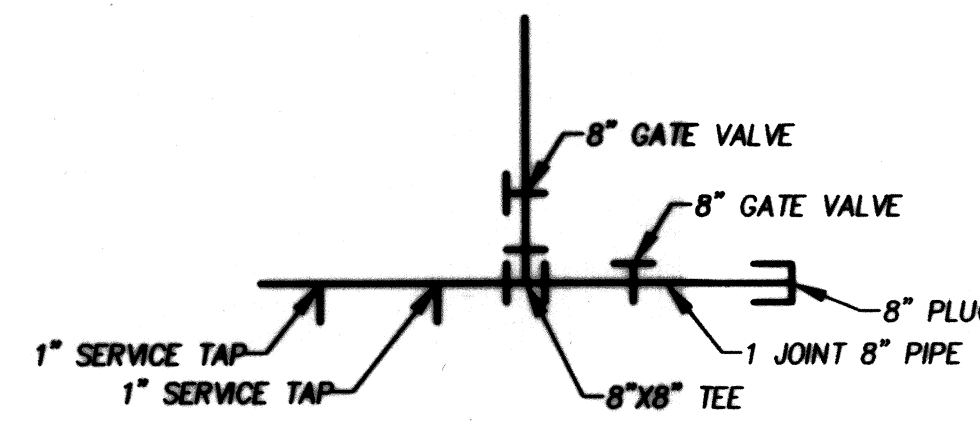

CITY OF ROCKWALL
WATERLINE REPLACEMENT PROJECTS
DICKEY WATERLINE REPLACEMENT
STA 0+00 TO STA 5+17

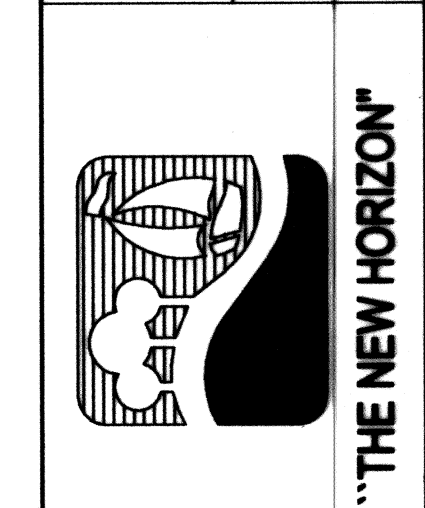

NO.	REVISION	BY	DATE
1	RECORD DWGS	RKJ	5/14/12
2			
3			
EMMA JANE STREET

DAVY CROCKETT STREET

WATER SERVICE FROM
EMMA JANE STREET

1006 DAVY CROCKETT

1008 DAVY CROCKETT

507 DICKEY ST

LOT 39
CANUP ADDITION
(VOL. 39, PG. 244)
EVELYN JONES
ONE-STORY
WOOD
BUILDING

LOT 38R
ROGEO & MARIA
RODRIGUEZ

508 DICKEY ST
LOT 24
FLORIDA M TAYLOR

510 DICKEY ST
LOT 23
DEBRA B HUMPHREY

512 DICKEY ST
LOT 22
GEORGIA BAKER

506 DICKEY ST
LOT 25
CANUP ADDITION
(VOL. 39, PG. 244)
VERNA MAE SIMS

504 DICKEY ST
LOT 26
MICHAEL L &
DEBRA L MATHIS

502 DICKEY ST
LOT 27
CAIN REVOCABLE
FAMILY TRUST

500 DICKEY ST
LOT 28
HENRY MIMS

500 DICKEY ST
LOT 29
ROGEO & MARIA
RODRIGUEZ

500 DICKEY ST
LOT 30
ROGEO & MARIA
RODRIGUEZ

500 DICKEY ST
LOT 31
ROGEO & MARIA
RODRIGUEZ

500 DICKEY ST
LOT 32
ROGEO & MARIA
RODRIGUEZ


500 DICKEY ST
LOT 33
ROGEO & MARIA
RODRIGUEZ

500 DICKEY ST
LOT 34
ROGEO & MARIA
RODRIGUEZ

500 DICKEY ST
LOT 35
ROGEO & MARIA
RODRIGUEZ

500 DICKEY ST
LOT 36
ROGEO & MARIA
RODRIGUEZ

500 DICKEY ST
LOT 37
ROGEO & MARIA
RODRIGUEZ

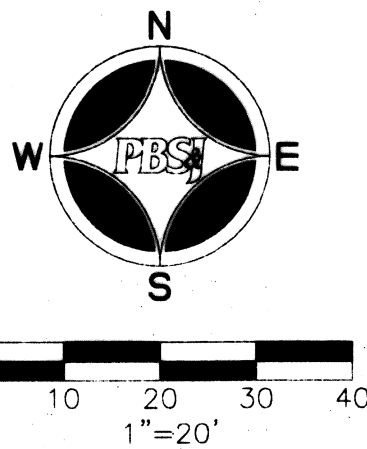


ALIGNMENT DATA-DICKEY



STATION	NORTHING	EASTING	DESC.	BEARING
0+00.00	7023754.69	2594012.99	POB	
0+50.00	7023754.31	2594062.99	PI	S 89°33'49" E
0+60.33	7023761.55	2594070.35	PI	N 45°26'11" E
1+46.63	7023760.89	2594956.65	PI	S 89°33'49" E
1+51.63	7023764.40	2594960.21	PI	N 45°26'11" E
1+59.63	7023764.34	2594968.21	PI	S 89°33'49" E
1+64.53	7023760.78	2594971.72	PI	S 44°33'49" E
2+68.69	7023759.99	2595075.77	PI	S 89°33'49" E
5+17.39	7024008.68	2595077.67	POE	N 00°26'11" E

BENCHMARK DATA-DICKEY


POINT	NORTHING	EASTING	ELEV.	STATION/OFFSET
BM #4A	7023800.40	2595123.88	555.63	3+06.53, 47.80' RT
BM #4B	7023818.72	2594787.61	562.08	3+22.29, 288.6' LT

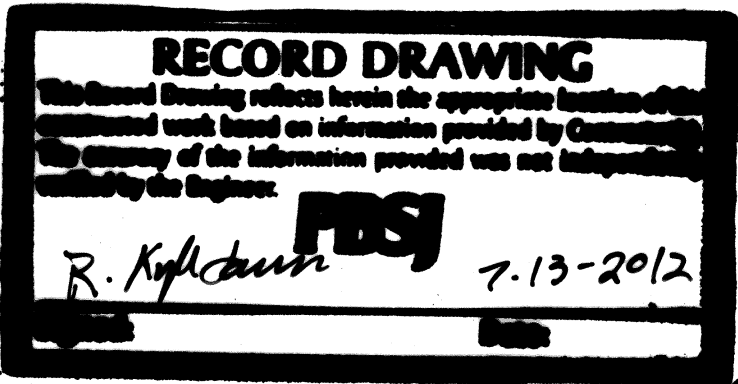

STA 2+65.76 DETAIL

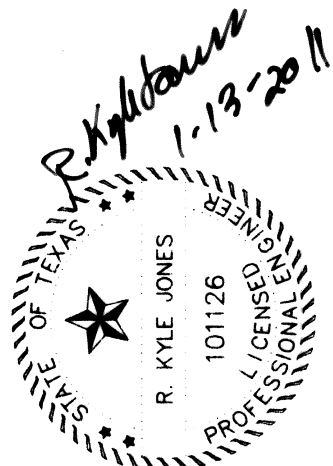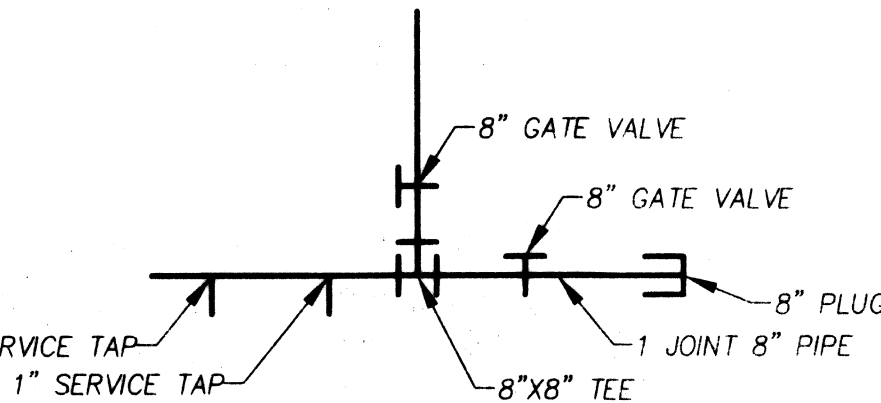

CITY OF ROCKWALL
WATERLINE REPLACEMENT PROJECTS
DICKEY WATERLINE REPLACEMENT
STA 0+00 TO STA 5+17

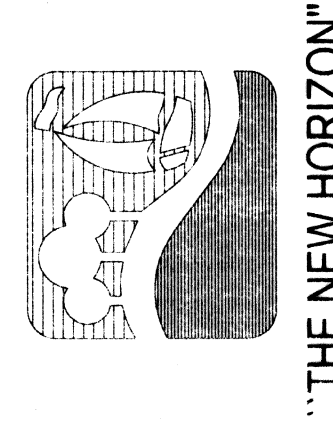


NO.	REVISION	DATE	BY
1	RECORD DMS	5/14/12	RKJ

DESIGN: TBS
DRAWN: RKJ
CHECKED: TBS
APPROVED: PBS&J

PBS&J TYPE #F-474
18843 PRAIRIE ROAD - SUITE 600
DALLAS, TEXAS 75242
PH: (972) 814-1275 FAX (972) 814-2608

SCALE: HOR: 1"=20'
SHEET 4A OF 13

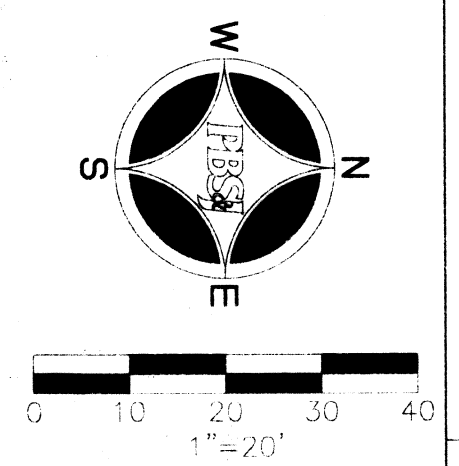

RECORD DRAWING


This drawing was based on information provided by the FBI, the attorney of the information provided was not independent of the FBI.

FBI

J. K. Adams


7-13-2012


Date

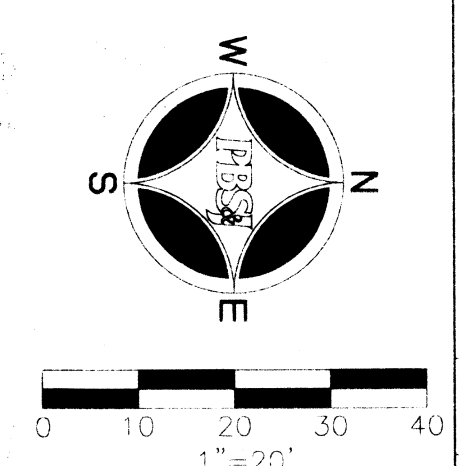

ALIGNMENT DATA-JOE WHITE				
STATION	NORTHING	EASTING	DESC.	BEARING
6+70.36	7030423.83	2595709.14	PT	N 25°43'29" W CURVE 2
7+10.64	7030460.11	2595691.66	PC	
8+40.00	7030584.66	2595660.03	PT	N 43°58'00" E
8+47.79	7030590.26	2595665.43	PI	N 01°02'00" W
8+81.94	7030624.40	2595664.82	PI	N 46°02'00" W
8+89.94	7030629.96	2595659.06	PI	N 01°02'00" W
16+46.09	7031385.99	2595645.42	PI	N 09°18'36" E
17+50.94	7031489.45	2595662.39	PI	N 01°56'24" W
18+42.19	7031580.65	2595659.30	END	

BENCHMARK DATA-JOE WHITE				
POINT	NORTHING	EASTING	ELEV	STATION/OFFSET
BM #5A	7031502.70	2595622.43	504.93	17+65.30, 37.11 R/L
BM #5B	7029935.28	2596163.11	529.23	JOE WHITE & NASH

 SHEET	SCALE:	HOR: 1"=20'	PBS&J JOB NO.: 100010908		DESIGN: RKJ	CHECKED: TBS
			DATE: JANUARY 2011		DRAWN: PKJ	APPROVED: PRSKJ
 TBPE #P-474		16383 PRESTON ROAD - SUITE 500 PH. (972) 918-7275 FAX (972) 980-2609		NO. _____ REVISION _____ BY _____ DATE _____		

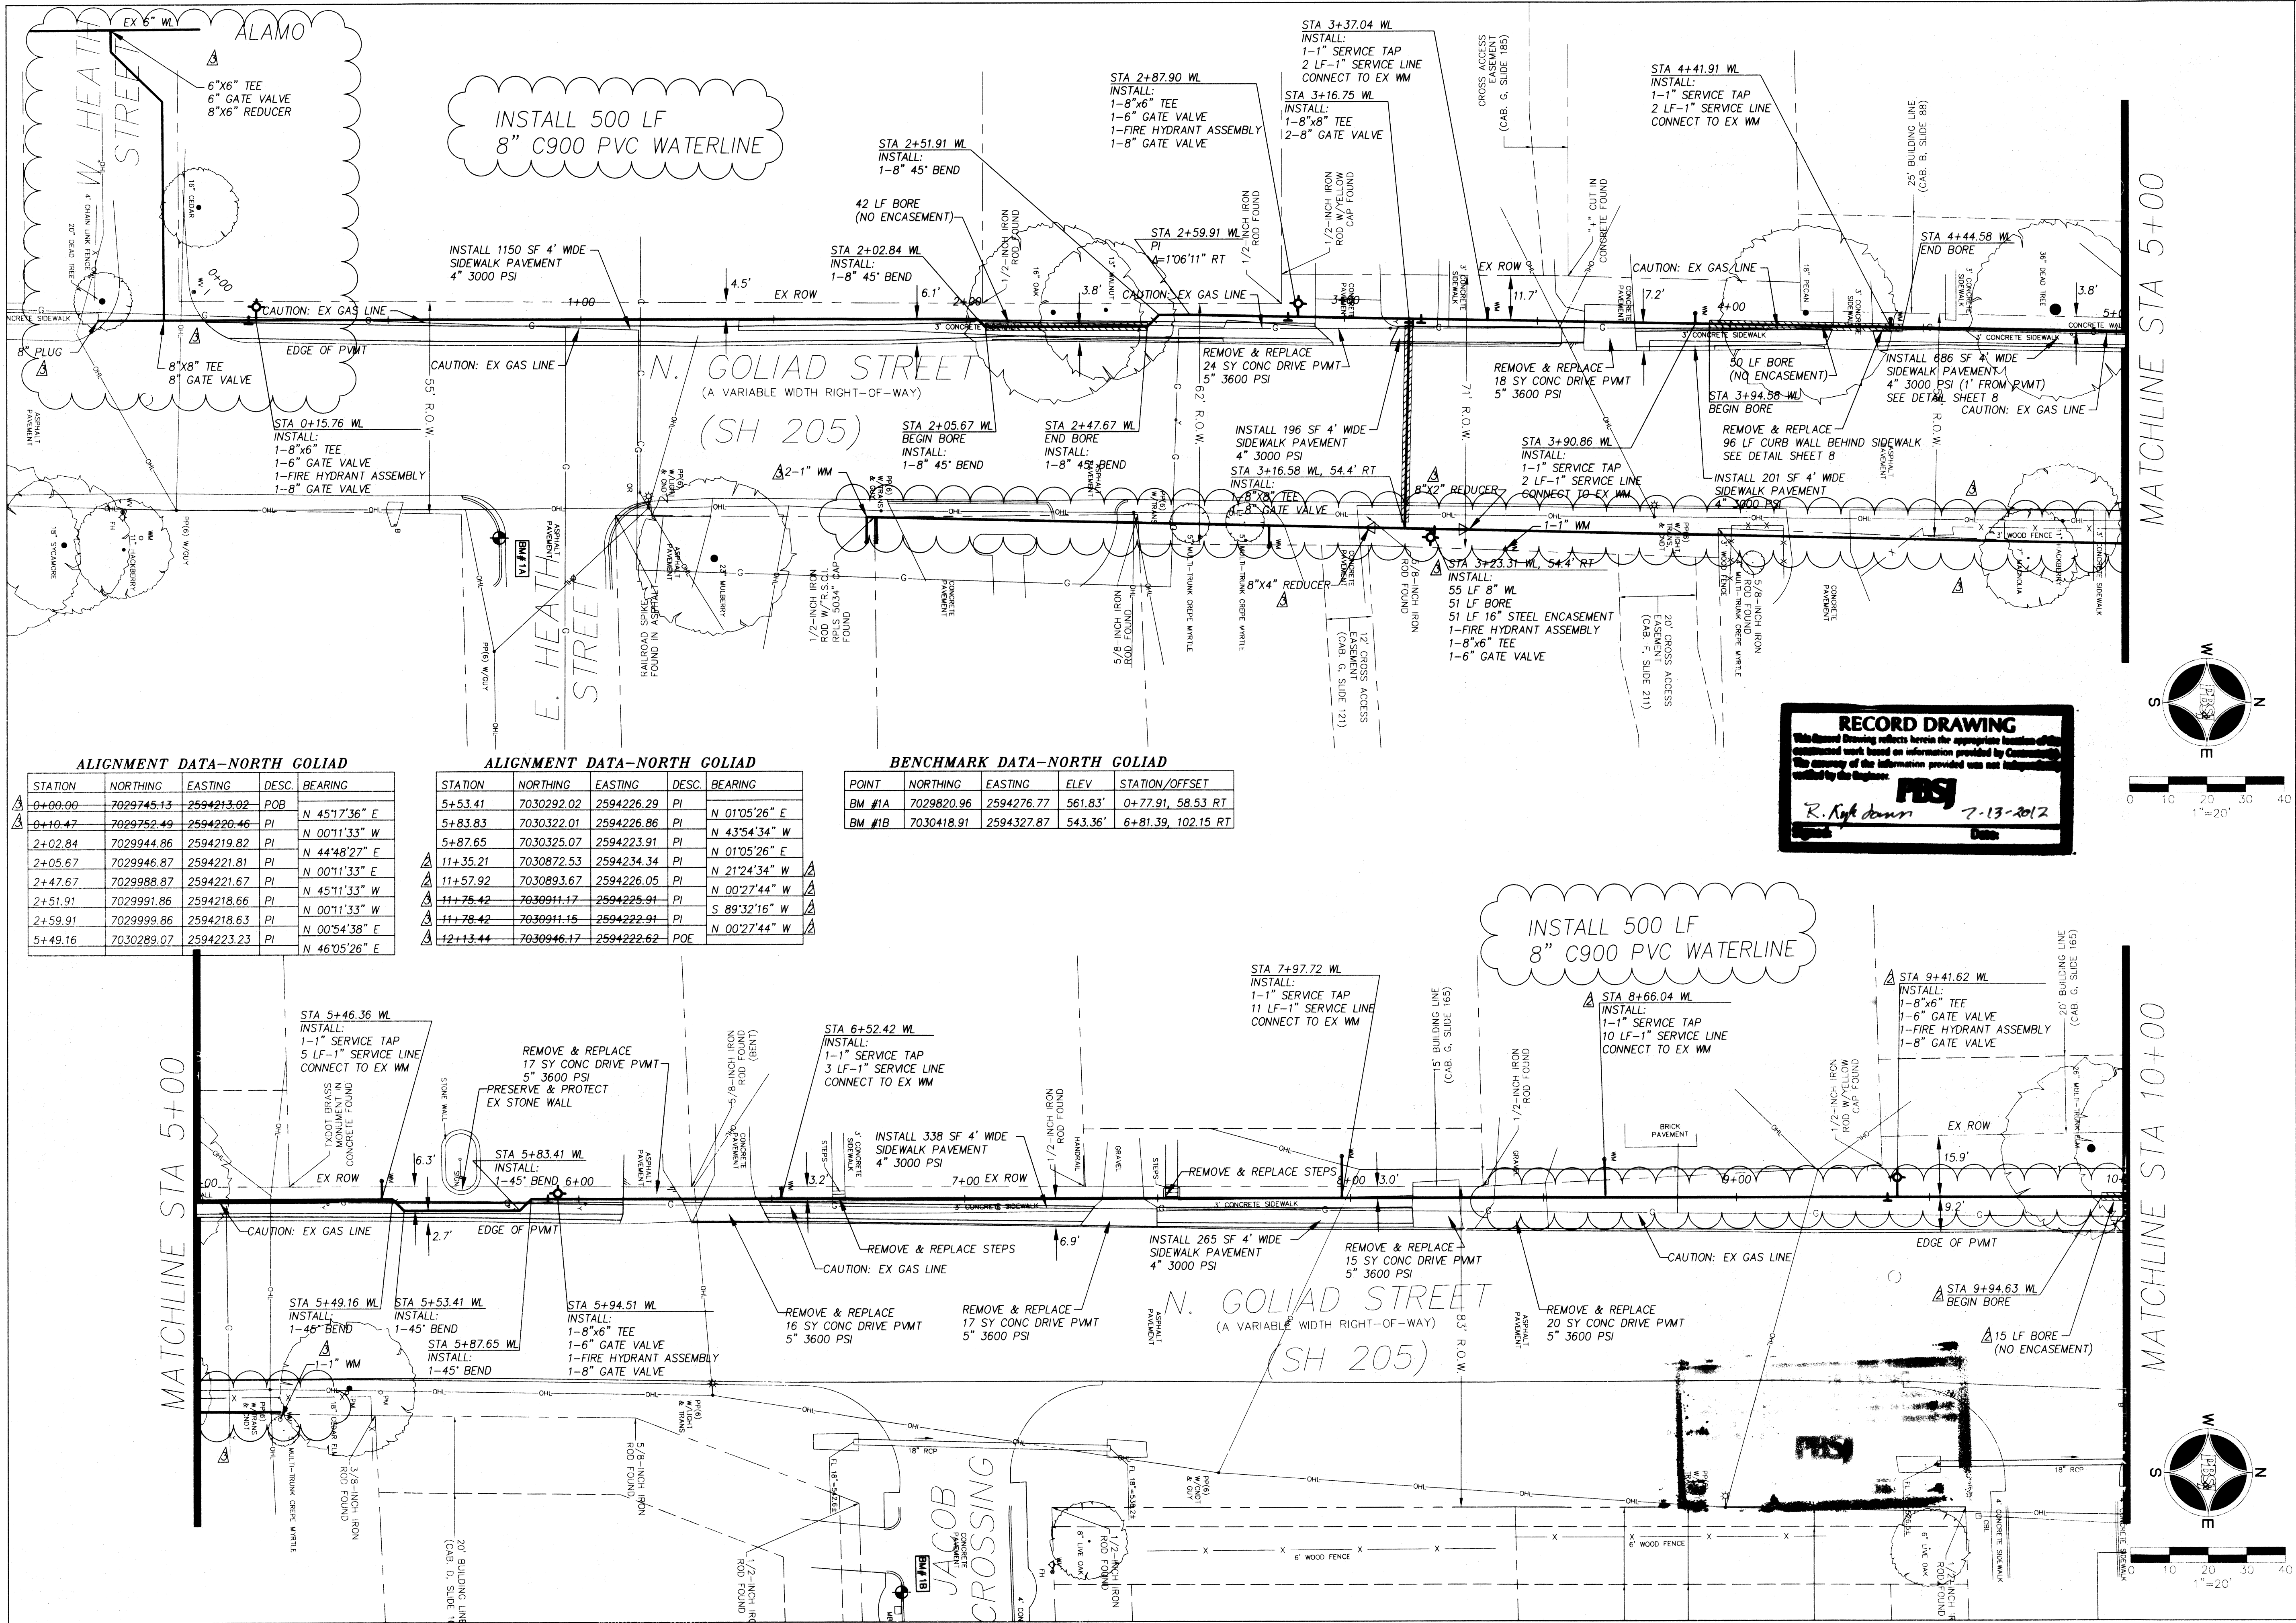

ALIGNMENT DATA-NORTH GOLIAD


STATION	NORTHING	EASTING	DESC.	BEARING
0+00.00	7029745.13	2594213.02	POB	N 45°17'36" E
0+10.47	7029752.49	2594220.46	PI	N 00°11'33" W
2+02.84	7029944.86	2594219.82	PI	N 44°48'27" E
2+05.67	7029946.87	2594221.81	PI	N 00°11'33" E
2+47.67	7029988.87	2594221.67	PI	N 45°11'33" W
2+51.91	7029991.86	2594218.66	PI	N 00°11'33" W
2+59.91	7029999.86	2594218.63	PI	N 00°54'38" E
5+49.16	7030289.07	2594223.23	PI	N 46°05'26" E

ALIGNMENT DATA-NORTH GOLIAD

STATION	NORTHING	EASTING	DESC.	BEARING
5+53.41	7030292.02	2594226.29	PI	N 01°05'26" E
5+83.83	7030322.01	2594226.86	PI	N 43°54'34" W
5+87.65	7030325.07	2594223.91	PI	N 01°05'26" E
11+35.21	7030872.53	2594234.34	PI	N 21°24'34" W
11+57.92	7030893.67	2594226.05	PI	N 00°27'44" W
11+75.42	7030911.17	2594225.91	PI	S 89°32'16" W
11+78.42	7030911.15	2594222.91	PI	N 00°27'44" W
12+13.44	7030946.17	2594222.62	POE	

BENCHMARK DATA-NORTH GOLIAD

POINT	NORTHING	EASTING	ELEV.	STATION/OFFSET
BM #1A	7029820.96	2594276.77	561.83'	0+77.91, 58.53 RT
BM #1B	7030418.91	2594327.87	543.36'	6+81.39, 102.15 RT

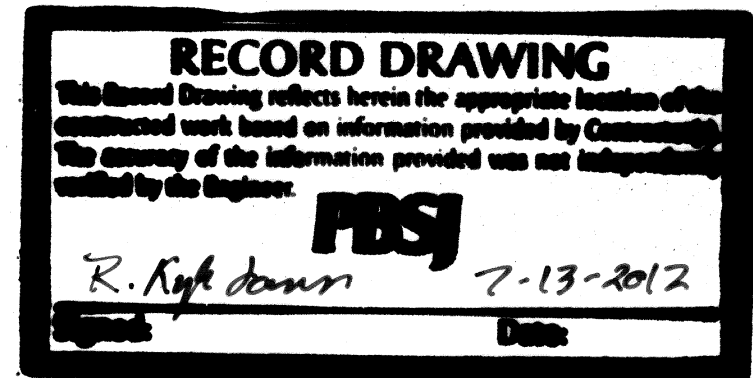

CITY OF ROCKWALL
WATERLINE REPLACEMENT PROJECTS
NORTH GOLIAD WATERLINE REPLACEMENT
STA 0+00 TO STA 10+00

THE NEW HORIZON

NO.	REVISION	BY	DATE
1	REVISED ALIGN 0+00 TO 5+49	RKJ	1/28/2011
2	REVISED ALIGN 6+35 TO END	RKJ	8/10/2011
3	RECORD DRAWINGS	RKJ	5/21/2012

TBPE #F-474


18383 PRESTON ROAD - SUITE 600
DALLAS, TEXAS 75244
PH: (972) 410-2717 FAX: (972) 480-8808

DESIGN: RKJ
CHECKED: TBS
APPROVED: PBS&J


PBS&J JOB NO.: 100010908
DATE: JANUARY 2011
FILE:

SCALE: HOR: 1"=20'
SHEET 7 OF 13



MATCHLINE STA 10+00

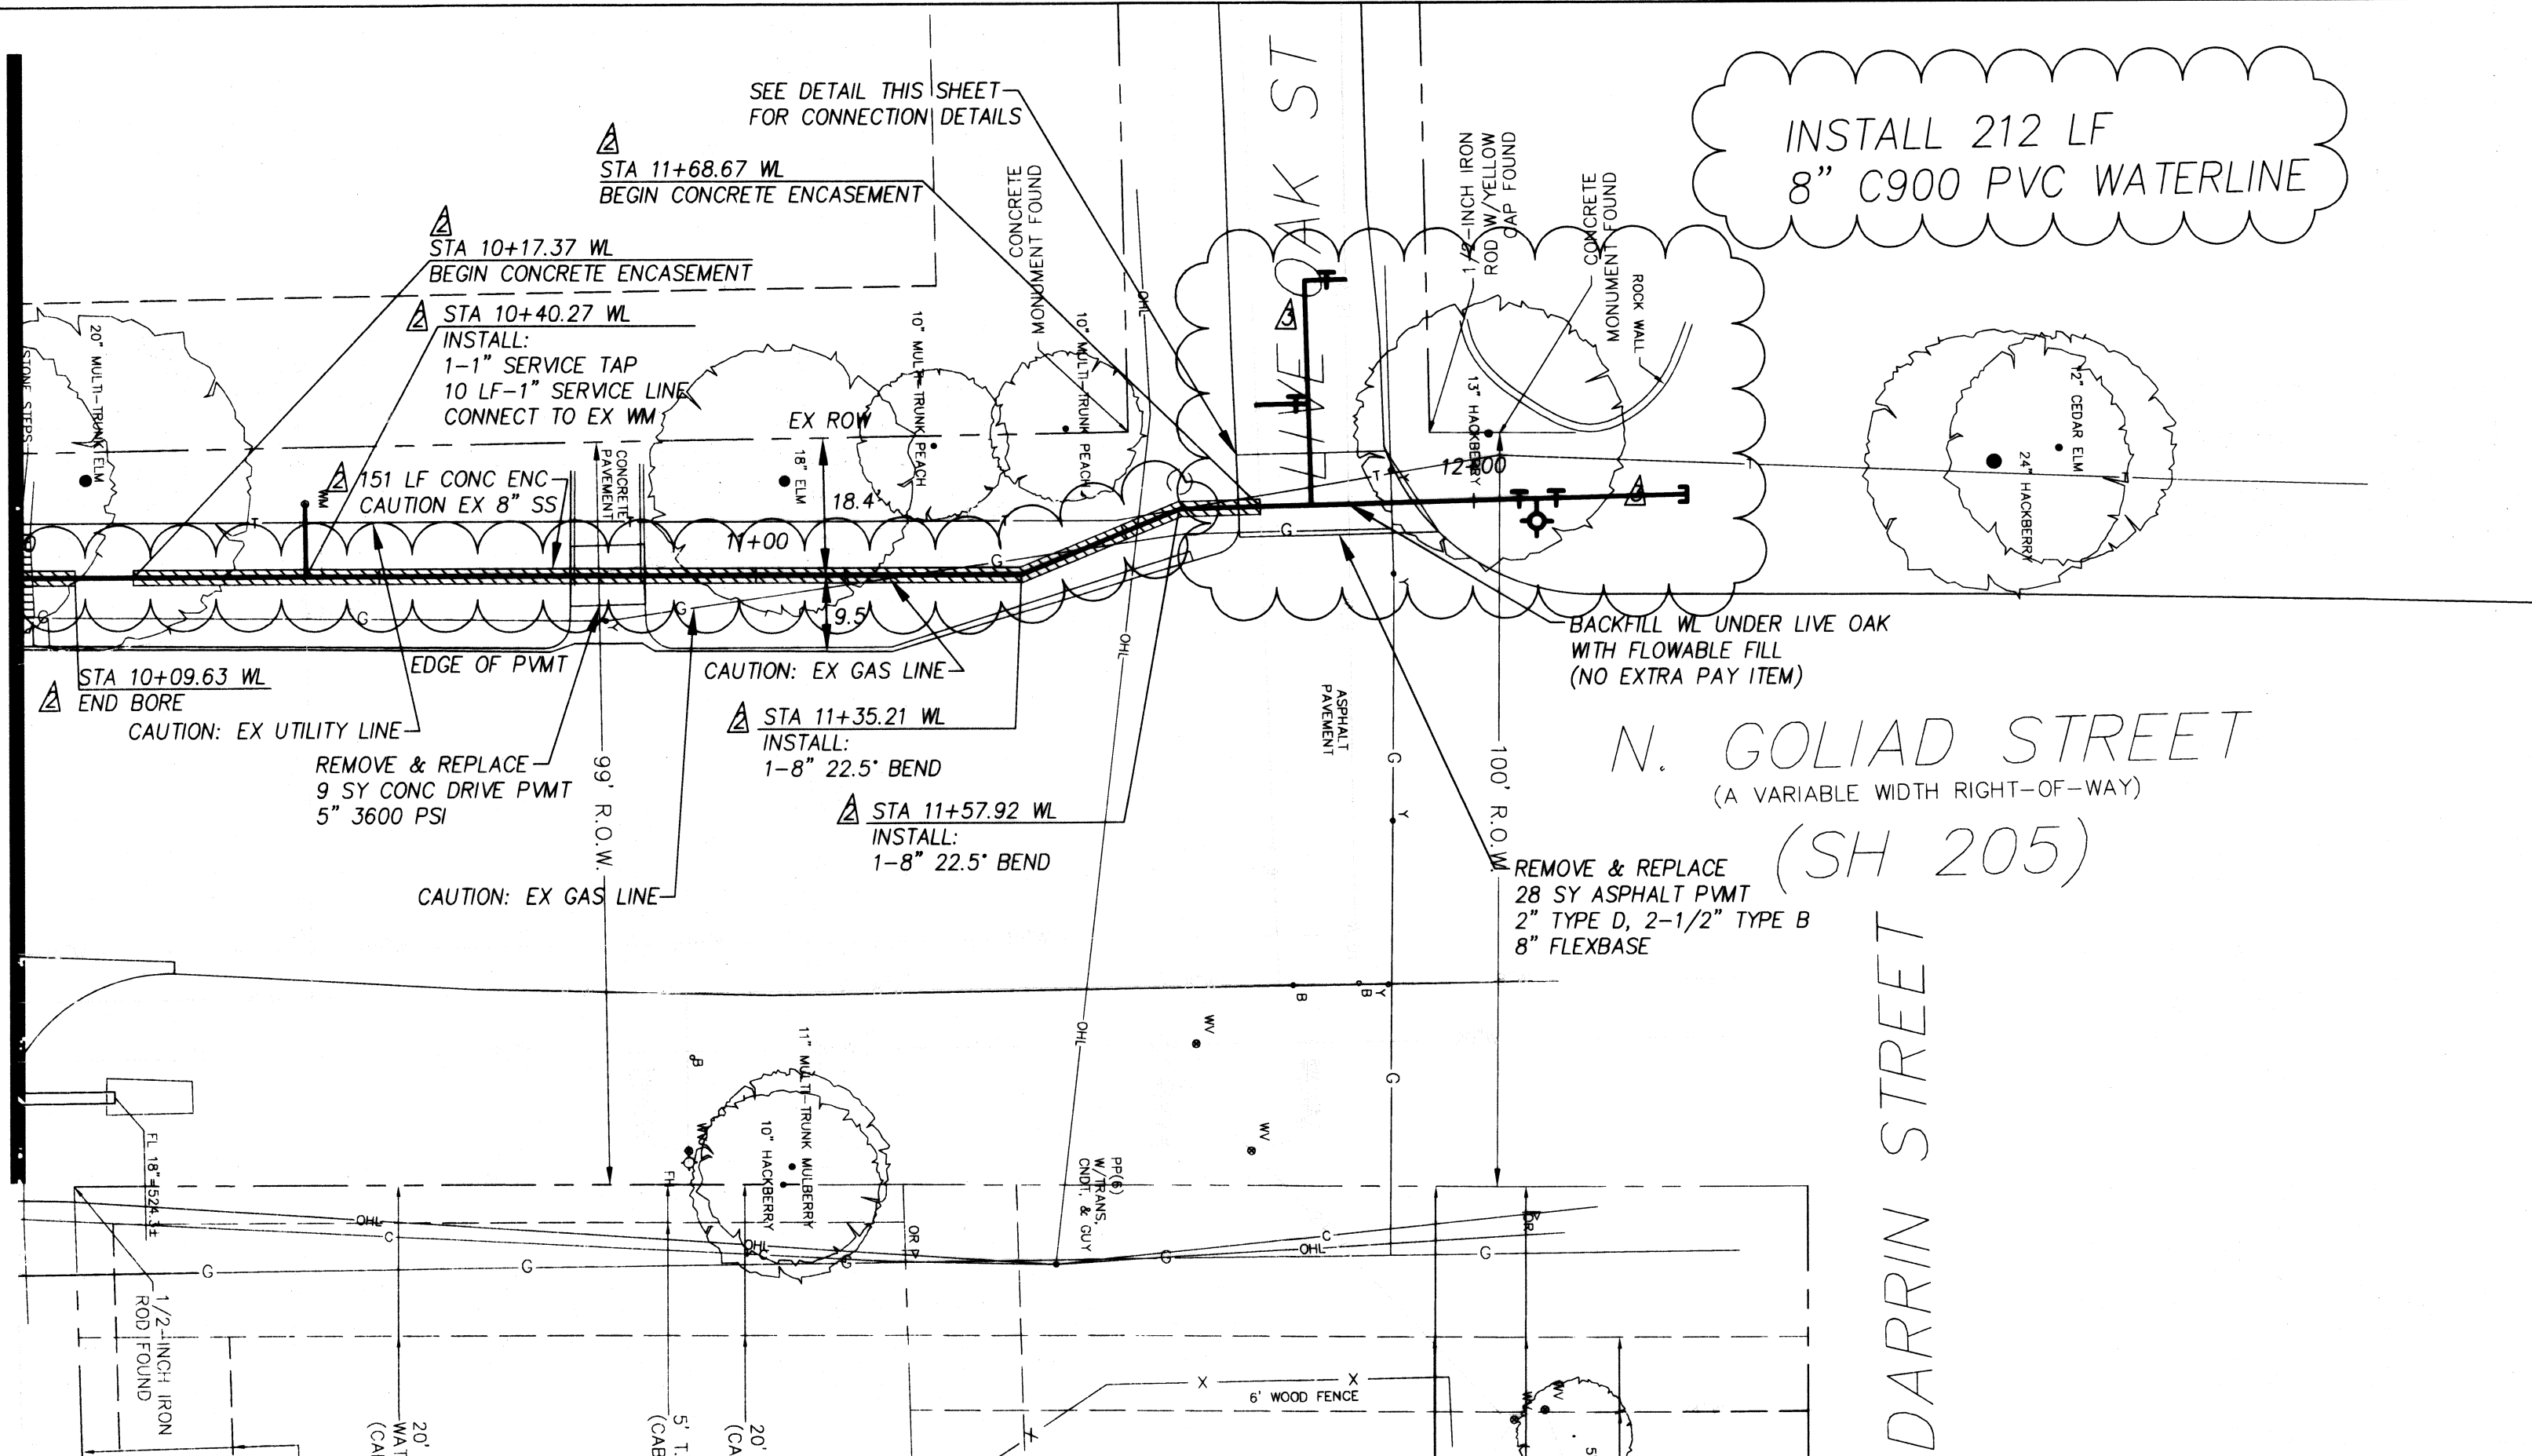

ASPHALT DETAIL
NOT TO SCALE

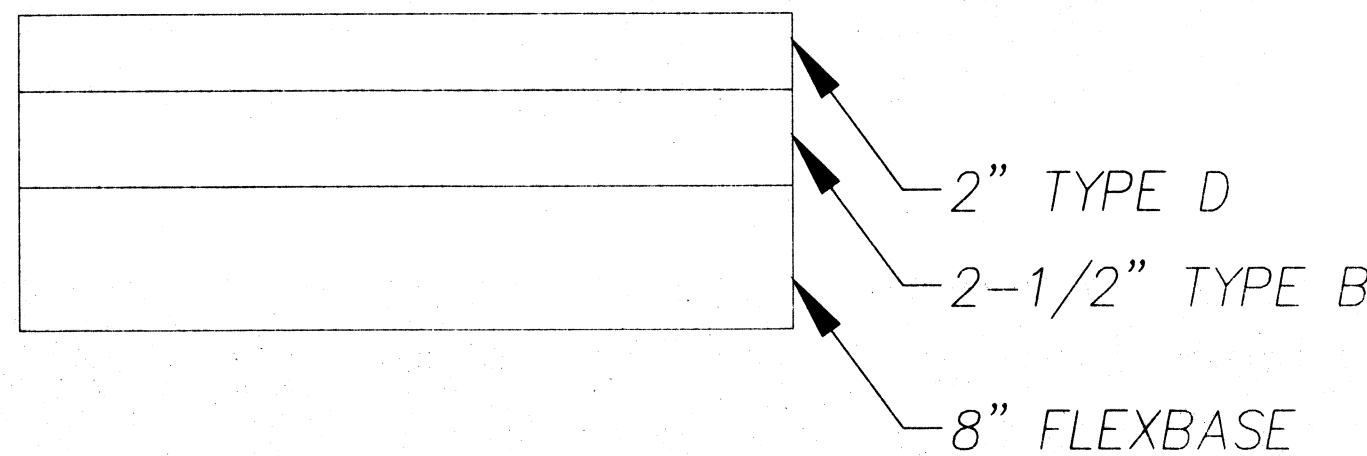





CURB WALL WITH SIDEWALK
NOT TO SCALE
WALL IS INCLUDED AS PART OF SIDEWALK PAY ITEM

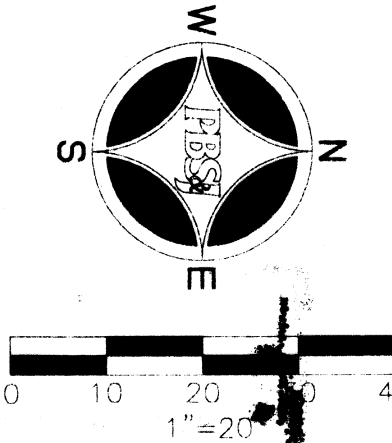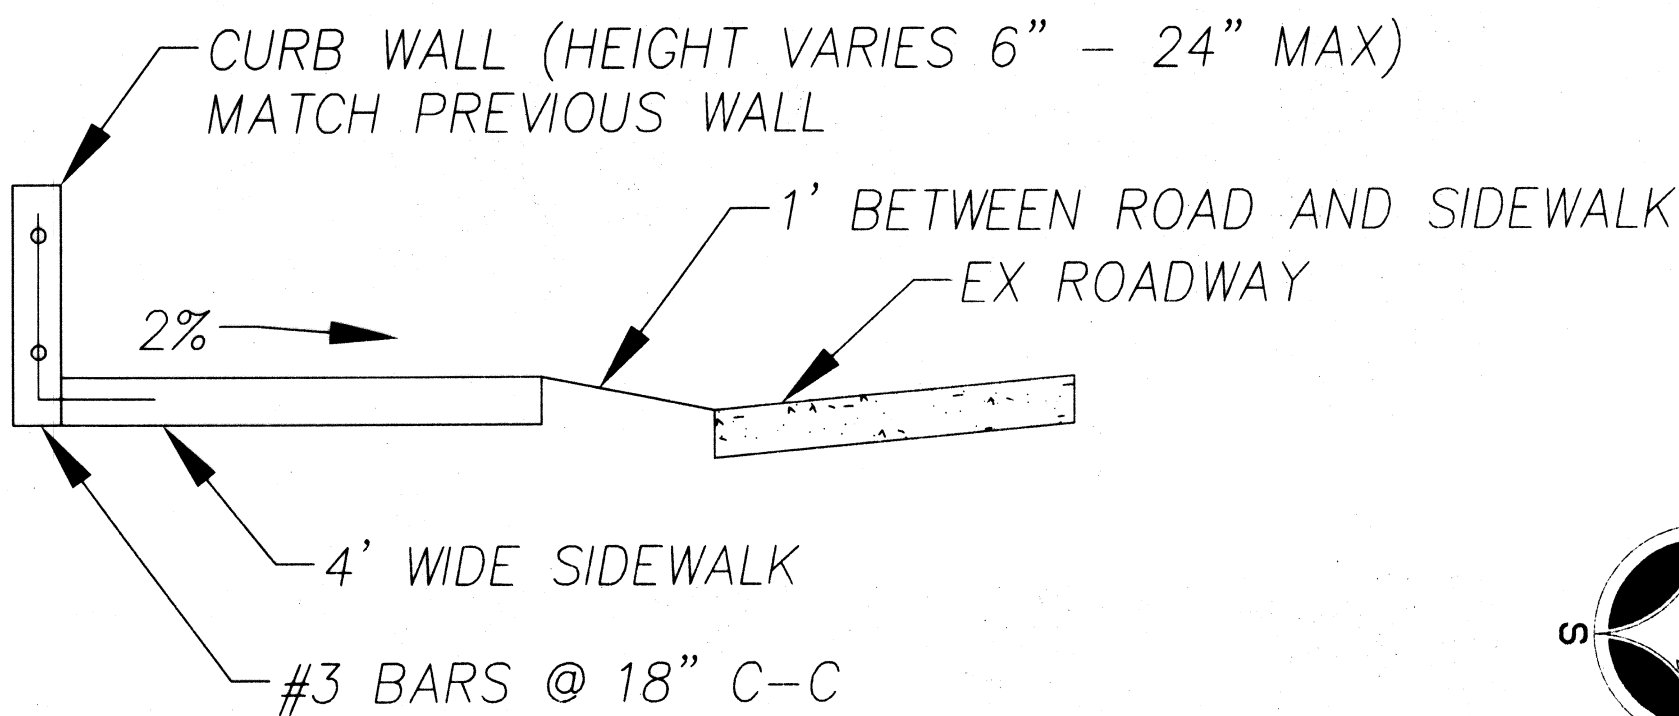


ALIGNMENT DATA-NORTH GOLIAD				
STATION	NORTHING	EASTING	DESC.	BEARING
0+00.00	7029745.13	2594213.02	POB	N 45°17'36\"
0+10.47	7029752.49	2594220.46	PI	N 00°11'33\"
2+02.84	7029944.86	2594219.82	PI	N 44°48'27\"
2+05.67	7029946.87	2594221.81	PI	N 00°11'33\"
2+47.67	7029988.87	2594221.67	PI	N 45°11'33\"
2+51.91	7029991.86	2594218.66	PI	N 00°11'33\"
2+59.91	7029999.86	2594218.63	PI	N 00°54'38\"
5+49.16	7030289.07	2594223.23	PI	N 46°05'26\"

ALIGNMENT DATA-NORTH GOLIAD				
STATION	NORTHING	EASTING	DESC.	BEARING
5+53.41	7030292.02	2594226.29	PI	N 01°05'26\"
5+83.83	7030322.01	2594226.86	PI	N 43°54'34\"
5+87.65	7030325.07	2594223.91	PI	N 01°05'26\"
11+35.21	7030872.53	2594234.34	PI	N 21°24'34\"
11+57.92	7030893.67	2594226.05	PI	N 00°27'44\"
11+75.42	7030911.17	2594225.91	PI	S 89°32'16\"
11+78.42	7030911.15	2594222.91	PI	N 00°27'44\"
12+13.44	7030946.17	2594222.62	POE	


BENCHMARK DATA-NORTH GOLIAD				
POINT	NORTHING	EASTING	ELEV	STATION/OFFSET
BM #1A	7029820.96	2594276.77	561.83'	0+77.91, 58.53 RT
BM #1B	7030418.91	2594327.87	543.36'	6+81.39, 102.15 RT

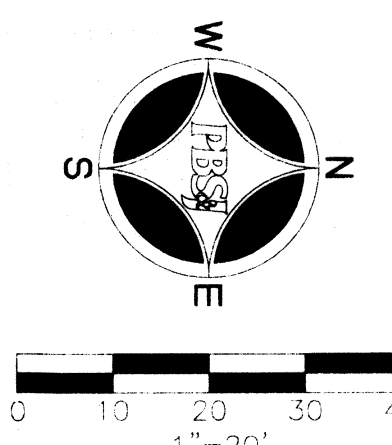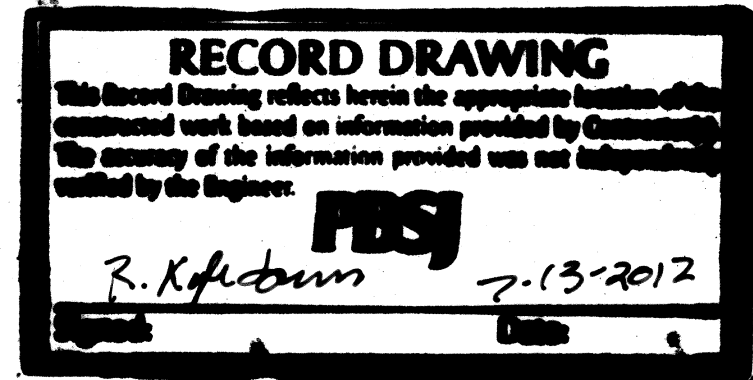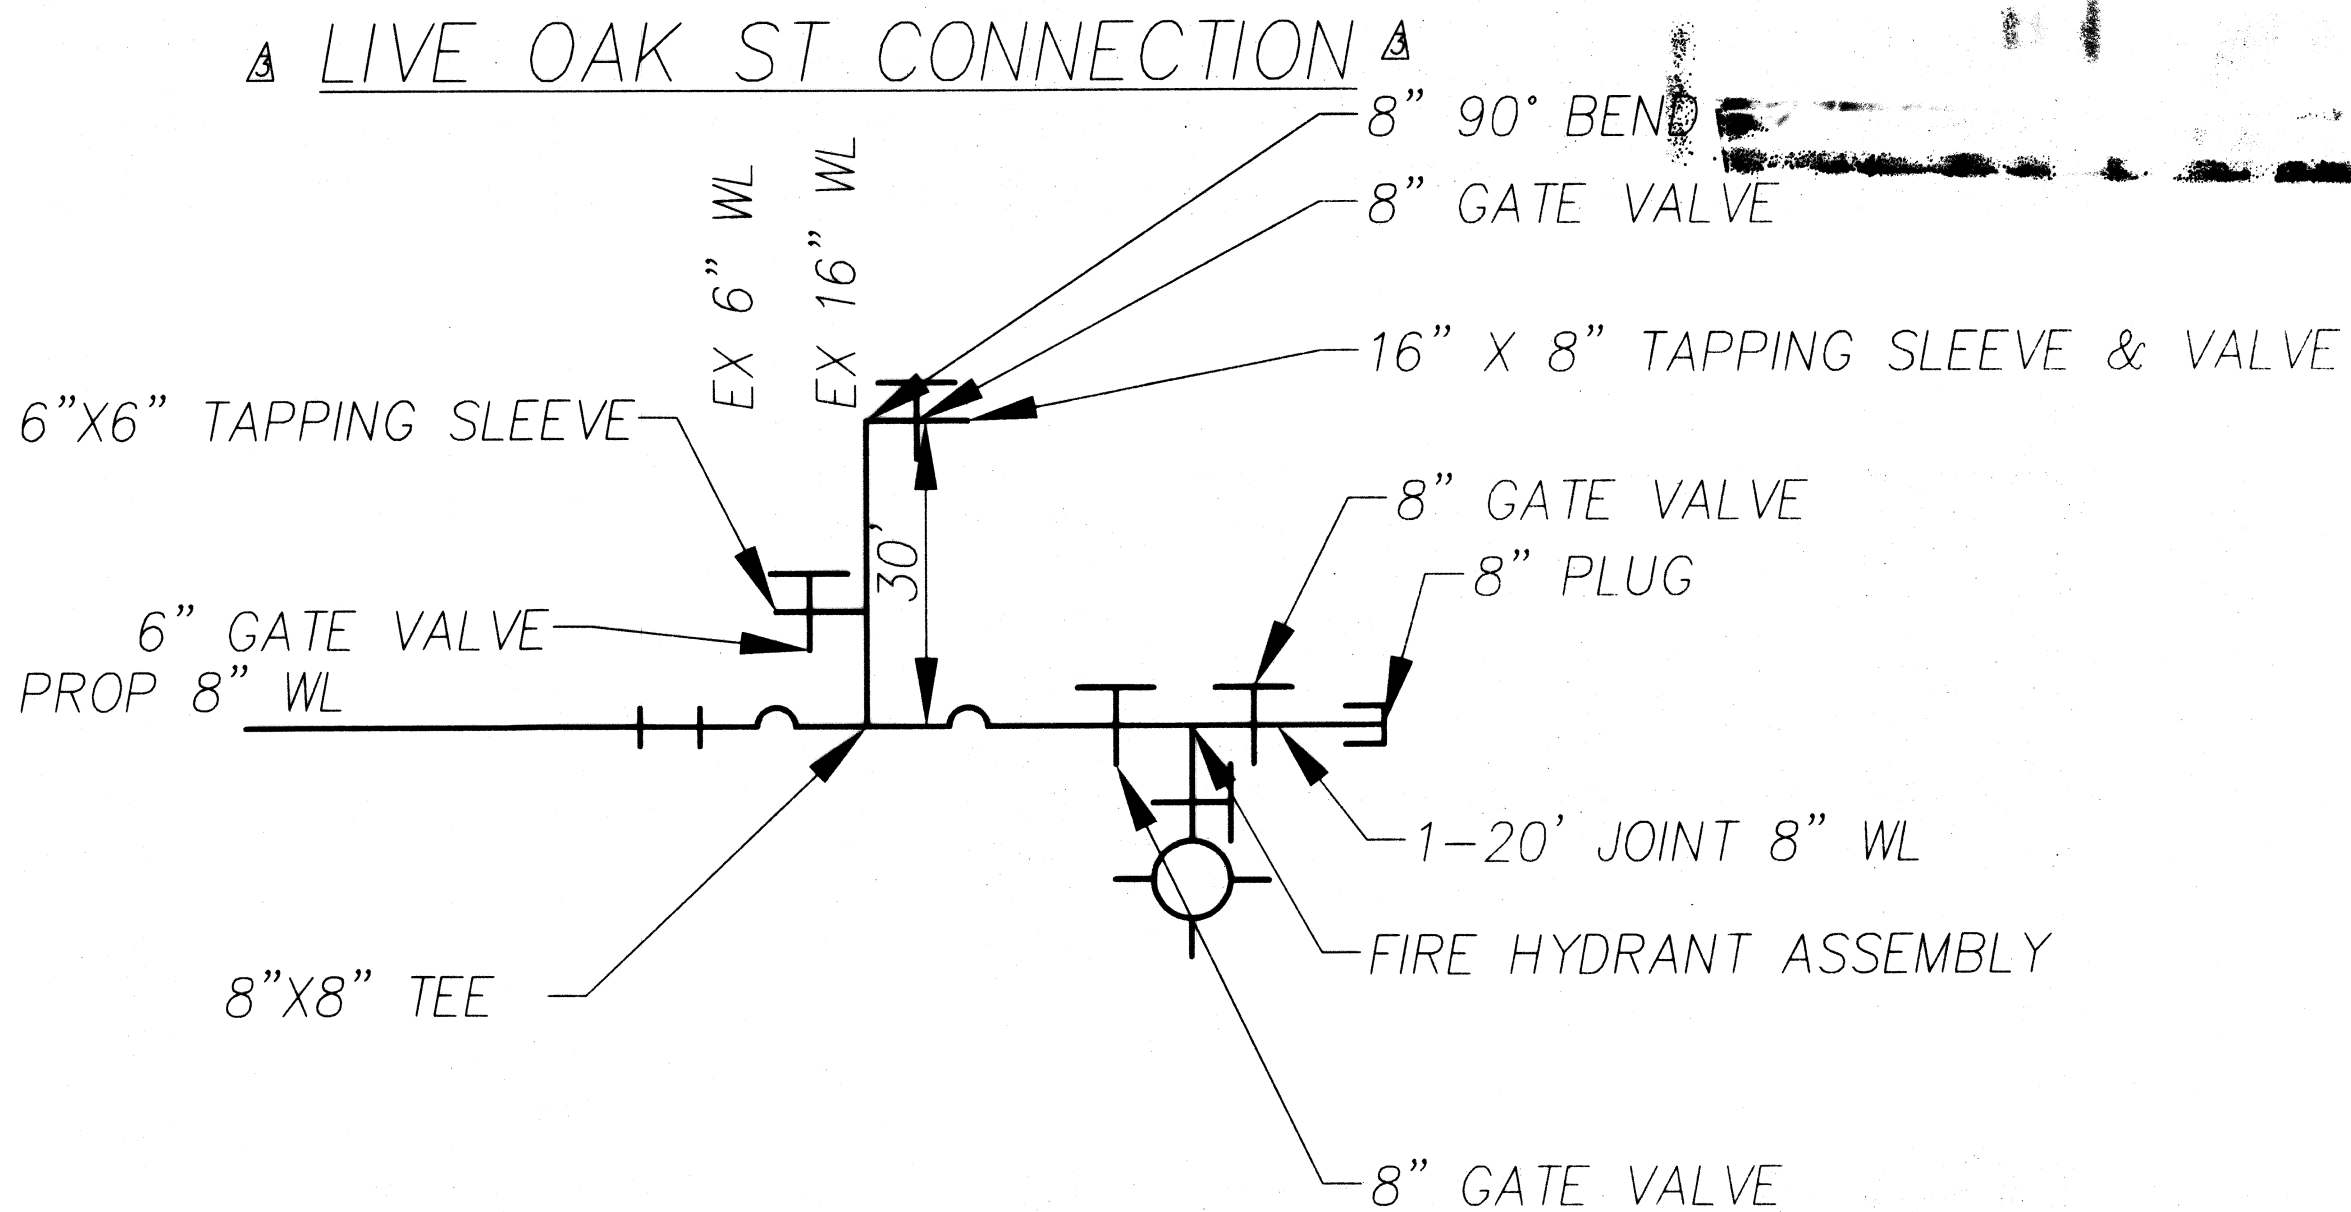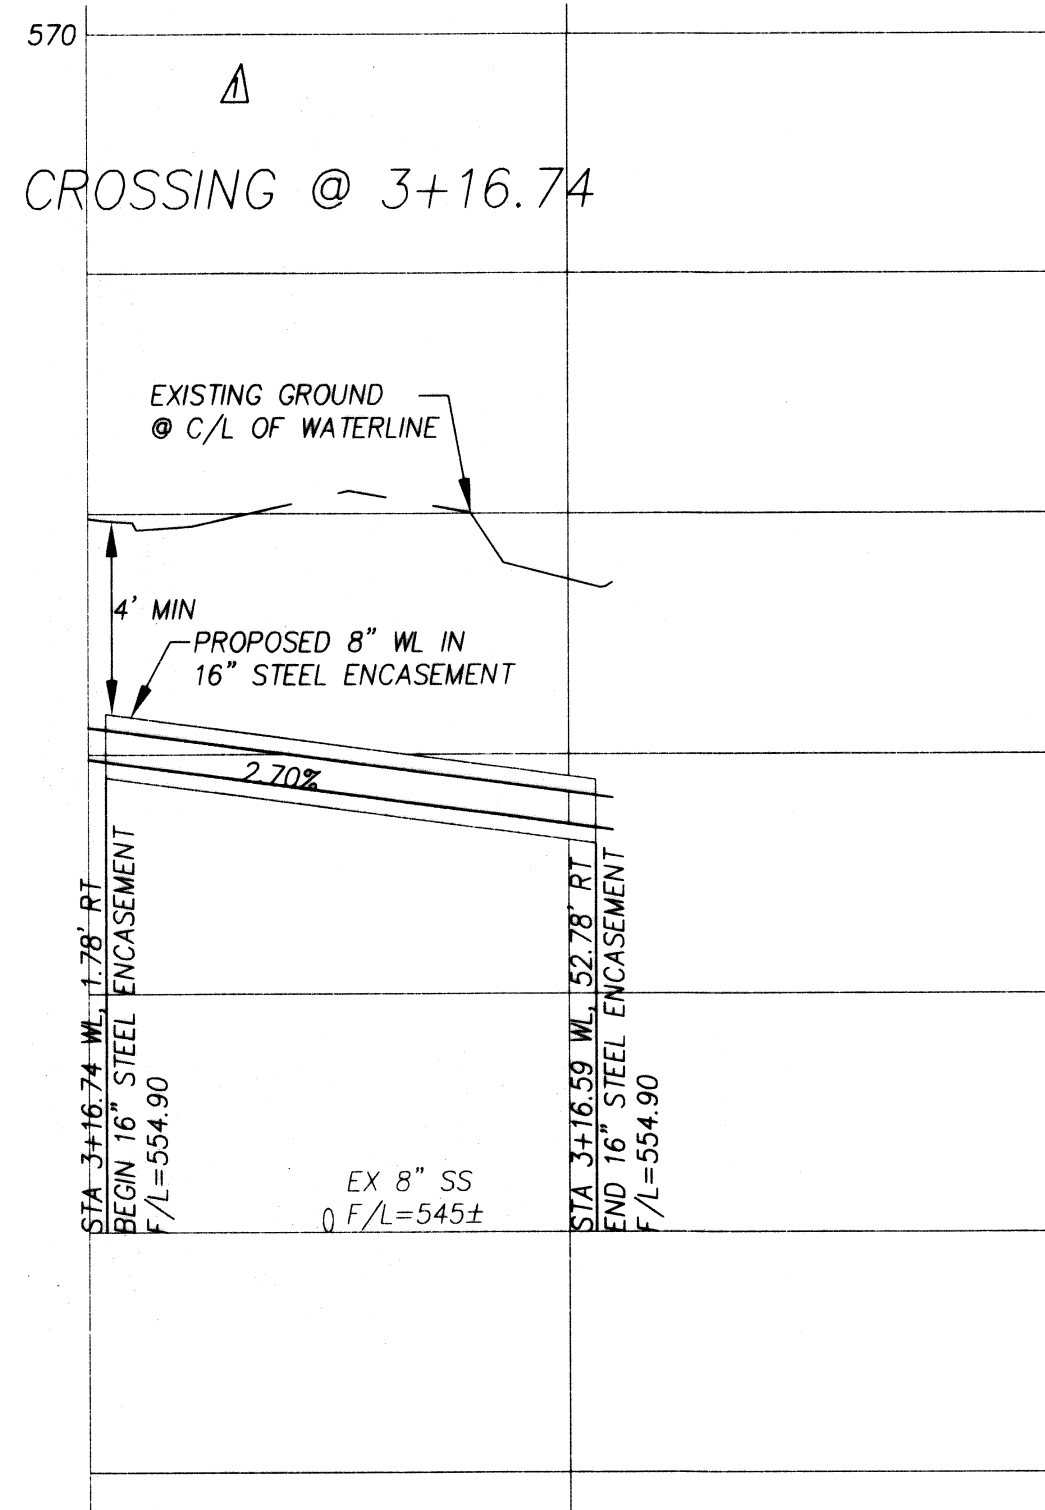

CITY OF ROCKWALL
WATERLINE REPLACEMENT PROJECTS
NORTH GOLIAD WATERLINE REPLACEMENT
STA 10+00 TO STA 12+11

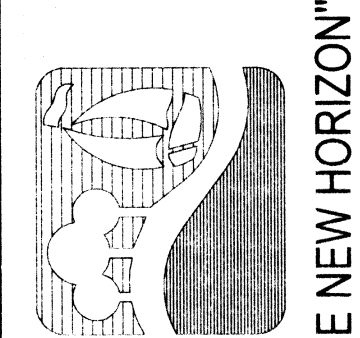

PBS&J		18883 PRESTON ROAD - SUITE 500		DALLAS, TEXAS 75232		PH (972) 816-2715 FAX (972) 360-8808	
SCALE:		HOR: 1"=20'		VER: 1"=4'			
SHEET		8		OF		13	
PBS&J JOB NO.: 100070908		DATE: JANUARY 2011		DESIGN: RKJ		CHECKED: TBS	
APPROVED: PBS&J		DATE: 1/28/2011		BY: RKJ		DATE: 8/10/2011	
REVISION		NO.		ADDED WL PROFILE FOR CROSSING		REVISION	
1		Δ		ADDED WL PROFILE FOR CROSSING		1	
2		Δ		REVISED ALIGN 8+35 TO END		2	
3		Δ		RECORD DRAWINGS		3	

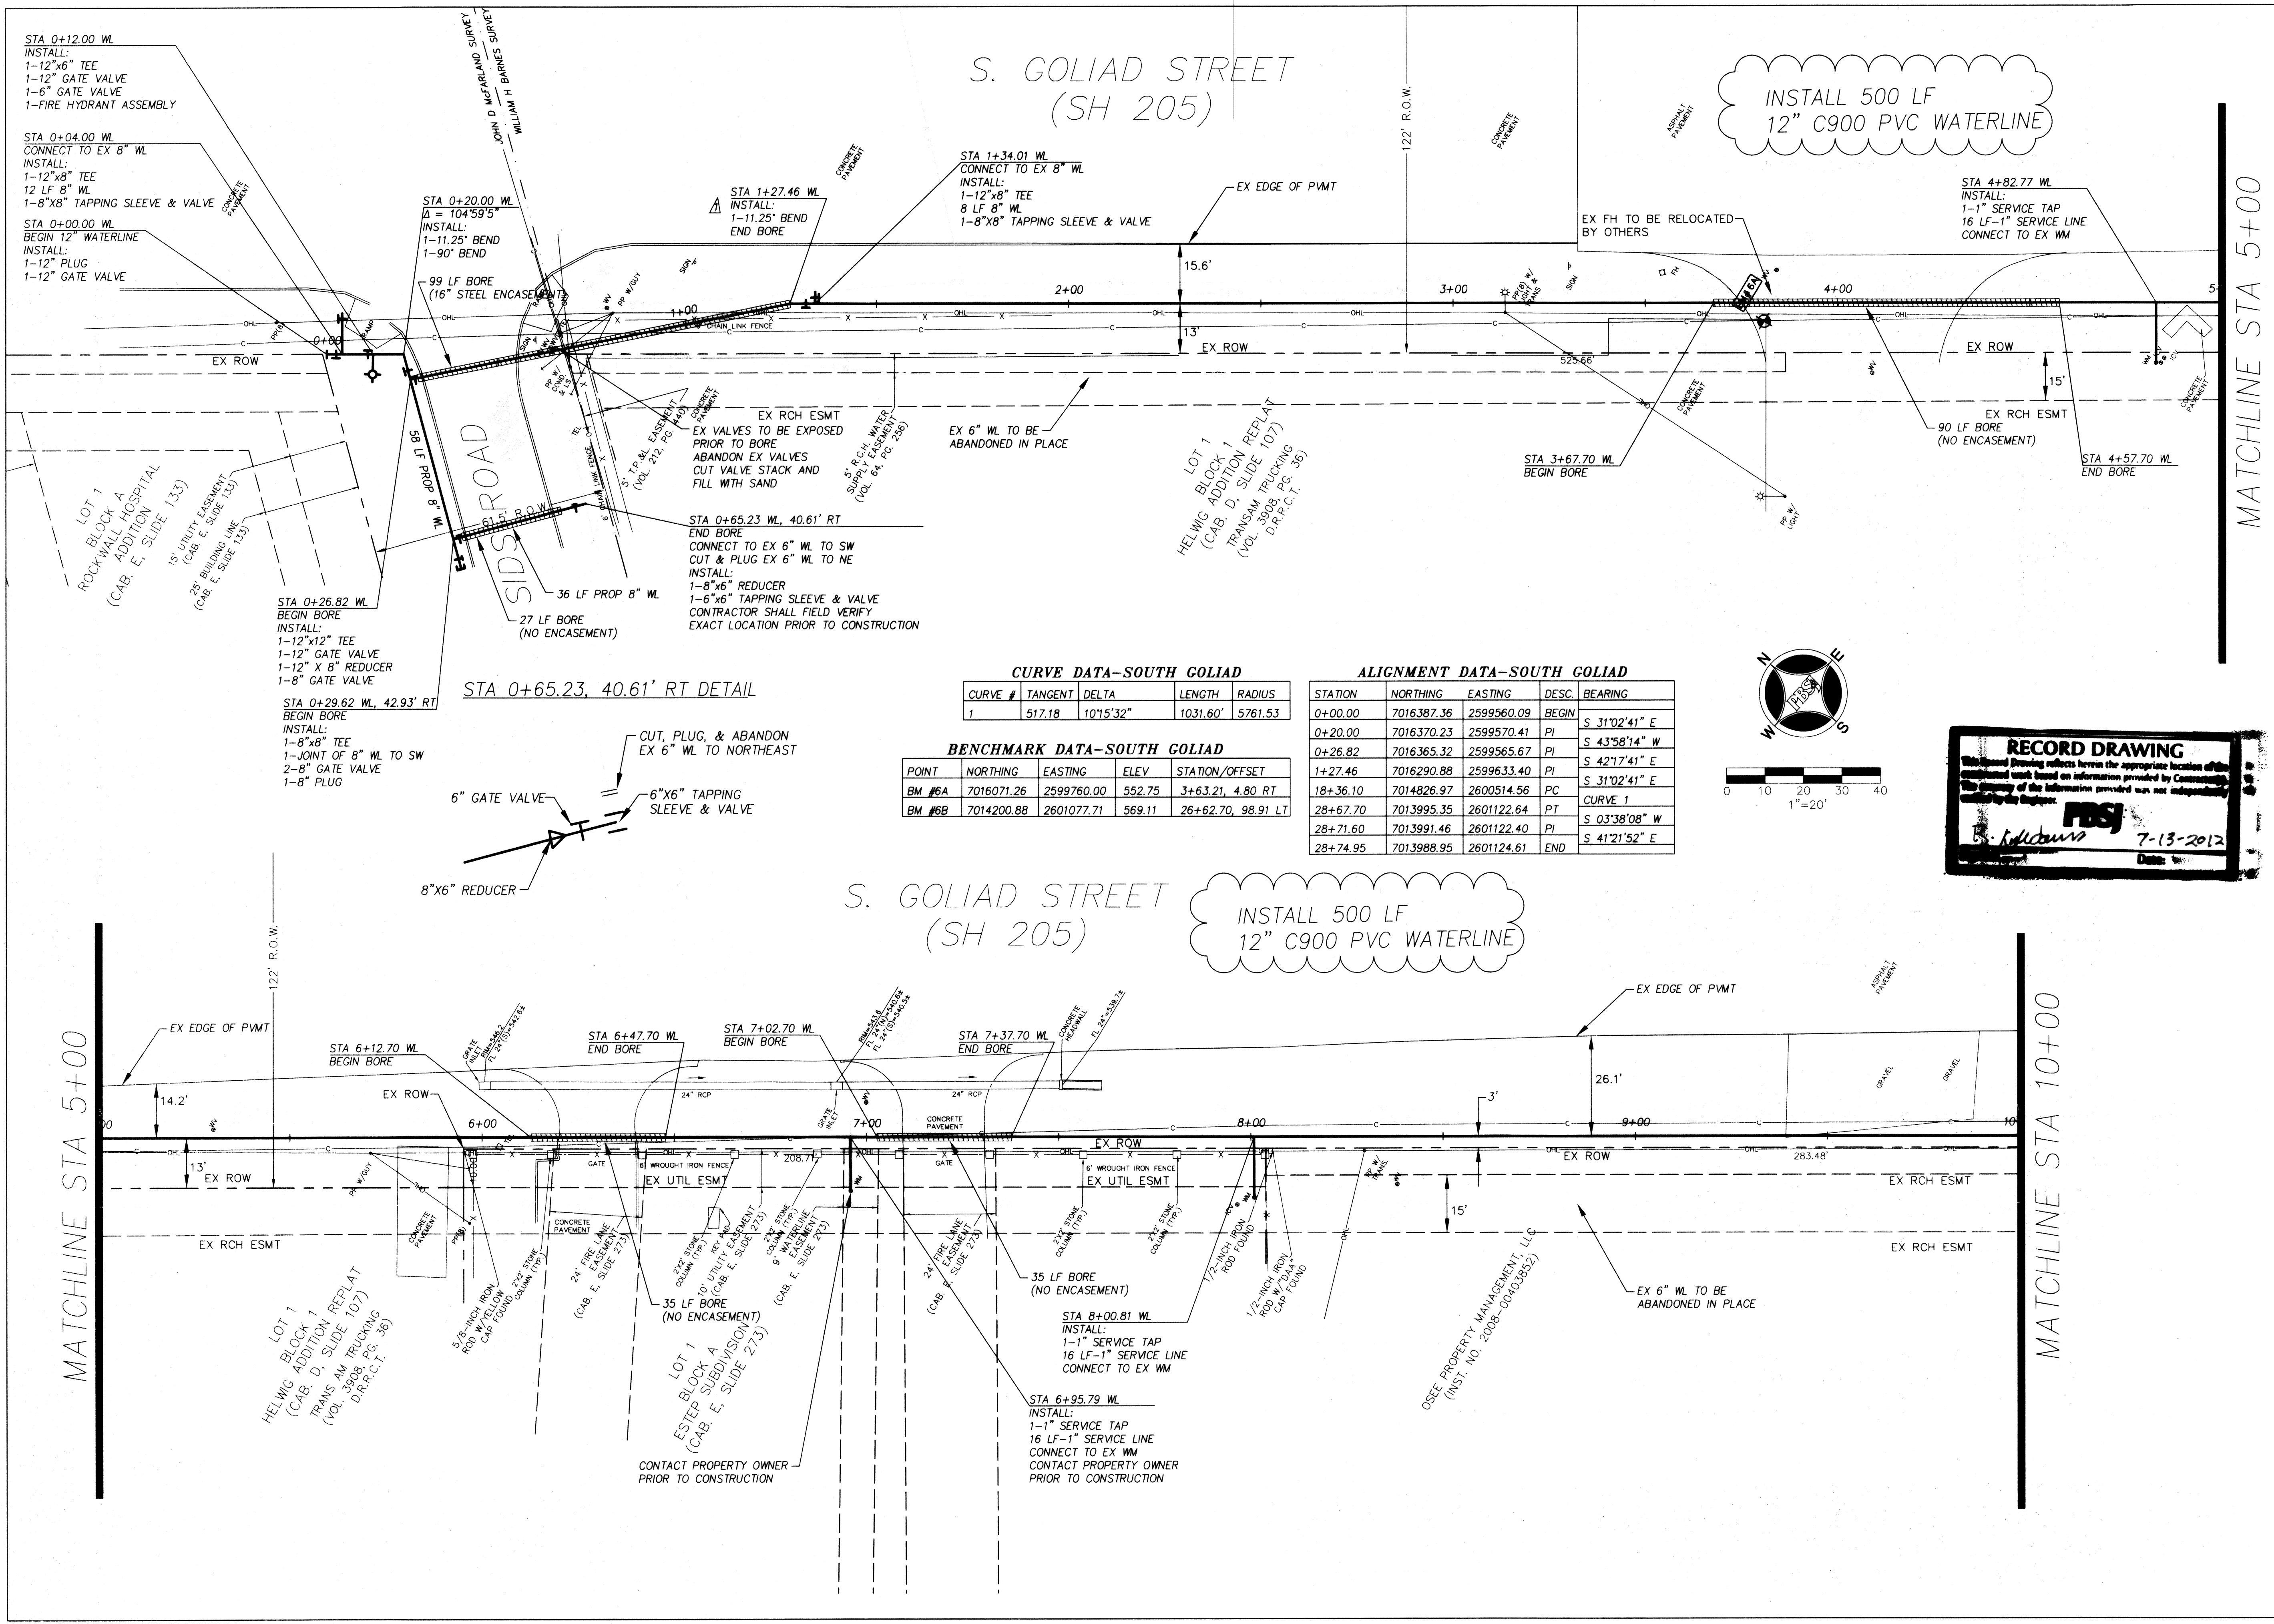

S. GOLIAD STREET
(SH 205)

INSTALL 500 LF
12" C900 PVC WATERLINE

MATCHLINE STA 5+00

MATCHLINE STA 10+00

CURVE DATA-SOUTH GOLIAD



CURVE #	TANGENT	DELTA	LENGTH	RADIUS
1	517.18	10°15'32"	1031.60'	5761.53

BENCHMARK DATA-SOUTH GOLIAD

POINT	NORTHING	EASTING	ELEV	STATION/OFFSET
BM #6A	7016071.26	2599760.00	552.75	3+63.21, 4.80 RT
BM #6B	7014200.88	2601077.71	569.11	26+62.70, 98.91 LT


ALIGNMENT DATA-SOUTH GOLIAD

STATION	NORTHING	EASTING	DESC.	BEARING
0+00.00	7016387.36	2599560.09	BEGIN	S 31°02'41" E
0+20.00	7016370.23	2599570.41	PI	S 43°58'14" W
0+26.82	7016365.32	2599565.67	PI	S 42°17'41" E
1+27.46	7016290.88	2599633.40	PI	S 31°02'41" E
18+36.10	7014826.97	2600514.56	PC	CURVE 1
28+67.70	7013995.35	2601122.64	PT	S 03°38'08" W
28+71.60	7013991.46	2601122.40	PI	S 41°21'52" E
28+74.95	7013988.95	2601124.61	END	

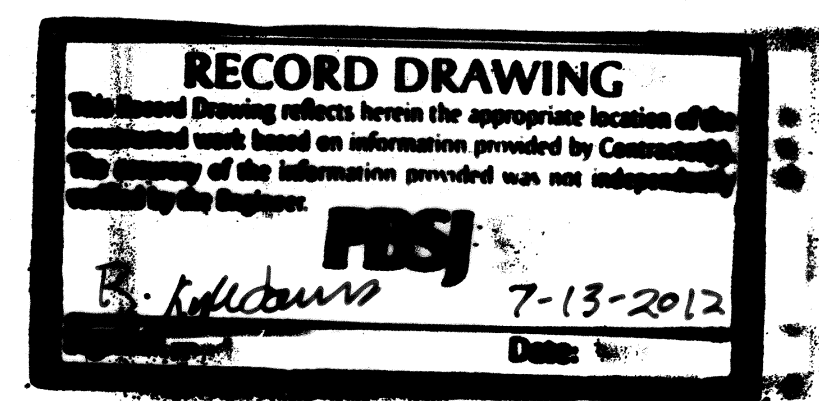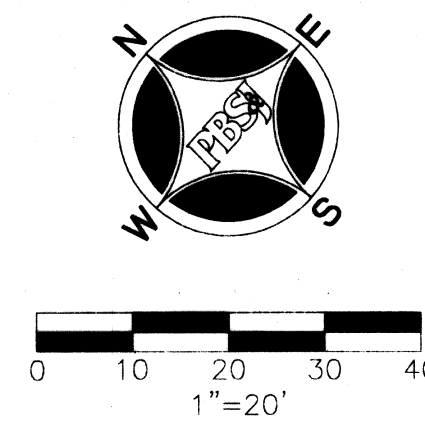


S. GOLIAD STREET
(SH 205)

INSTALL 500 LF
12" C900 PVC WATERLINE

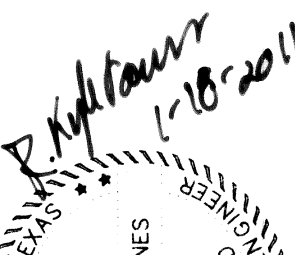

CITY OF ROCKWALL
WATERLINE REPLACEMENT PROJECTS
SOUTH GOLIAD WATERLINE REPLACEMENT
STA 0+00 TO STA 10+00

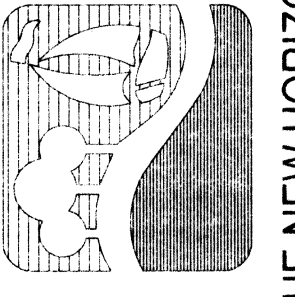

"THE NEW HORIZON"

NO.	REVISION	DATE	BY	DATE
1	EXTEND BORE TO 1+27.00	1/18/2011	RKJ	

DESIGN: RKJ	CHECKED: TBS
DRAWN: RKJ	APPROVED: PBS&J





TBPE #F-474
18383 PRESTON ROAD - SUITE 500
DALLAS, TEXAS 75252
PH (972) 818-7210 FAX (972) 880-8808

PBS&J JOB NO.: 100010908
DATE: JANUARY 2011
FILE:


SCALE: HOR: 1"=20'

SHEET 9 OF 13

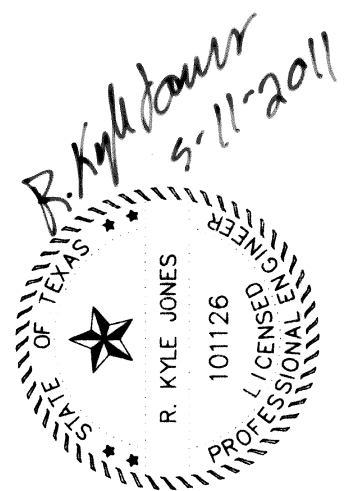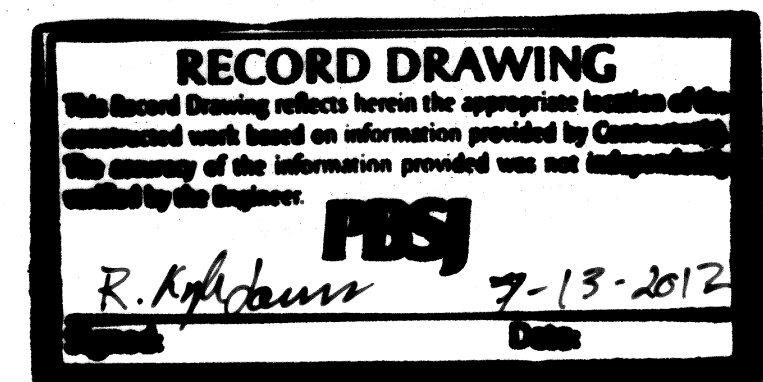

*CITY OF ROCKWALL
WATERLINE REPLACEMENT PROJECTS*

SOUTH GOLIAD WATERLINE REPLACEMENT
STA 10+00 TO STA 20+00

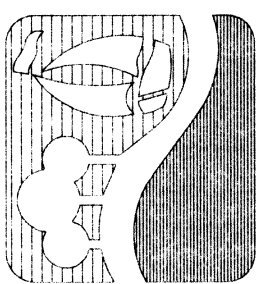

'THE NEW HORIZON'

NO.	REVISION	BY	DATE
1	REVISE ENCASUREMENT TO 18"	RKJ	5/11/2011
2	RECORD DRAWINGS	RKJ	5/22/2012

PBS&J **TBPE #F-474**
 18388 PRESTON ROAD - SUITE 500
 DALLAS, TEXAS 75252
 PH (972) 818-7275 FAX (972) 980-8869

PBS&J JOB NO.: 100010908
 DATE: JANUARY 2011
 DESIGN: RKJ
 CHECKED: TBS
 DESIGNED: TBS

SCALE: HOR: 1"=20'

SHEET

INSTALL 480 LF
8" C900 PVC WATERLINE

NOTE:
CONTRACTOR SHALL INSTALL WL
ACROSS KERNODLE ST BY
OPEN CUTTING HALF OF THE
STREET AT A TIME. CONTRACTOR
MUST MAINTAIN ACCESS AT ALL TIMES.

WATER SERVICE FROM
WILLIAMS STREET

STA 2+26 KERNODLE WL, 37' LT
CONNECT TO EX 2" WL
CUT, PLUG, ABANDON EX 2" WL TO SOUTH
END BORE
BACKFILL 16 LF OF 2" WL WITH
FLOWABLE FILL (NO EXTRA PAY ITEM)

LOT 2
DEBORAH C WINES
(VOL. 3666, PG. 102)

STA 2+07 KERNODLE WL
INSTALL:
1-2" SERVICE TAP
30 LF 2" WL

WATER SERVICE FROM
WILLIAMS STREET

LOT 1
PATRICIA A MAY
(VOL. 1716, PG. 323)

BLOCK 1
PATRICIA A. MAY ADDITION
(CAB. E, SLIDE 310)

EX 2" WL TO BE
ABANDONED IN PLACE

EX ROW

5' TYPICAL

ASPHALT PAVEMENT

EX ROW

GRAVEL

BRICK

WOOD DECK

5' WRIGHT IRON FENCE

1-STORY FRAME HOUSE

STA 0+00.00 KERNODLE WL

INSTALL:
1-8"x8" TAPPING SLEEVE & VALVE
BEGIN 8" WATERLINE
CONNECT TO EX 8" WL
CONTRACTOR SHALL FIELD
VERIFY EXACT LOCATION
PRIOR TO CONSTRUCTION

STA 0+99.56 KERNODLE WL

INSTALL:
1-1" SERVICE TAP
13 LF 1" SERVICE LINE
CONNECT TO EX WM

BLOCK 5
FARMERS & MERCHANTS
ADDITION
(CAB. R, SLIDE 313)

PEREIRA MOACYR
(INST. NO. 2010-00432643)

APPROPRIATE ENCROACHMENT
(ADDITIONAL RESEARCH MAY
BE NECESSARY TO VERIFY
RIGHT-OF-WAY)

STA 2+16.59 KERNODLE WL

INSTALL:
1-2" SERVICE TAP
115 LF 2" WL
BEGIN BORE
BACKFILL 10 LF OF 8" WL WITH
FLOWABLE FILL (NO EXTRA PAY ITEM)

CONNECT 2" SERVICE LINE TO EX WM

CONNECT 2" SERVICE LINE TO EX WM

WILLIAMS ST
(SH 66)

55' R.O.W.

EX ROW

EX ROW

CROSSING @ 2+26.59

EXISTING GROUND
@ C/L OF WATERLINE

4' MIN

PROPOSED 8" WL IN
16" STEEL ENCASEMENT

3.6%

STA 2+63.35 KERNODLE
END ENCASEMENT
F/L ELEV=562.72

EX 6" SS
O F/L=558.0±

STA 2+26.59 KERNODLE
BEGIN ENCASEMENT
F/L ELEV=564.04

EX ROW

EX ROW

STA 2+74 KERNODLE WL

INSTALL:
1-2" SERVICE TAPS
137 LF 2" SERVICE LINE
CONNECT TO EX WM

REMOVE & REPLACE
30 SF CONC WALK
4" 3000 PSI

30 LF BORE
(6" STEEL ENCASEMENT)

REMOVE & REPLACE
7 LF 12" CMP

ASPHALT PAVEMENT

EX ROW

EX ROW

LOT 1-R

BLOCK 2

BUTTGEN ADDITION

(CAB. F, SLIDE 222)

JAMES D BUTTGEN

EX ROW

EX ROW

KERNODLE STREET

EX ROW

EX ROW

00'011

LOT 1
DEAN R. CALDWELL AND
SPOUSE, HOLLY A. CALDWELL
(VOL. 2424, PG. 157)

AUSTIN STREET

INSTALL 250 LF
8" C900 PVC WATERLINE

BLOCK 12
FARMERS & MERCHANTS
ADDITION
(CAB. R, SLIDE 313)

DOUGLAS RAY ROAN
(VOL. 559, PG. 86)

PART OF L
CHAD J. HUDS
LINDSAY B. H.
(VOL. 3364, P

PART OF
CHAD J. HUDS
LINDSAY B. H.
(VOL. 3364, P

MATCHLINE STA 2+50

BLOCK 5
FARMERS & MERCHANTS
ADDITION
(CAB. R, SLIDE 313)

PEREIRA MOACYR
(INST. NO. 2010-00432643)

LISANNE PLACE
(VOL. 3019, PG. 247)

WILLIAMS ST (SH 66)

STA 0+00.00 WILLIAMS WL
INSTALL:
1-8"X8" TAPPING SLEEVE
& VALVE
CONNECT TO EX 8" WL
CONTRACTOR SHALL FIELD
EXACT LOCATION PRIOR
TO CONSTRUCTION

CHARLES CHASTAIN, JR.
(INST. NO. 2006-00363982)

STA 0+54.34 WILLIAMS WL
INSTALL:
1-1" SERVICE TAP
4 LF-1" SERVICE LINE
CONNECT TO EX WMS

FARMERS & MERCHANTS
ADDITION
(CAB. R, SLIDE 313)

JAMES H. CROW
(VOL. 1142, PG. 185)

REMOVE & REPLACE
12 SF CONC WALK
4" 3000 PSI

REMOVE & REPLACE
10 SY CONC DRIVE
5" 3600 PSI

STA 1+39.79 WILLIAMS WL
INSTALL:
2-1" SERVICE TAP
50 LF-1" SERVICE LINE
29 LF BORE
29 LF 4" STEEL ENCASEMENT
CONNECT TO EX WM

STA 2+00.00 WILLIAMS WL
PI
Δ=0'40'29" LT

STA 2+33.08 WILLIAMS WL
INSTALL:
1-1" SERVICE TAP
42 LF-1" SERVICE LINE
29 LF BORE
29 LF 4" STEEL ENCASEMENT
CONNECT TO EX WM

LOT 1
ON AND
UDSON
G. 241)

PART OF LOT 1
CONNIE L. RIDDELL
(VOL. 1761, PG. 245)

PARKS STREET

LOT 2
BLOCK B
FOREE'S ADDITION
(BOOK 12, PG. 569)
JASON A. POTTS AND
ANNA A. POTTS
(VOL. 3661, PG. 59)

PART OF LOT 1
JASON A. POTTS AND
ANNA A. POTTS
(VOL. 3661, PG. 59)

MICHAEL WHITLEY
AND SPOUSE,
SANDRA H. WHITLEY
(VOL. 3913, PG. 25)

RECORD DRAWING
This drawing reflects the approved location of the
proposed work based on information provided by the owner.
The accuracy of the information provided can not be guaranteed
by the Engineer.

PBS
R. Kyle Jones 7-13-2012

MATCHLINE STA 2+50

WILLIAMS ST
(SH 66)

STA 2+80.98 WILLIAMS WL
INSTALL:
1-1" SERVICE TAP
3 LF-1" SERVICE LINE
CONNECT TO EX WM

STA 3+60.84 WILLIAMS WL
INSTALL:
1-8"X6" TEE
1-8" GATE VALVE
1-6" GATE VALVE
1-FIRE HYDRANT ASSEMBLY

STA 3+63.93 WILLIAMS WL
PI
Δ=3'36"14" LT

STA 4+77.57 WILLIAMS WL
PI
Δ=40'11"22" LT
INSTALL:
1-8" 45° BEND
BEGIN ENCASEMENT

STA 4+98.67 WILLIAMS WL
CONNECT TO EX 8" WL
REMOVE EX PLUG
END ENCASEMENT

INSTALL:
1-8" 45° BEND
CONTRACTOR SHALL FIELD
VERIFY EXACT LOCATION
PRIOR TO CONSTRUCTION

PEGGY JEAN PANNELL SMITH
(INST. NO. 2009-00419598)

WATER SERVICE FROM
NORTH CLARK STREET



SCOTT W. WENTZEL
AND WIFE,
JANSY J. WENTZEL
(VOL. 1872, PG. 256)

NORTH CLARK STREET



INSTALL 247 LF
8" C900 PVC WATERLINE

ALIGNMENT DATA-WILLIAMS


STATION	NORTHING	EASTING	DESC.	BEARING
0+00.00	7028646.57	2595449.54	BEGIN	N 89°21'13" E
2+00.00	7028648.83	2595649.53	PI	N 88°40'44" E
3+63.93	7028652.61	2595813.42	PI	N 85°04'30" E
4+77.57	7028662.36	2595941.52	PI	N 44°53'07" E
4+98.67	7028677.31	2595941.52	PI	

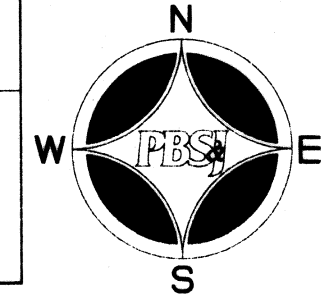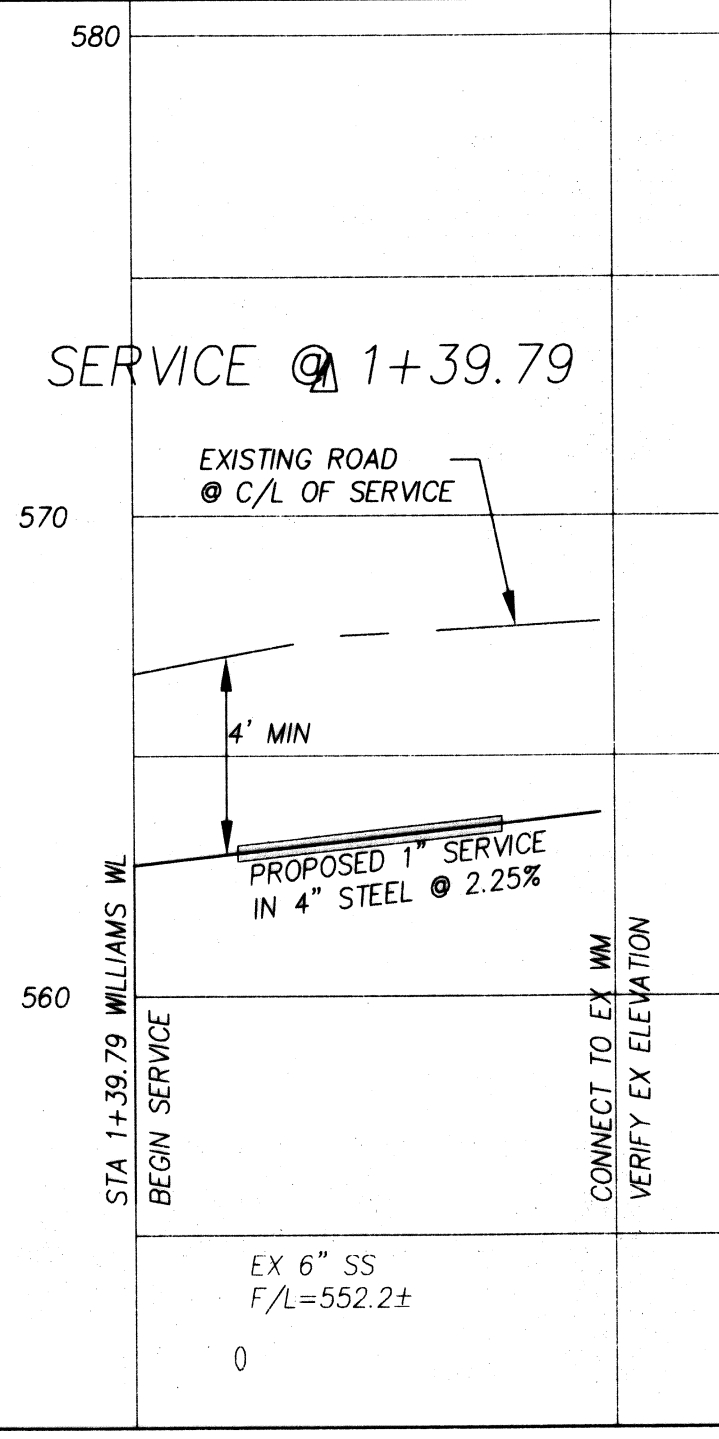

0 10 20 30 40
1"=20'

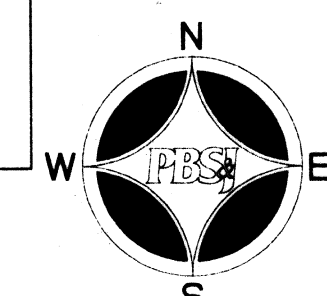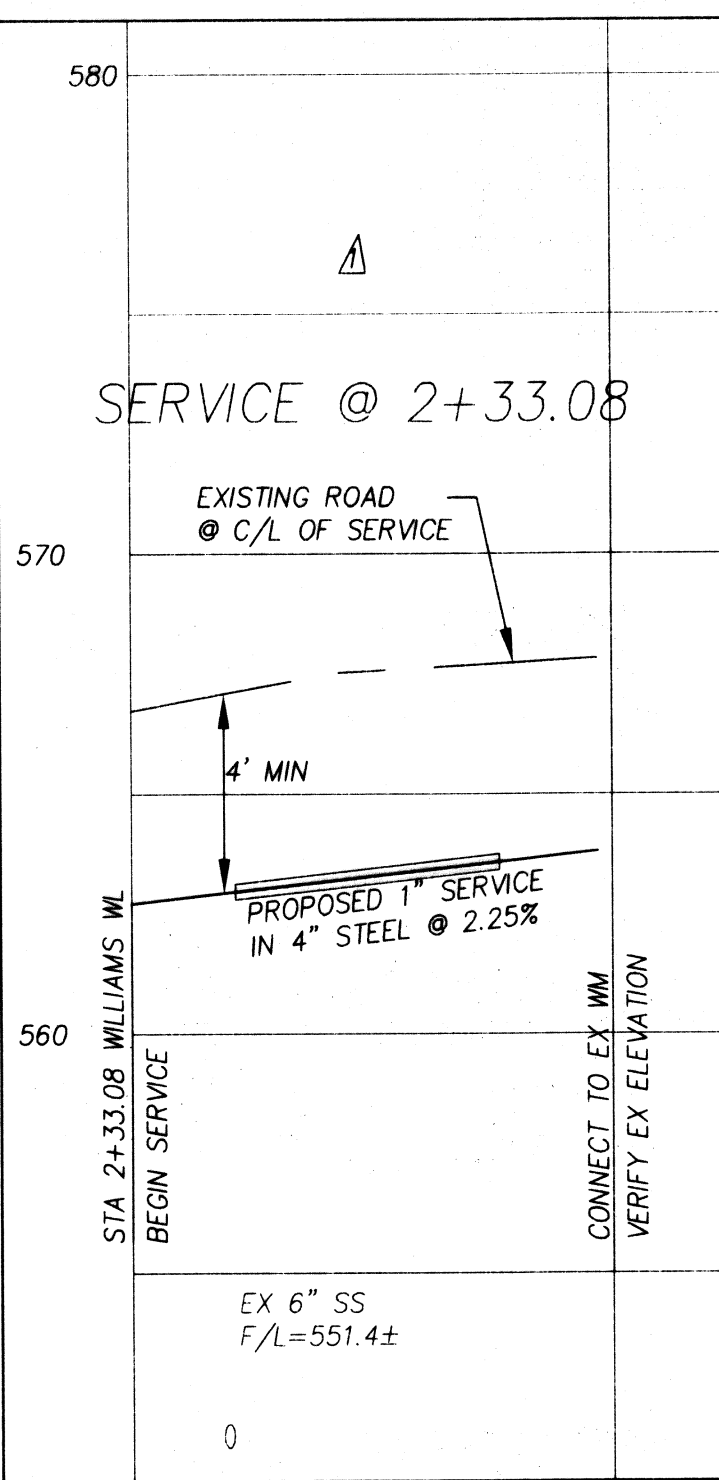


0 10 20 30 40
1"=20'

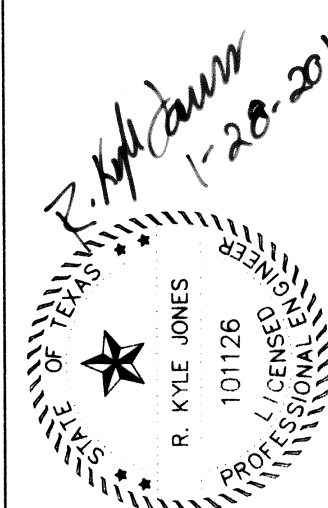

CITY OF ROCKWALL
WATERLINE REPLACEMENT PROJECTS

WILLIAMS WATERLINE REPLACEMENT

STA 0+00 TO 4+98

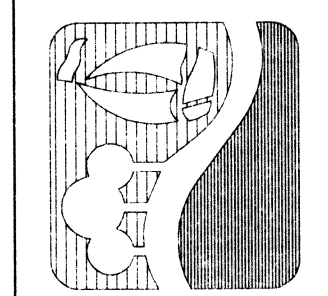

"THE NEW HORIZON"

NO.	REVISION	BY	DATE
1	ADDED WL PROFILE FOR CROSSING RKJ	RKJ	1/28/2011
2	ALIGNMENT REVISION 2+00 TO END RKJ	RKJ	1/28/2011
3	RECORD DRAWINGS	RKJ	5/23/2012
DESIGN: RKJ			
DRAWN: RKJ			
CHECKED: TBS			
APPROVED: PBS&J			

FILE:

DATE: JANUARY 2011

PBS&J JOB NO: 100010908

SCALE: HOR: 1"=20'
VER: 1"=4'

SHEET 13A OF 13