



DRAINAGE AREA MAP

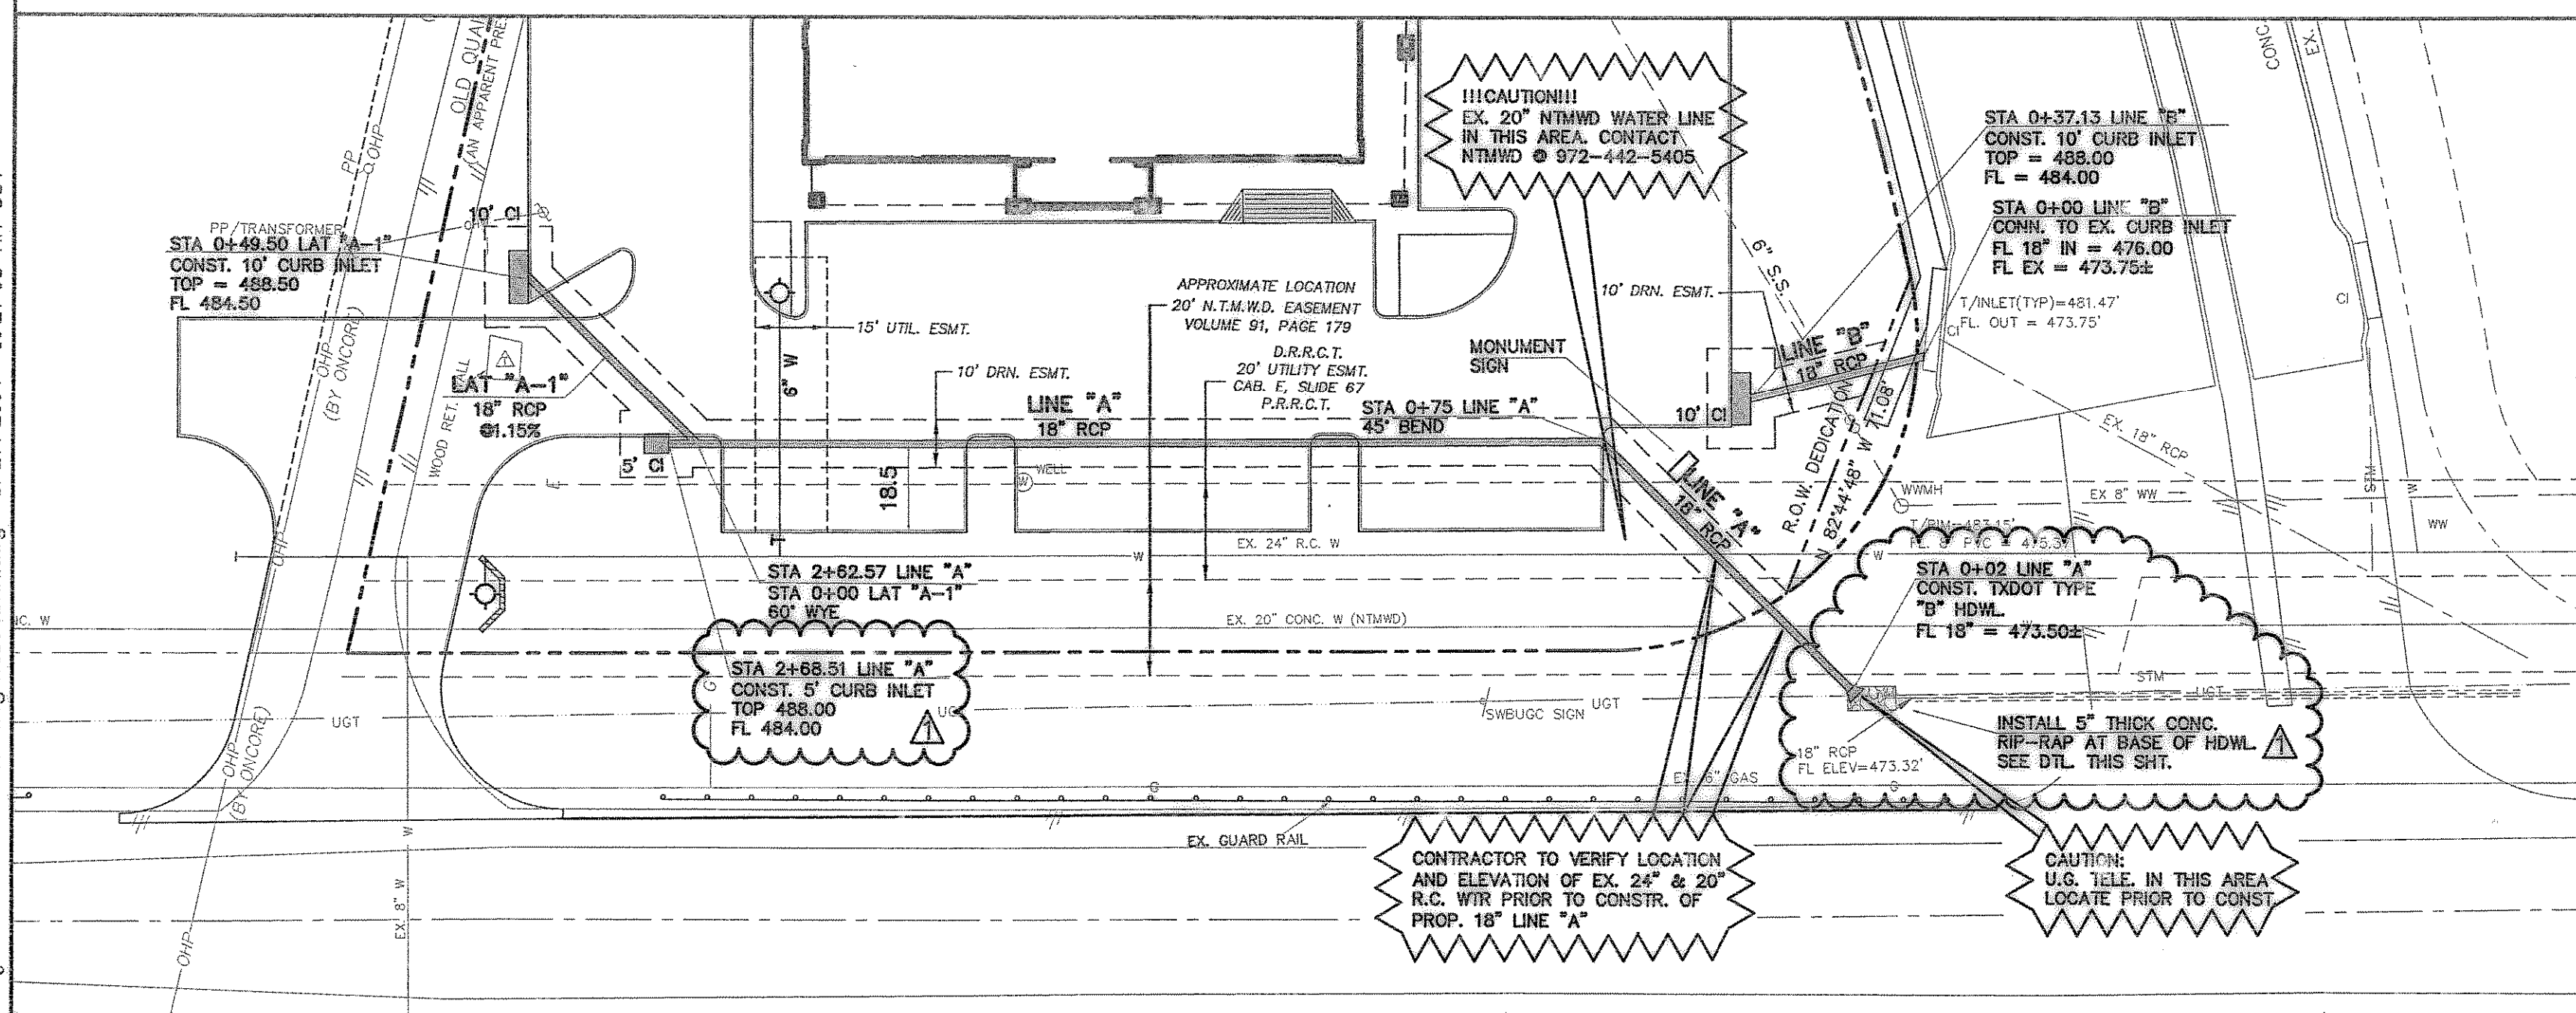

DRAINAGE PLAN

NOTES


- See Sht. C8 for General Notes and Drainage Notes.
- See Sht. C5 for Utility Design.
- See Sht. C6 for Utility Profiles.
- See Cover Sheet for NTMWD General Notes.
- For open cut, where crossing under the NTMWD's pipeline within ten feet either side of centerline of pipeline, the trench width to be cut shall be limited to four-foot vertical walls, no sloping bank with the appropriate trench safety. The entire excavation within the limits noted above shall be back filled with gravel to one-foot above top of the NTMWD's pipeline. One-foot minimum vertical clearance is required between the NTMWD's pipeline and proposed utilities.
- Franchised utilities, water, sanitary sewer and storm sewer facilities are not permitted in the 15' NTMWD easement except for crossings.
- Please note that excavation adjacent to the NTMWD's pipeline and appurtenances to install the proposed improvements shall be performed so that the pipeline or appurtenances are not displaced or damaged. Any damage to the pipeline or appurtenances shall be repaired to the satisfaction of the NTMWD. Further, any cost for repair of damage to the pipeline or appurtenances resulting from construction by the developer or contractor will be the responsibility of the developer.

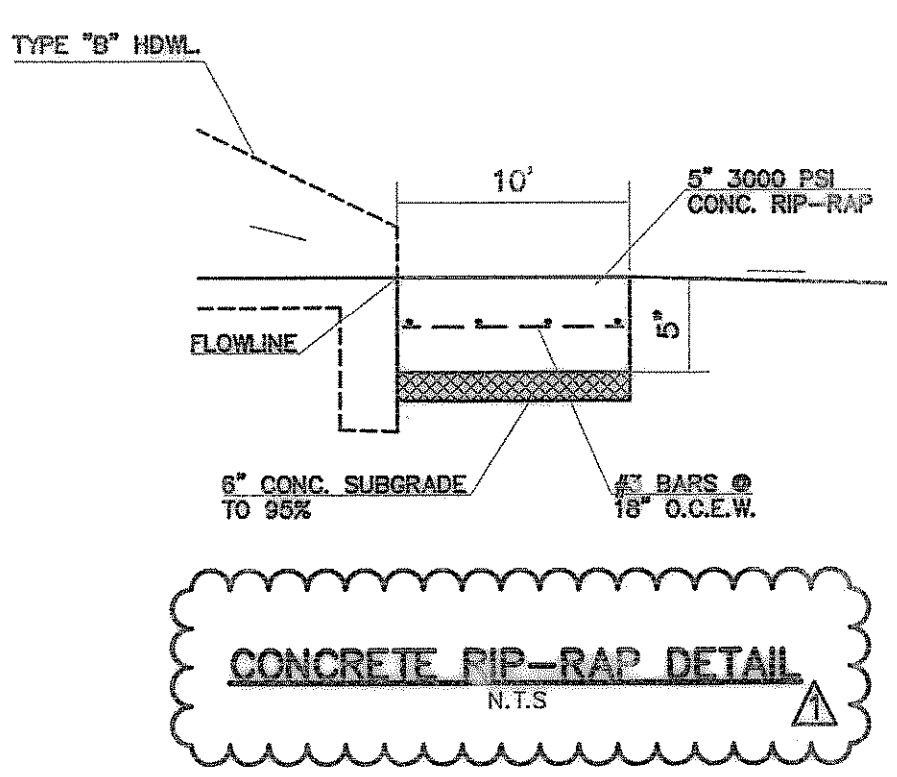

CONSTRUCTION RECORDS
 DATE: *1/14/04* BY: *J.J.V.*
 THIS DRAWING INDICATES THE WORK COMPLETED FOR INFORMATION SUPPLIED BY THE CONTRACTOR. ACTUAL ON THE GROUND SURVEY VERIFICATION WAS NOT PERFORMED EXCEPT AS SPECIFICALLY NOTED.

SHEET
C4
OF
8

11/18/03 CONSTRUCTION SET
 J.J.V.
 Revisions
 No. Date
 App.

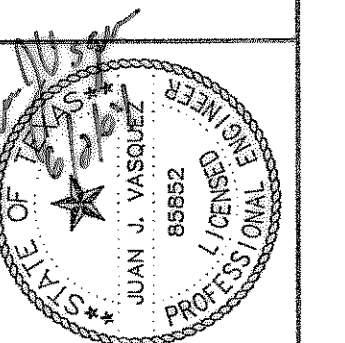

TOMDEN ENGINEERING
 12655 N. CENTRAL EXPY. SUITE 1016
 DALLAS, TX. 75243
 972 366-6446 FAX 972 386-6409
 tomden@mail.net

ECKERD - ROCKWALL, TEXAS
 ARCHITECT:
 GENESIS DESIGN GROUP, INC.
 2080 N. HIGHWAY 350, STE. 200
 GRAND PRAIRIE, TX. 75050
 OWNER:
 MAYS & COMPANY
 5949 SHERRY LANE, # 1570
 DALLAS, TX. 75225

DRAINAGE PLAN & DRAINAGE AREA MAP

Scale: AS NOTED
 Designed by: J.J.V.
 Drawn by: R.W.A./J.K.A.
 Checked by: T.P.J.
 /dwg/268-06/DIC04DAM.dwg
 Date: 05/27/04 10:27