
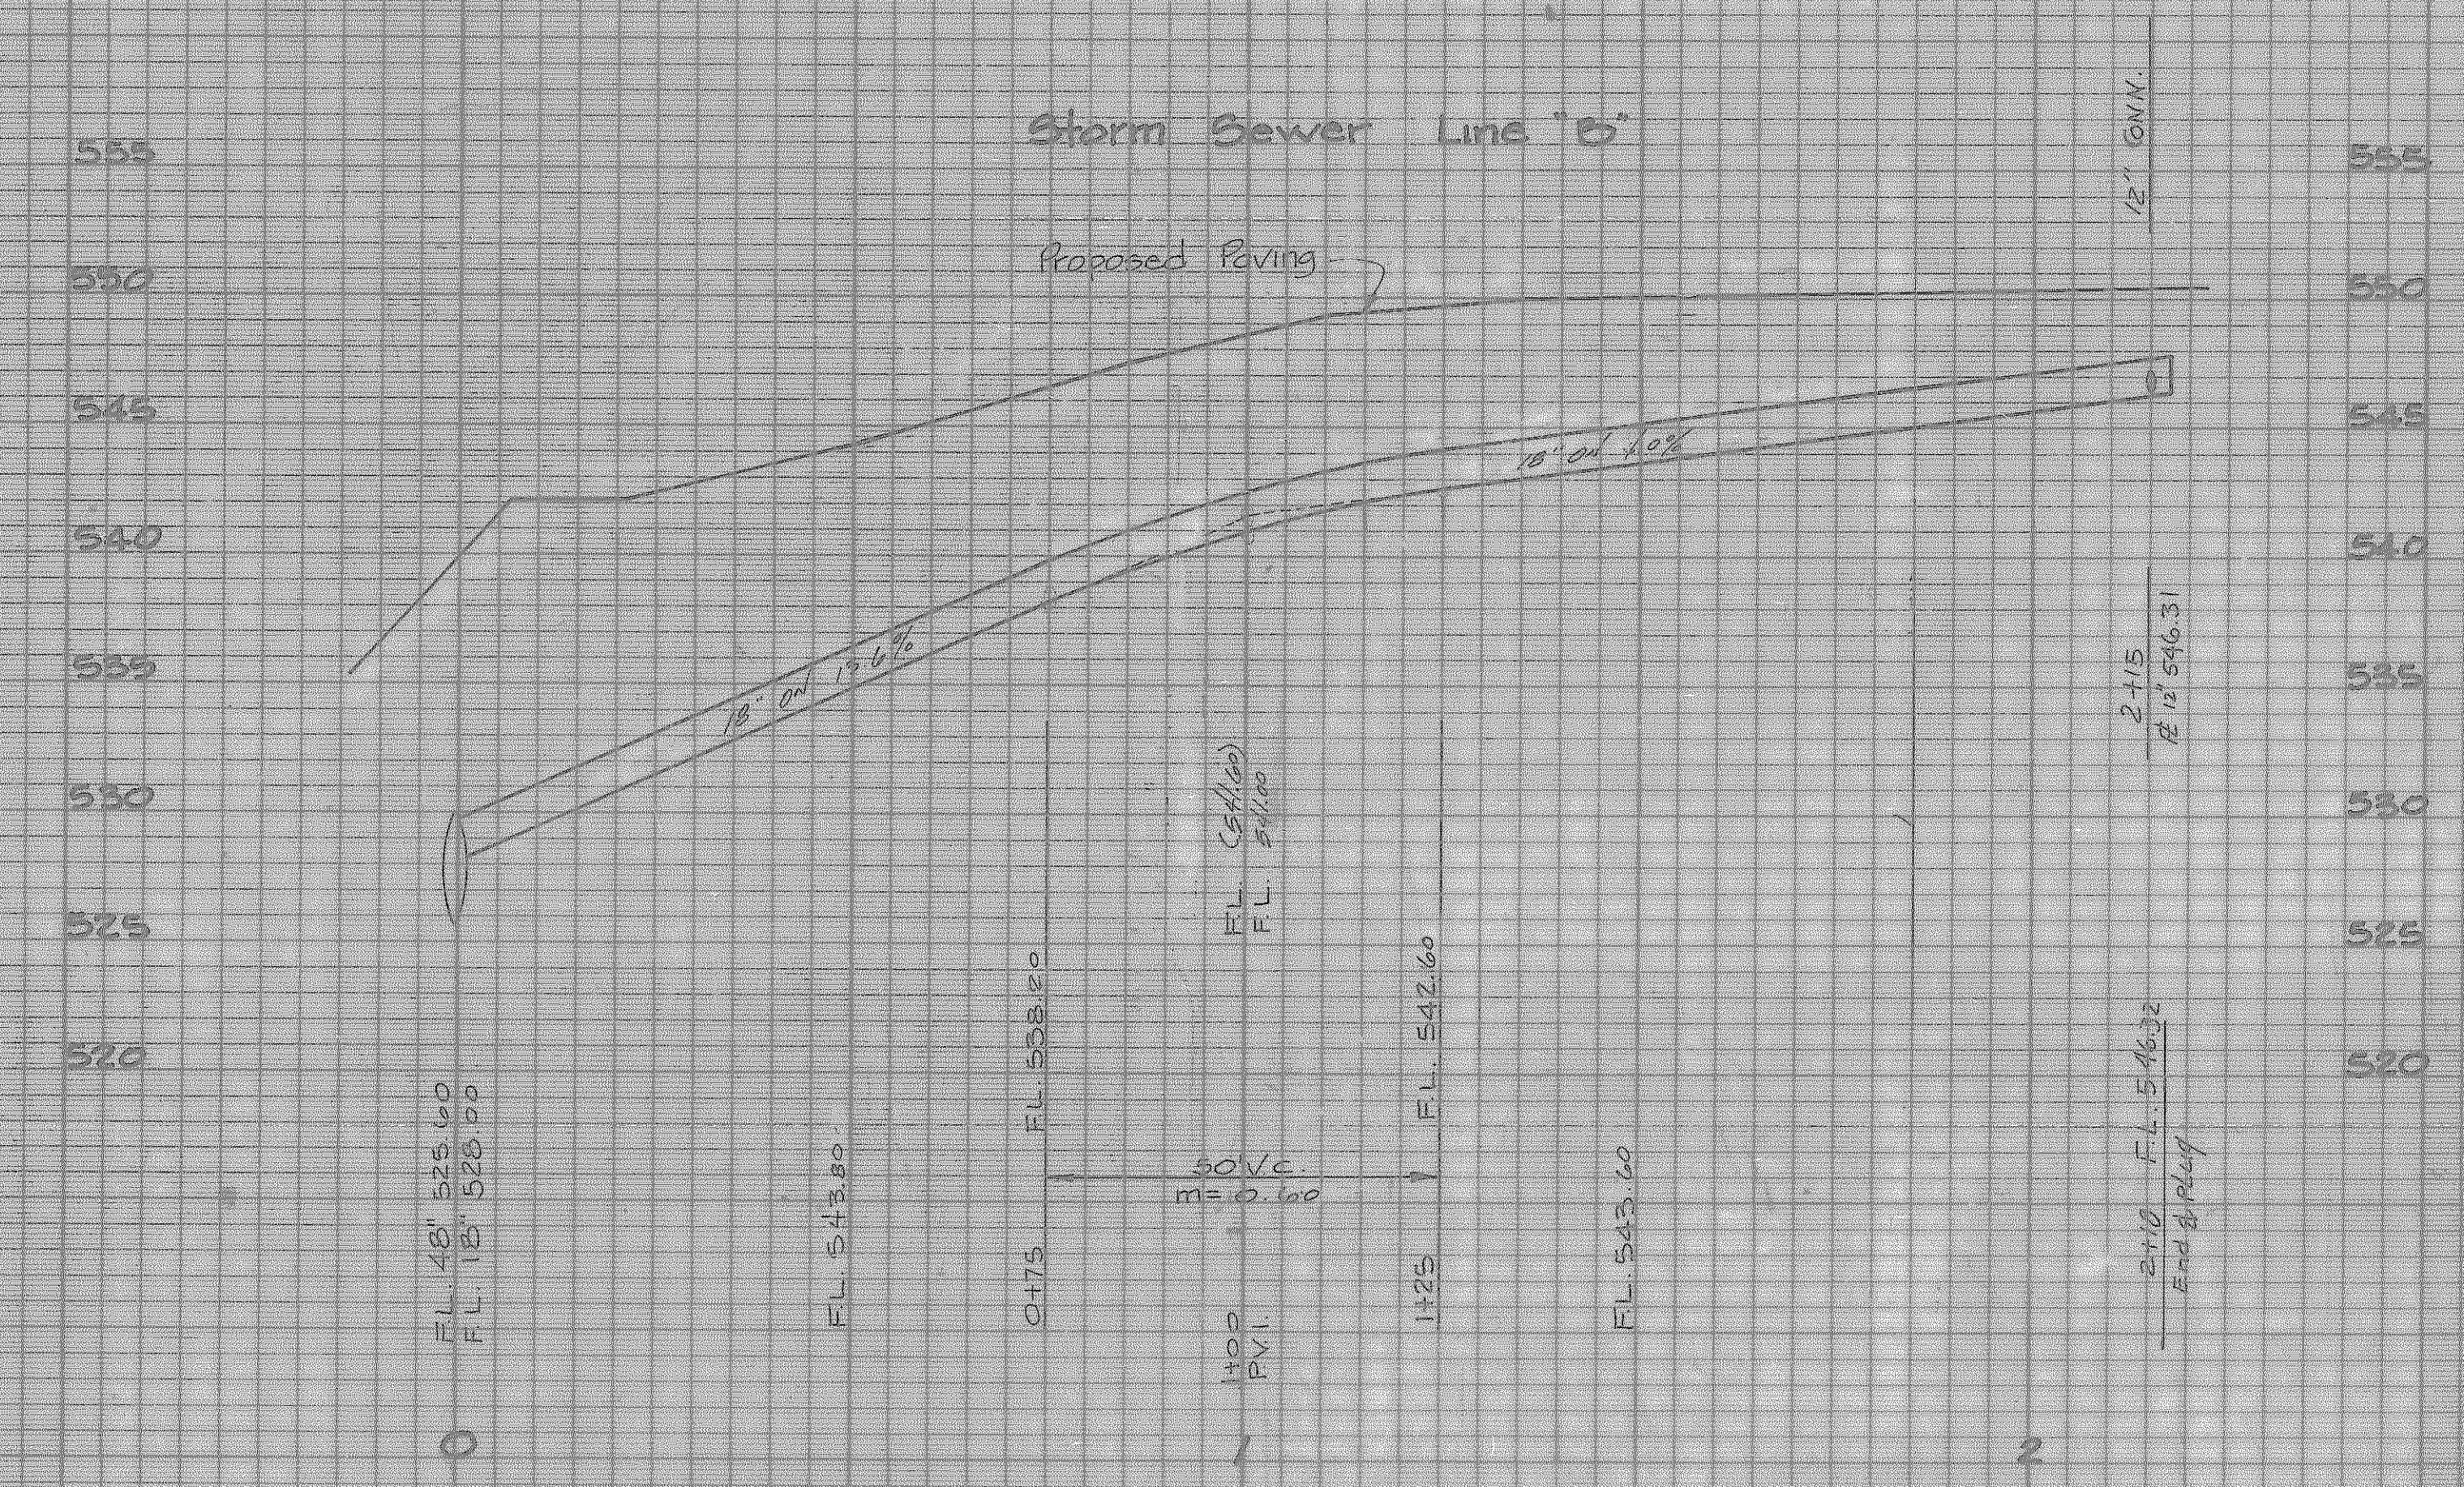


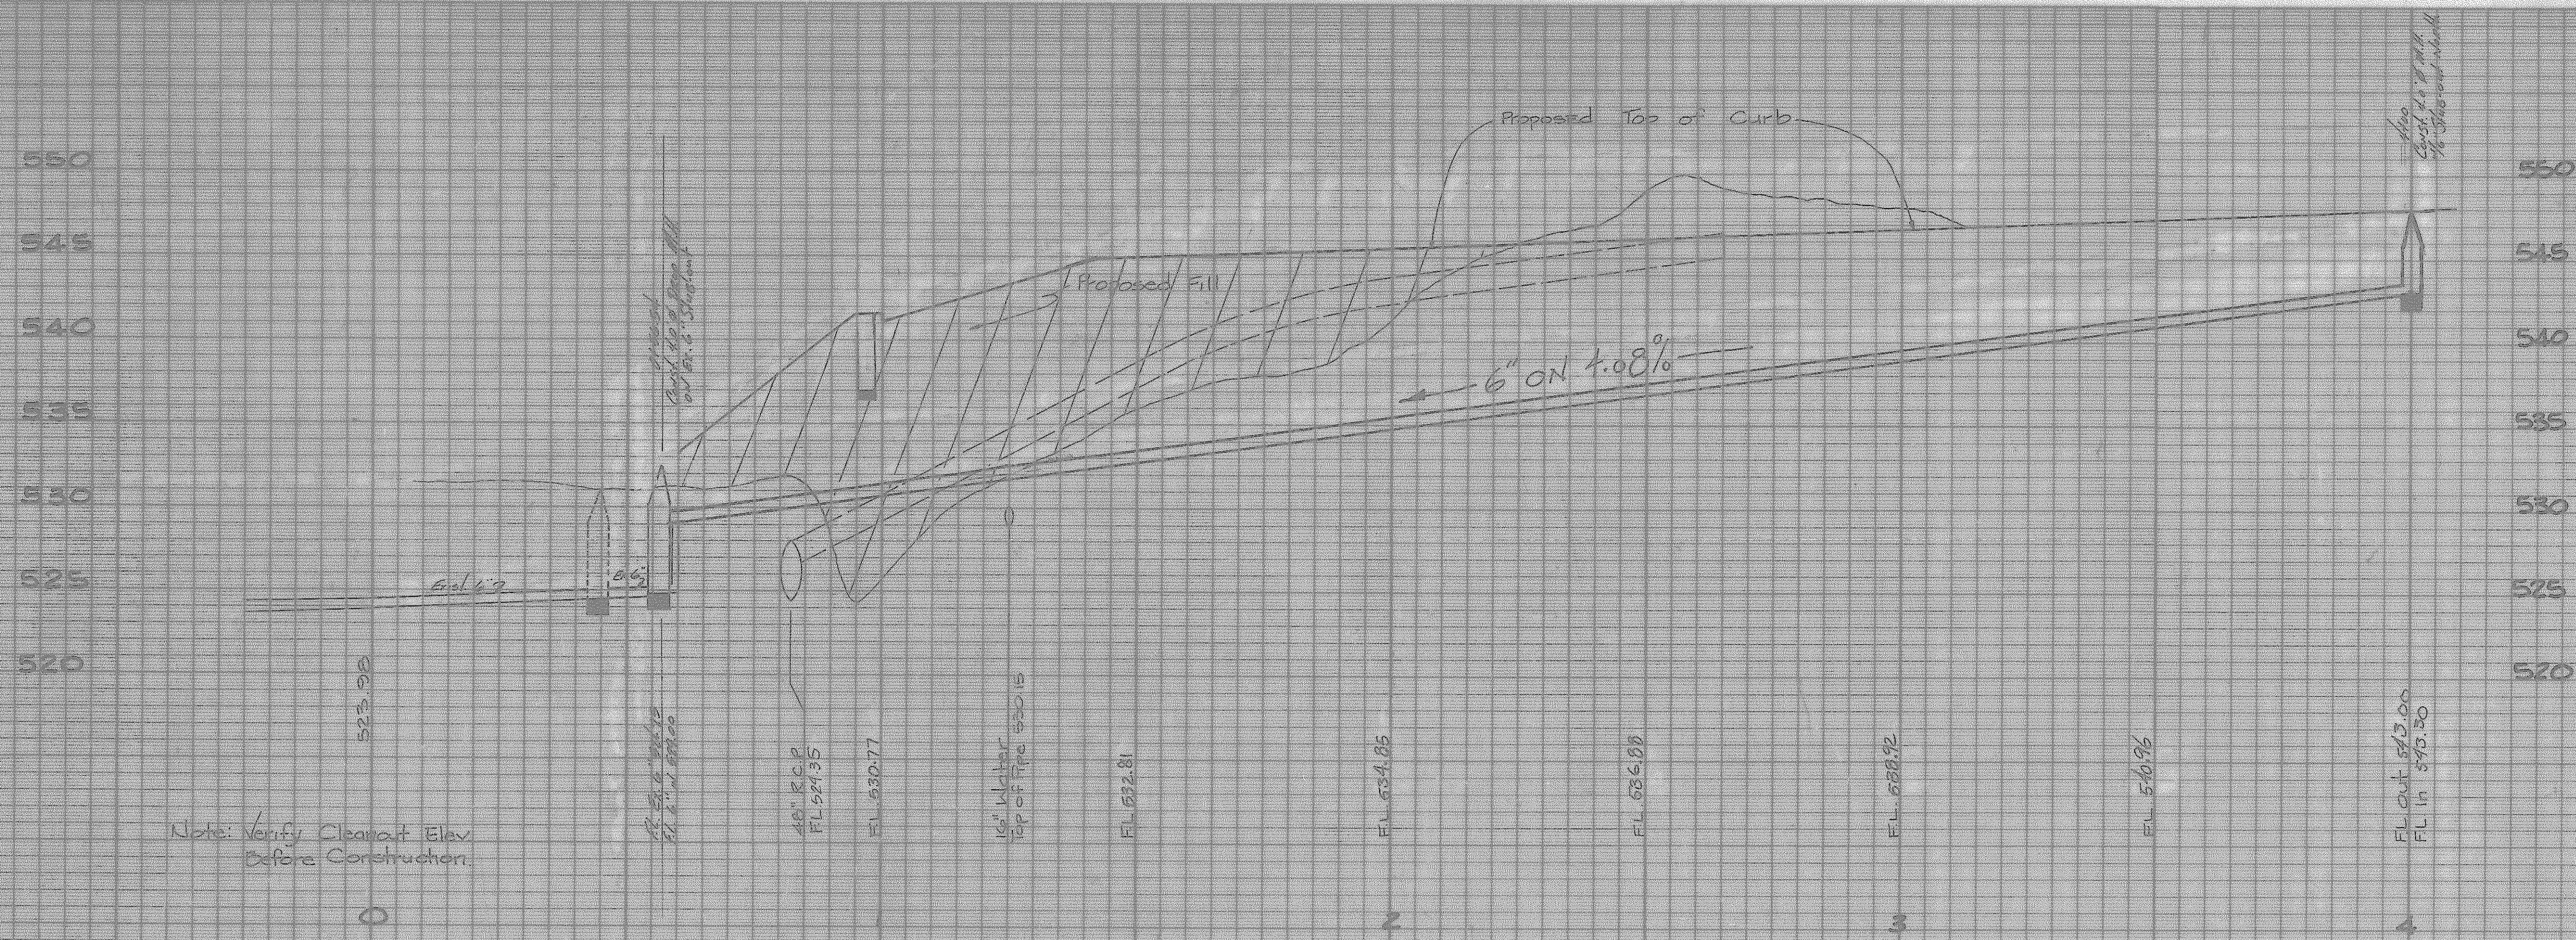

AS BUILT

Sewer Profiles

Cain Properties No. 1

Rockwall County, Texas

HAROLD EVANS - CONSULTING ENGINEER

DESIGN	DRAWN	DATE	SCALE	NOTES	FILE	NO.
H.E.	TLB	9-28-81	1"-20' H 1"-6' V			80102

Revised 5-13-82 Revised 11-29-82