
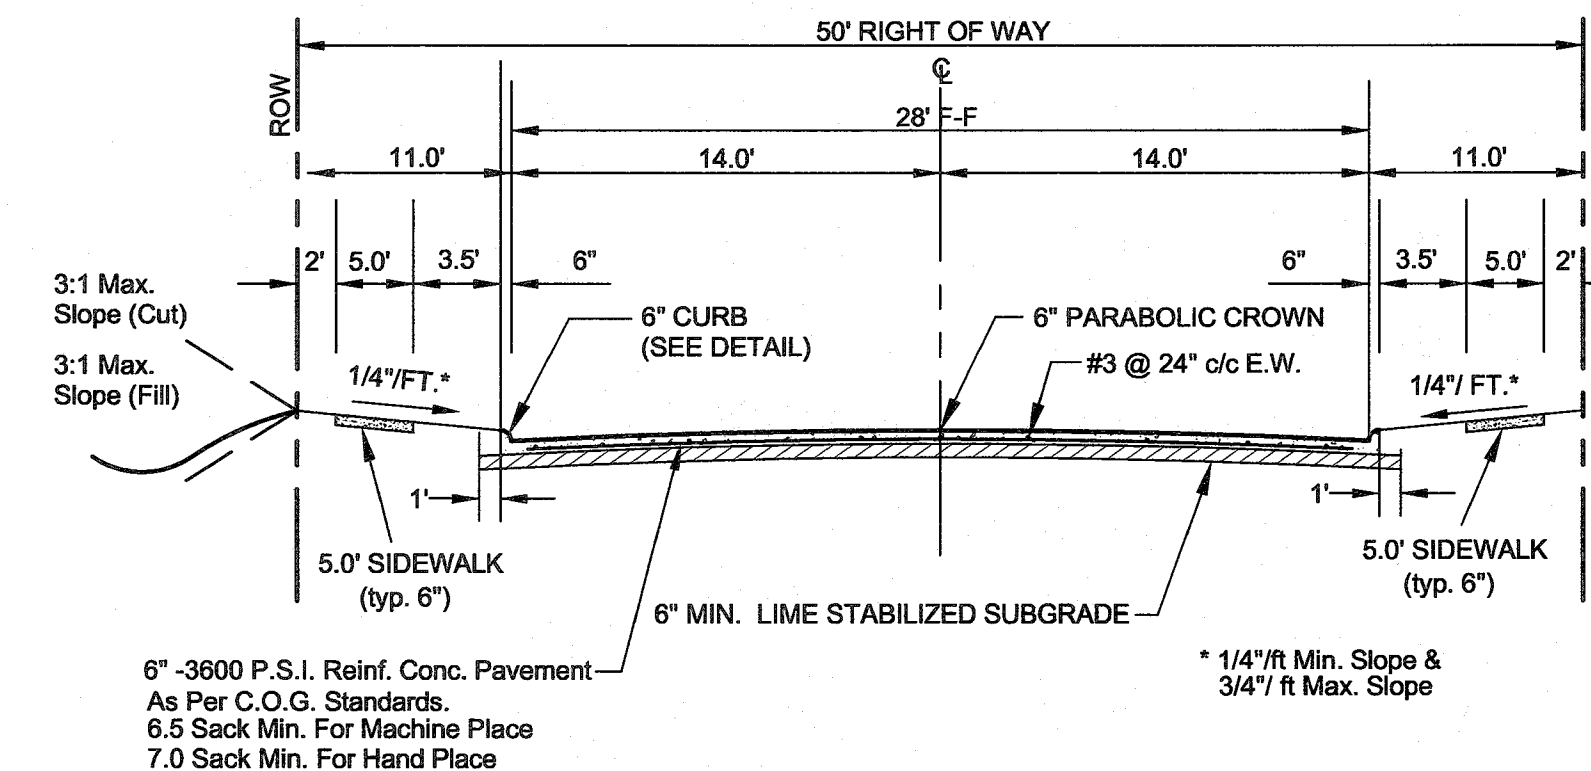



(IN FEET)
 1 inch = 40 ft. Horiz.
 1 inch = 4 ft. Vert.

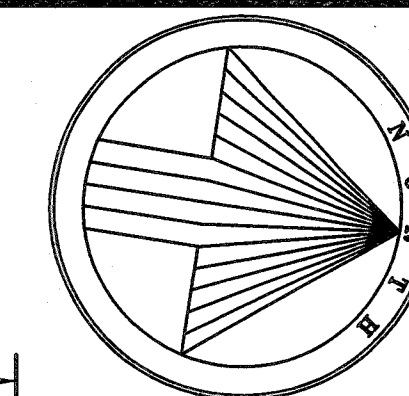

TYPICAL PAVEMENT SECTION (29' B-B)
 N.T.S.

- NOTE:
1. PAVEMENT FOR STREETS SHALL CONSIST OF 6" 3600 P.S.I. REINFORCED CONCRETE AND 6" LIME-STABILIZED SUBGRADE WITH 6" PARABOLIC CROWN.
 2. PAVEMENT FOR ALLEYS SHALL CONSIST OF 4000 P.S.I. REINFORCED CONCRETE AND 6" LIME-STABILIZED SUBGRADE WITH 5" INVERT. TYPICAL ALLEY SECTION WILL BE 7'-5"-7'-7".
 3. CONTRACTOR TO RUN LIME SERIES BEFORE CONSTRUCTION.

ERIE DRIVE

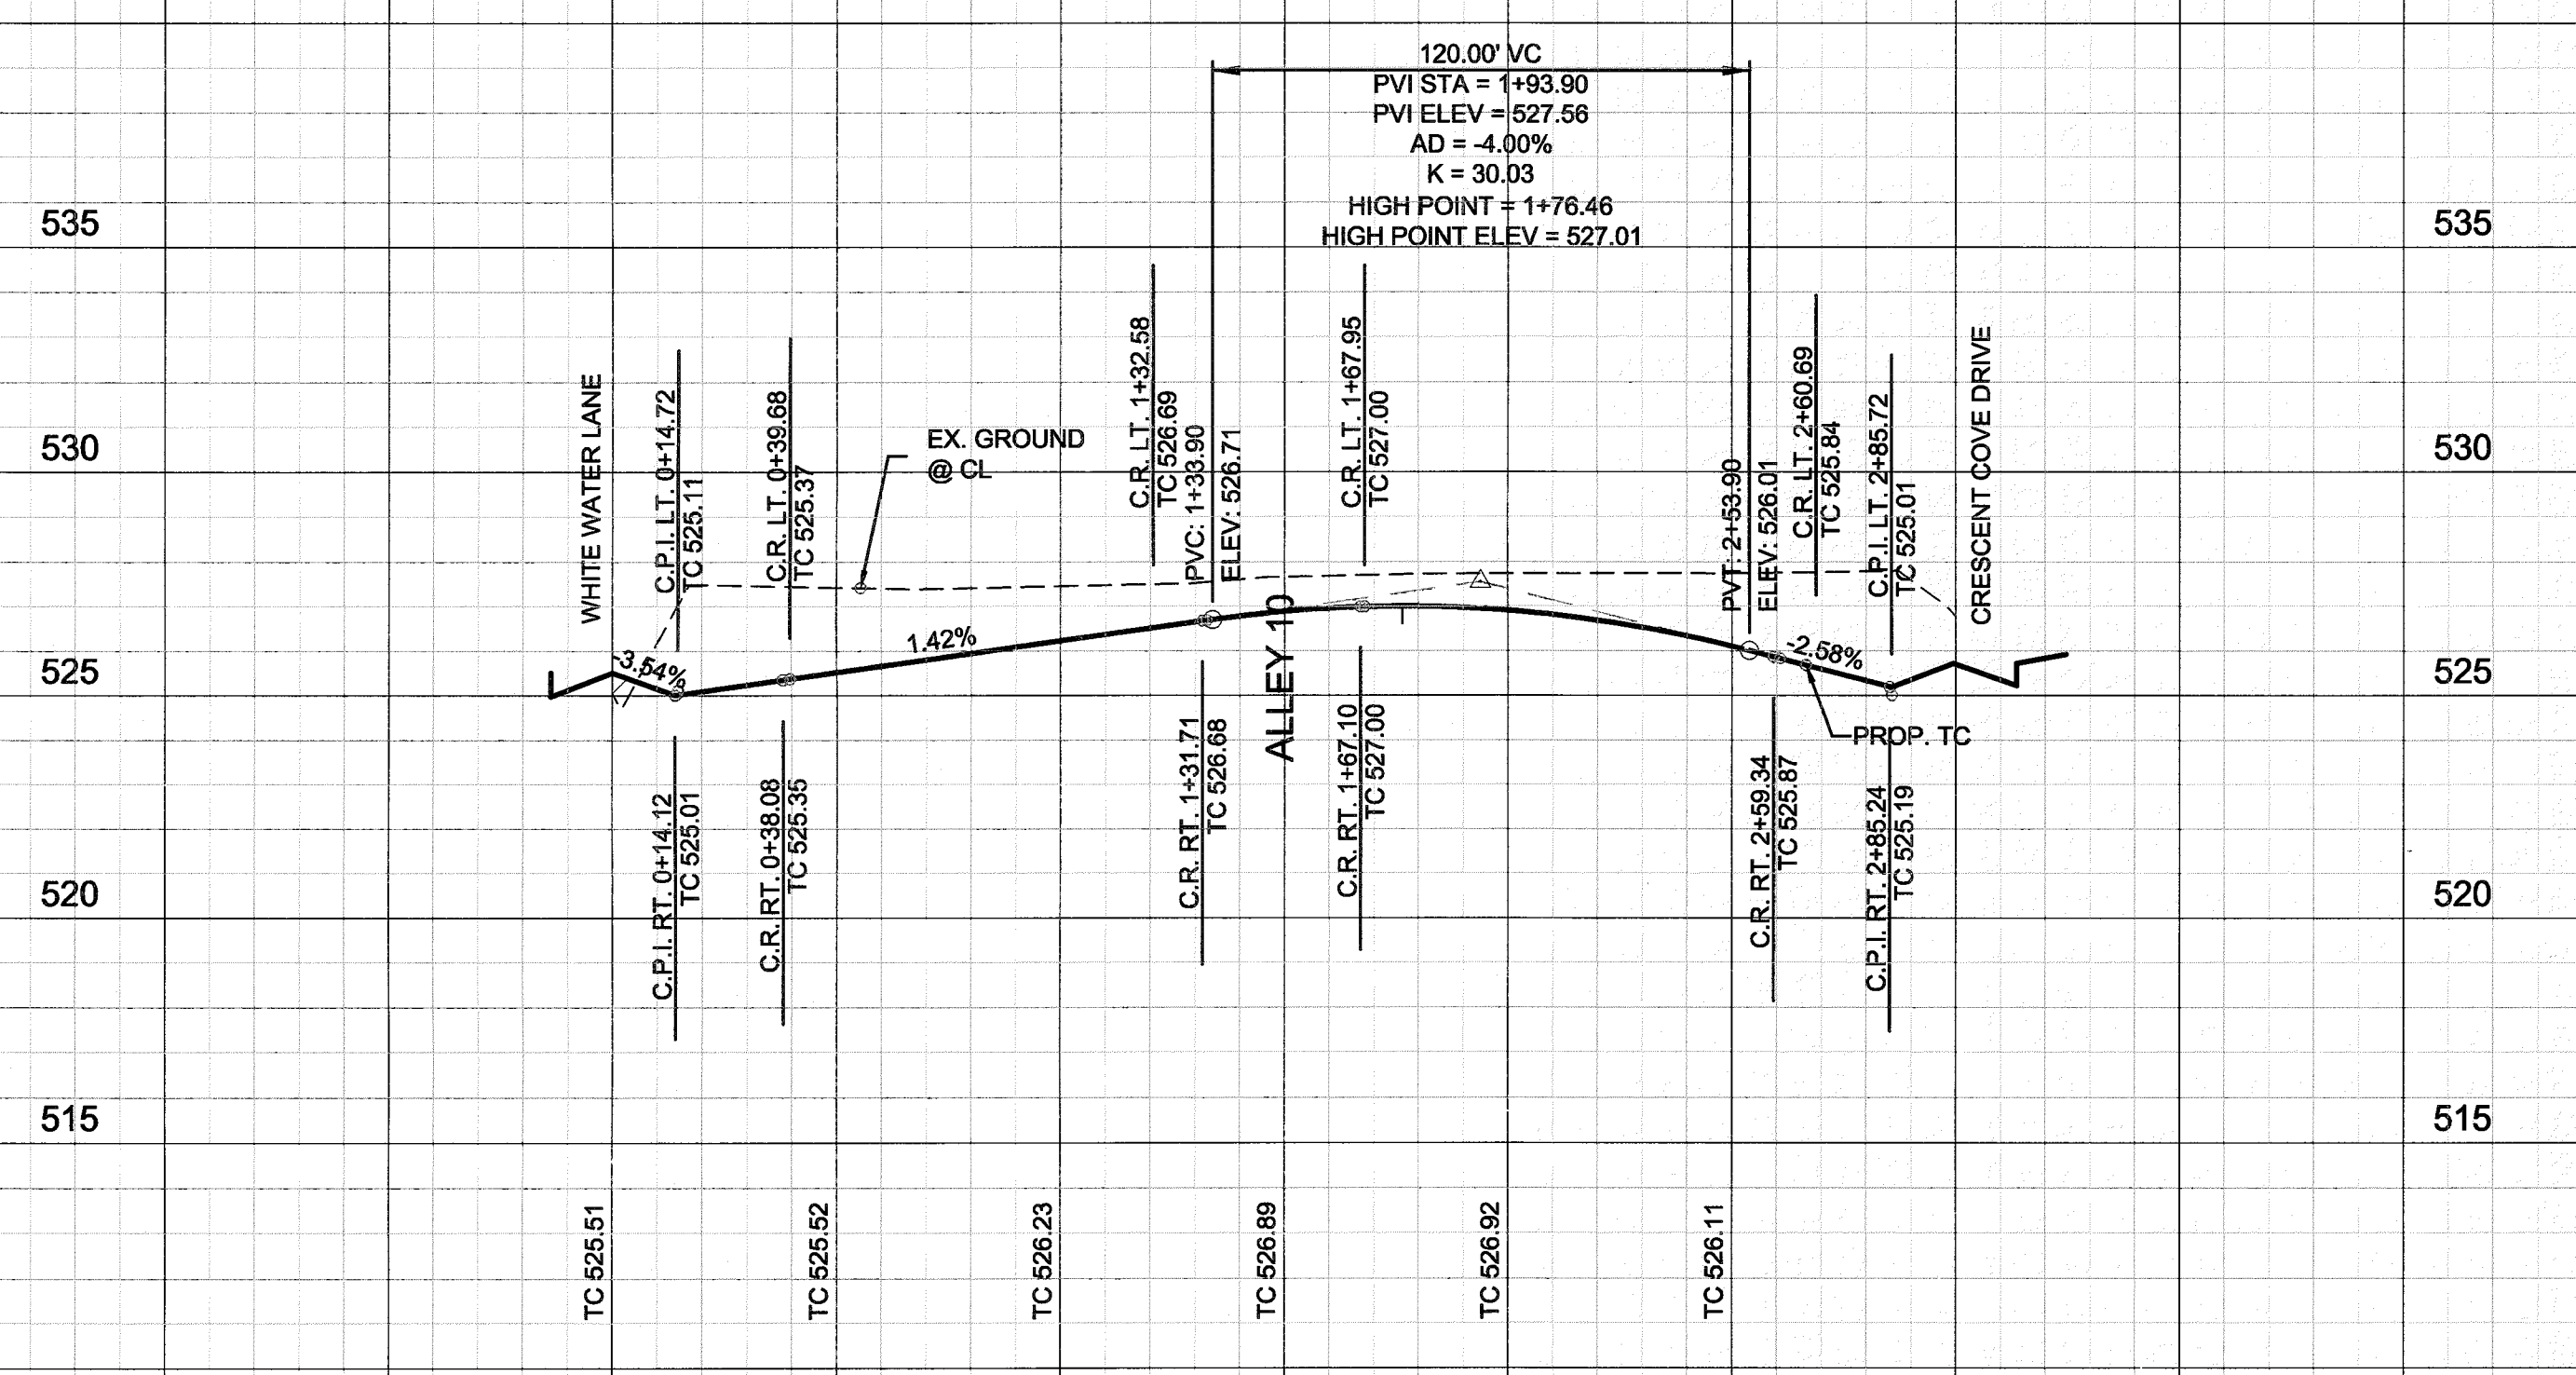

AS-BUILT DRAWINGS: 02/01/2013
 TO THE BEST OF JBI PARTNERS, INC. KNOWLEDGE HEREBY STATES: THIS PLAN IS AS-BUILT. THE INFORMATION PROVIDED IS BASED ON CONSTRUCTION STAKING AND PAD VERIFICATION AT THE SITE AND INFORMATION PROVIDED BY THE CONTRACTOR.
 Daniel Dewey 2-1-13
 Name Date

CONSTRUCTION SET 07-27-12
 ALL RESPONSIBILITY FOR ADEQUACY OF DESIGN REMAINS WITH THE DESIGN ENGINEER. THE CITY OF ROCKWALL, IN REVIEWING AND RELEASING PLANS FOR CONSTRUCTION, ASSUMES NO RESPONSIBILITY FOR ADEQUACY OR ACCURACY OF DESIGN.

- BENCHMARKS**
1. X-chiseled in CL of Alley East of Morningstar Drive within the third lot north of Midnight Pass. Elevation = 513.26
 2. PK Nail in CL of Caruth Lane & Alley intersection 150 feet +/- east of Morningstar Drive. Elevation = 491.68

NO.	REVISIONS DURING CONSTRUCTION	BY	DATE	NO.	SUBMITTALS	DATE

The seal appearing on this document was authorized by DANIEL DEWEY, P.E. 93961. Alteration of a sealed document without proper notification to the responsible engineer is an offense under the Texas Engineering Practice Act.

Daniel Dewey
 7-27-12

JBI PARTNERS
 Texas Registered Engineering Firm F-438

16301 Quorum Drive
 Suite 200 B
 Addison, Texas 75001
 Main 972.248.7676
 Fax 972.248.1414
 www.jbipartners.com

PAVING PLAN		PROJECT NO.
ERIE DRIVE		HOE132
Caruth Lakes Phase 7B		SHEET NO.
City of Rockwall, Texas		6

Drawing: H:\Projects\HOE132B\HOE132-PV(P7H7B).dwg Saved By: ddewey Save Time: 7/25/2012 9:17 AM Plotted By: ddewey Plot Date: 7/25/2012 9:29 AM