

CITY OF ROCKWALL FLOOD STUDY JUNE 2006
TABLE C-5


SQUABEE CREEK TRIBUTARY C
100-YEAR FLOOD ANALYSIS
SUMMARY OF RESULTS
EXISTING AND PROJECTED FULLY-DEVELOPED CONDITIONS

CROSS SECTION #	EXISTING CONDITIONS		PROJECT FULLY-DEVELOPED CONDITIONS	
	PEAK DISCHARGE	SURFACE ELEV.	PEAK DISCHARGE	SURFACE ELEV.
678	345	479.62	418	479.76
767	345	479.77	418	479.94
868	345	480.20	418	480.36
936	345	480.76	418	481.00
1077	345	483.75	418	483.91
1226	397	488.10	418	488.25

General Notes


ALL INFORMATION, EITHER DRAWN, WRITTEN, OR IMPLIED APPEARING ON THIS DOCUMENT SHALL NOT BE DUPLICATED, DISCLOSED OR OTHERWISE USED WITHOUT WRITTEN PERMISSION OF THE AUTHOR.

THIS DOCUMENT IS AN INSTRUMENT OF SERVICE AND IS THE SOLE PROPERTY OF THE AUTHOR. FURTHERMORE, THE USE OF THIS DOCUMENT FOR ANY PURPOSE SHALL BE REVOKED IF THE INTENT OF THE DESIGN OR THE CONSTRUCTION TECHNIQUES OR DETAILS SHOWN HEREIN ARE NOT ADHERED TO OR THE CONTRACTUAL AGREEMENT GOVERNING THEIR USE IS NOT STRICTLY ADHERED TO.

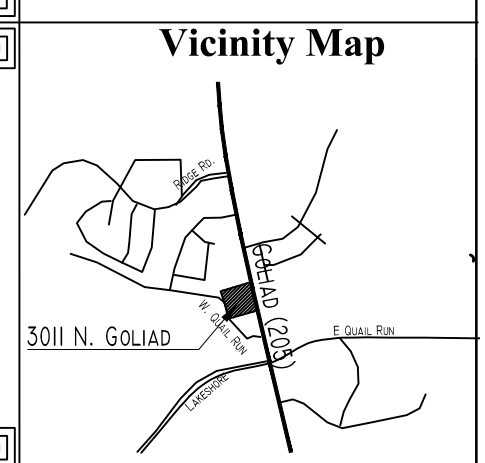

Copyright

No.	Revision/Issue	Date
2	CONTRACT DRAWINGS	3/12/16
3	RETAINING WALL	8/12/16
4	FF-488.5	9/13/16

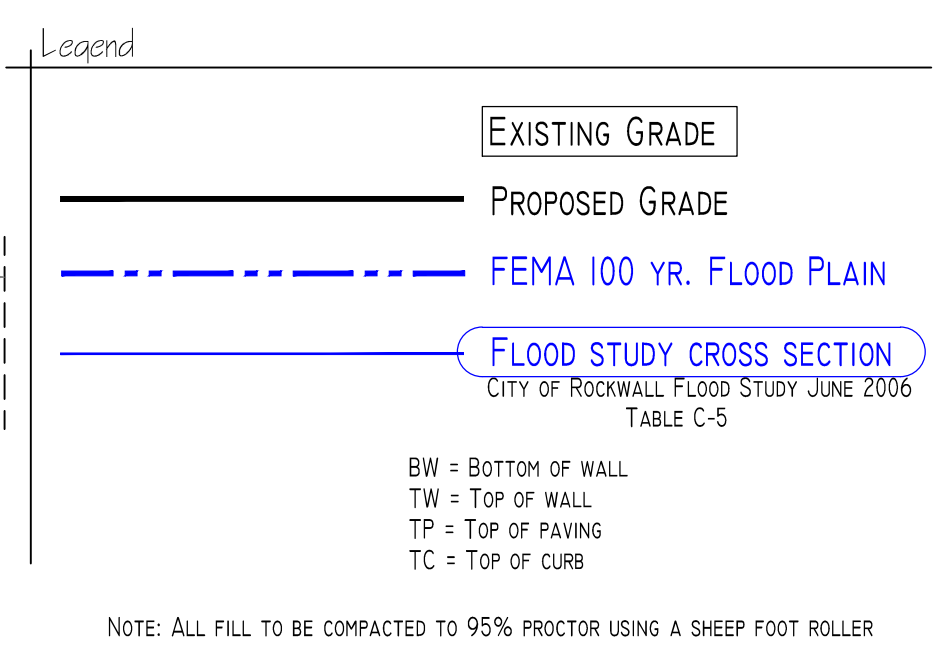

- NOTE:
- ALL FILL TO BE COMPACTED TO A MINIMUM OF 95% STANDARD DENSITY USING A SHEEP FOOT ROLLER
 - NO PAVING/CONCRETE IS ALLOWED TO BE INSTALLED UNTIL THE DETENTION SYSTEM IS CONSTRUCTED AND FUNCTIONING PER APPROVED ENGINEERING PLANS ALONG WITH THE SIDES AND BOTTOMS OF THE POND TO BE SOD OR HAVE ANCHORED SEEDED CURLEX INSTALLED. (WINTER RYE IS NOT ALLOWED)

DESIGN TEAM:

OWNER:
EMILY AND AMAL FERNANDO
3465 FM 544
WYLIE, TEXAS 75034
214-794-2094

FRANCHISE INFORMATION:
CHILDRENS LIGHTHOUSE FRANCHISE INC.
101 S. JENNINGS SUITE #209
FORT WORTH, TEXAS 76104

DESIGN:
SAM ELLIS
DOB
6916 ECHO CANYON DR.
MCKINNEY, TEXAS 75070
972-877-6630

CIVIL ENGINEER:
RYAN KIM
TEXAS REGISTERED ENGINEERING FIRM # 8280
817-308-6243
JAY149L@HOTMAIL.COM

Dallas Design Build

6916 Echo Canyon
McKinney, Texas 75070
972-877-6630
eam@dallasdb.com

Project


CHILDRENS LIGHTHOUSE
3011 N. GOLLIAD
ROCKWALL, TX

Description

GRADING PLAN

Date: 8/14/15
Drawn By: sle
Scale: 1"=20'

AS-BUILT
6-24-17

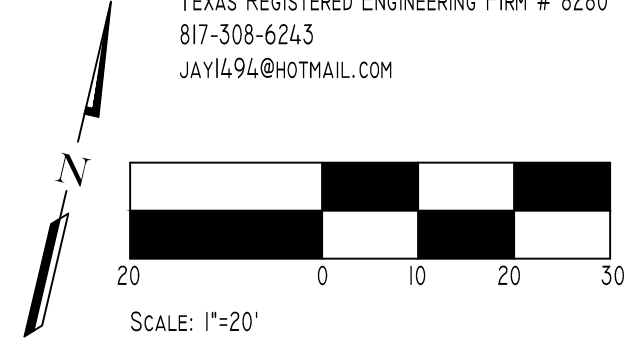

STATE HIGHWAY NO. 205
(A CALLED 100' RIGHT OF WAY)
ASPHALT PAVING

Asphalt Pavement

ASPHALT PAVING