
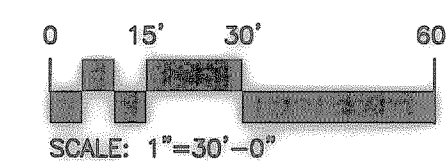


SITE GRADING PLAN

- NOTES:**  
KEYED NOTES DESIGNATED BY: ○
- NEW SPOT GRADE
  - EXG SPOT GRADE  
 --- EXG MAJOR CONTOUR (5')  
 --- EXG MINOR CONTOUR (1')
  - NEW MAJOR CONTOUR (5')  
 --- NEW MINOR CONTOUR (1')
  - BENCHMARK  
 □ CUT AT TOP OF CURB 15' SOUTHEAST OF EAST CORNER OF ROCKWALL FORD ADDITION VOL 1375 PG 301 ELEV 563.95
  - RETAINING WALL
  - CULVERT UNDER DRIVE
  - RETAINING WALL (DETENTION POND)
  - REFER TO DETAIL GRADING PLAN FOR THIS AREA ON SHEET 8.1
  - REFER TO SHEET 6 FOR SITE DRAINAGE PLAN
  - TOC = TOP OF CURB  
 TOI = TOP OF INLET  
 TOG = TOP OF GUTTER
  - GRADES SHALL BE ADJUSTED TO PROVIDE MAXIMUM USE OF EXISTING SITE SOILS TO PROVIDE REQUIRED GRADES

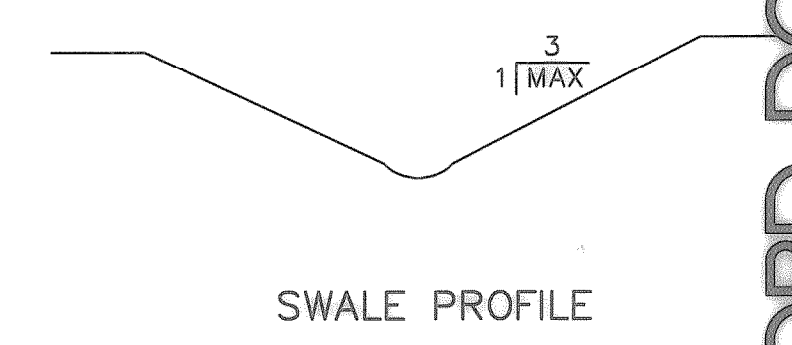

4

SECTION

SCALE: 1/2" = 1'-0"



**ALLIED ASSOCIATES CONSULTING ENGINEERS**  
 ARCHITECTURAL, MECHANICAL, ELECTRICAL  
 2525 74TH ST., SUITE 200  
 LUBBOCK, TX 79423  
 (806) 745-1100

**Architectural Resources**  
 2525 74TH ST., SUITE 200  
 LUBBOCK, TX 79423  
 (806) 745-1100

PROPOSED  
**DODGE CAR DEALERSHIP**  
 ROCKWALL, TEXAS

PROJECT NO. P88-
DATE: 09/19/00
REVISIONS:
DATE: 11/08/00
RECORD DOCUMENTS: 12/17/00

SHEET NO.  
**5**

RECORD DOCUMENTS

M:\dodge\_car\_dealership\sheet-05.dwg Plot Date: 17:19:20.54.2003 STATION=11