

This document, together with the concepts and designs presented herein, as an instrument of service, is intended only for the specific purpose and client for which it was prepared. Reuse of and improper reliance on this document without written authorization and adaptation by Kimley-Horn and Associates, Inc. shall be without liability to Kimley-Horn and Associates, Inc.

CIVIL CONSTRUCTION PLANS
PAVING & UTILITIES
FOR
**JUSTIN RD & CONVEYOR'S ST
EXTENSION**
CITY OF ROCKWALL, ROCKWALL COUNTY, TEXAS
CITY PROJECT NO. --

PLAN SUBMITTAL/REVIEW LOG

1ST SUBMITTAL TO CITY	08/26/2019
2ND SUBMITTAL TO CITY	10/28/2019
3RD SUBMITTAL TO CITY	12/11/2019
ISSUE FOR CONSTRUCTION	01/30/2020

ENGINEER

Kimley»Horn

400 N. OKLAHOMA DR.
SUITE 105
CELINA, TEXAS 75009
TEL: (469) 501-2200
CONTACT: ANTHONY M. LOEFFEL, P.E.

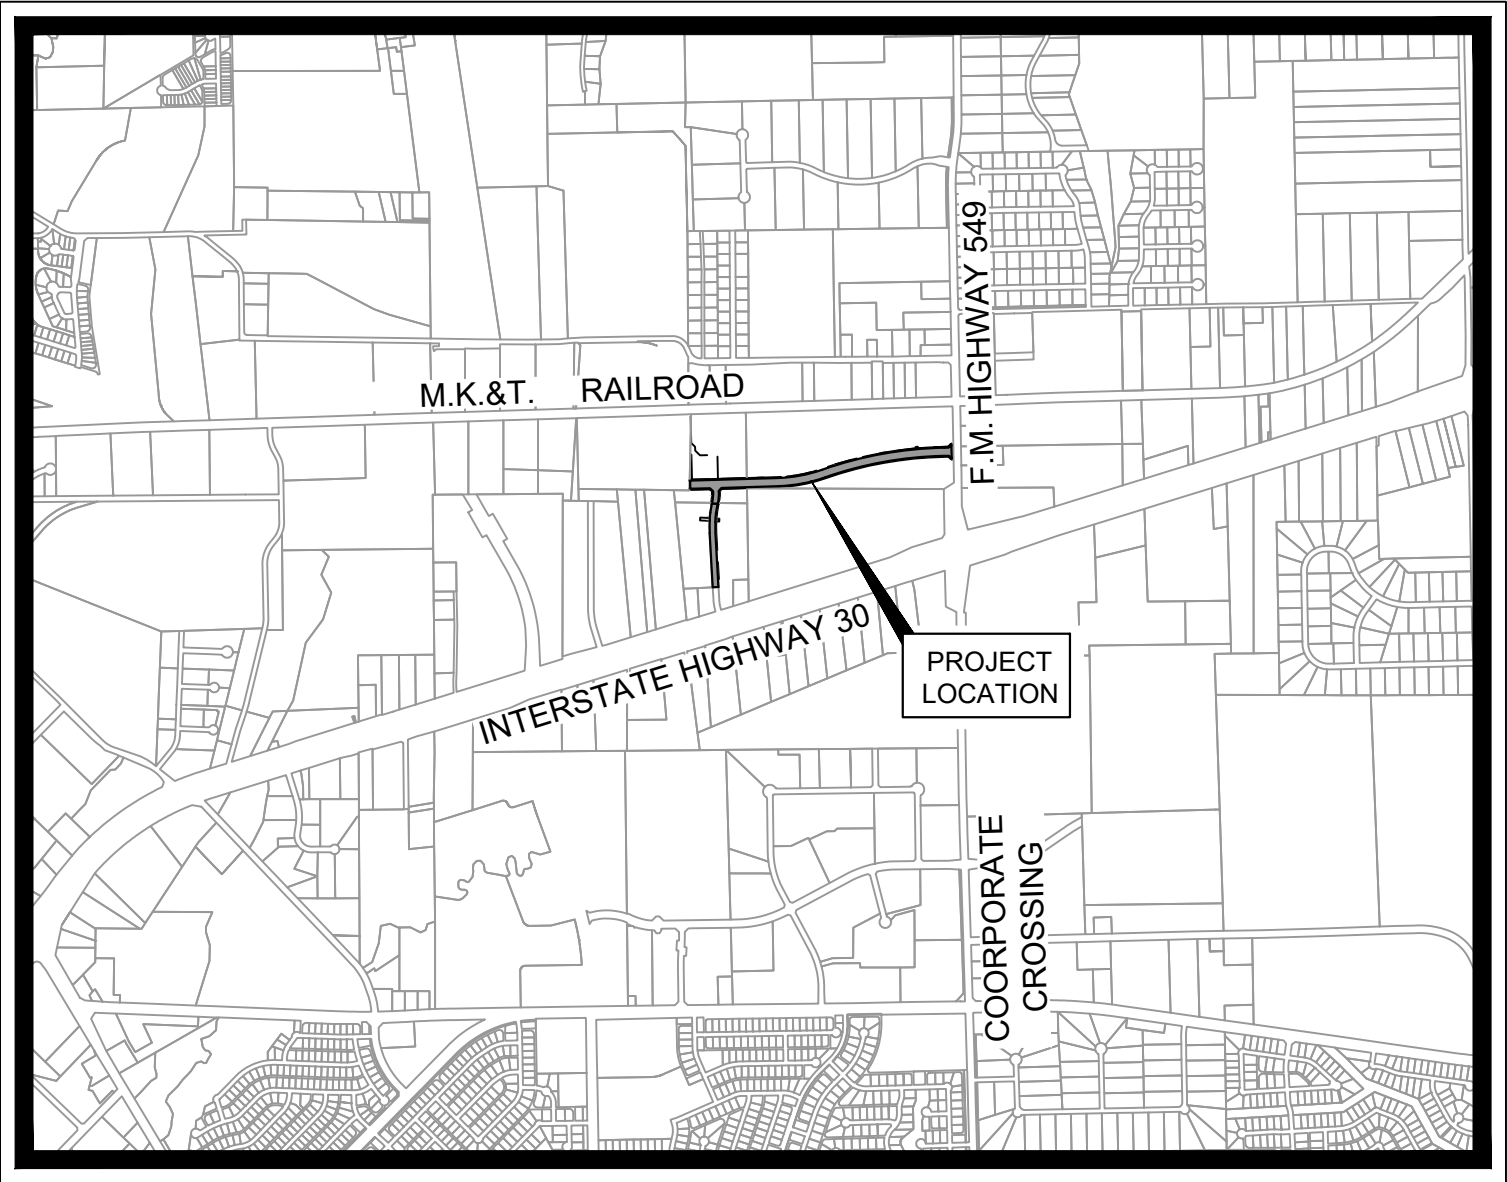
STATE OF TEXAS
REGISTRATION NO. F-928

OWNER/DEVELOPER

ROCKWALL 549/I-30 PARTNERS, LP
8750 N. CENTRAL EXPRESSWAY
SUITE 1735
DALLAS, TEXAS 75231
TEL: (972) 762-2627
CONTACT: RANDY MCCUISTION



TREE SURVEY NOTE:
A TREE SURVEY WAS NOT INCLUDED WITH
THIS PLAN SET DUE TO EXEMPTION PER
ARTICLE IX, SECTION 5.1.3 OF CITY
ORDINANCES.



VICINITY MAP
SCALE: 1" = 2,000'

JANUARY 2020

SHEET INDEX

Sheet Number	Sheet Title
C-01	COVER SHEET
-	FINAL PLAT
C-02	GENERAL NOTES
C-03	PAVING PLAN & PROFILE - JUSTIN ROAD
C-04	PAVING PLAN & PROFILE - JUSTIN ROAD
C-05	PAVING PLAN & PROFILE - JUSTIN ROAD
C-06	PAVING PLAN & PROFILE - CONVEYORS STREET
C-07	EXISTING DRAINAGE AREA MAP
C-07A	EXISTING DRAINAGE AREA MAP CALCULATIONS
C-08	DRAINAGE AREA MAP
C-08A	DRAINAGE AREA MAP CALCULATIONS
C-09	DRAINAGE CALCULATIONS
C-10	DRAINAGE CALCULATIONS
C-11	STORM DRAIN PLAN & PROFILE - LINE SD-A
C-12	STORM DRAIN PLAN & PROFILE - LINE SD-A
C-13	STORM DRAIN PLAN & PROFILE - LINE SD-A, LINE SD-C & LINE SD-D
C-14	STORM DRAIN PLAN & PROFILE - LINE SD-B
C-15	STORM PROFILES - LATERALS
C-16	STORM PROFILES - LATERALS
C-17	POND PLAN
C-17A	DETENTION CALCS
C-18	WATER PLAN & PROFILE - LINE WL-A (1 OF 3)
C-19	WATER PLAN & PROFILE - LINE WL-A (2 OF 3)
C-20	WATER PLAN & PROFILE - LINE WL-A (3 OF 3)
C-21	WATER PLAN & PROFILE - LINE WL-B (1 OF 2)
C-22	WATER PLAN & PROFILE - LINE WL-B (2 OF 2)
C-23	SANITARY SEWER PLAN & PROFILE - LINE SS-A (1 OF 2)
C-24	SANITARY SEWER PLAN & PROFILE - LINE SS-A (2 OF 2)
C-25	STREET LIGHT, STRIPING & SIGN PLAN
C-26	EROSION CONTROL PLAN
C-27	EROSION CONTROL DETAILS
FW-0	TXDOT DETAIL - CONCRETE FLARED WINGWALL
SCP-4	SINGLE BOX CULVERTS - PRECAST - 4' SPAN




RECORD DRAWING

THIS DRAWING HAS BEEN REVISED TO SHOW THOSE
CHANGES DURING THE CONSTRUCTION PROCESS
REPORTED BY THE CONTRACTOR TO KIMLEY-HORN
AND ASSOCIATES, INC. AND CONSIDERED TO BE
SIGNIFICANT. THIS DRAWING IS NOT GUARANTEED
TO BE "AS BUILT" BUT IS BASED ON THE
INFORMATION MADE AVAILABLE.

DATE: 01/08/2021 BY: ANTHONY LOEFFEL, P.E.



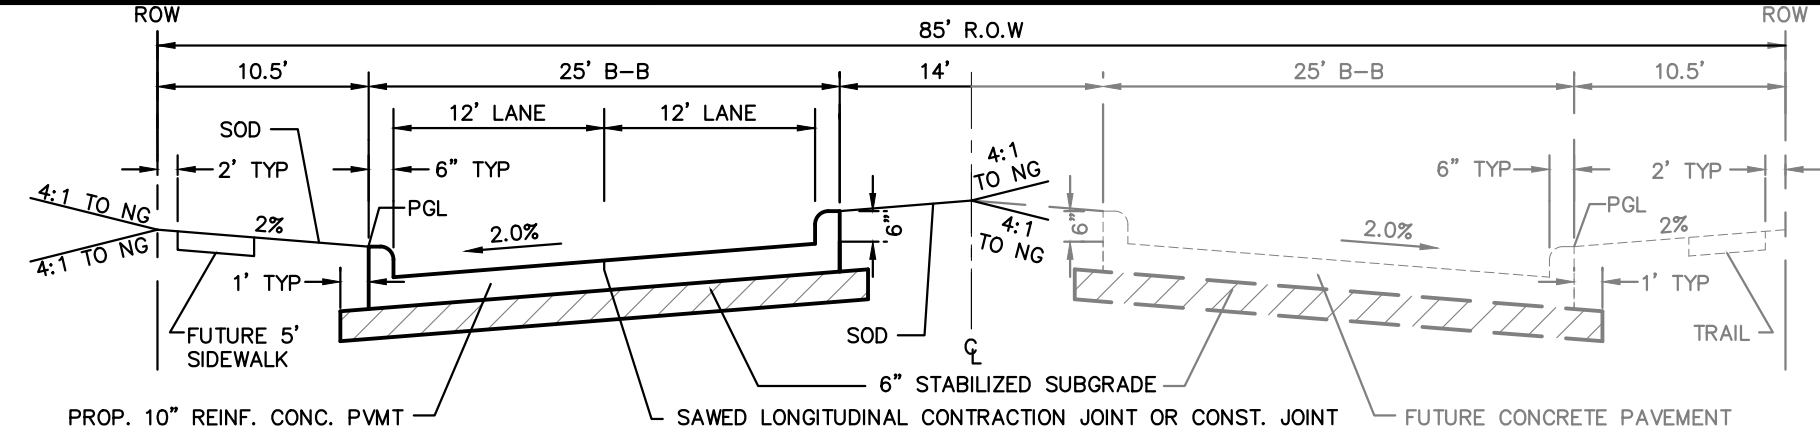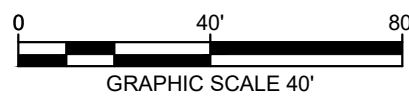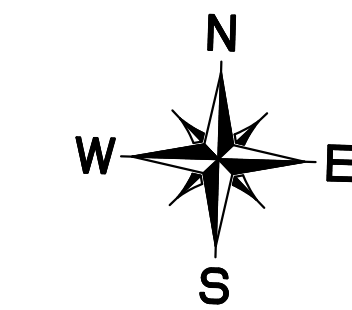Plotted By: Loeffel, Anthony Date: January 08, 2021 11:20:53am File Path: K:\JEL\Civil\063234203-Rockwall - Commercial Rwy\Cod\PlanSheets\C-Paving P&P.dwg This document, together with the concepts and designs presented herein, as an instrument of service, is intended only for the specific purpose and client for which it was prepared. Reuse of and improper reliance on this document without written authorization and adaptation by Kimley-Horn and Associates, Inc. shall be without liability to Kimley-Horn and Associates, Inc.



JUSTIN ROAD STANDARD SECTION


POINT TABLE					
POINT NO.	DESCRIPTION	ALIGNMENT	STATION	OFFSET	ELEVATION
01	PCCR (TC)	JUSTIN ROAD	12+27.12	7.00' LT	587.63
02	PT (TC)	JUSTIN ROAD	12+96.12	4.00' RT	588.34
03	PT (TC)	JUSTIN ROAD	12+96.12	7.00' RT	588.14
04	PCCR (END PAVEMENT)	JUSTIN ROAD	13+12.12	32.00' RT	587.75
05	END PAVEMENT	JUSTIN ROAD	13+12.12	7.00' RT	588.25
06	PC (TC)	JUSTIN ROAD	13+94.62	4.00' RT	589.03
07	PRC (TC)	JUSTIN ROAD	14+46.77	1.50' LT	589.59
08	PT (TC)	JUSTIN ROAD	14+98.92	7.00' LT	590.11

CURVE TABLE						
CURVE	RADIUS	LENGTH	CHORD BEARING	CHORD	DELTA	TANGENT
C1	1550.00'	478.21'	N79°26'21"E	476.32'	17°40'38"	241.02'

RECORD DRAWING

THIS DRAWING HAS BEEN REVISED TO SHOW THOSE CHANGES DURING THE CONSTRUCTION PROCESS REPORTED BY THE CONTRACTOR TO KIMLEY-HORN AND ASSOCIATES, INC. AND CONSIDERED TO BE SIGNIFICANT. THIS DRAWING IS NOT GUARANTEED TO BE "AS BUILT" BUT IS BASED ON THE INFORMATION MADE AVAILABLE.

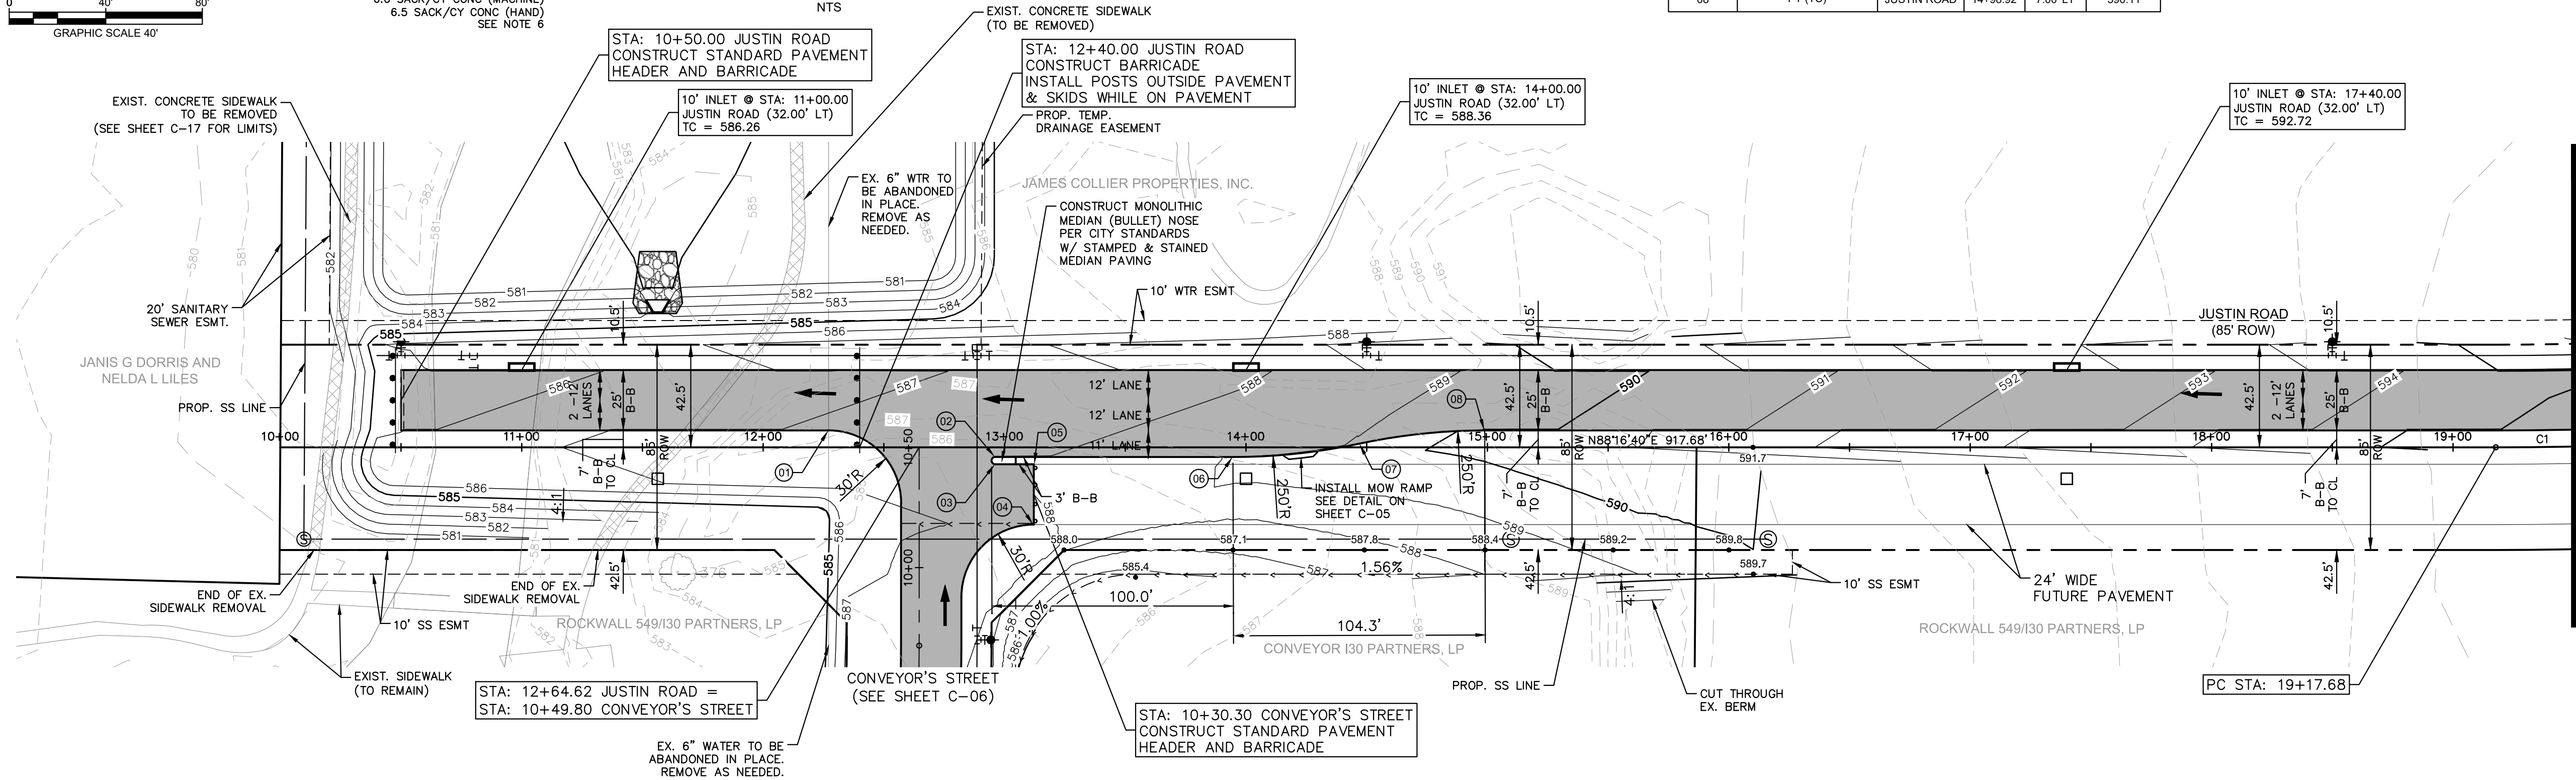DATE: 01/08/2021 BY: ANTHONY LOEFFEL, P.E.




PAVING GENERAL NOTES

- CONTRACTOR TO FIELD VERIFY HORIZONTAL AND VERTICAL LOCATION OF EXISTING IMPROVEMENTS PRIOR TO CONSTRUCTION.
- REFER TO SHEET C-02 FOR GENERAL PAVING NOTES.
- STABILIZED SUBGRADE SHALL BE A MIN. DEPTH OF 6" WITH 9% DRY WEIGHT LIME CONTENT (41LB/SY) OR PER GEOTECHNICAL RECOMMENDATIONS (WHICHEVER IS GREATER) TO REDUCE THE PI OF NATIVE MATERIAL TO 15 OR LESS.
- ALL PAVING STEEL SHALL BE GRADE 60 STEEL AND COMPLY WITH TXDOT SPECIFICATIONS.
- ALL PAVING STEEL SHALL BE #4 BARS WITH A SPACING OF 18" ON CENTER EACH WAY.
- JUSTIN ROAD PAVEMENT SHALL BE A MINIMUM OF 10" THICK. REFER TO GEOTECHNICAL REPORT FOR FINAL PAVEMENT DESIGN RECOMMENDATIONS.
- CONVEYORS STREET PAVEMENT SHALL BE A MINIMUM OF 8" THICK. REFER TO GEOTECHNICAL REPORT FOR FINAL PAVEMENT DESIGN RECOMMENDATIONS.
- ALL CONSTRUCTION SHALL BE PER THE CITY OF ROCKWALL STANDARDS OF DESIGN MANUAL.
- REFER TO THE CITY OF ROCKWALL STANDARDS OF DESIGN MANUAL FOR STANDARD CONSTRUCTION DETAILS. IF THIS MANUAL DOES NOT INCLUDE THE DETAILS SPECIFIED, REFER TO THE CURRENT VERSION OF THE NCTCOG PUBLIC WORKS CONSTRUCTION STANDARDS MANUAL.

Kimley»Horn


© 2021 KIMLEY-HORN AND ASSOCIATES, INC.
400 N. OKLAHOMA DRIVE, SUITE 05, CELINA, TX 75009
PHONE: 469-501-2200
WWW.KIMLEY-HORN.COM

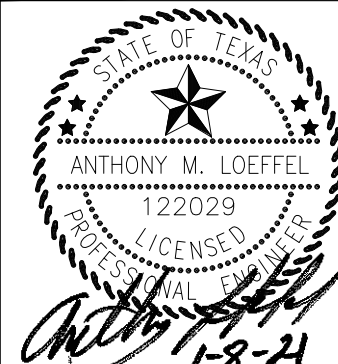TEXAS REGISTERED ENGINEERING FIRM F-928



KHA PROJECT	063234203
DATE	MARCH 2020
SCALE	AS SHOWN
DESIGNED BY:	AVL
DRAWN BY:	AML
CHECKED BY:	BLM

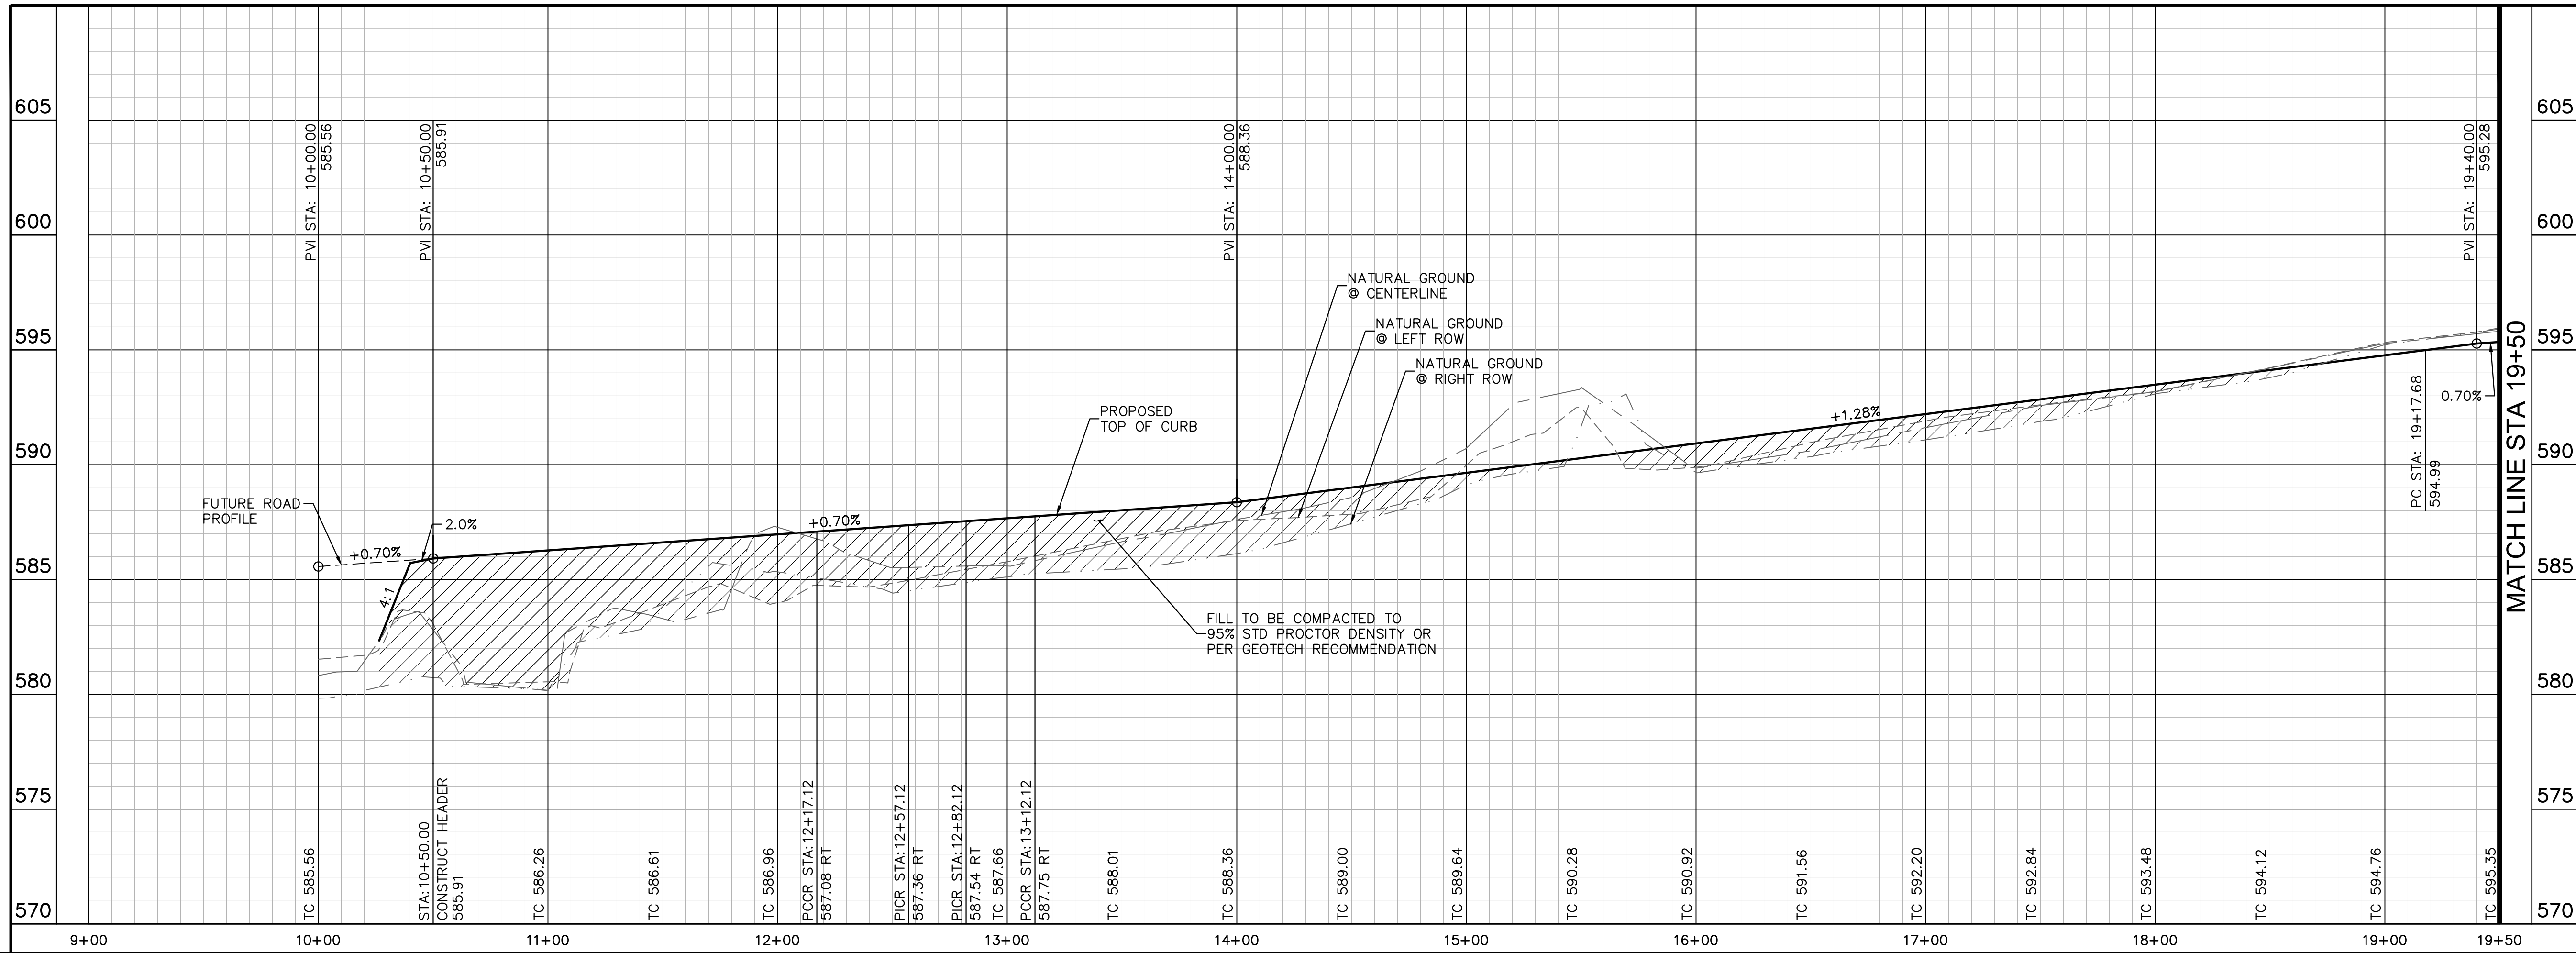JUSTIN ROAD



PROFILE SCALE
1" = 40' HORIZONTAL
1" = 4' VERTICAL

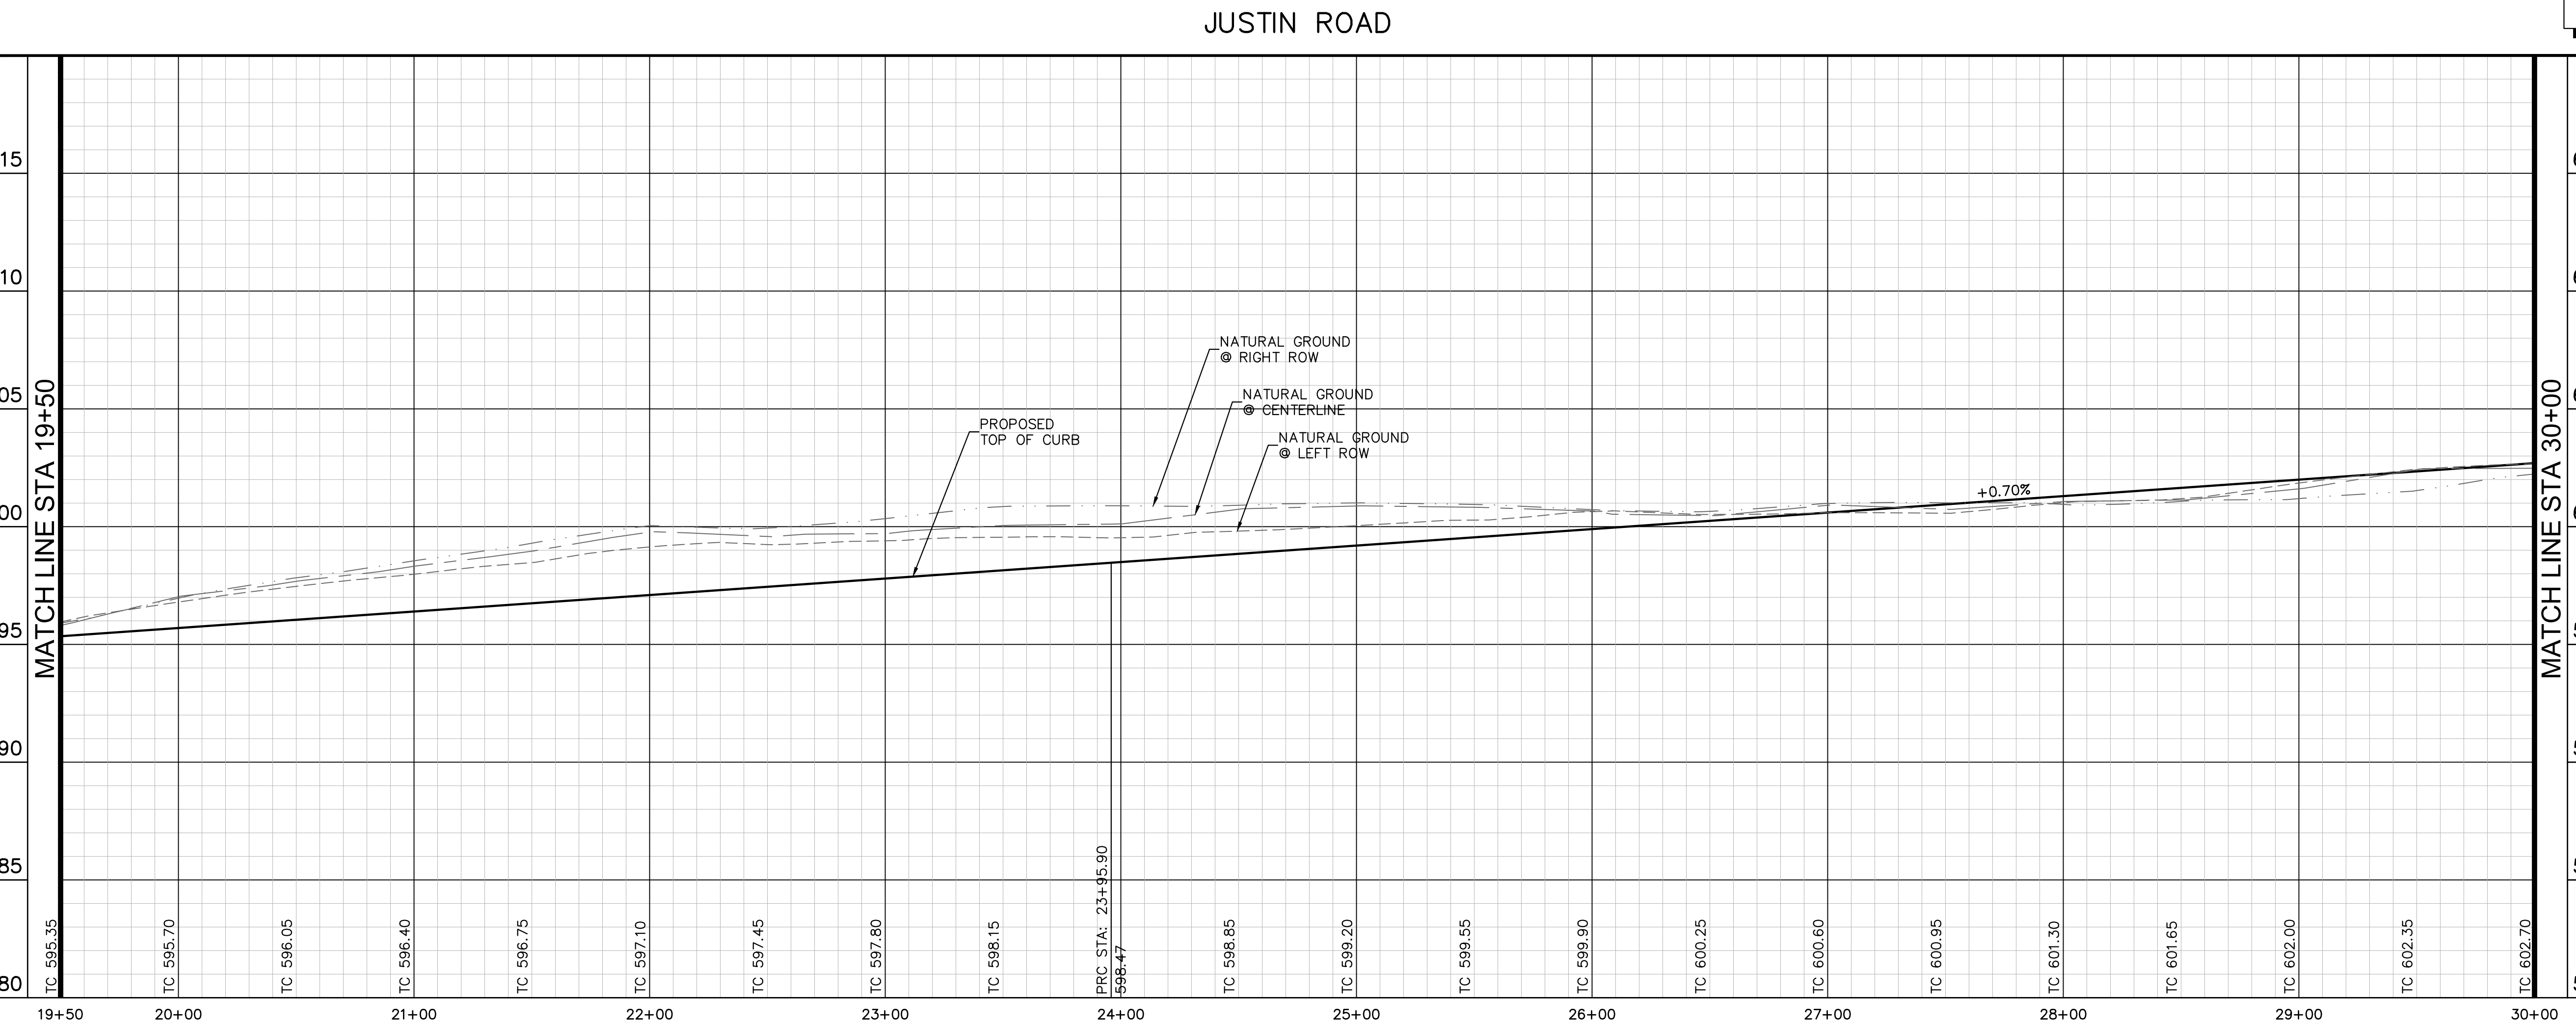
BENCHMARKS

SQUARE CUT IN CENTER OF AN INLET LOCATED ON THE NORTH SIDE OF INTERSTATE HIGHWAY 30, APPROXIMATELY 53 FEET EAST OF THE SOUTHEAST CURB RETURN OF CONVEYORS ST AND HWY 30.
ELEVATION = 587.055 FEET
SQUARE CUT ON NORTHEAST SIDE OF WATER MANHOLE RIM, LOCATED ON THE WEST SIDE OF FM HIGHWAY 549, APPROXIMATELY 1246 FEET NORTH OF THE INTERSECTION OF FM 549 AND HWY 30.
ELEVATION = 610.402 FEET

PAVING PLAN & PROFILE - JUSTIN ROAD

JUSTIN RD & CONVEYORS ST
EXTENSION
CITY OF ROCKWALL
ROCKWALL COUNTY, TEXAS

SHEET NUMBER
C-03






RECORD DRAWING


THIS DRAWING HAS BEEN REVISED TO SHOW THOSE CHANGES DURING THE CONSTRUCTION PROCESS REPORTED BY THE CONTRACTOR TO KIMLEY-HORN AND ASSOCIATES, INC. AND CONSIDERED TO BE SIGNIFICANT. THIS DRAWING IS NOT GUARANTEED TO BE "AS BUILT" BUT IS BASED ON THE INFORMATION MADE AVAILABLE.

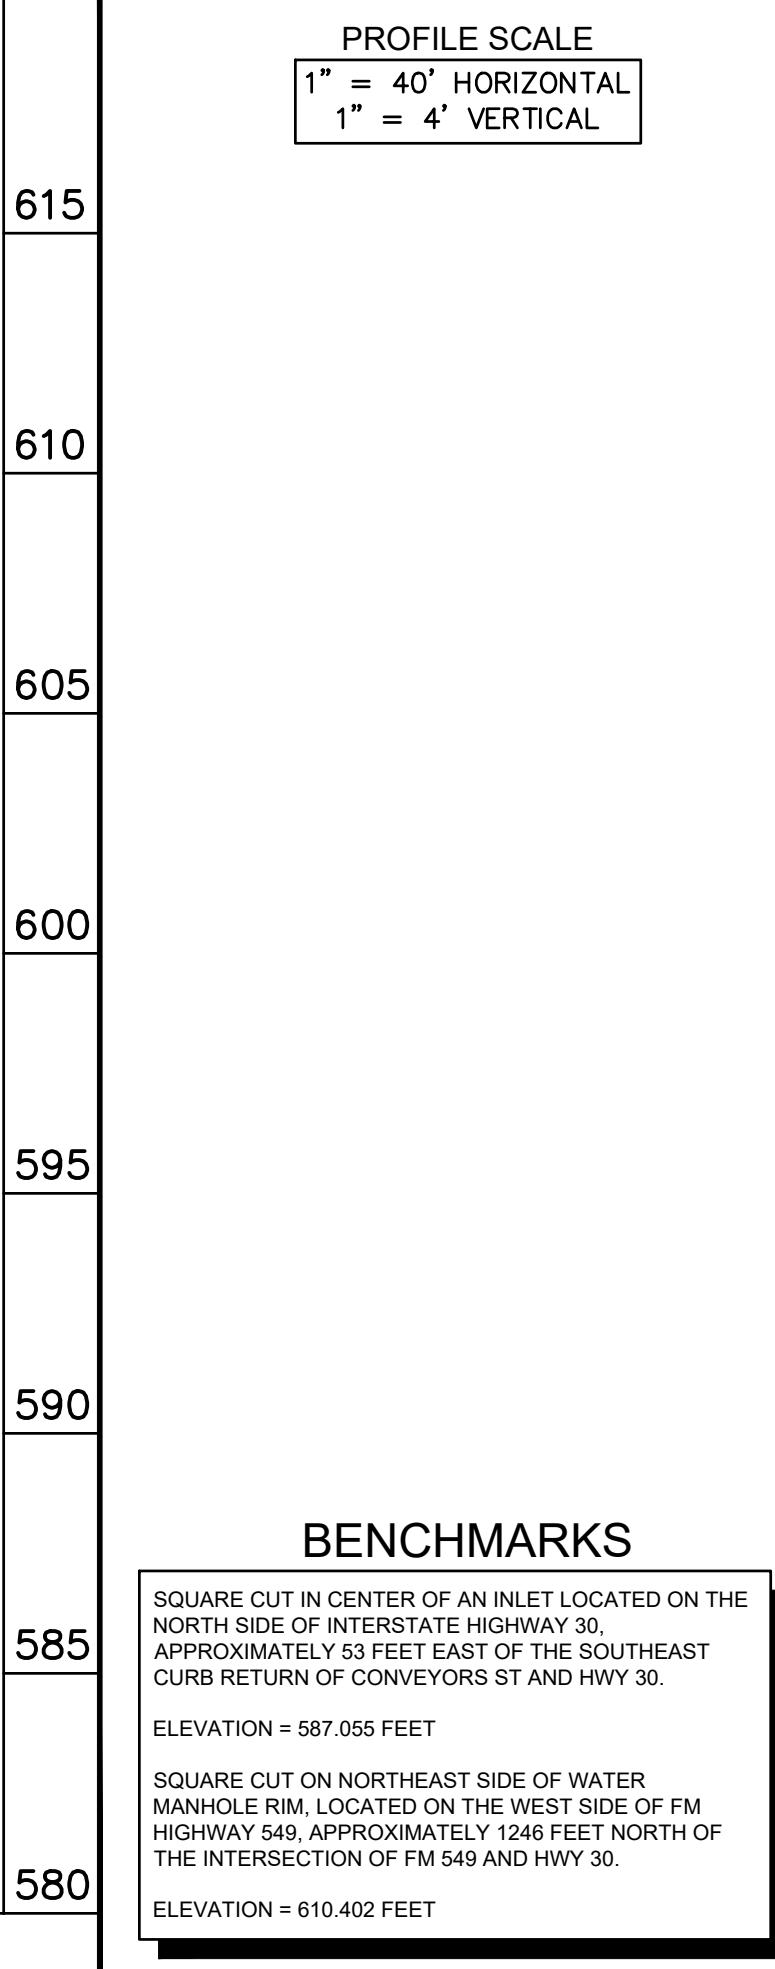DATE: 01/08/2021 BY: ANTHONY LOEFFEL, P.E.


- # PAVING GENERAL NOTES
- | | |
|----|--|
| 1. | CONTRACTOR TO FIELD VERIFY HORIZONTAL AND VERTICAL LOCATIONS OF EXISTING IMPROVEMENTS PRIOR TO CONSTRUCTION. |
| 2. | REFER TO SHEET C-02 FOR GENERAL PAVING NOTES. |
| 3. | STABILIZED SUBGRADE SHALL BE A MIN. DEPTH OF 6" WITH 9% COMPACTED TO MEET THE CONTRACT REQUIREMENT FOR PERCENTS OF COMPRESSIONS (WHICHEVER IS GREATER) TO REDUCE THE R/F OF NATIVE MATERIAL TO 15 OR LESS. |
| 4. | ALL CURB AND STEEL SHALL BE GRADE 60 STEEL AND COMPLY WITH TxDOT SPECIFICATIONS. |
| 5. | ALL PAVING STEEL SHALL BE 6" BARS WITH A SPACING OF 18" ON CENTER EACH WAY. |
| 6. | REFER TO GEOTECHNICAL REPORT SHALL BE A MINIMUM OF 10" THICK REFER TO GEOTECHNICAL REPORT FOR PAVEMENT DESIGN RECOMMENDATIONS. |
| 7. | ALL CURB AND STREET SHALL BE A MINIMUM OF 8" THICK REFER TO GEOTECHNICAL REPORT FOR PAVEMENT DESIGN RECOMMENDATIONS. |
| 8. | ALL CONSTRUCTION SHALL BE PER THE CITY OF ROCKWALL STANDARDS OF DESIGN. |
| 9. | REFER TO THE CITY OF ROCKWALL STANDARDS OF DESIGN MANUAL FOR STANDARD CONSTRUCTION DETAILS. IF THIS MANUAL DOES NOT INCLUDE THE DETAIL REQUIRED, THEN REFER TO THE CURRENT VERSION OF THE NCTCOG PUBLIC WORKS CONSTRUCTION STANDARDS MANUAL. |




SHEET NUMBER	C-04			
	JUSTIN RD & CONVEYOR'S ST EXTENSION CITY OF ROCKWALL ROCKWALL COUNTY, TEXAS			
PAVING PLAN & PROFILE - JUSTIN ROAD				
KHA PROJECT 063234203 DATE MARCH 2020 SCALE: AS SHOWN DESIGNED BY: AML DRAWN BY: AML CHECKED BY: BLM				
				
	© 2021 KIMLEY-HORN AND ASSOCIATES, INC. 400 N. OKLAHOMA DRIVE, SUITE 105, CELINA, TX 75009 PHONE: 469-501-2200 WWW.KIMLEY-HORN.COM TEXAS REGISTERED ENGINEERING FIRM F-928			
	No.	REVISIONS	DATE	BY

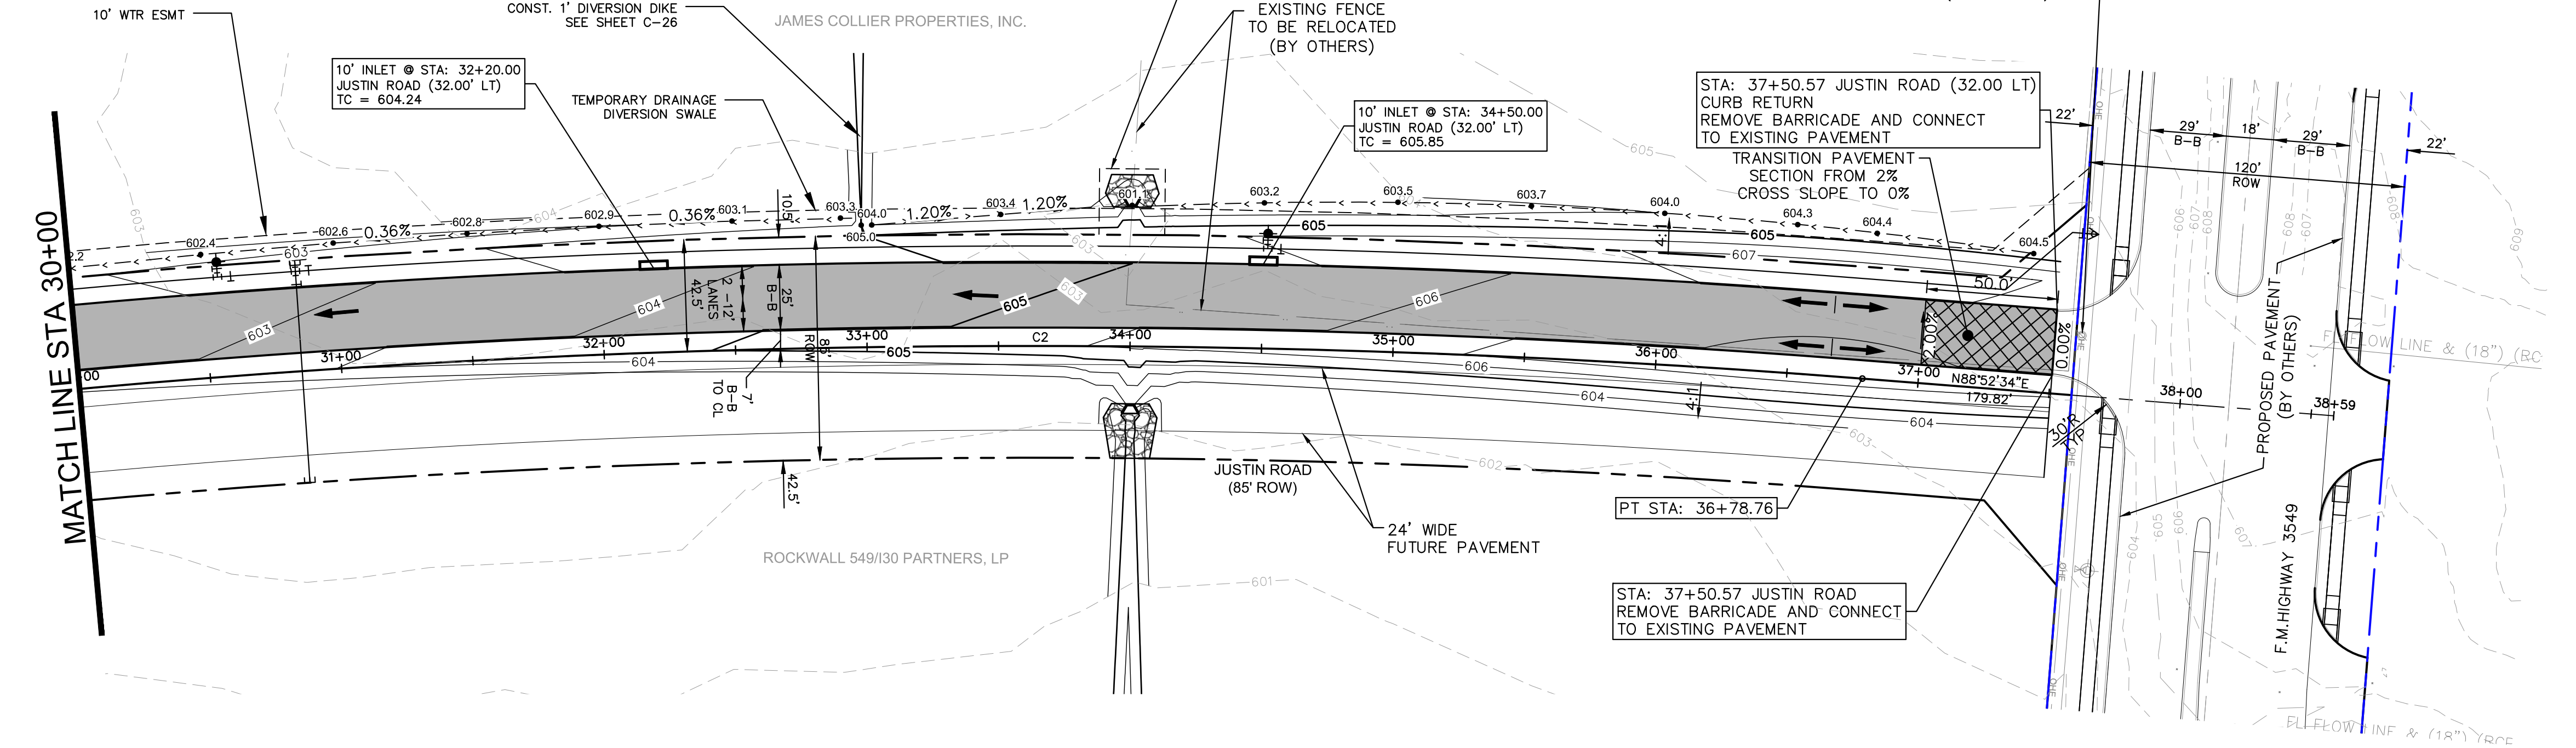

JUSTIN ROAD

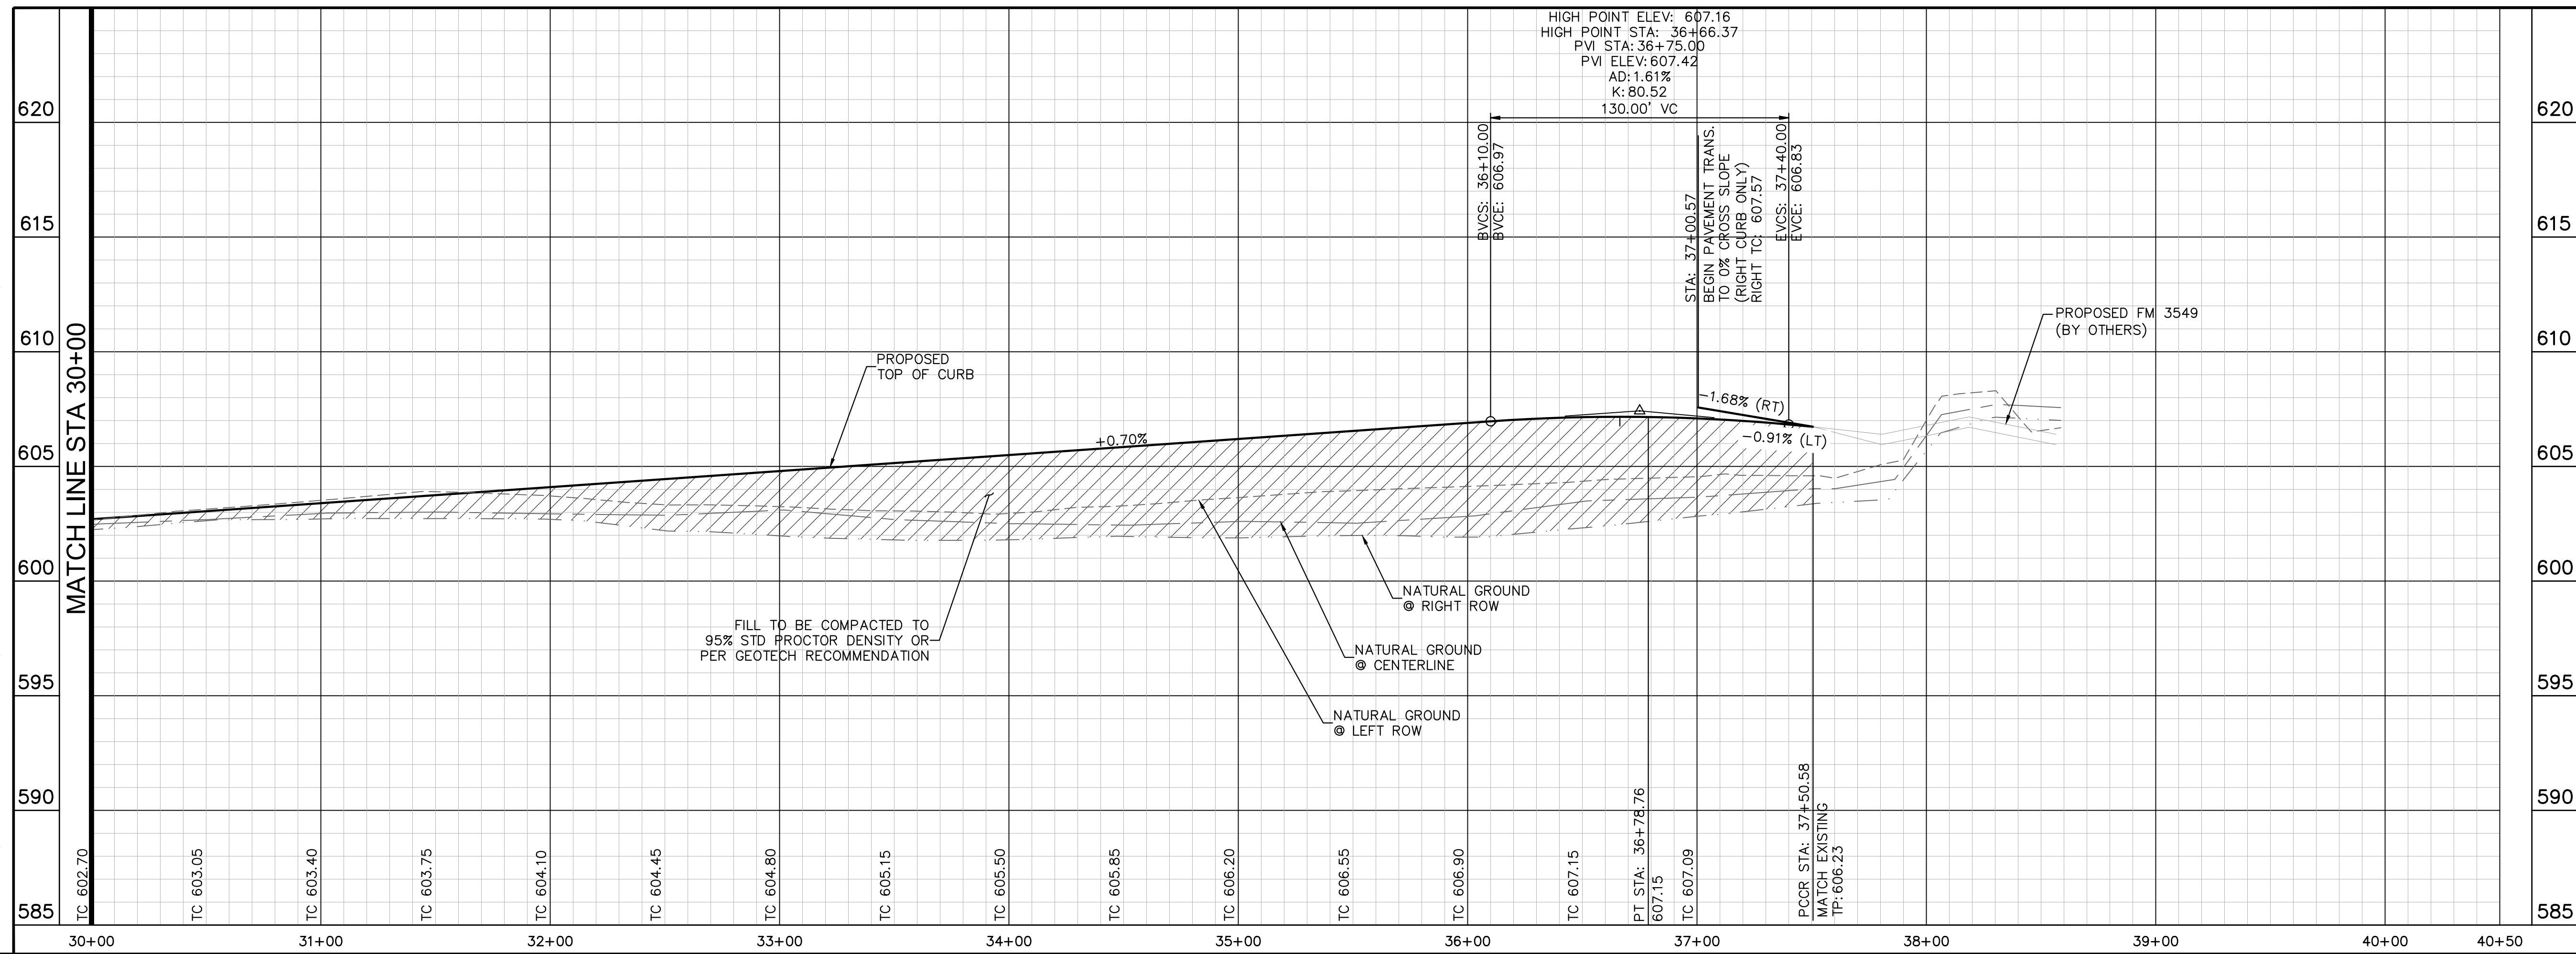

CURVE TABLE						
CURVE	RADIUS	LENGTH	CHORD BEARING	CHORD	DELTA	TANGENT
C2	4021.90'	1282.86'	N79°44'18"E	1277.43'	18°16'32"	646.92'

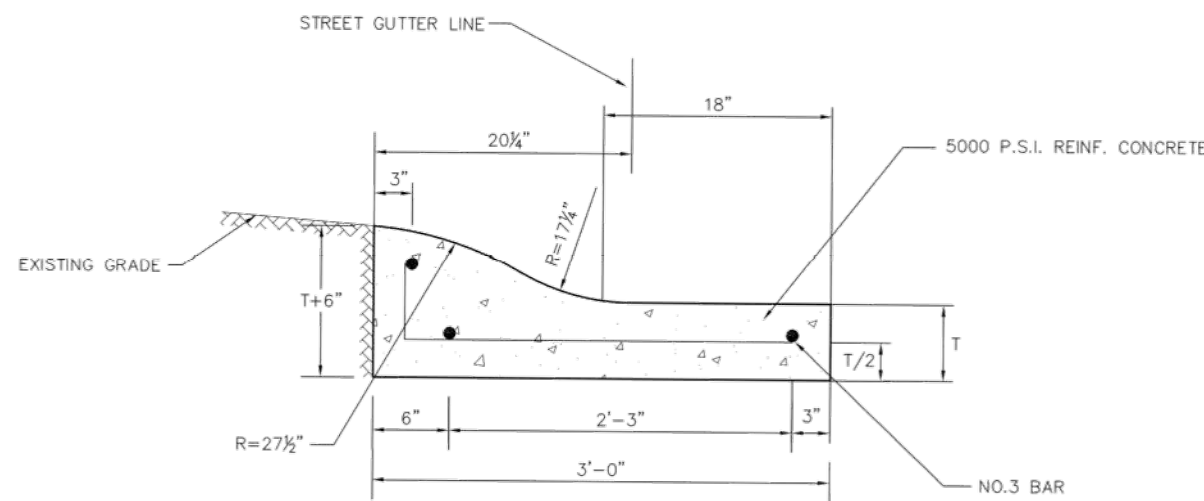

MOUNTABLE CURB SECTION


RECORD DRAWING

THIS DRAWING HAS BEEN REVISED TO SHOW THOSE
CHANGES DURING THE CONSTRUCTION PROCESS
REPORTED BY THE CONTRACTOR TO KIMLEY-HORN
AND ASSOCIATES, INC. AND CONSIDERED TO BE
SIGNIFICANT. THIS DRAWING IS NOT GUARANTEED
TO BE "AS BUILT" BUT IS BASED ON THE
INFORMATION MADE AVAILABLE.

DATE: 01/08/2021 BY: ANTHONY LOEFFEL, P.E.

PAVING GENERAL NOTES

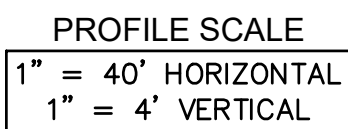1. CONTRACTOR TO FIELD VERIFY HORIZONTAL AND VERTICAL LOCATION OF EXISTING IMPROVEMENTS PRIOR TO CONSTRUCTION.
2. REFER TO SHEET C-02 FOR GENERAL PAVING NOTES.
3. STABILIZED SUBGRADE SHALL BE A MIN. DEPTH OF 6" WITH 9% DRY WEIGHT WATER CONTENT (415BS) OR PER GEOTECHNICAL ENGINEER'S RECOMMENDATIONS TO AVOID EXCESSIVE SETTLING TO REDUCE THE P/F OF NATIVE MATERIAL TO 10% OR LESS.
4. ALL PAVING STEEL SHALL BE GRADE 60 STEEL AND COMPLY WITH ALL APPLICABLE SPECIFICATIONS.
5. ALL PAVING STEEL SHALL BE #4 BARS WITH A SPACING OF 18" ON CENTER EACH WAY.
6. JUSTIN ROAD PAVEMENT SHALL BE A MINIMUM OF 10" THICK. REFER TO THE GEOTECHNICAL REPORT FOR FINAL PAVEMENT DESIGN RECOMMENDATIONS.
7. CONVEYORS STREET PAVEMENT SHALL BE A MINIMUM OF 6" THICK. REFER TO THE GEOTECHNICAL REPORT FOR FINAL PAVEMENT DESIGN RECOMMENDATIONS.
8. ALL CONSTRUCTION SHALL BE PER THE CITY OF ROCKWALL STANDARDS OF DESIGN MANUAL.
9. ALL CONSTRUCTION SHALL BE PER THE CITY OF ROCKWALL STANDARDS FOR STANDARD CONSTRUCTION DETAILS. IF THIS MANUAL DOES NOT INCLUDE THE DETAILS SPECIFIED, REFER TO THE CITY OF ROCKWALL STANDARDS FOR PUBLIC WORKS CONSTRUCTION STANDARDS MANUAL.



BENCHMARKS

SQUARE CUT IN CENTER OF AN INLET LOCATED ON THE NORTH SIDE OF INTERSTATE HIGHWAY 30, APPROXIMATELY 53 FEET EAST OF THE SOUTHEAST CURB RETURN OF CONVEYORS ST AND HWY 30.

ELEVATION = 587.055 FEET

SQUARE CUT ON NORTHEAST SIDE OF WATER MANHOLE RIT 1 LOCATED IN THE WEST SIDE OF FM HIGHWAY 549, APPROXIMATELY 1246 FEET NORTH OF THE INTERSECTION OF FM 549 AND HWY 30.

ELEVATION = 610.402 FEET





KHA PROJECT 063234203	DATE MARCH 2020	SCALE: AS SHOWN	DESIGNED BY: AML	DRAWN BY: AML
--------------------------	--------------------	-----------------	------------------	---------------

PAVING PLAN & PROFILE - JUSTIN ROAD

JUSTIN RD & CONVEYOR'S ST
EXTENSION
CITY OF ROCKWALL
ROCKWALL COUNTY, TEXAS

SHEET NUMBER
C-05

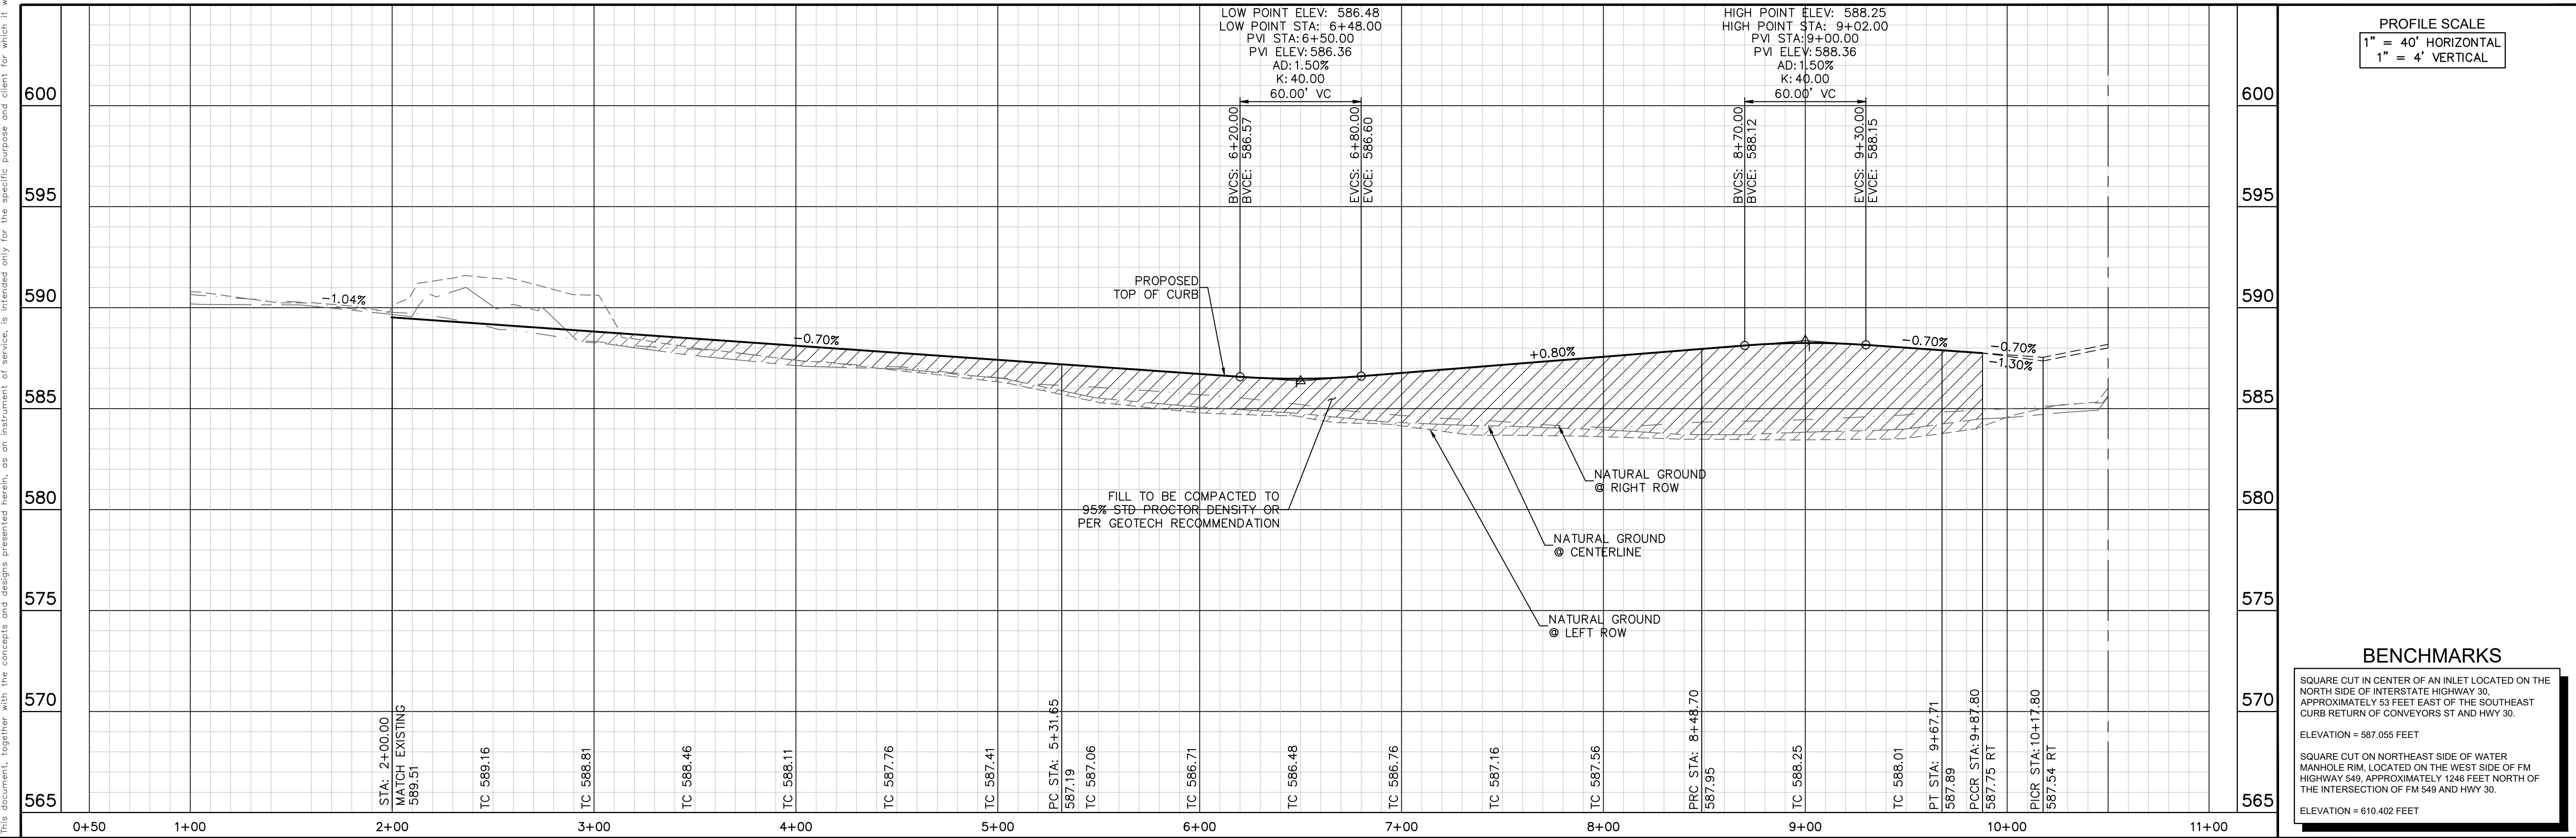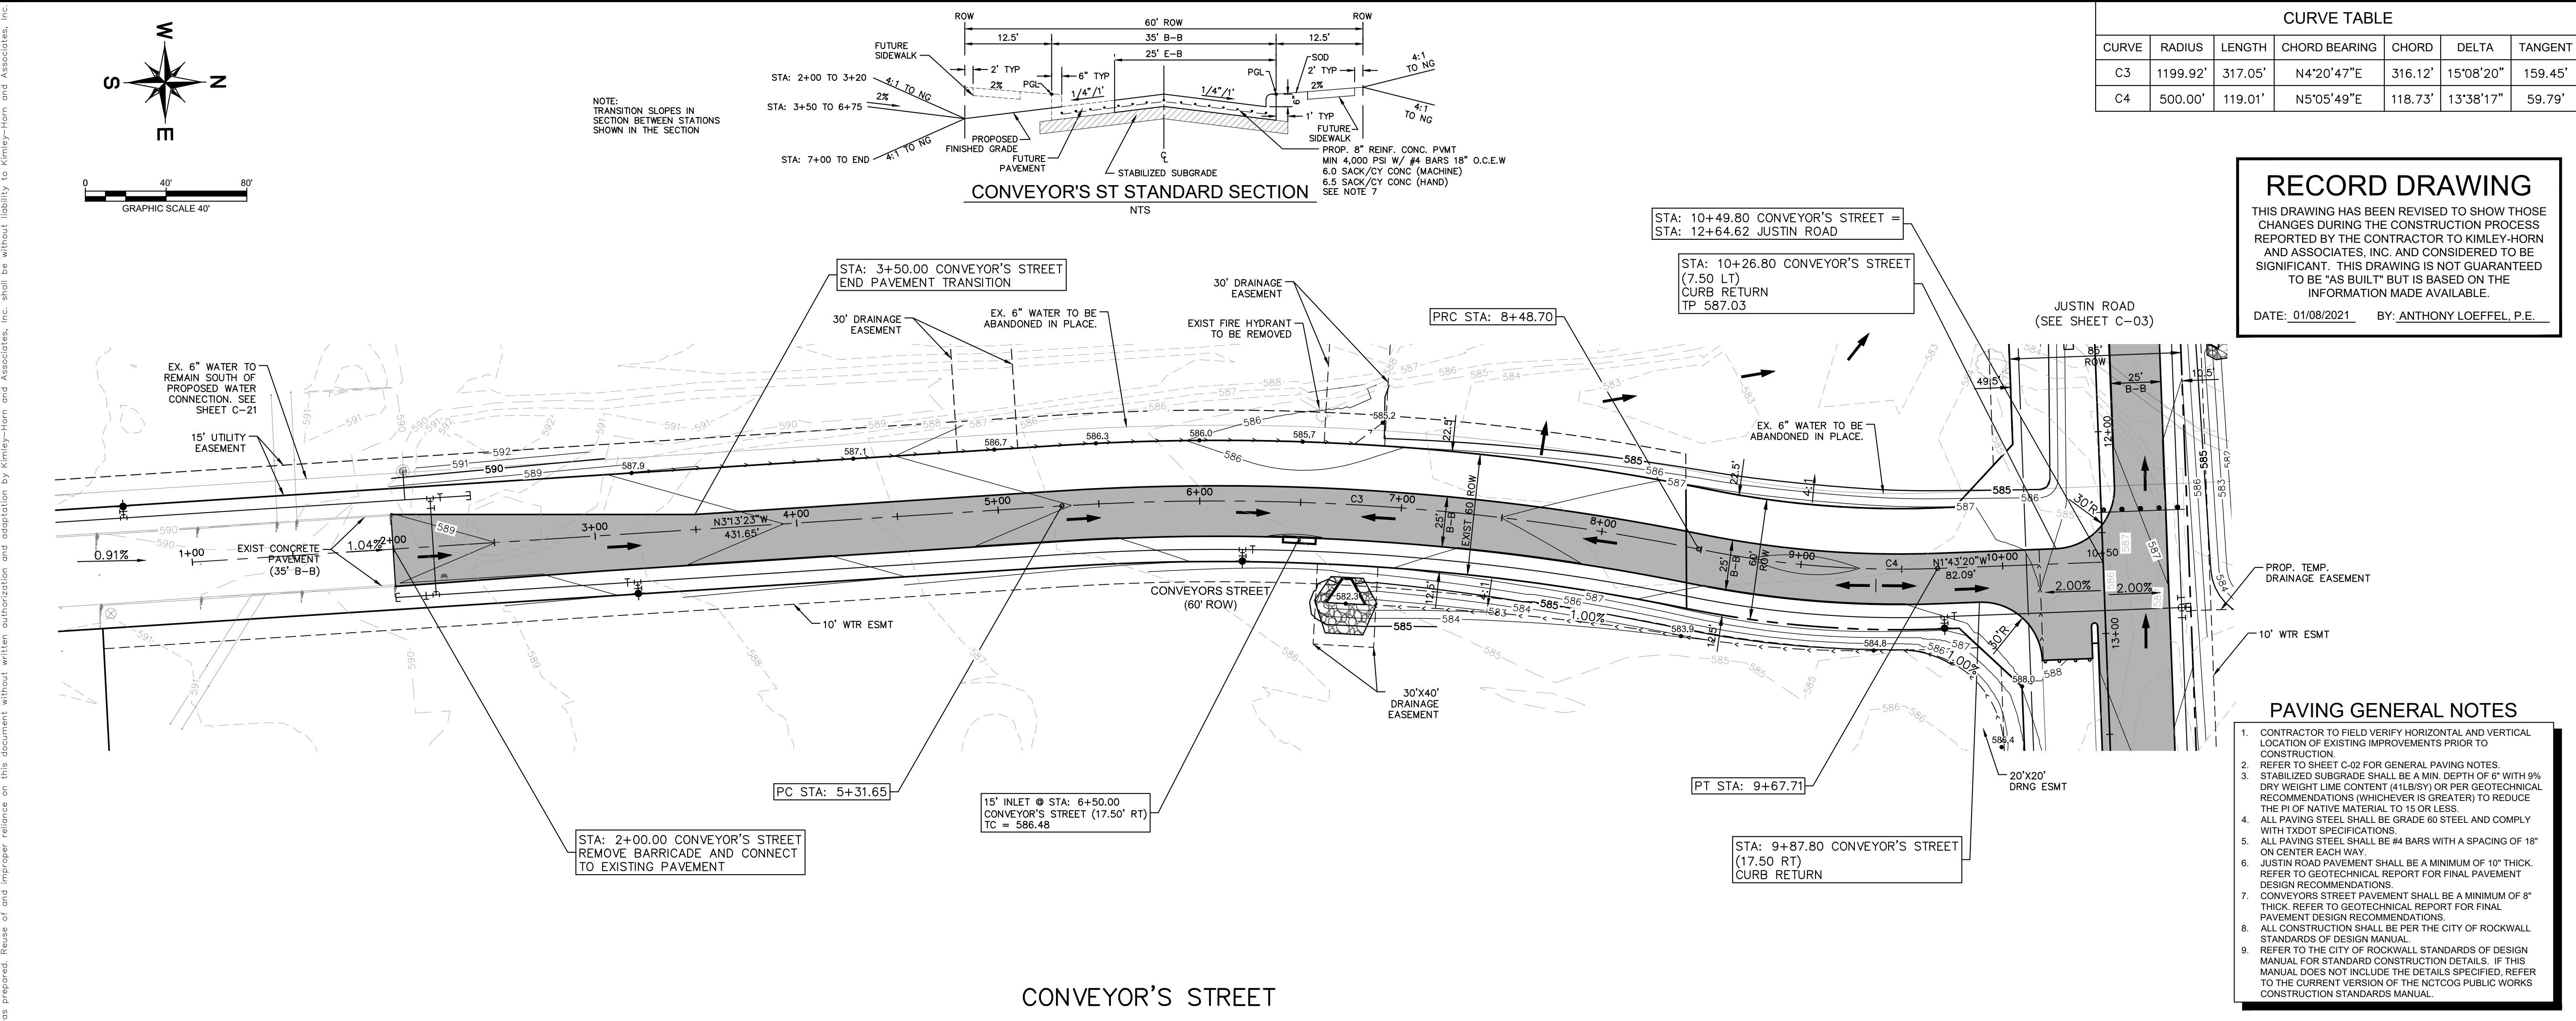Plotted By: Loeffel, Anthony Date: January 08, 2021 11:21:25am File Path: K:\CEL\Civil\063234203-Rockwall - Commercial Rdwy\Cod\PlanSheets\C-Paving P&P.dwg
This document, together with the concepts and designs presented herein, is intended only for the specific purpose and client for which it was prepared. Reuse of and improper reliance on this document without written authorization and adaptation by Kimley-Horn and Associates, Inc. shall be without liability to Kimley-Horn and Associates, Inc.



Kimley»Horn
© 2021 KIMLEY-HORN AND ASSOCIATES, INC.
400 N. OKLAHOMA DRIVE, SUITE 105, CELINA, TX 75009
PHONE: 469-501-2200
WWW.KIMLEY-HORN.COM
TEXAS REGISTERED ENGINEERING FIRM F-928

**PAVING PLAN & PROFILE -
CONVEYORS STREET**

**JUSTIN RD & CONVEYOR'S ST
EXTENSION**
CITY OF ROCKWALL
ROCKWALL COUNTY, TEXAS

REVISIONS


No.	REVISIONS	DATE	BY

SHEET NUMBER
C-06

PROJECT
KHA PROJECT 063234203
DATE MARCH 2020
SCALE AS SHOWN
DESIGNED BY: AVL
DRAWN BY: AVL
CHECKED BY: BLM

Plotted By: Loeffel, Anthony Date: January 08, 2021 11:21:51am File Path: K:\CEL\Civil\063234203-Rockwall - Commercial Rdwy\Coa\PlanSheets\EX-Ex Drainage Area Map.dwg

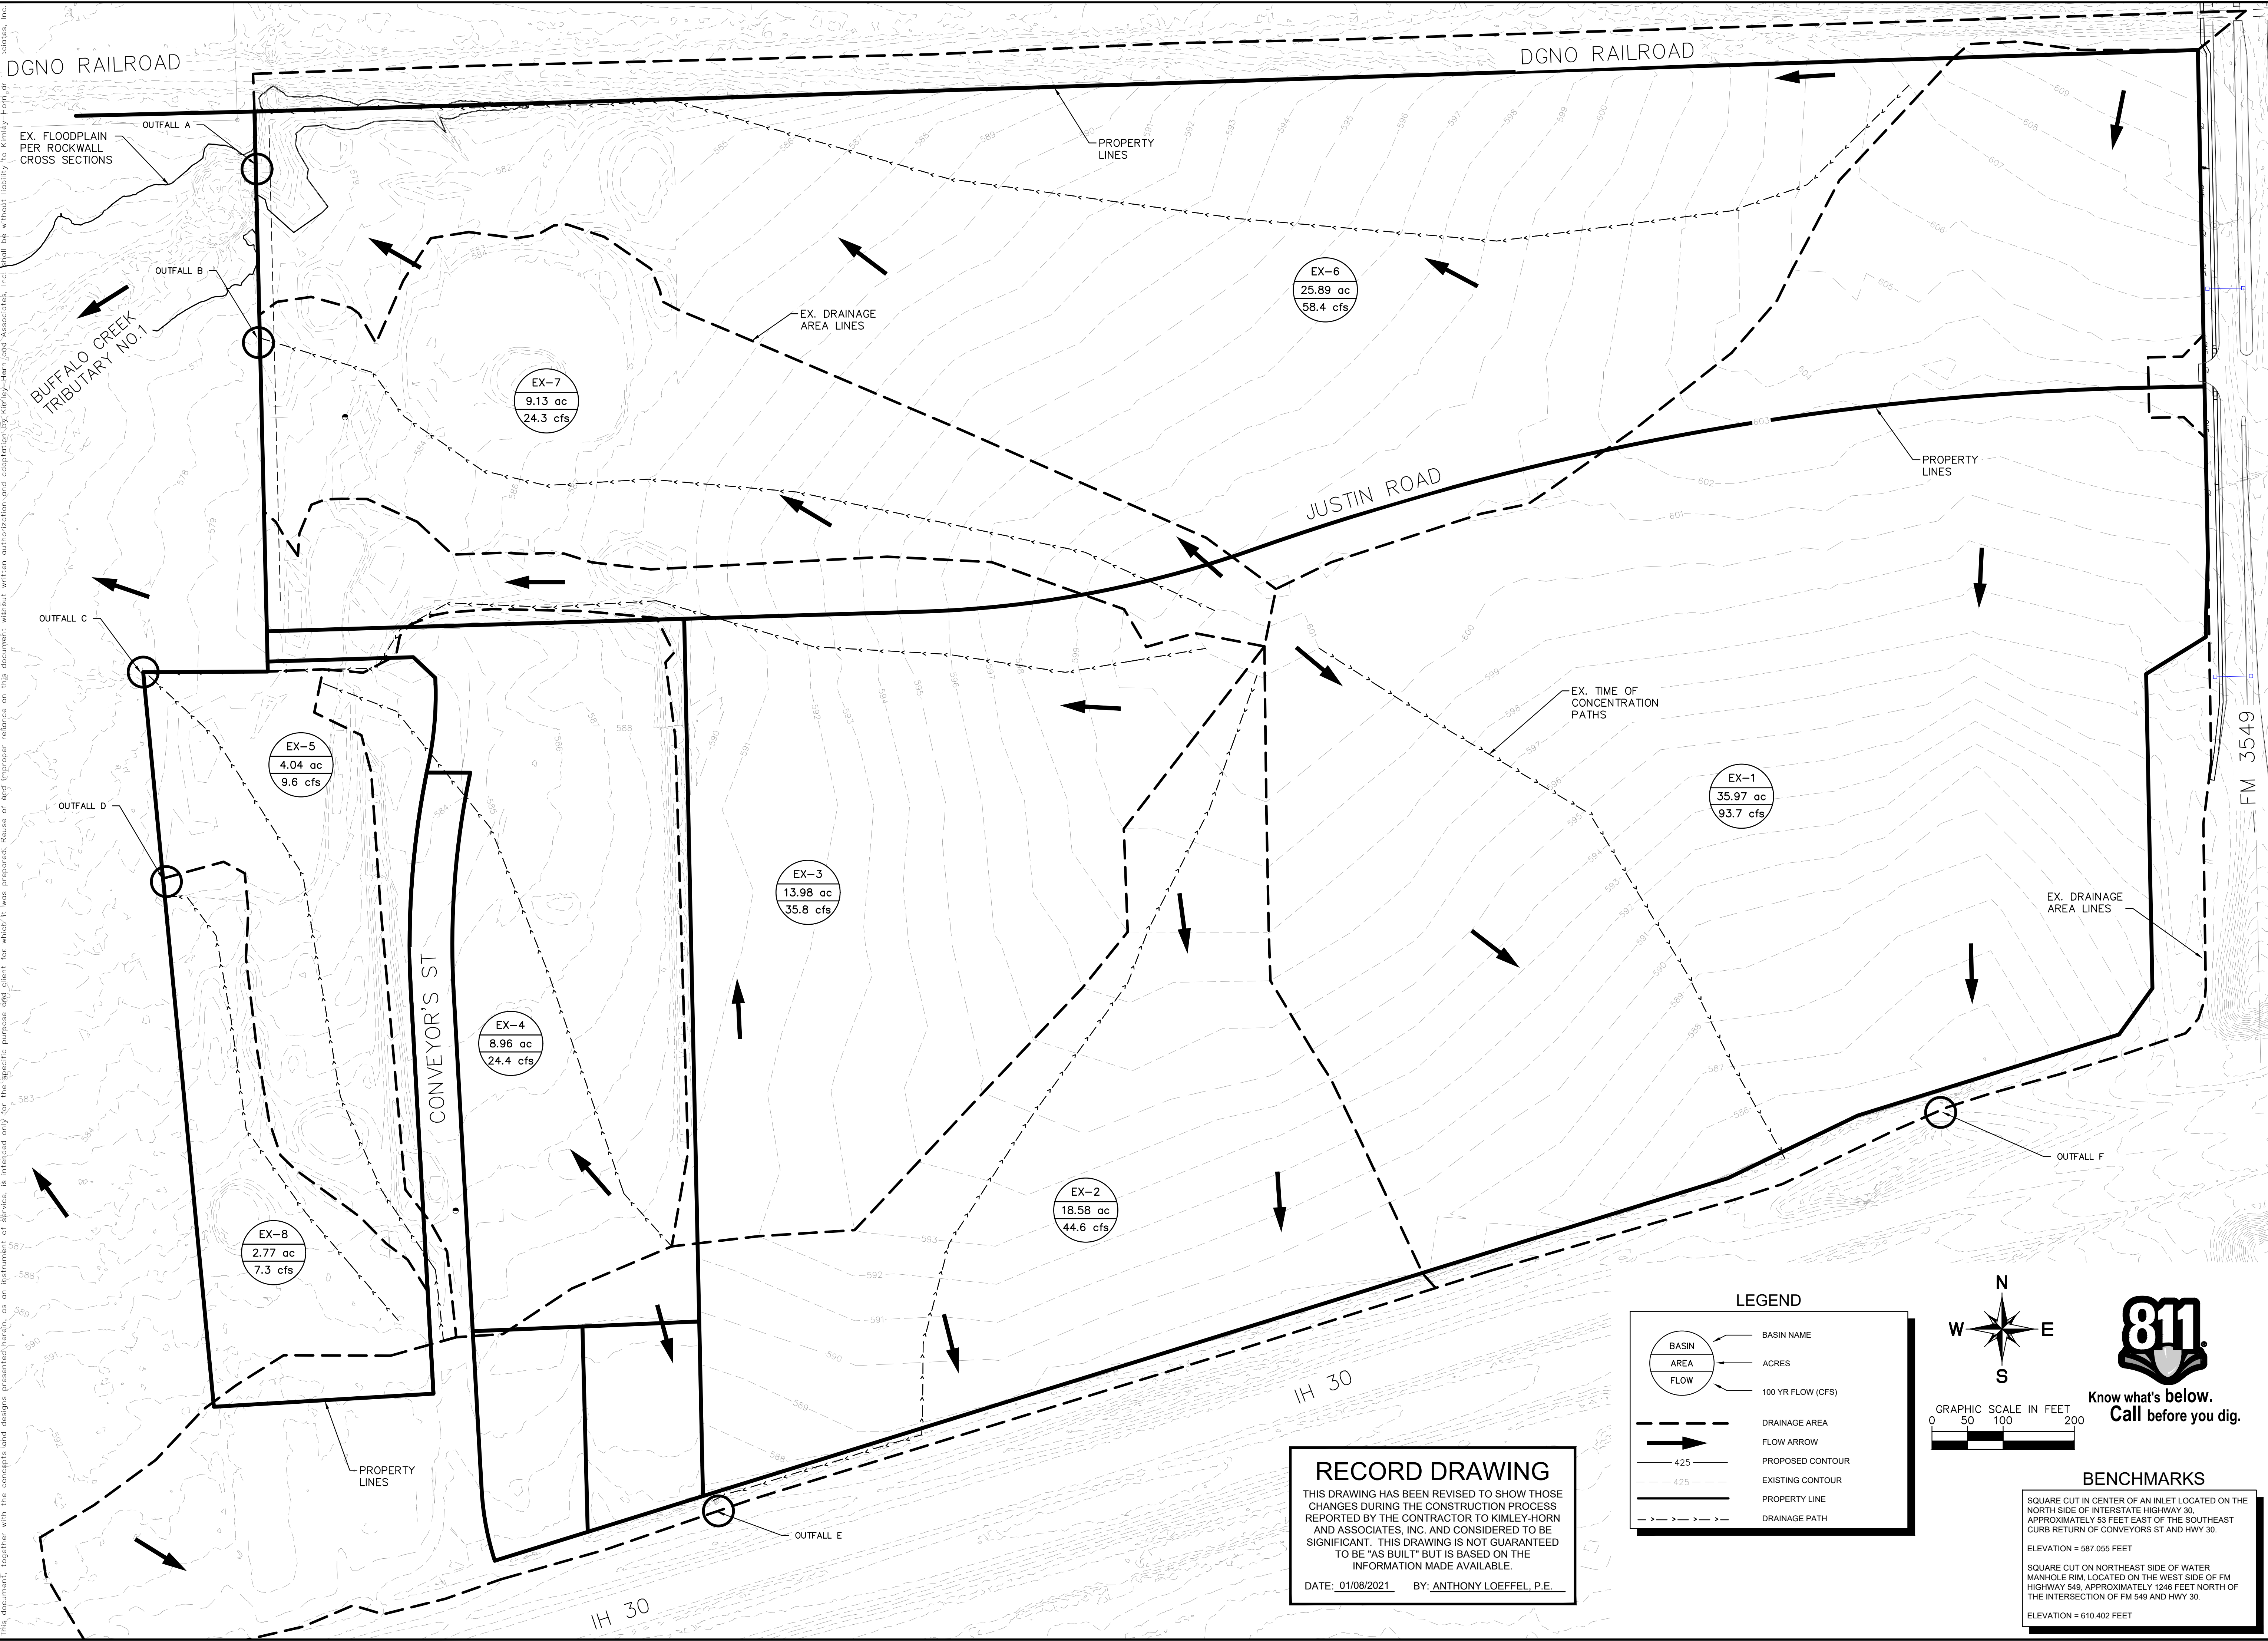This document, together with the concepts and designs presented herein, as an instrument of service, is intended only for the specific purpose and client for which it was prepared. Reuse of and improper reliance on this document without written authorization and adaptation by Kimley-Horn and Associates, Inc. shall be without liability to Kimley-Horn and Associates, Inc.



RECORD DRAWING
THIS DRAWING HAS BEEN REVISED TO SHOW THOSE CHANGES DURING THE CONSTRUCTION PROCESS REPORTED BY THE CONTRACTOR TO KIMLEY-HORN AND ASSOCIATES, INC. AND CONSIDERED TO BE SIGNIFICANT. THIS DRAWING IS NOT GUARANTEED TO BE "AS BUILT" BUT IS BASED ON THE INFORMATION MADE AVAILABLE.
DATE: 01/08/2021 BY: ANTHONY LOEFFEL, P.E.

LEGEND

	BASIN NAME
	ACRES
	100 YR FLOW (CFS)
	DRAINAGE AREA
	FLOW ARROW
	PROPOSED CONTOUR
	EXISTING CONTOUR
	PROPERTY LINE
	DRAINAGE PATH

811
Know what's below.
Call before you dig.

GRAPHIC SCALE IN FEET
0 50 100 200

BENCHMARKS

SQUARE CUT IN CENTER OF AN INLET LOCATED ON THE NORTH SIDE OF INTERSTATE HIGHWAY 30, APPROXIMATELY 53 FEET EAST OF THE SOUTHEAST CURB RETURN OF CONVEYORS ST AND HWY 30.
ELEVATION = 587.055 FEET

SQUARE CUT ON NORTHEAST SIDE OF WATER MANHOLE RIM, LOCATED ON THE WEST SIDE OF FM HIGHWAY 549, APPROXIMATELY 1246 FEET NORTH OF THE INTERSECTION OF FM 549 AND HWY 30.
ELEVATION = 610.402 FEET

Kimley»Horn © 2021 KIMLEY-HORN AND ASSOCIATES, INC. 400 N. OKLAHOMA DRIVE, SUITE 105, CELINA, TX 75009 PHONE: 469-501-2200 WWW.KIMLEY-HORN.COM TEXAS REGISTERED ENGINEERING FIRM F-928			
KHA PROJECT 063234203	DATE MARCH 2020	SCALE: AS SHOWN	DESIGNED BY: AVL
DRAWN BY: XXX		CHECKED BY: BLM	
EXISTING DRAINAGE AREA MAP			
JUSTIN RD & CONVEYOR'S ST EXTENSION CITY OF ROCKWALL ROCKWALL COUNTY, TEXAS			
SHEET NUMBER C-07			

Plotted By: Loeffel, Anthony Date: January 08, 2021 11:21:52am File Path: K:\CEL\Civil\063234203-Rockwall - Commercial Rdwy\Cad\PlanSheets\0-Ex Drainage Area Map.dwg
This document, together with the concepts and designs presented herein, as an instrument of service, is intended only for the specific purpose and client for which it was prepared. Reuse of and improper reliance on this document without written authorization and adaptation by Kimley-Horn and Associates, Inc. shall be without liability to Kimley-Horn and Associates, Inc.

DRAINAGE AREA TABLE						
DRAINAGE AREA NO.	AREA (ac)	FREQUENCY FACTOR	RUNOFF COEFFICIENT "C"	RAINFALL INTENSITY "I" 100 (in/hr)	TIME OF CONCENTRATION (minutes)	TOTAL FLOW Q100 (cfs)
EX-1	35.97	1.00	0.35	7.44	26.1	93.7
EX-2	18.58	1.00	0.35	6.86	30.4	44.6
EX-3	13.98	1.00	0.35	7.31	27.1	35.8
EX-4	8.96	1.00	0.35	7.77	23.8	24.4
EX-5	4.04	1.00	0.35	6.80	30.9	9.6
EX-6	25.89	1.00	0.35	6.45	34.1	58.4
EX-7	9.13	1.00	0.35	7.60	25.0	24.3
EX-8	2.77	1.00	0.35	7.55	25.4	7.3

Existing Condition Design Point Summary						
Design Point	Contributing DA's	Area (ac)	Runoff Coefficient	Intensity (in/hr)	TOC (min)	Q ₁₀₀ (cfs)
A	EX-6	25.89	0.35	6.45	34.1	58.5
B	EX-7	9.13	0.35	7.60	25.0	24.3
C	EX-3, EX-4, EX-5	26.98	0.35	7.31	27.1	69.0
D	EX-8	2.77	0.35	7.55	25.4	7.3
E	EX-2	18.58	0.35	6.86	30.4	44.6
F	EX-1	35.97	0.35	7.44	26.1	93.7

EXISTING TIME OF CONCENTRATION TR-55 Methodology																																
Basin	SHEET FLOW						SHALLOW CONCENTRATED FLOW								OPEN CHANNEL FLOW											STORM SEWER FLOW				TOTAL		
	Tc = (0.007(nL) ^{0.8} /(P ² *0.5)(s ^{0.4})						Tc = L / 3600*K*S ^{0.5} K = 16.13 for unpaved, K = 20.32 for paved								Tc = L / 3600*(1.49/n)*(R ^{2/3})*(S ^{1/2})											Tc = L / 60*V						
	2-year/24-hr Rainfall Depth from City of Rockwall Drainage Design Manual (in.) = 4.09																															
	Length (ft)	Elev ₁	Elev ₂	Slope (ft/ft)	Manning's "n"	T _{c1} (min)	Length (ft)	Elev ₂	Elev ₃	Slope (ft/ft)	Condition TR-55 Fig. 3-1	V _{avg} (ft/s)	T _{c2} (min)	Length (ft)	Manning's "n"	Width (ft)	Side Slope (ft/ft)	Depth (ft)	Area (ft ²)	Perimeter (ft)	Radius (ft)	Elev ₃	Elev ₄	Slope (ft/ft)	V _{avg} (ft/s)	T _{c3} (min)	Inlet Time (min)	Length (ft)	V _{avg} (ft/s)	T _{c4} (min)	T _{cMINIMUM} (min)	T _{cTOTAL} (min)
DP-A (EX-6)	100	607.00	606.00	0.0100	0.240	16.7	1724	606.00	580.00	0.0151	Unpaved	1.98	14.5	585	0.03	-	-	1.04	14.7	19.8	0.74	580.0	576.0	0.0068	3.4	2.9	0	0	-	0.0	20.0	34.1
DP-B (EX-7)	100	601.00	599.50	0.0150	0.240	14.2	1334	599.50	578.00	0.0161	Unpaved	2.05	10.9														0	0	-	0.0	20.0	25.0
DP-C (EX-3)	100	601.00	600.20	0.0080	0.240	18.2	686	600.20	589.00	0.0163	Unpaved	2.06	5.5	760	0.03	-	-	1.38	15.6	19.5	0.80	589.0	583.0	0.0079	3.8	3.3	0	0	-	0.0	20.0	27.1
EX-4	100	591.70	590.50	0.0120	0.240	15.5	867	590.50	580.40	0.0116	Unpaved	1.74	8.3														0	0	-	0.0	20.0	23.8
EX-5	100	590.40	589.70	0.0070	0.240	19.2	951	589.70	583.00	0.0070	Unpaved	1.35	11.7														0	0	-	0.0	20.0	30.9
DP-D (EX-8)	100	591.00	590.40	0.0060	0.240	20.4	618	590.40	580.00	0.0168	Unpaved	2.09	4.9														0	0	-	0.0	20.0	25.4
DP-E (EX-2)	100	601.00	600.20	0.0080	0.240	18.2	1087	600.20	589.00	0.0103	Unpaved	1.64	11.1	307	0.03	-	-	1.37	8.7	11.9	0.731092	589.0	585.0	0.0130	4.6	1.1	0	0	-	0.0	20.0	30.4
DP-F (EX-1)	100	601.00	600.30	0.0070	0.240	19.2	902	600.30	584.00	0.0181	Unpaved	2.17	6.9														0	0	-	0.0	20.0	26.1

RECORD DRAWING

THIS DRAWING HAS BEEN REVISED TO SHOW THOSE CHANGES DURING THE CONSTRUCTION PROCESS REPORTED BY THE CONTRACTOR TO KIMLEY-HORN AND ASSOCIATES, INC. AND CONSIDERED TO BE SIGNIFICANT. THIS DRAWING IS NOT GUARANTEED TO BE "AS BUILT" BUT IS BASED ON THE INFORMATION MADE AVAILABLE.

DATE: 01/08/2021 BY: ANTHONY LOEFFEL, P.E.

Kimley»Horn

© 2021 KIMLEY-HORN AND ASSOCIATES, INC.
400 N. OKLAHOMA DRIVE, SUITE 105, CELINA, TX 75009
PHONE: 469-501-2200
WWW.KIMLEY-HORN.COM

TEXAS REGISTERED ENGINEERING FIRM F-928



KHA PROJECT	063234203
DATE	MARCH 2020
SCALE	AS SHOWN
DESIGNED BY:	AVL
DRAWN BY:	XXX
CHECKED BY:	BLM

EXISTING DRAINAGE
AREA MAP
CALCULATIONS



BENCHMARKS

SQUARE CUT IN CENTER OF AN INLET LOCATED ON THE NORTH SIDE OF INTERSTATE HIGHWAY 30, APPROXIMATELY 53 FEET EAST OF THE SOUTHEAST CURB RETURN OF CONVEYORS ST AND HWY 30.

ELEVATION = 587.055 FEET

SQUARE CUT ON NORTHEAST SIDE OF WATER MANHOLE RIM, LOCATED ON THE WEST SIDE OF FM HIGHWAY 549, APPROXIMATELY 1246 FEET NORTH OF THE INTERSECTION OF FM 549 AND HWY 30.

ELEVATION = 610.402 FEET

JUSTIN RD & CONVEYOR'S ST
EXTENSION
CITY OF ROCKWALL
ROCKWALL COUNTY, TEXAS

SHEET NUMBER
C-07A

Plotted By: Loeffel, Anthony Date: January 08, 2021 11:22:31am File Path: K:\CEL\Civil\063234203-Rockwall - Commercial Rdy\Cod\PlanSheets\C-Drainage Area Map.dwg

This document, together with the concepts and designs presented herein, is an instrument of service. It is intended only for the specific purpose and client for which it was prepared. Reuse of and improper reliance on this document without written authorization and adaptation by Kimley-Horn and Associates, Inc. shall be without liability to Kimley-Horn and Associates, Inc.

DRAINAGE AREA TABLE							
DRAINAGE AREA NO.	AREA (ac)	FREQUENCY FACTOR	RUNOFF COEFFICIENT "C"	RAINFALL INTENSITY "I" 1"100 (in/hr)	TIME OF CONCENTRATION (minutes)	TOTAL FLOW Q100 (cfs)	FLOWS/DRAINS TO
A2	0.23	1.00	0.90	9.80	10.0	2.0	INLET A2
A3	0.34	1.00	0.90	9.80	10.0	3.0	FUT INLET A3
A4	0.23	1.00	0.90	9.80	10.0	2.0	INLET A4
A5	0.23	1.00	0.90	9.80	10.0	2.0	INLET A5
A6	0.33	1.00	0.90	9.80	10.0	2.9	FUT INLET A6
A7	0.22	1.00	0.90	9.80	10.0	2.0	FUT INLET A7
A8	0.33	1.00	0.90	9.80	10.0	2.9	INLET A8
A9	0.34	1.00	0.90	9.80	10.0	3.0	FUT INLET A9
A10	0.33	1.00	0.90	9.80	10.0	2.9	INLET A10
A11	0.33	1.00	0.90	9.80	10.0	2.9	FUT INLET A11
A12	0.33	1.00	0.90	9.80	10.0	2.9	INLET A12
A13	0.33	1.00	0.90	9.80	10.0	2.9	FUT INLET A13
A14	0.34	1.00	0.90	9.80	10.0	3.0	INLET A14
A15	0.34	1.00	0.90	9.80	10.0	3.0	FUT INLET A15
A16	0.31	1.00	0.90	9.80	10.0	2.7	INLET A16
B1	0.60	1.00	0.90	9.80	10.0	5.3	FUT INLET B0
B2	0.58	1.00	0.90	9.80	10.0	5.1	INLET B1
C	6.57	1.00	0.70	8.25	20.3	38.0	LINE B
D	10.77	1.00	0.35	7.96	22.4	30.0	LINE B
E	4.59	1.00	0.35	8.30	20.0	13.3	LINE E
E1	0.23	1.00	0.90	9.80	10.0	2.0	INLET E1
E2	0.33	1.00	0.90	9.80	10.0	2.9	FUT INLET E2
OS2	0.20	1.00	0.90	9.80	10.0	1.7	FUT INLET OS
OS3	0.10	1.00	0.90	9.80	10.0	0.9	FUT INLET OS
OS4	29.14	1.00	0.35	7.44	26.1	75.9	OUTFALL F
OS5	18.58	1.00	0.35	6.86	30.4	44.6	OUTFALL E
OS6	25.57	1.00	0.35	6.45	34.1	57.7	OUTFALL A
OS7	4.96	1.00	0.35	7.66	24.6	13.3	OUTFALL C
OS8	2.77	1.00	0.70	7.55	25.4	14.6	OUTFALL D
OS9	3.31	1.00	0.35	8.30	20.0	9.6	POND
OS10	4.92	1.00	0.35	7.78	23.7	13.4	OUTFALL B
POND	1.56	1.00	0.35	8.72	17.0	4.8	OUTFALL B

AREAS C, D, E, OS4, OS5, OS6, OS7, OS8, OS9 & OS10 WILL NEED TO BE DETAINED WHEN DEVELOPED IN THE FUTURE.

Proposed Condition Weighted Runoff Coefficient Calculations					
Design Point	Drainage Area	Area (ac)	Runoff Coefficient	Total Area	Weighted C
B	A2	0.23	0.9	14.35	0.52
	A3	0.34	0.9		
	A4	0.23	0.9		
	A5	0.23	0.9		
	A6	0.33	0.9		
	A7	0.22	0.9		
	A8	0.33	0.9		
	A9	0.34	0.9		
	A10	0.33	0.9		
	A11	0.33	0.9		
	A12	0.33	0.9		
	A13	0.33	0.9		
	A14	0.34	0.9		
	A15	0.34	0.9		
	A16	0.31	0.9		
	POND	1.56	0.35		
C	OS9	3.31	0.35	23.78	0.38
	OS10	4.92	0.35		
	B1	0.6	0.9		
	B2	0.58	0.9		
	C	6.57	0.35		
	D	10.77	0.35		
	OS2	0.2	0.9		
	OS3	0.1	0.9		
F	OS7	4.96	0.35	34.29	0.36
	E	4.59	0.35		
	E1	0.23	0.9		
	E2	0.33	0.9		
	OS4	29.14	0.35		

Proposed Condition Design Point Summary						
Design Point	Contributing DA's	Area (ac)	Runoff Coefficient	Intensity (in/hr)	TOC (min)	Q ₁₀₀ (cfs)
A	OS6	25.57	0.35	6.45	34.1	57.8
B	A2-16,POND,OS9,OS10	14.35	0.52	8.69	17.2	64.9
C	B1,B2,C,D,OS2,OS3,OS7	23.78	0.38	7.46	26.0	67.4
D	OS8	2.77	0.35	7.55	25.4	7.3
E	OS5	18.58	0.35	6.86	30.4	44.6
F	E,E1,E2,OS4	34.29	0.36	7.44	26.1	91.6
Line B	C & D	17.34	0.35	7.19	27.9	43.7
Line E	E	4.59	0.35	8.30	20.0	13.3

PROPOSED TIME OF CONCENTRATION																																	
TR-55 Methodology																																	
Basin	SHEET FLOW						SHALLOW CONCENTRATED FLOW						OPEN CHANNEL FLOW										STORM SEWER FLOW					TOTAL					
	Tc = (0.007(nL) ^{0.8})/(P ² ^{0.5})(s ^{0.4})						Tc = L / 3600*K*S ^{0.5} K = 16.13 for unpaved, K = 20.32 for paved						Tc = L / 3600*(1.49/n)*(R ^{2/3})*(S ^{1/2})										Tc = L / 60*V										
	2-year/24-hr Rainfall Depth from City of Rockwall Drainage Design Manual (in.) = 4.09																																
	Length (ft)	Elev ₁	Elev ₂	Slope (ft/ft)	Manning's "n"	T _{c1} (min)	Length (ft)	Elev ₂	Elev ₃	Slope (ft/ft)	Condition TR-55 Fig. 3-1	V _{avg} (ft/s)	T _{c2} (min)	Length (ft)	Manning's "n"	Width (ft)	Side Slope (ft/ft)	Depth (ft)	Area (ft^2)	Perimeter (ft)	Radius (ft)	Elev ₃	Elev ₄	Slope (ft/ft)	V _{avg} (ft/s)	T _{c3} (min)	Inlet Time (min)	Length (ft)	V _{avg} (ft/s)	T _{c4} (min)	T _c MINIMUM (min)	T _c TOTAL (min)	
DP-A (OS-6)	100	607.00	606.00	0.0100	0.240	16.7	1724	606.00	580.00	0.0151	Unpaved	1.98	14.5	585	0.03	-	-	1.04	14.7	19.8	0.74	580.0	576.0	0.0068	3.4	2.9	0	0	-	0.0	20.0	34.1	
DP-B*																											REFERENCE LINE SD-A STORM CALCS					10.0	17.2
OS-9	100	597.00	595.50	0.0150	0.240	14.2	642	595.50	585.00	0.0164	Unpaved	2.06	5.2													0	0	-	0.0	20.0	20.0		
OS-10	100	599.00	597.20	0.0180	0.240	13.2	1025	597.20	583.00	0.0139	Unpaved	1.90	9.0	214	0.03	-	-	0.19	4.9	30.1	0.16	583.0	578.0	0.0234	2.3	1.6	0	0	-	0.0	20.0	23.7	
POND	100	585.00	580.00	0.0500	0.240	8.7	230	580.00	578.65	0.0059	Unpaved	1.24	3.1													0	0	-	1.0	20.0	20.0		
DP-C	100	601.00	600.10	0.0090	0.240	17.4	623	600.10	590.00	0.0162	Unpaved	2.05	5.1	837	0.03	-	-	1.38	15.6	19.5	0.80	590.0	583.0	0.0084	3.9	3.6	0	0	-	0.0	20.0	26.0	
OS-7	100	590.40	589.00	0.0140	0.240	14.6	825	589.00	583.00	0.0073	Unpaved	1.38	10.0													0	0	-	0.0	20.0	24.6		
DP-D (OS-8)	100	591.00	590.40	0.0060	0.240	20.4	618	590.40	580.00	0.0168	Unpaved	2.09	4.9													0	0	-	0.0	20.0	25.4		
DP-E (OS-5)	100	601.00	600.20	0.0080	0.240	18.2	1087	600.20	589.00	0.0103	Unpaved	1.64	11.1	307	0.03	-	-	1.37	8.7	11.9	0.73	589.0	585.0	0.0130	4.6	1.1	0	0	-	0.0	20.0	30.4	
DP-F (OS-4)	100	601.00	600.30	0.0070	0.240	19.2	902	600.30	584.00	0.0181	Unpaved	2.17	6.9													0	0	-	0.0	20.0	26.1		
C	100	591.70	590.50	0.0120	0.240	15.5	496	590.50	585.00	0.0111	Unpaved	1.70	4.9													0	0	-	0.0	20.0	20.3		
D	100	601.00	600.10	0.0090	0.240	17.4	623	600.10	590.00	0.0162	Unpaved	2.05	5.1													0	0	-	0.0	20.0	22.4		
LINE B	100	601.00	600.10	0.0090	0.240	17.4	623	600.10	590.00	0.0162	Unpaved	2.05	5.1	667	0.03	-	-	0.52	17	63.7	0.27	590.0	583.5	0.0097	2.0	5.5	0	0	-	0.0	20.0	27.9	
LINE E (E)	100	610.00	608.50	0.0150	0.240	14.2	414	608.50	603.00	0.0133	Unpaved	1.86	3.7													0	0	-	0.0	20.0	20.0		



Know what's below.
Call before you dig.

BENCHMARKS

SQUARE CUT IN CENTER OF AN INLET LOCATED ON THE NORTH SIDE OF INTERSTATE HIGHWAY 30, APPROXIMATELY 53 FEET EAST OF THE SOUTHEAST CURB RETURN OF CONVEYORS ST AND HWY 30.

ELEVATION = 587.055 FEET

SQUARE CUT ON NORTHEAST SIDE OF WATER MANHOLE RIM, LOCATED ON THE WEST SIDE OF FM HIGHWAY 549, APPROXIMATELY 1246 FEET NORTH OF THE INTERSECTION OF FM 549 AND HWY 30.

ELEVATION = 610.402 FEET


RECORD DRAWING

THIS DRAWING HAS BEEN REVISED TO SHOW THOSE CHANGES DURING THE CONSTRUCTION PROCESS REPORTED BY THE CONTRACTOR TO KIMLEY-HORN AND ASSOCIATES, INC. AND CONSIDERED TO BE SIGNIFICANT. THIS DRAWING IS NOT GUARANTEED TO BE "AS BUILT" BUT IS BASED ON THE INFORMATION MADE AVAILABLE.

DATE: 01/08/2021 BY: ANTHONY LOEFFEL, P.E.

Kimley»Horn

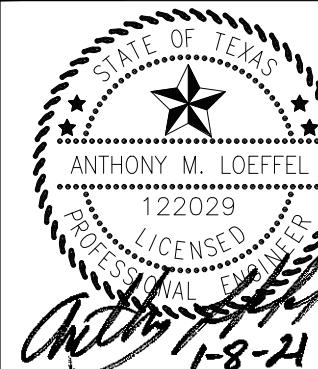© 2021 KIMLEY-HORN AND ASSOCIATES, INC.
400 N. OKLAHOMA DRIVE, SUITE 05, CELINA, TX 75009
PHONE: 469-501-2200
WWW.KIMLEY-HORN.COM



KHA PROJECT	DATE	SCALE	DESIGNED BY:	DRAWN BY:	CHECKED BY:
063234203	MARCH 2020	AS SHOWN	AVL	XXX	BLM

DRAINAGE AREA MAP CALCULATIONS

JUSTIN RD & CONVEYOR'S ST
EXTENSION
CITY OF ROCKWALL
ROCKWALL COUNTY, TEXAS

SHEET NUMBER

C-08A

BY	DATE	REVISIONS	No.

Plotted By: Loeffel, Anthony Date: January 08, 2021 11:22:41am File Path: K:\CEL\Civil\063234203--Rockwall-- Commercial Rwy\CD\PlanSheets\C--Drainage Calculations.dwg
This document, together with the concepts and designs presented herein, is an instrument of service. It is intended only for the specific purpose and client for which it was prepared. Reuse of and improper reliance on this document without written authorization and adaptation by Kimley-Horn and Associates, Inc. shall be without liability to Kimley-Horn and Associates, Inc.

Storm Drain Calculations																																				
From	To	Pipe Length	Drainage Area			Runoff "c"	Incr. cA	Total cA	Time of Concentration			100-year Intensity	100-year Runoff	Inlet Carryover	Inlet Carryover	Q Pipe	Pipe Size Diameter	n	Sf	HGL		Head Loss Calculations								Design HGL	Invert Elevation		T/C or Ground	T/C-HG	<div>RECORD DRAWING THIS DRAWING HAS BEEN REVISED TO SHOW THOSE CHANGES DURING THE CONSTRUCTION PROCESS REPORTED BY THE CONTRACTOR TO KIMLEY-HORN AND ASSOCIATES, INC. AND CONSIDERED TO BE SIGNIFICANT. THIS DRAWING IS NOT GUARANTEED TO BE "AS BUILT" BUT IS BASED ON THE INFORMATION MADE AVAILABLE. DATE: 01/08/2021 BY: ANTHONY LOEFFEL, P.E.</div>	
			Increme No.	Area	Total				Inlet	Travel	Total									V1 (in)	V2 (out)	V1 ² /2G	V2 ² /2G	Kj	KjV1 ⁴ /2G	Hk	From	To								
																													U/S		D/S	ft/s				ft/s
1	2	3	4	5	6	7	8	9	10	11	12	13	14	15	16	17	18	18a	21	22	23	24	25	26	27	28	29	30	31	32	33	34	35	ft		
LINE SD-A																																				
24+12.83	23+48.82	64.01	A	0.23	0.23	0.90	0.20	0.20	10.0	0.2	10.2	9.80	1.99	0.00	0.00	1.99	18	1	0.013	0.0004	600.62	599.55	0.00	5.83	0.00	0.53	1.25	0.66	0.66	601.28	600.24	598.98	604.22	2.94		
23+48.82	21+64.81	184.01	A	0.00	0.23	0.90	0.00	0.20	10.2	0.9	11.1	9.80	1.99	0.00	0.00	1.99	18	1	0.013	0.0004	599.55	598.82	5.83	3.30	0.53	0.17	0.37	0.20	0.00	599.55	598.98	598.25	603.77	4.22		
21+64.81	19+09.53	255.28	A	0.57	0.79	0.90	0.51	0.71	11.1	1.5	12.6	9.80	6.98	0.00	0.00	6.98	21	1	0.013	0.0019	598.60	597.78	3.30	2.90	0.17	0.13	1.00	0.17	PARTIAL	598.60	598.00	595.94	602.48	3.88		
19+09.53	18+14.95	94.58	A	0.23	1.02	0.90	0.20	0.91	12.6	0.2	12.8	9.80	8.97	0.00	0.00	8.97	21	1	0.013	0.0032	597.23	596.93	2.90	6.60	0.13	0.68	1.00	0.13	0.55	597.78	595.94	595.18	600.69	2.91		
18+14.95	16+65.00	149.95	A	0.33	1.35	0.90	0.30	1.21	12.8	0.5	13.3	9.80	11.88	0.00	0.00	11.88	21	1	0.013	0.0056	596.41	595.26	6.60	4.94	0.68	0.38	1.00	0.68	0.00	596.41	595.18	593.98	600.03	3.62		
16+65.00	15+85.70	79.30	A	0.00	1.35	0.90	0.00	1.21	13.3	0.3	13.6	9.80	11.88	0.00	0.00	11.88	24	1	0.013	0.0028	595.25	595.03	4.94	3.78	0.38	0.22	0.05	0.02	0.01	595.26	593.73	592.94	598.98	3.72		
15+85.70	15+70.63	15.07	A	0.22	1.57	0.90	0.20	1.41	13.6	0.0	13.6	9.80	13.84	0.00	0.00	13.84	24	1	0.013	0.0037	594.29	594.23	3.78	7.89	0.22	0.97	1.00	0.22	0.74	595.03	592.94	592.79	598.42	3.39		
15+70.63	12+54.08	316.55	A	0.33	1.90	0.90	0.30	1.71	13.6	0.6	14.2	9.80	16.79	0.00	0.00	16.79	24	1	0.013	0.0055	594.07	591.62	7.89	8.52	0.97	1.13	1.00	0.97	0.16	594.23	592.79	589.62	598.32	4.09		
12+54.08	9+12.72	341.36	A	0.66	2.57	0.90	0.60	2.31	14.2	1.0	15.2	9.80	22.64	0.00	0.00	22.64	27	1	0.013	0.0053	590.81	588.06	8.52	5.69	1.13	0.50	1.00	1.13	0.50	591.31	589.37	585.96	596.12	4.81		
9+12.72	5+72.72	340.00	A	0.66	3.23	0.90	0.60	2.91	15.2	1.1	16.3	9.00	26.16	0.00	0.00	26.16	30	1	0.013	0.0041	587.62	586.24	5.69	5.33	0.50	0.44	1.00	0.50	0.44	588.06	585.71	582.96	592.59	4.53		
5+72.72	5+46.74	25.98	A	0.33	3.56	0.90	0.29	3.20	16.3	0.1	16.4	9.00	28.81	0.00	0.00	28.81	30	1	0.013	0.0049	585.70	585.57	5.33	5.87	0.44	0.53	1.00	0.44	0.53	586.24	582.96	582.84	588.16	1.92		
5+46.74	3+66.87	179.87	A	0.34	3.89	0.90	0.30	3.50	16.4	0.5	16.9	9.00	31.54	0.00	0.00	31.54	30	1	0.013	0.0059	585.47	584.41	5.87	6.42	0.53	0.64	1.00	0.53	0.11	585.57	582.84	581.43	588.05	2.48		
3+66.87	3+63.87	3.00	A	0.00	3.89	0.90	0.00	3.50	16.9	0.0	16.9	9.00	31.54	0.00	0.00	31.54	36	1	0.013	0.0022	584.21	584.20	6.42	4.46	0.64	0.31	0.00	0.00	0.20	584.41	580.93	580.91	586.79	2.38		
3+63.87	3+29.07	34.80	A	0.34	4.23	0.90	0.31	3.81	16.9	0.1	17.0	9.00	34.29	0.00	0.00	34.29	36	1	0.013	0.0026	583.84	583.75	4.46	4.85	0.31	0.37	1.00	0.37	0.37	584.20	580.91	580.64	586.77	2.57		
3+29.07	2+60.00	69.07	A	0.31	4.54	0.90	0.28	4.09	17.0	0.2	17.2	9.00	36.80	0.00	0.00	36.80	36	1	0.013	0.0030	583.64	583.43	4.85	5.21	0.37	0.42	0.25	0.09	0.11	583.75	580.64	580.43	586.53	2.78		

LATERAL A-3																																																																																																																																																																																																																																																																																																																																																																																																																																																																																																																																																																																																																																																																																																																																																																																																																																																																																																																																																																																																																																																																																																																																																																																																																																																																																																																																																																																																																																																																				
-------------	--	--	
LATERAL A-4																																																																																																																																																																																																																																																																																																																																																																																																																																																																																																																																																																																																																																																																																																																																																																																																																																																																																																																																																																																																																																																																																																																																																																																																																																																																																																																																																																																																																																																																				
-------------	--	--	
LATERAL A-5																																																																																																																																																																																																																																																																																																																																																																																																																																																																																																																																																																																																																																																																																																																																																																																																																																																																																																																																																																																																																																																																																																																																																																																																																																																																																																																																																																																																																																																																			
-------------	--	--	
LATERAL A-6																																																																																																																																																																																																																																																																																																																																																																																																																																																																																																																																																																																																																																																																																																																																																																																																																																																																																																																																																																																																																																																																																																																																																																																																																																																																																																																																																																																																																																																																																																																								</
-------------	--	--	----

LATERAL A-7																																																																																																																																																																																																																																																																																																																																																																																																																																																																																																																																																																																																																																																																																																																																																																																																																																																																																																																																																																																																																																																																																																																																																																																																																																																																																																																																																																																																																																																																																																																										</
-------------	--	--	----

LATERAL A-8																																																																																																																																																																																																																																																																																																																																																																																																																																																																																																																																																																																																																																																																																																																																																																																																																																																																																																																																																																																																																																																																																																																																																																																																																																																																																																																																																																																																																																																																																																																								</
-------------	--	--	----

LATERAL A-9																																																																																																																																																																																																																																																																																																																																																																																																																																																																																																																																																																																																																																																																																																																																																																																																																																																																																																																																																																																																																																																																																																																																																																																																																																																																																																																																																																																																																																																																																																																								</
-------------	--	--	----

Plotted By: Loeffel, Anthony Date: January 08, 2021 11:22:50am File Path: K:\DEL_Civil\063234203-Rockwall - Commercial Rwy\Cod\PlanSheets\C--Drainage Calculations.dwg

This document, together with the concepts and designs presented herein, as an instrument of service, is intended only for the specific purpose and client for which it was prepared. Reuse of and improper reliance on this document without written authorization and adaptation by Kimley-Horn and Associates, Inc. shall be without liability to Kimley-Horn and Associates, Inc.

INLET LOCATION				Design Storm Frequency (YRS)	AREA RUNOFF							Total Gutter Flow "Q _T " (CFS)	Roadway Classification	On-Grade or Sump	Mann-ing's "n"	Roadway Longitudinal Slope		Crown Type	Roadway Cross Slope "S _x " (FT/FT)	Depth of Depres-sion (FT)	Width of Depres-sion "W" (FT)	Flow Spread "T" (allow) (FT)	Flow Spread "T" (actual) (FT)	Gutter Flow Depth "y" (allow) (FT)	Gutter Flow Depth "y" (actual) (FT)	Max. Flow based on allow (FT)	INLETS CAPACITY				Conve-yance Depressed Kw	Conve-yance Beyond Depressed Ko	Flow Ratio "E _o " (FT/FT)	Equiv-alent Cross Slope "S _o " (FT/FT)	Required Length "L _r " (FT)	Actual Length "L" (FT)	Inlet Capacity "Q _i " (CFS)	Bypass Flow "Q _b " (CFS)	Runoff Coeff. "C"	Bypass Destination
Inlet No.	Street	Station (FT)	Offset		Runoff Coeff. "C"	Area ID	Time of Concen-tration "T _c " (MIN)	Rainfall Intensity "i" (IN/HR)	Area "A" (AC)	Storm Water Runoff "Q" (CFS)	Upstream Bypass Flow "C*A" (CFS)					On Grade/ Sump Lower Station "S _L " (FT/FT)	Sump Higher Station "S _H " (FT/FT)																							
																											Depressed Gutter Section	Wetted Perimeter "P _w " (FT)	Depression	Wetted Perimeter "P _o " (FT)										
1	2	3	4	5	6	7	8	9	10	11	12	13	14	15	16	17	17	18	19	20	21	22	23	24	25	26	27	28	29	30	31	32	33	34	35	36	37	38	39	40
A2	Justin Road	32+20.00	00+32.00	100	0.90	A2	10	9.80	0.23	2.03	0.00	2.03	M4D	On-Grade	0.0175	0.007	N/A	Straight	0.0200	0.50	2.00	12.00	10.37	0.24	0.21	2.98	0.87	2.07	0.70	8.37	41.80	11.37	0.79	0.22	5.17	10	2.03	0.00	0.00	
A3	Justin Road	FUTURE	00+32.00	100	0.90	A3	10	9.80	0.34	2.95	0.00	2.95	M4D	On-Grade	0.0175	0.007	N/A	Straight	0.0200	0.50	2.00	12.00	11.94	0.24	0.24	2.98	0.94	2.07	0.99	9.94	46.92	17.99	0.72	0.20	6.34	10	2.95	0.00	0.00	
A4	Justin Road	29+90.00	00+32.00	100	0.90	A4	10	9.80	0.23	2.03	0.00	2.03	M4D	On-Grade	0.0175	0.007	N/A	Straight	0.0200	0.50	2.00	12.00	10.37	0.24	0.21	2.98	0.87	2.07	0.70	8.37	41.80	11.37	0.79	0.22	5.17	10	2.03	0.00	0.00	
A5	Justin Road	27+60.00	00+32.00	100	0.90	A5	10	9.80	0.23	2.03	0.00	2.03	M4D	On-Grade	0.0175	0.007	N/A	Straight	0.0200	0.50	2.00	12.00	10.37	0.24	0.21	2.98	0.87	2.07	0.70	8.37	41.80	11.37	0.79	0.22	5.17	10	2.03	0.00	0.00	
A6	Justin Road	FUTURE	00+32.00	100	0.90	A6	10	9.80	0.33	2.91	0.00	2.91	M4D	On-Grade	0.0175	0.007	N/A	Straight	0.0200	0.50	2.00	12.00	11.87	0.24	0.24	2.98	0.93	2.07	0.97	9.87	46.70	17.67	0.73	0.20	6.29	10	2.91	0.00	0.00	
A7	Justin Road	FUTURE	00+32.00	100	0.90	A7	10	9.80	0.22	1.97	0.00	1.97	M4D	On-Grade	0.0175	0.007	N/A	Straight	0.0200	0.50	2.00	12.00	10.25	0.24	0.21	2.98	0.87	2.07	0.68	8.25	41.43	10.96	0.79	0.22	5.09	10	1.97	0.00	0.00	
A8	Justin Road	24+20.00	00+32.00	100	0.90	A8	10	9.80	0.33	2.94	0.00	2.94	M4D	On-Grade	0.0175	0.007	N/A	Straight	0.0200	0.50	2.00	12.00	11.92	0.24	0.24	2.98	0.94	2.07	0.98	9.92	46.85	17.89	0.72	0.20	6.32	10	2.94	0.00	0.00	
A9	Justin Road	FUTURE	00+32.00	100	0.90	A9	10	9.80	0.33	2.91	0.00	2.91	M4D	On-Grade	0.0175	0.007	N/A	Straight	0.0200	0.50	2.00	12.00	11.87	0.24	0.24	2.98	0.93	2.07	0.97	9.87	46.70	17.67	0.73	0.20	6.29	10	2.91	0.00	0.00	
A10	Justin Road	20+80.00	00+32.00	100	0.90	A10	10	9.80	0.33	2.91	0.00	2.91	M4D	On-Grade	0.0175	0.007	N/A	Straight	0.0200	0.50	2.00	12.00	11.87	0.24	0.24	2.98	0.93	2.07	0.97	9.87	46.70	17.67	0.73	0.20	6.29	10	2.91	0.00	0.00	
A11	Justin Road	FUTURE	00+32.00	100	0.90	A11	10	9.80	0.33	2.95	0.00	2.95	M4D	On-Grade	0.0175	0.013	N/A	Straight	0.0200	0.50	2.00	12.00	10.65	0.24	0.21	4.03	0.89	2.07	0.75	8.65	42.70	12.42	0.77	0.21	7.31	10	2.95	0.00	0.00	
A12	Justin Road	17+40.00	00+32.00	100	0.90	A12	10	9.80	0.33	2.95	0.00	2.95	M4D	On-Grade	0.0175	0.013	N/A	Straight	0.0200	0.50	2.00	12.00	10.65	0.24	0.21	4.03	0.89	2.07	0.75	8.65	42.70	12.42	0.77	0.21	7.31	10	2.95	0.00	0.00	
A13	Justin Road	FUTURE	00+32.00	100	0.90	A13	10	9.80	0.33	2.88	0.00	2.88	M4D	On-Grade	0.0175	0.013	N/A	Straight	0.0200	0.50	2.00	12.00	10.56	0.24	0.21	4.03	0.88	2.07	0.73	8.56	42.41	12.08	0.78	0.21	7.22	10	2.88	0.00	0.00	
A14	Justin Road	14+00.00	00+32.00	100	0.90	A14	10	9.80	0.34	2.97	0.00	2.97	M4D	On-Grade	0.0175	0.013	N/A	Straight	0.0200	0.50	2.00	12.00	10.68	0.24	0.21	4.03	0.89	2.07	0.75	8.68	42.81	12.55	0.77	0.21	7.34	10	2.97	0.00	0.00	
A15	Justin Road	FUTURE	00+32.00	100	0.90	A15	10	9.80	0.34	3.00	0.00	3.00	M4D	On-Grade	0.0175	0.013	N/A	Straight	0.0200	0.50	2.00	12.00	10.72	0.24	0.21	4.03	0.89	2.07	0.76	8.72	42.93	12.69	0.77	0.21	7.38	10	3.00	0.00	0.00	
A16	Justin Road	11+00.00	00+32.00	100	0.90	A16	10	9.80	0.31	2.73	0.00	2.73	M4D	On-Grade	0.0175	0.013	N/A	Straight	0.0200	0.50	2.00	12.00	10.35	0.24	0.21	4.03	0.87	2.07	0.70	8.35	41.76	11.33	0.79	0.22	7.02	10	2.73	0.00	0.00	
B0	Conveyors Street	FUTURE	00+17.50	100	0.90	B0	10	9.80	0.60	5.29	0.00	5.29	Collector	Sump	0.0175	0.007	0.015	Straight	0.0250	0.50	2.00	17.50	12.92	0.44	0.32	11.81	1.10	2.07	1.49	10.92	60.82	33.55	0.64	0.19	8.93	15	5.29	0.00	0.00	
B1	Conveyors Street	7+64.17	00+17.50	100	0.90	B1	10	9.80	0.60	5.29	0.00	5.29	Collector	Sump	0.0175	0.007	0.015	Straight	0.0250	0.50	2.00	17.50	12.92	0.44	0.32	11.81	1.10	2.07	1.49	10.92	60.82	33.55	0.64	0.19	8.93	15	5.29	0.00	0.00	
E1	Justin Road	34+50.00	00+32.00	100	0.90	E1	10	9.80	0.23	2.03	0.00	2.03	M4D	On-Grade	0.0175	0.007	N/A	Straight	0.0200	0.50	2.00	12.00	10.37	0.24	0.21	2.98	0.87	2.07	0.70	8.37	41.80	11.37	0.79	0.22	5.17	10	2.03	0.00	0.00	
E2	Justin Road	FUTURE	00+32.00	100	0.90	E2	10	9.80	0.33	2.91	0.00	2.91	M4D	On-Grade	0.0175	0.007	N/A	Straight	0.0200	0.50	2.00	12.00	11.87	0.24	0.24	2.98	0.93	2.07	0.97	9.87	46.70	17.67	0.73	0.20	6.29	10	2.91	0.00	0.00	

RECORD DRAWING

THIS DRAWING HAS BEEN REVISED TO SHOW THOSE CHANGES DURING THE CONSTRUCTION PROCESS REPORTED BY THE CONTRACTOR TO KIMLEY-HORN AND ASSOCIATES, INC. AND CONSIDERED TO BE SIGNIFICANT. THIS DRAWING IS NOT GUARANTEED TO BE "AS BUILT" BUT IS BASED ON THE INFORMATION MADE AVAILABLE.

DATE: 01/08/2021 BY: ANTHONY LOEFFEL, P.E.



KHA PROJECT
063234203
DATE
MARCH 2020
SCALE: AS SHOWN
DESIGNED BY: AVL
DRAWN BY: XXX
CHECKED BY: BLM

DRAINAGE
CALCULATIONS

JUSTIN RD & CONVEYOR'S ST
EXTENSION
CITY OF ROCKWALL
ROCKWALL COUNTY, TEXAS

SHEET NUMBER

C-10

Kimley»Horn

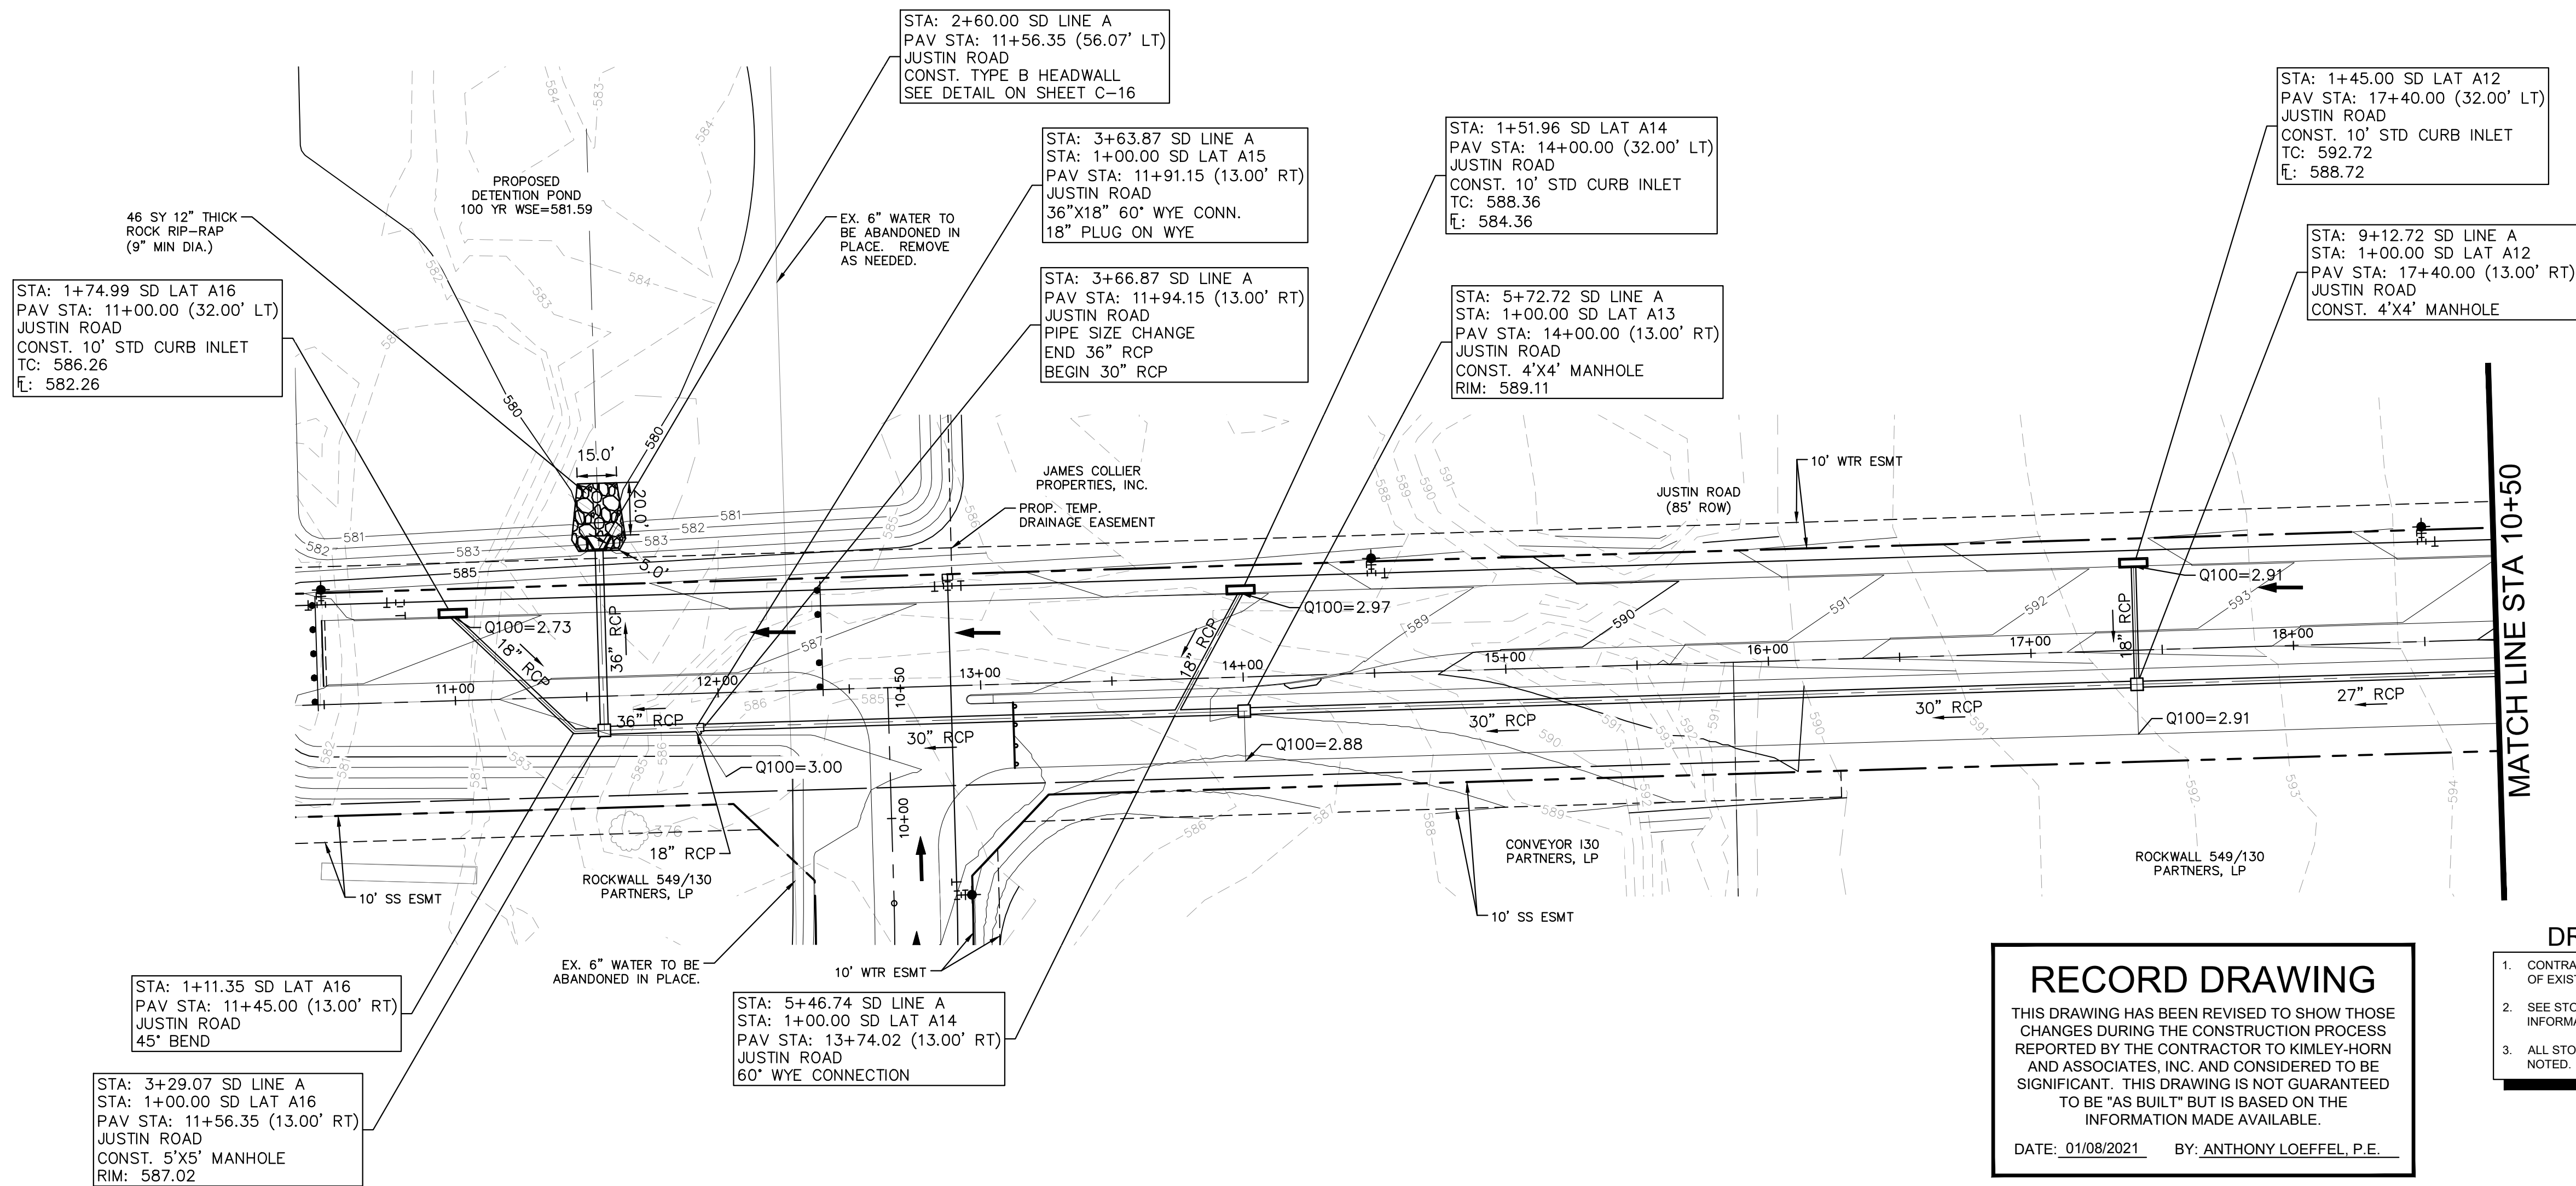
© 2021 KIMLEY-HORN AND ASSOCIATES, INC.
400 N. OKLAHOMA DRIVE, SUITE 05, CELINA, TX 75009
PHONE: 469-501-2200
WWW.KIMLEY-HORN.COM

TEXAS REGISTERED ENGINEERING FIRM F-928

No. REVISIONS

DATE

BY




RECORD DRAWING

THIS DRAWING HAS BEEN REVISED TO SHOW THOSE
CHANGES DURING THE CONSTRUCTION PROCESS
REPORTED BY THE CONTRACTOR TO KIMLEY-HORN
AND ASSOCIATES, INC. AND CONSIDERED TO BE
SIGNIFICANT. THIS DRAWING IS NOT GUARANTEED
TO BE "AS BUILT" BUT IS BASED ON THE
INFORMATION MADE AVAILABLE.

DATE: 01/08/2021 BY: ANTHONY LOEFFEL, P.E.

DRAINAGE GENERAL NOTES

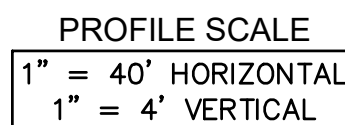
1. CONTRACTOR TO FIELD VERIFY HORIZONTAL AND VERTICAL LOCATION OF EXISTING UTILITIES PRIOR TO CONSTRUCTION.
2. SEE STORM DRAIN PLAN & PROFILE SHEETS FOR DETAILED INFORMATION ON STORM DRAIN LINES.
3. ALL STORM DRAIN LINES SHALL BE RCP, CLASS III UNLESS OTHERWISE NOTED.



BENCHMARKS

SQUARE CUT IN CENTER OF AN INLET LOCATED ON THE
NORTH SIDE OF INTERSTATE HIGHWAY 30.
APPROXIMATELY 53 FEET EAST OF THE SOUTHEAST
CURB RETURN OF CONVEYORS ST AND HWY 30.
ELEVATION = 587.055 FEET

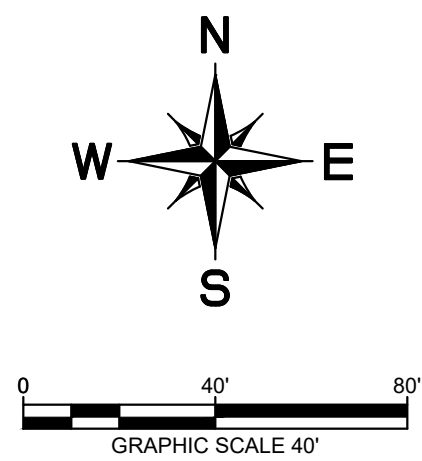SQUARE CUT ON NORTHEAST SIDE OF WATER
MANHOLE RIM, LOCATED ON THE WEST SIDE OF FM
HIGHWAY 549, APPROXIMATELY 124 FEET NORTH OF
THE INTERSECTION OF FM 549 AND HWY 30.
ELEVATION = 610.402 FEET




RECORD DRAWING

THIS DRAWING HAS BEEN REVISED TO SHOW THOSE
CHANGES DURING THE CONSTRUCTION PROCESS
REPORTED BY THE CONTRACTOR TO KIMLEY-HORN
AND ASSOCIATES, INC. AND CONSIDERED TO BE
SIGNIFICANT. THIS DRAWING IS NOT GUARANTEED
TO BE "AS BUILT" BUT IS BASED ON THE
INFORMATION MADE AVAILABLE.


DATE: 01/08/2021 BY: ANTHONY LOEFFEL, P.E.

CURVE TABLE						
CURVE	RADIUS	LENGTH	CHORD BEARING	CHORD	DELTA	TANGENT
C1	1563.00'	482.23'	N79°26'21"E	480.31'	17°40'38"	243.04'
C2	4008.90'	776.18'	N76°08'50"E	774.97'	11°05'36"	389.31'

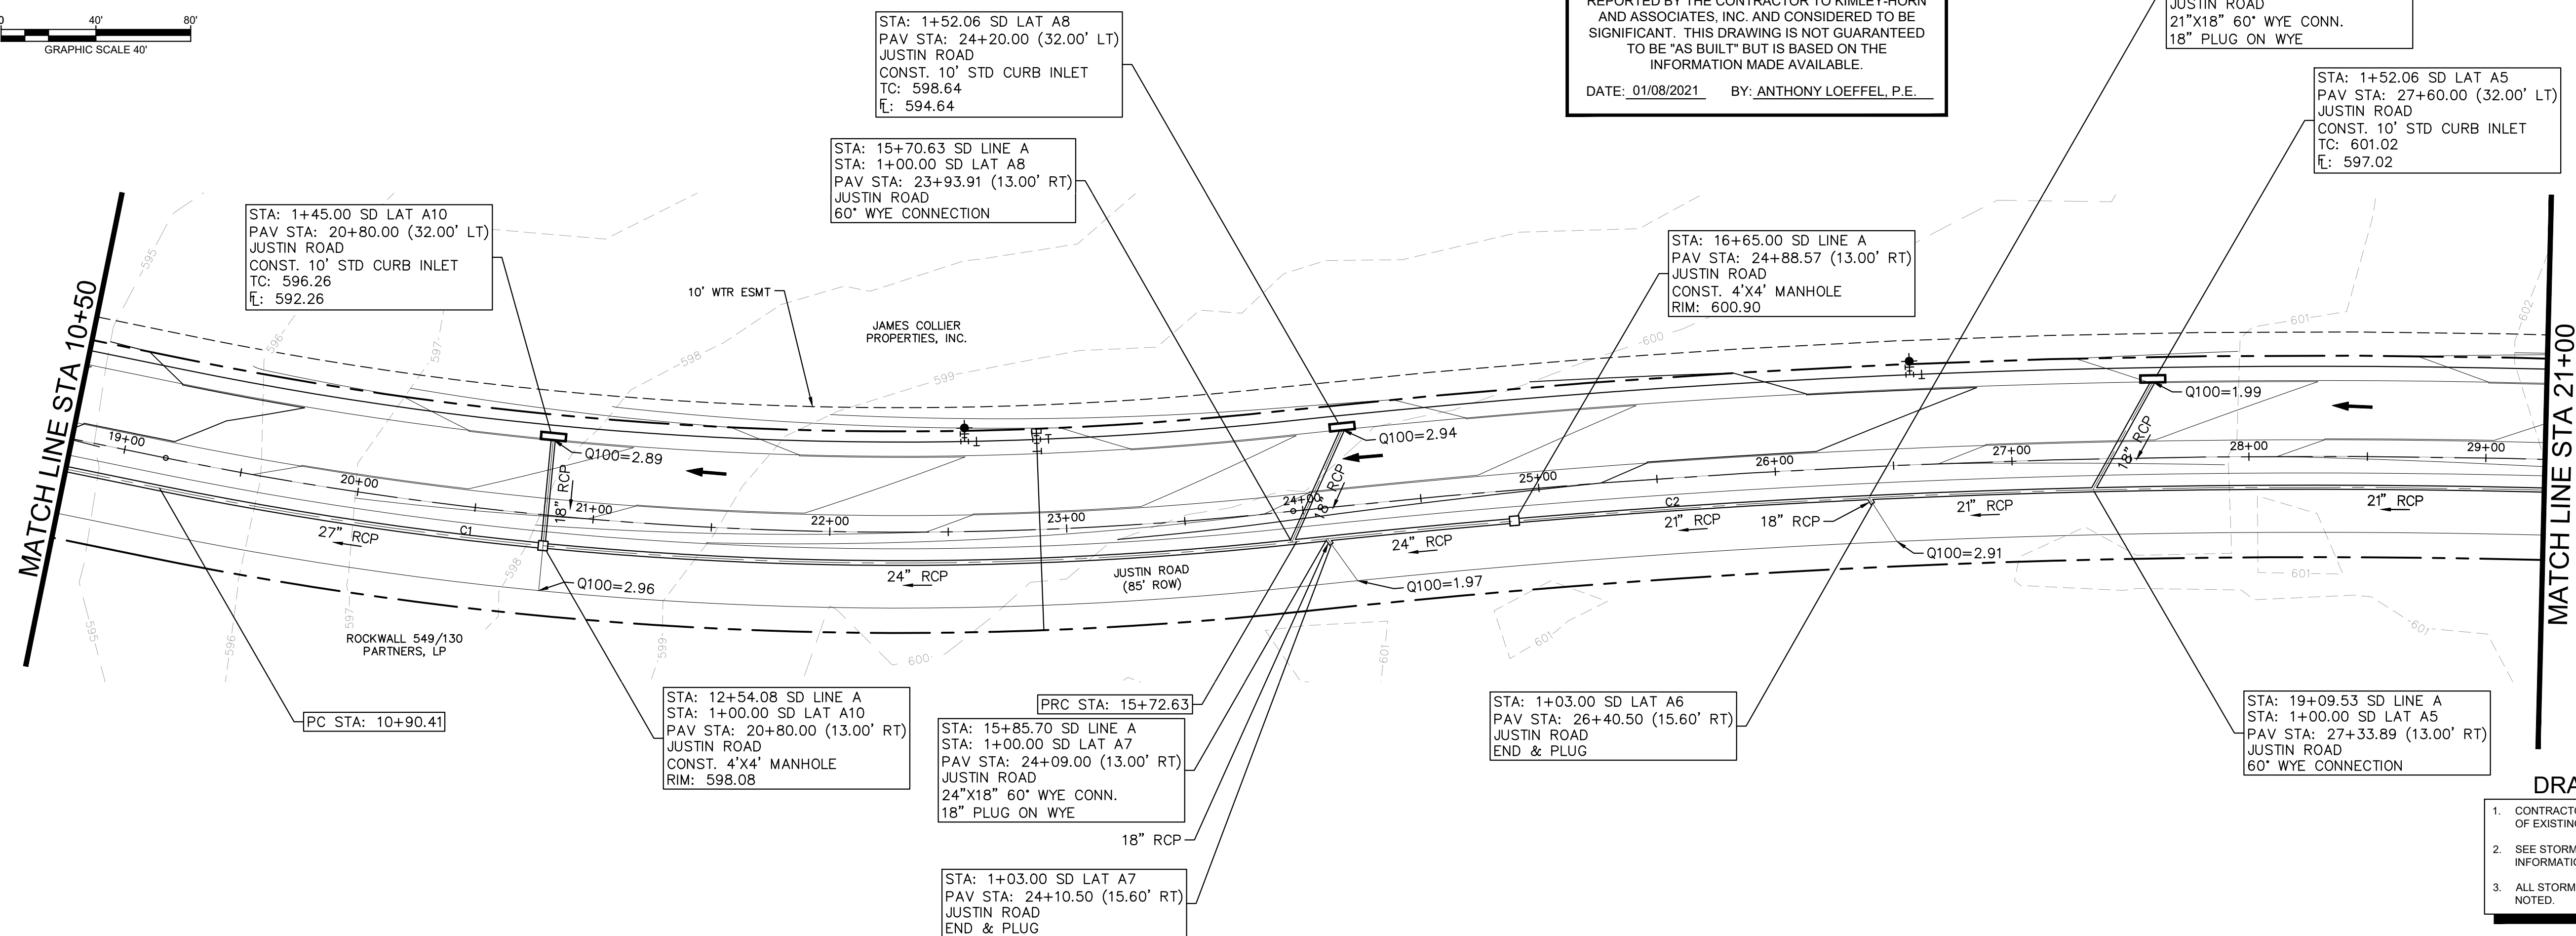

DRAINAGE GENERAL NOTES

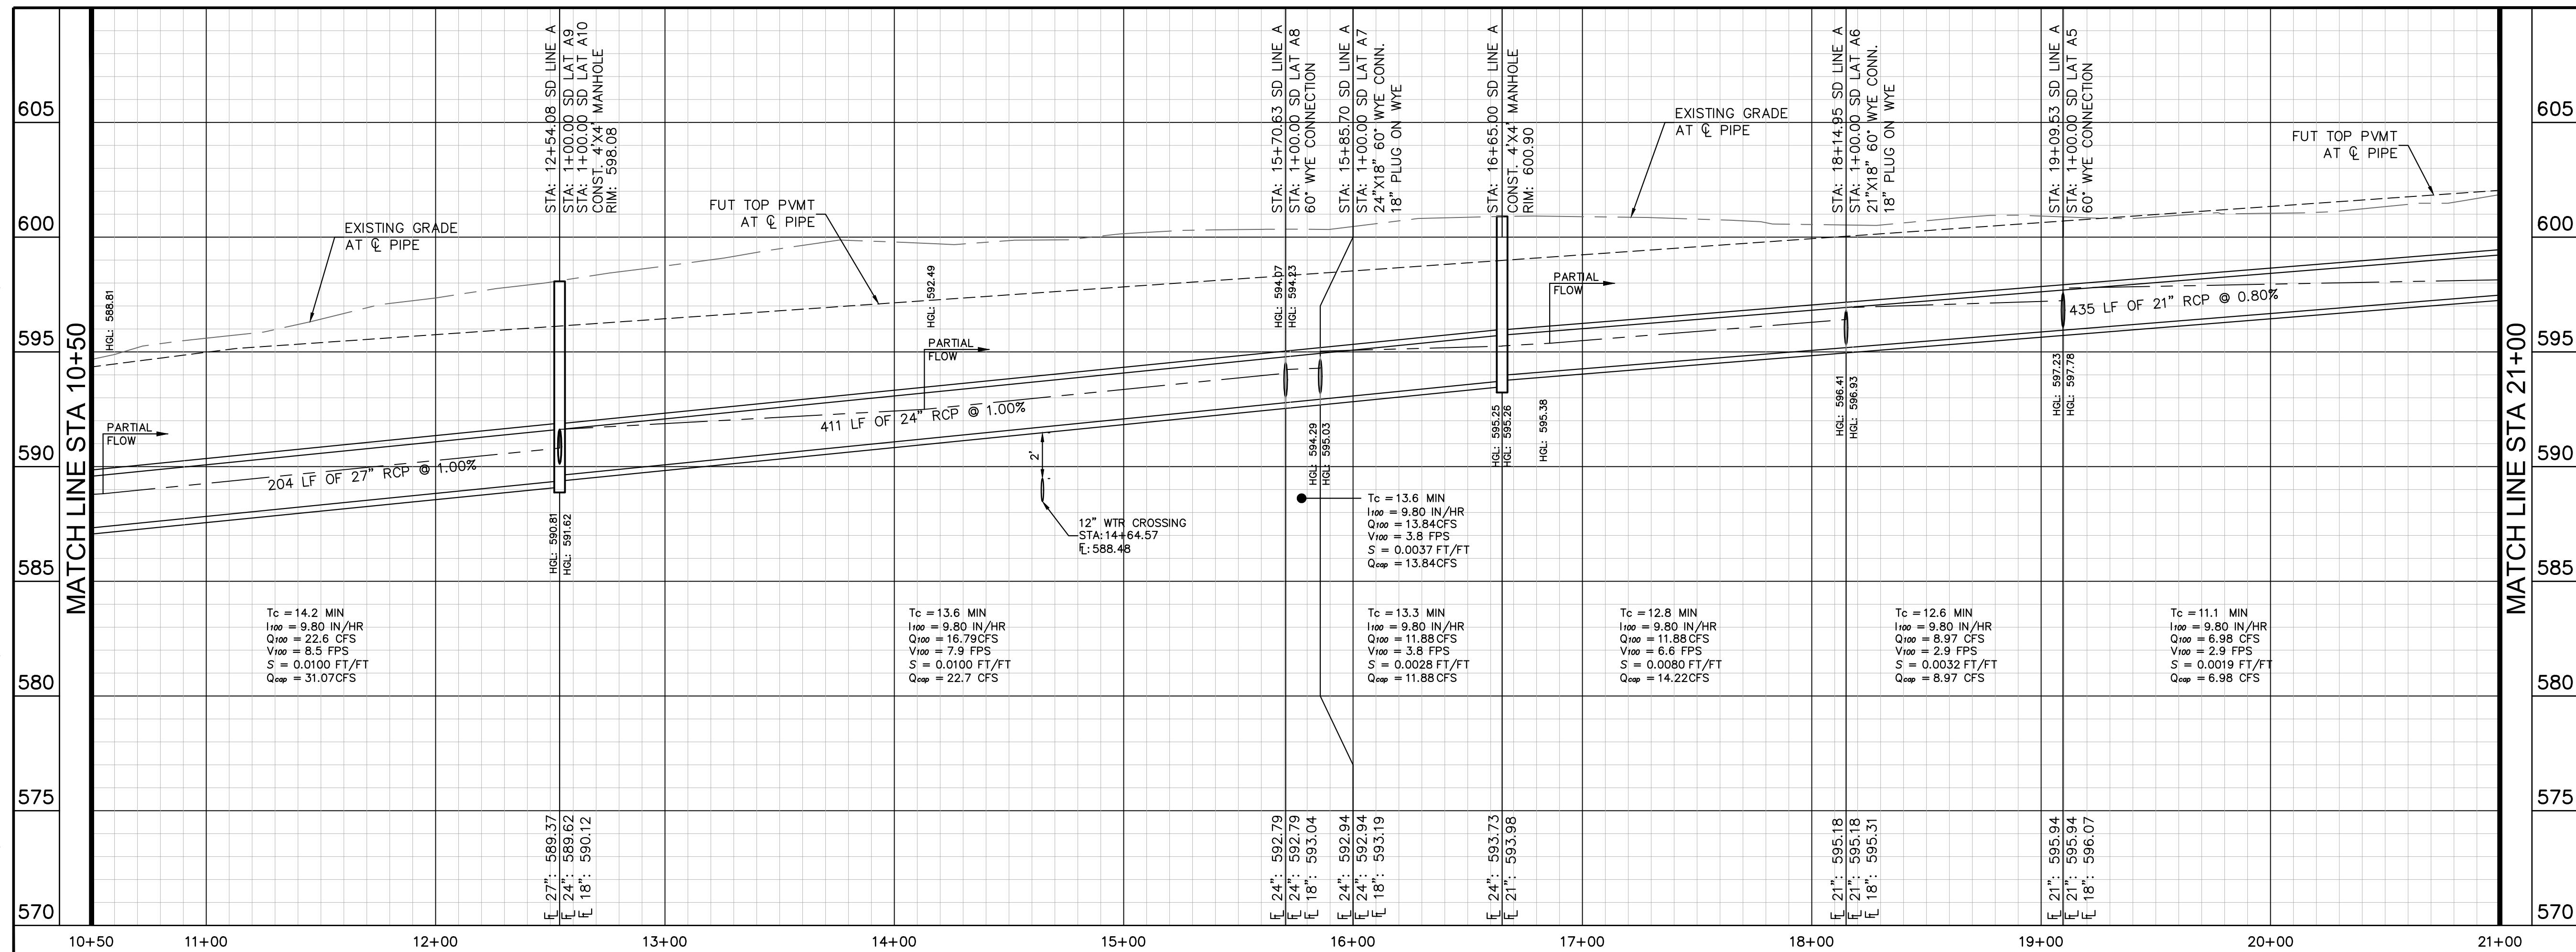1. CONTRACTOR TO FIELD VERIFY HORIZONTAL AND VERTICAL LOCATION OF EXISTING UTILITIES PRIOR TO CONSTRUCTION.
2. SEE STORM DRAIN PLAN & PROFILE SHEETS FOR DETAILED INFORMATION ON STORM DRAIN LINES.
3. ALL STORM DRAIN LINES SHALL BE RCP, CLASS III UNLESS OTHERWISE NOTED.



PROFILE SCALE
1" = 40' HORIZONTAL
1" = 4' VERTICAL

BENCHMARKS

SQUARE CUT IN CENTER OF AN INLET LOCATED ON THE NORTH SIDE OF INTERSTATE HIGHWAY 30, APPROXIMATELY 53 FEET EAST OF THE SOUTHEAST CURB RETURN OF CONVEYORS ST AND HWY 30.

ELEVATION = 587.055 FEET

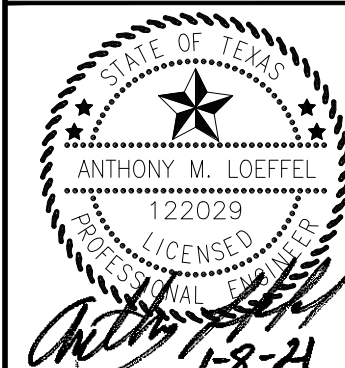
SQUARE CUT ON NORTHEAST SIDE OF WATER MANHOLE RIM, LOCATED ON THE WEST SIDE OF FM HIGHWAY 549, APPROXIMATELY 1246 FEET NORTH OF THE INTERSECTION OF FM 549 AND HWY 30.

ELEVATION = 610.402 FEET

Kimley»»Horn

© 2021 KIMLEY-HORN AND ASSOCIATES, INC.
400 N. OKLAHOMA DRIVE, SUITE 105, CELINA, TX 75009
PHONE: 469-501-2200
WWW.KIMLEY-HORN.COM

TEXAS REGISTERED ENGINEERING FIRM F-928










KHA PROJECT	DATE	SCALE: AS SHOWN	DESIGNED BY: AML	DRAWN BY: DFW	CHECKED BY: RIM
063234203	MARCH 2020				

STORM DRAIN PLAN &
PROFILE - LINE SD-A


JUSTIN RD & CONVEYOR'S ST
EXTENSION
CITY OF ROCKWALL
ROCKWALL COUNTY, TEXAS

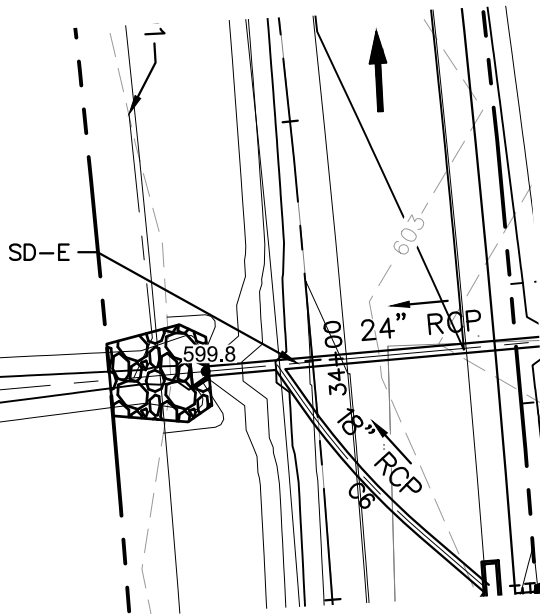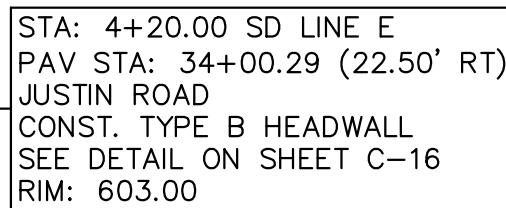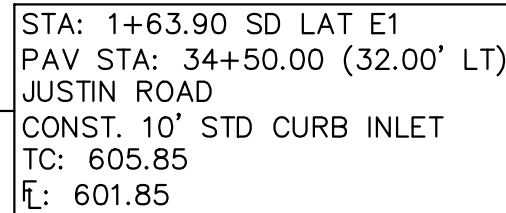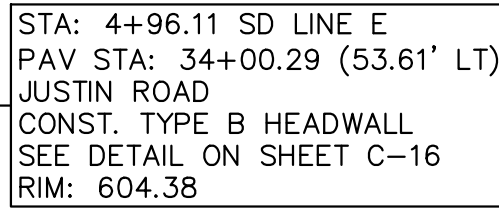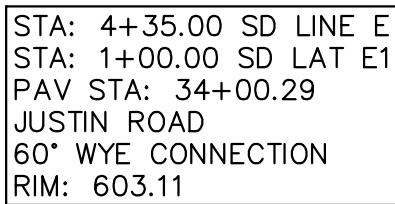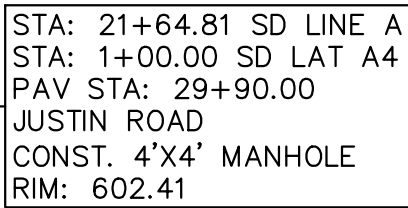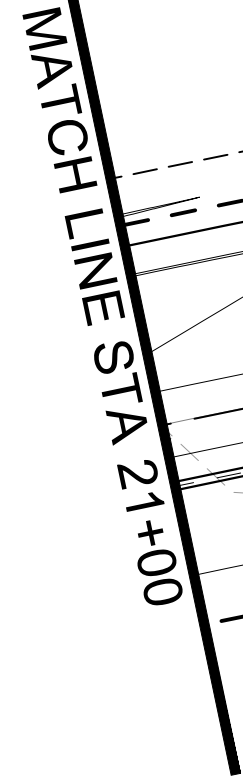SHEET NUMBER
C-12




THIS DRAWING HAS BEEN REVISED TO SHOW THOSE CHANGES DURING THE CONSTRUCTION PROCESS REPORTED BY THE CONTRACTOR TO KIMLEY-HORN AND ASSOCIATES, INC. AND CONSIDERED TO BE SIGNIFICANT. THIS DRAWING IS NOT GUARANTEED TO BE "AS BUILT" BUT IS BASED ON THE INFORMATION MADE AVAILABLE.

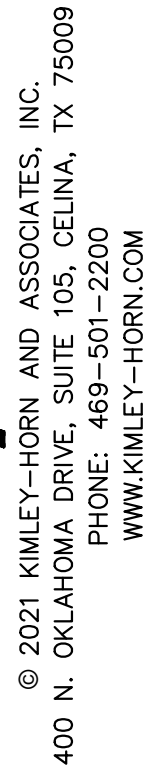DATE: 01/08/2021 BY: ANTHONY LOEFFEL, P.E.



JUSTIN RD & CONVEYOR'S ST
EXTENSION
CITY OF ROCKWALL
ROCKWALL COUNTY, TEXAS

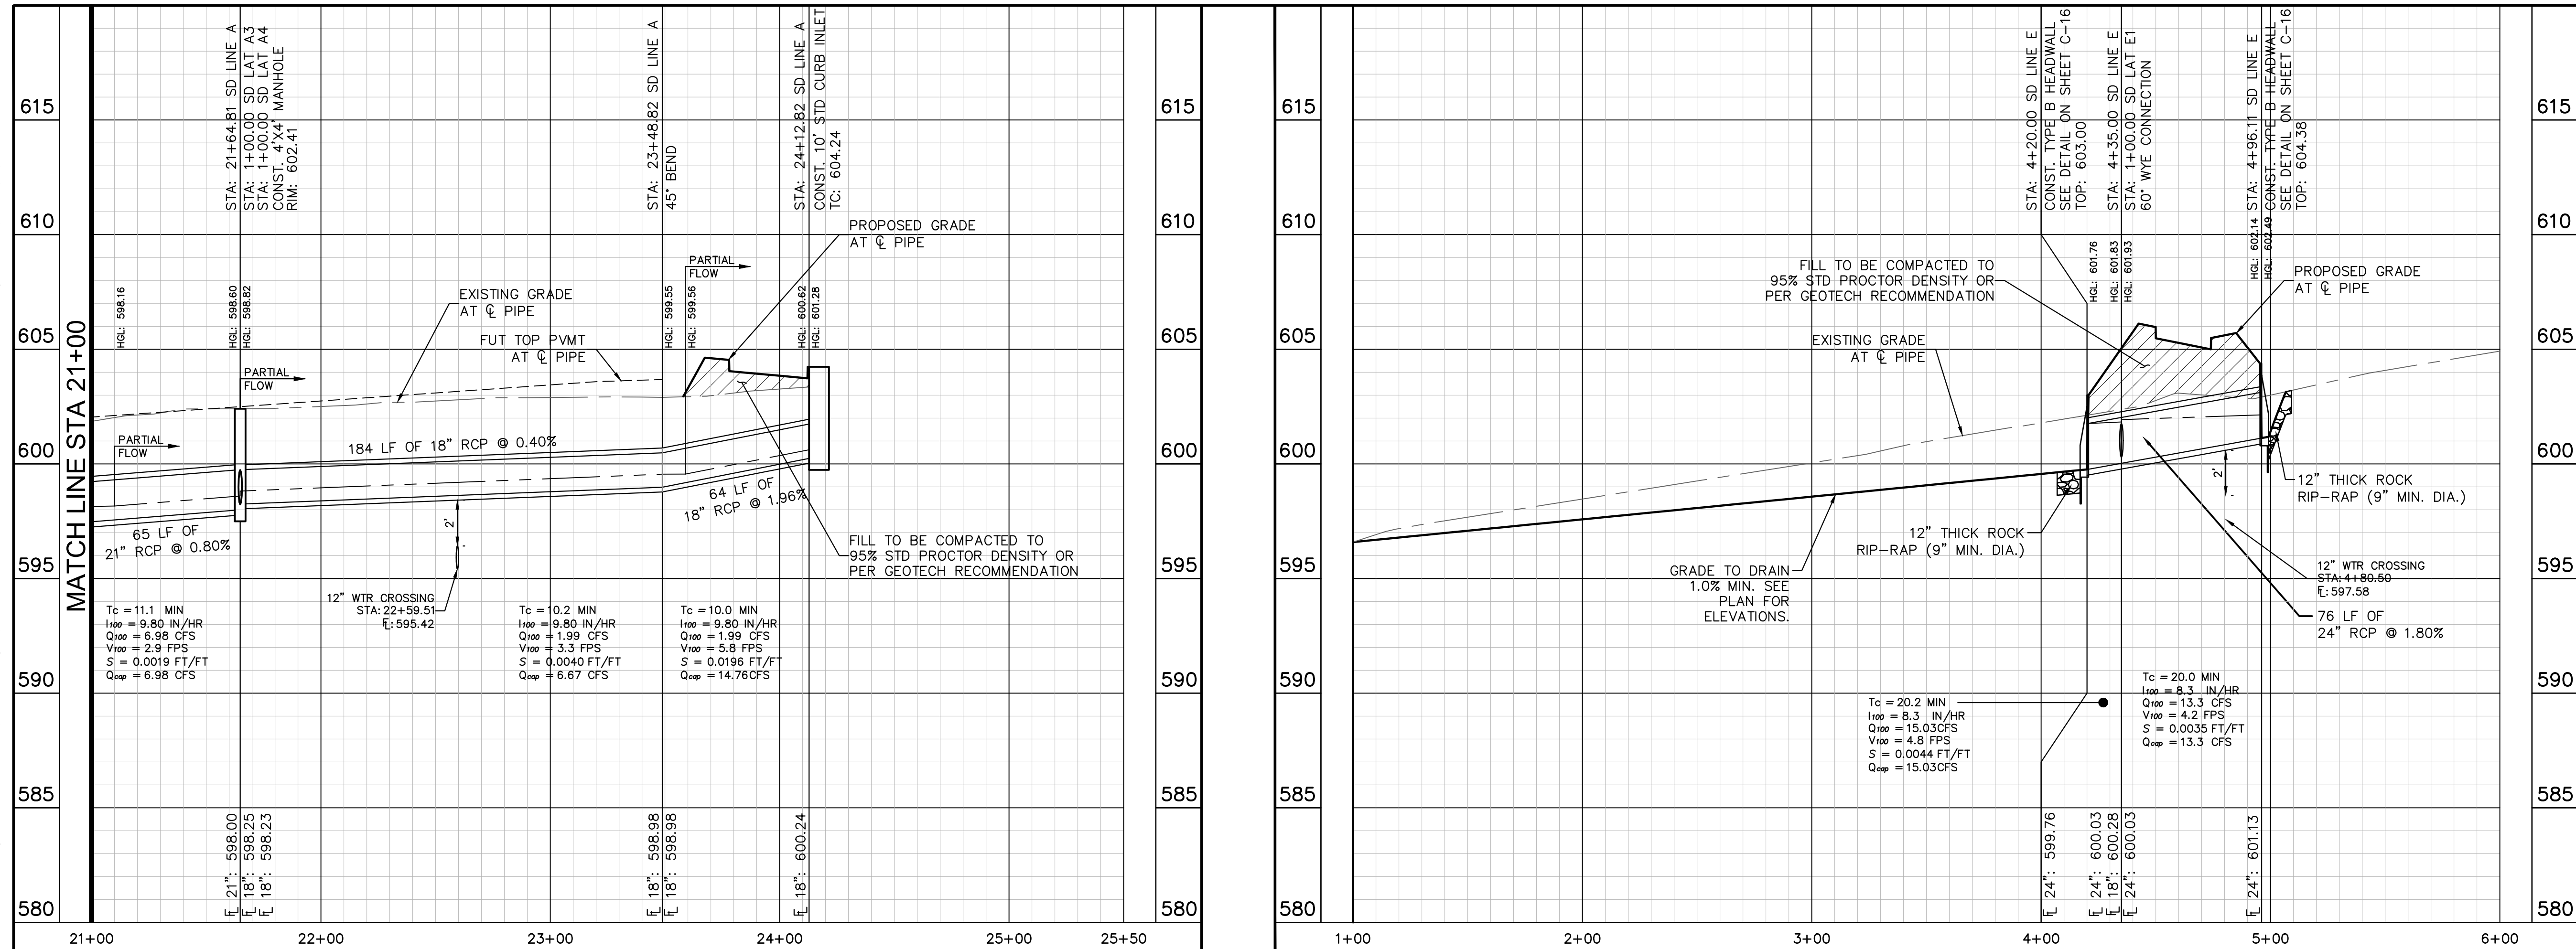SHEET NUMBER
C-13



PROFILE SCALE
1" = 40' HORIZONTAL
1" = 4' VERTICAL

BENCHMARKS

SQUARE CUT IN CENTER OF AN INLET LOCATED ON THE NORTH SIDE OF INTERSTATE HIGHWAY 30, APPROXIMATELY 53 FEET EAST OF THE SOUTHEAST CURB RETURN OF CONVEYORS ST AND HWY 30.

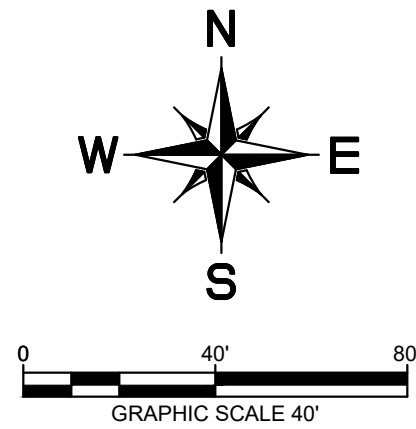
ELEVATION = 587.055 FEET

SQUARE CUT ON NORTHEAST SIDE OF WATER MANHOLE RIM, LOCATED ON THE WEST SIDE OF FM HIGHWAY 549, APPROXIMATELY 1246 FEET NORTH OF THE INTERSECTION OF FM 549 AND HWY 30.

ELEVATION = 610.402 FEET

Plotted By: Loeffel, Anthony Date: January 08, 2021 11:25:54am File Path: K:\DEL_OVA\063234203-Rockwall - Commercial Rwy\PlanSheets\0-Storm P&P.dwg

This document, together with the concepts and designs presented herein, is intended only for the specific purpose and client for which it was prepared. Reuse of and improper reliance on this document without written authorization and adaptation by Kimley-Horn and Associates, Inc. shall be without liability to Kimley-Horn and Associates, Inc.



!!WARNING!!

EXISTING WATER LINE IN THE AREA. CONTRACTOR SHALL FIELD VERIFY THE LOCATION OF ALL EXISTING UTILITIES WITH THE PROVIDER PRIOR TO START OF CONSTRUCTION AND SHALL IMMEDIATELY NOTIFY THE ENGINEER OF ANY CONFLICTS DISCOVERED. CONTRACTOR IS RESPONSIBLE FOR COORDINATING UTILITY RELOCATION WHERE NECESSARY AND PROTECTING EXISTING UTILITIES (SHOWN OR NOT SHOWN). IF ANY EXISTING UTILITIES ARE DAMAGED, THE CONTRACTOR SHALL REPLACE THEM AT THEIR OWN EXPENSE.

STA: 3+04.37 SD LINE B
STA: 1+00.00 SD LAT B1
PAV STA: 6+75.00 (19.01' RT)
CONVEYOR'S STREET
90" WYE CONNECTION

STA: 3+22.50 SD LINE B
PAV STA: 6+75.00 (37.13' RT)
CONVEYOR'S STREET
CONST. HEADWALL
PER TXDOT DETAIL FW-0
RIM: 585.54

STA: 1+92.00 SD LINE B
PAV STA: 6+75.00 (93.37' LT)
CONVEYOR'S STREET
CONST. HEADWALL
PER TXDOT DETAIL FW-0
RIM: 585.29

STA: 1+16.80 SD LAT B2
PAV STA: 6+57.93 (18.89' RT)
CONVEYOR'S STREET
STD CURB INLET
TC: 586.49
EL: 582.46

RECORD DRAWING

THIS DRAWING HAS BEEN REVISED TO SHOW THOSE CHANGES DURING THE CONSTRUCTION PROCESS REPORTED BY THE CONTRACTOR TO KIMLEY-HORN AND ASSOCIATES, INC. AND CONSIDERED TO BE SIGNIFICANT. THIS DRAWING IS NOT GUARANTEED TO BE "AS BUILT" BUT IS BASED ON THE INFORMATION MADE AVAILABLE.

DATE: 01/08/2021 BY: ANTHONY LOEFFEL, P.E.

Kimley»Horn

© 2021 KIMLEY-HORN AND ASSOCIATES, INC.
400 N. OKLAHOMA DRIVE, SUITE 05, CELINA, TX 75009
PHONE: 469-501-2200
WWW.KIMLEY-HORN.COM

TEXAS REGISTERED ENGINEERING FIRM F-928






KHA PROJECT	063234203
DATE	MARCH 2020
SCALE: AS SHOWN	
DESIGNED BY: AVL	DFW
DRAWN BY:	BLM
CHECKED BY:	

SD LINE B

SD LAT B2

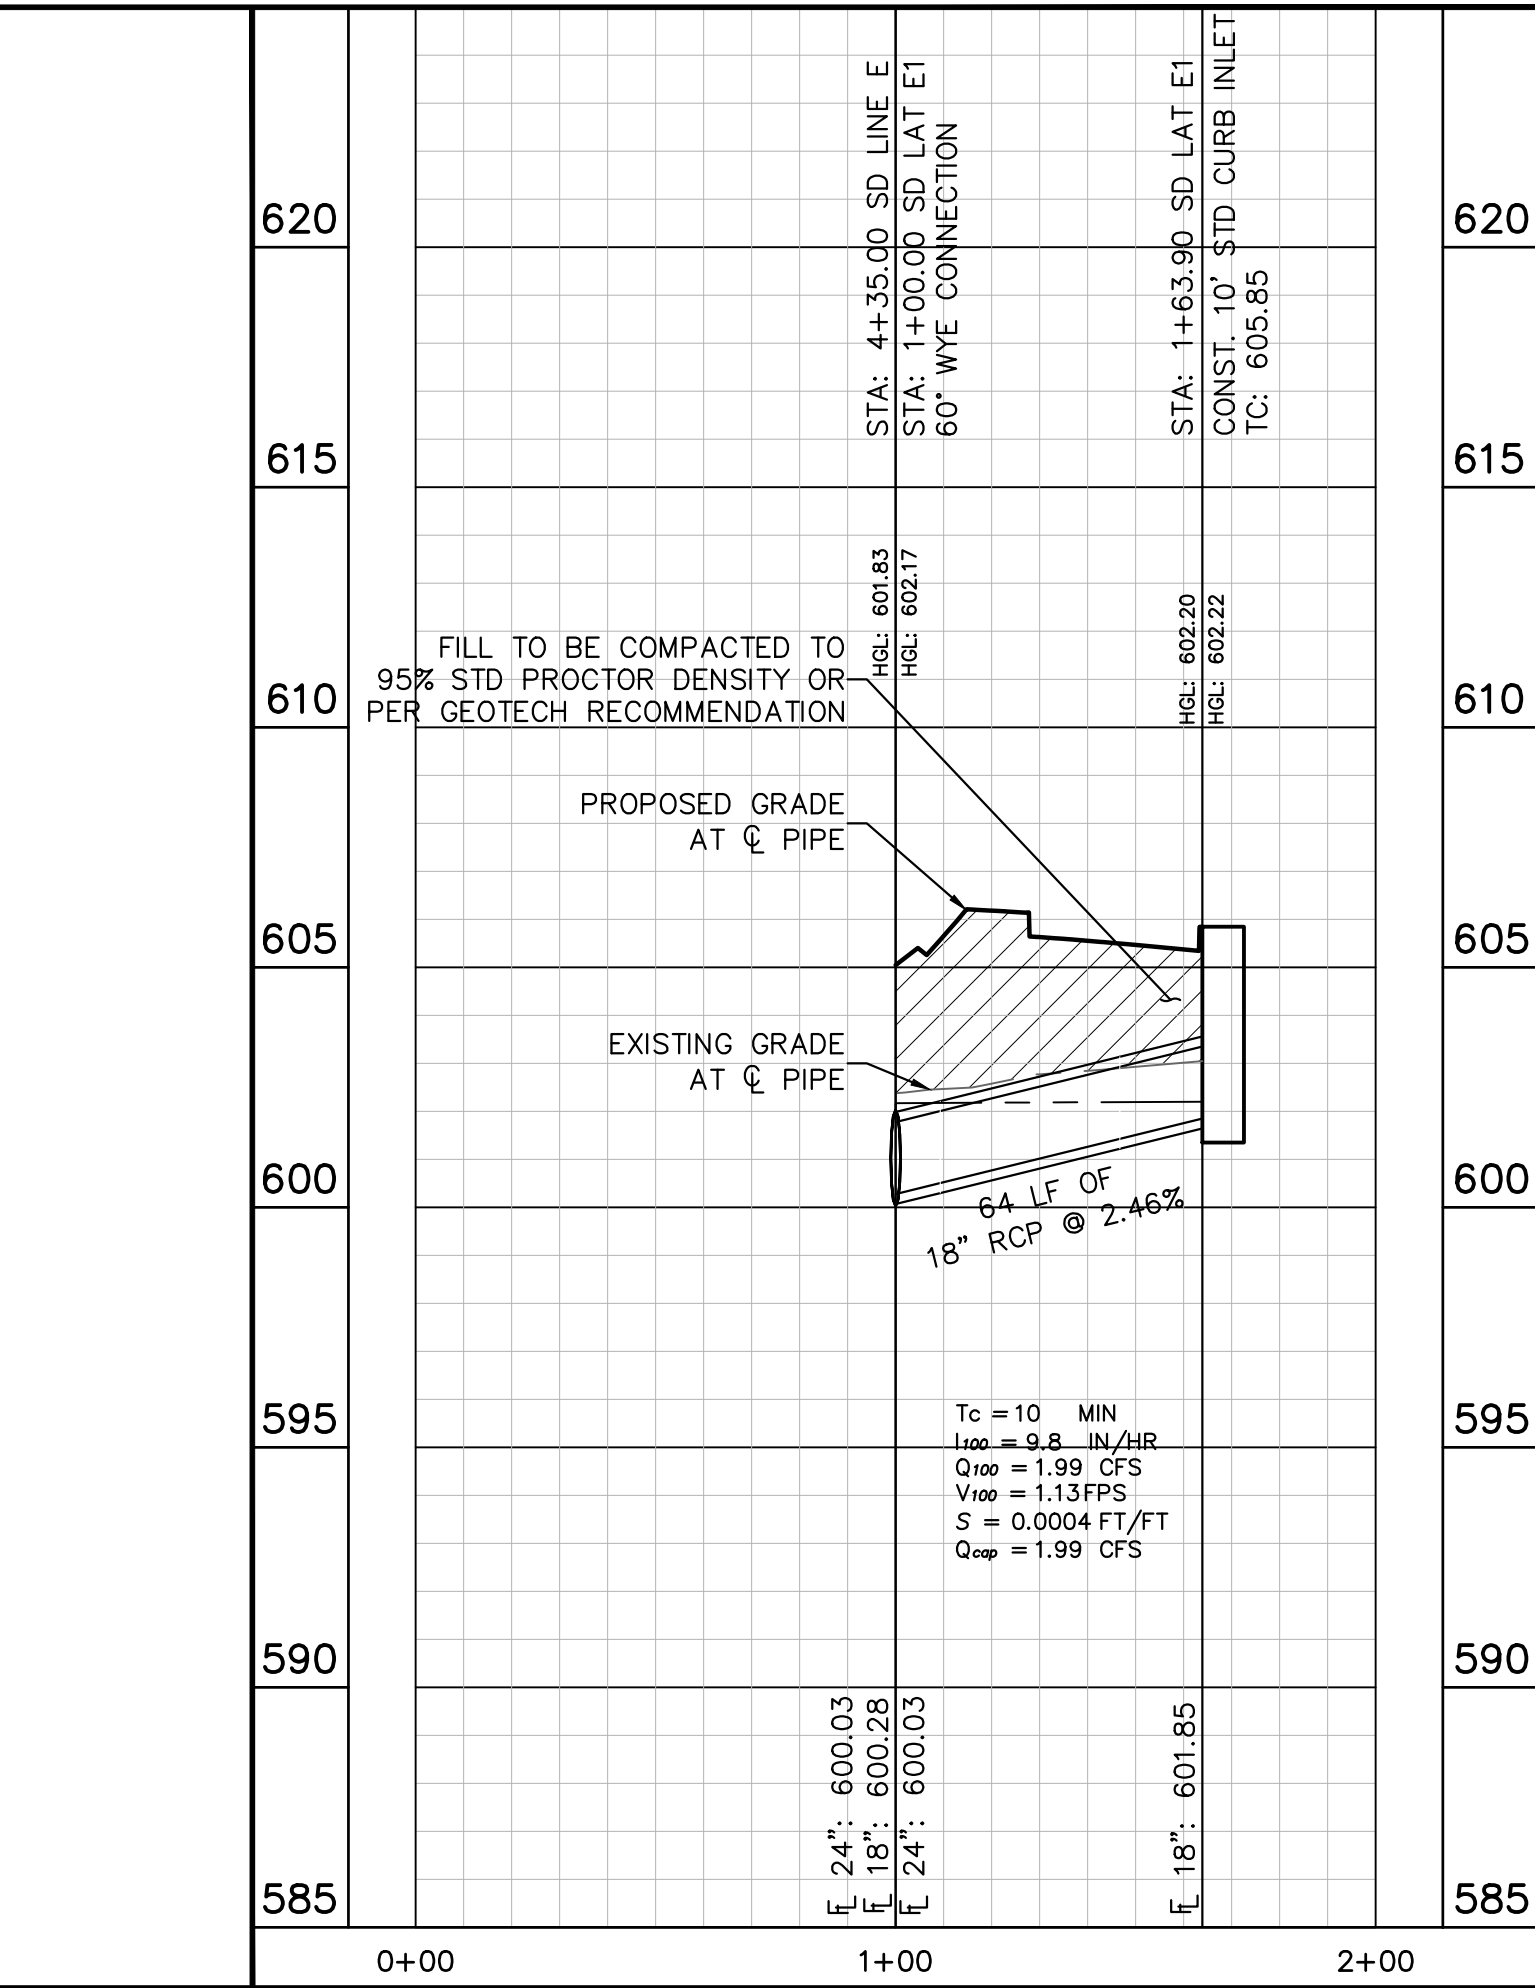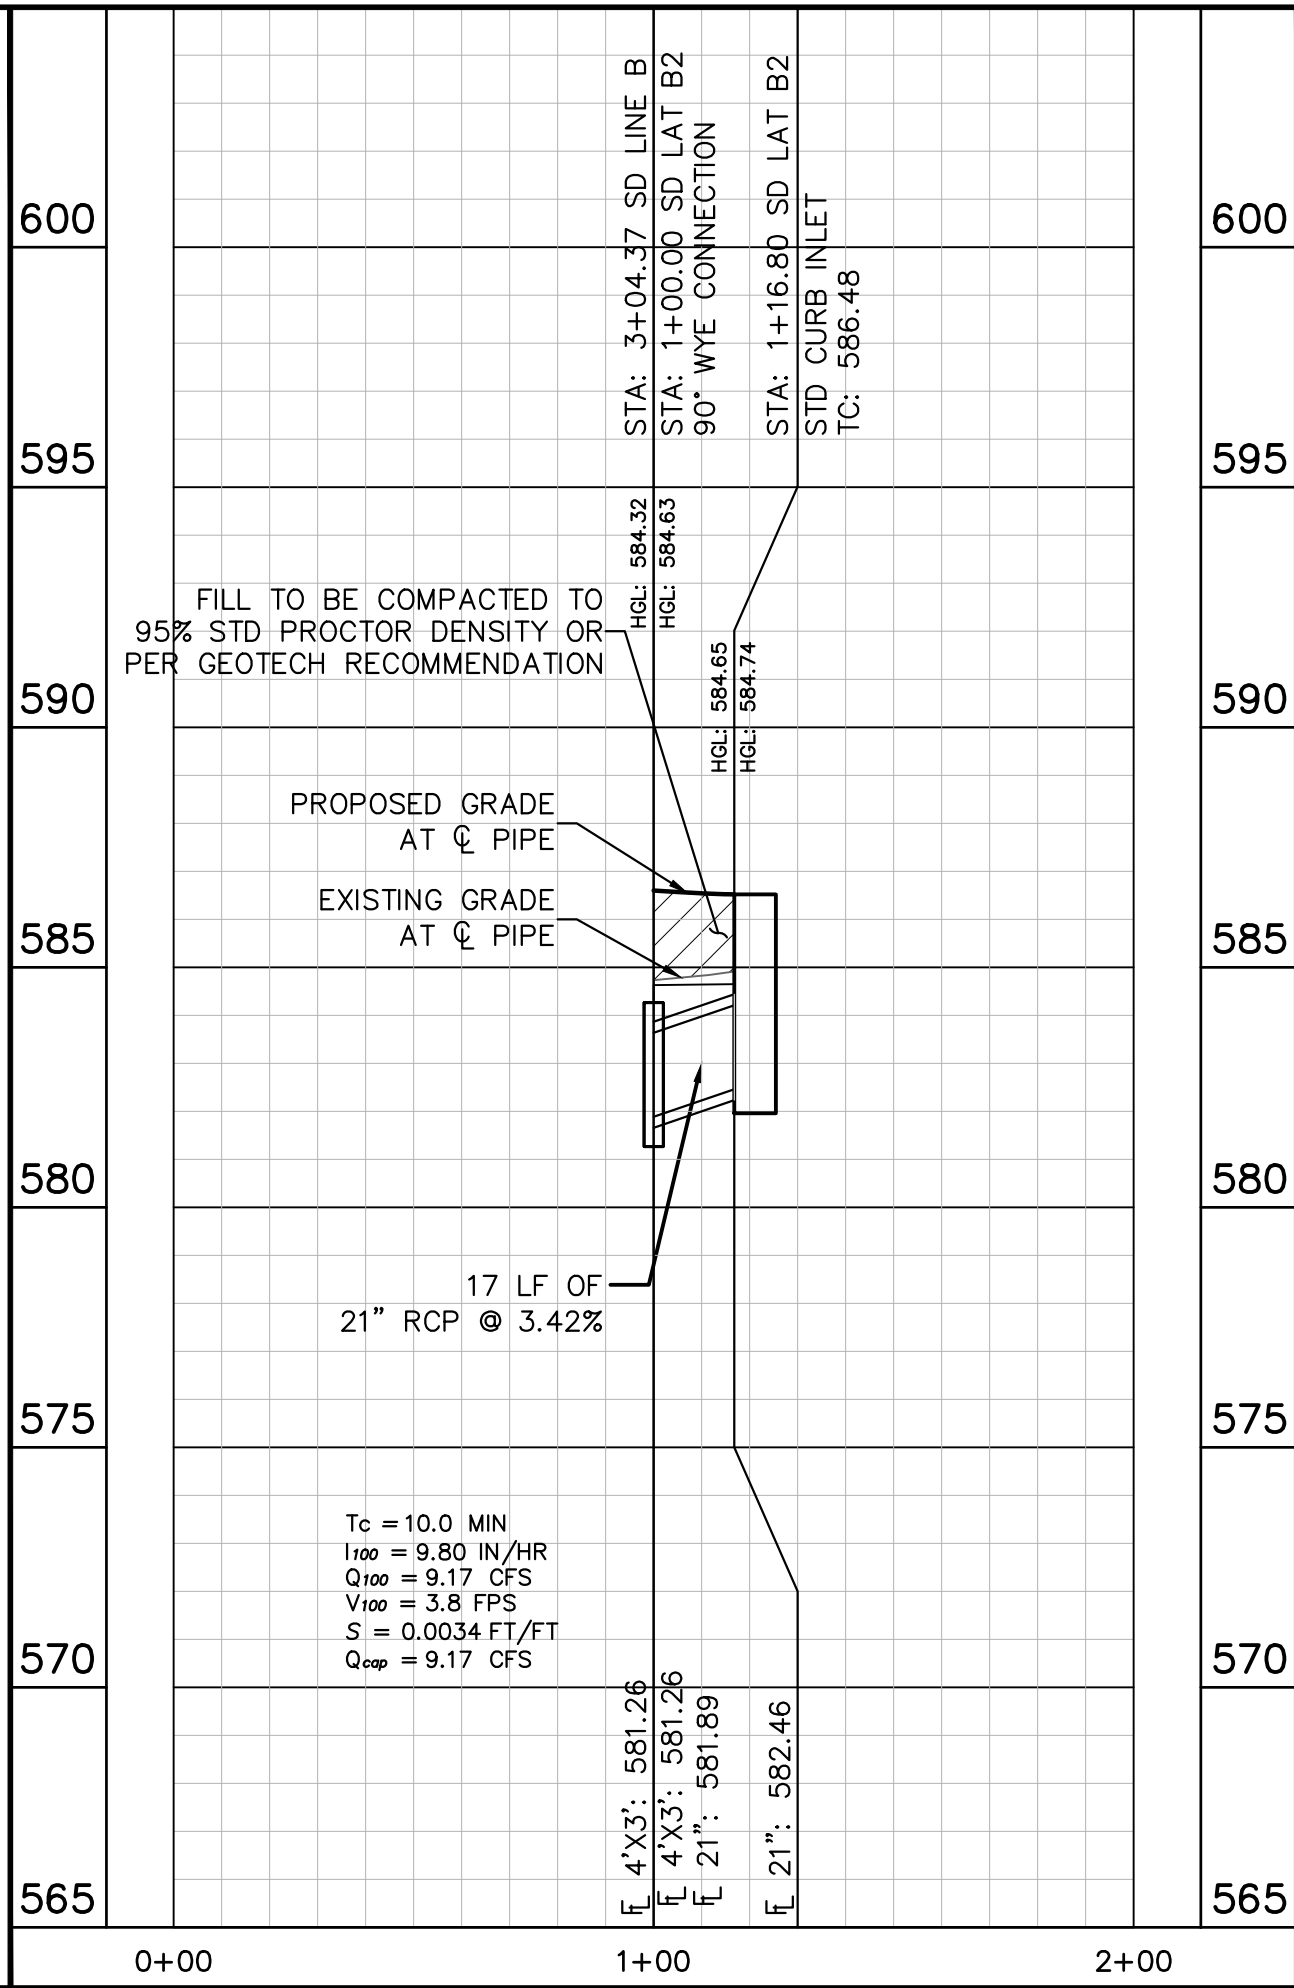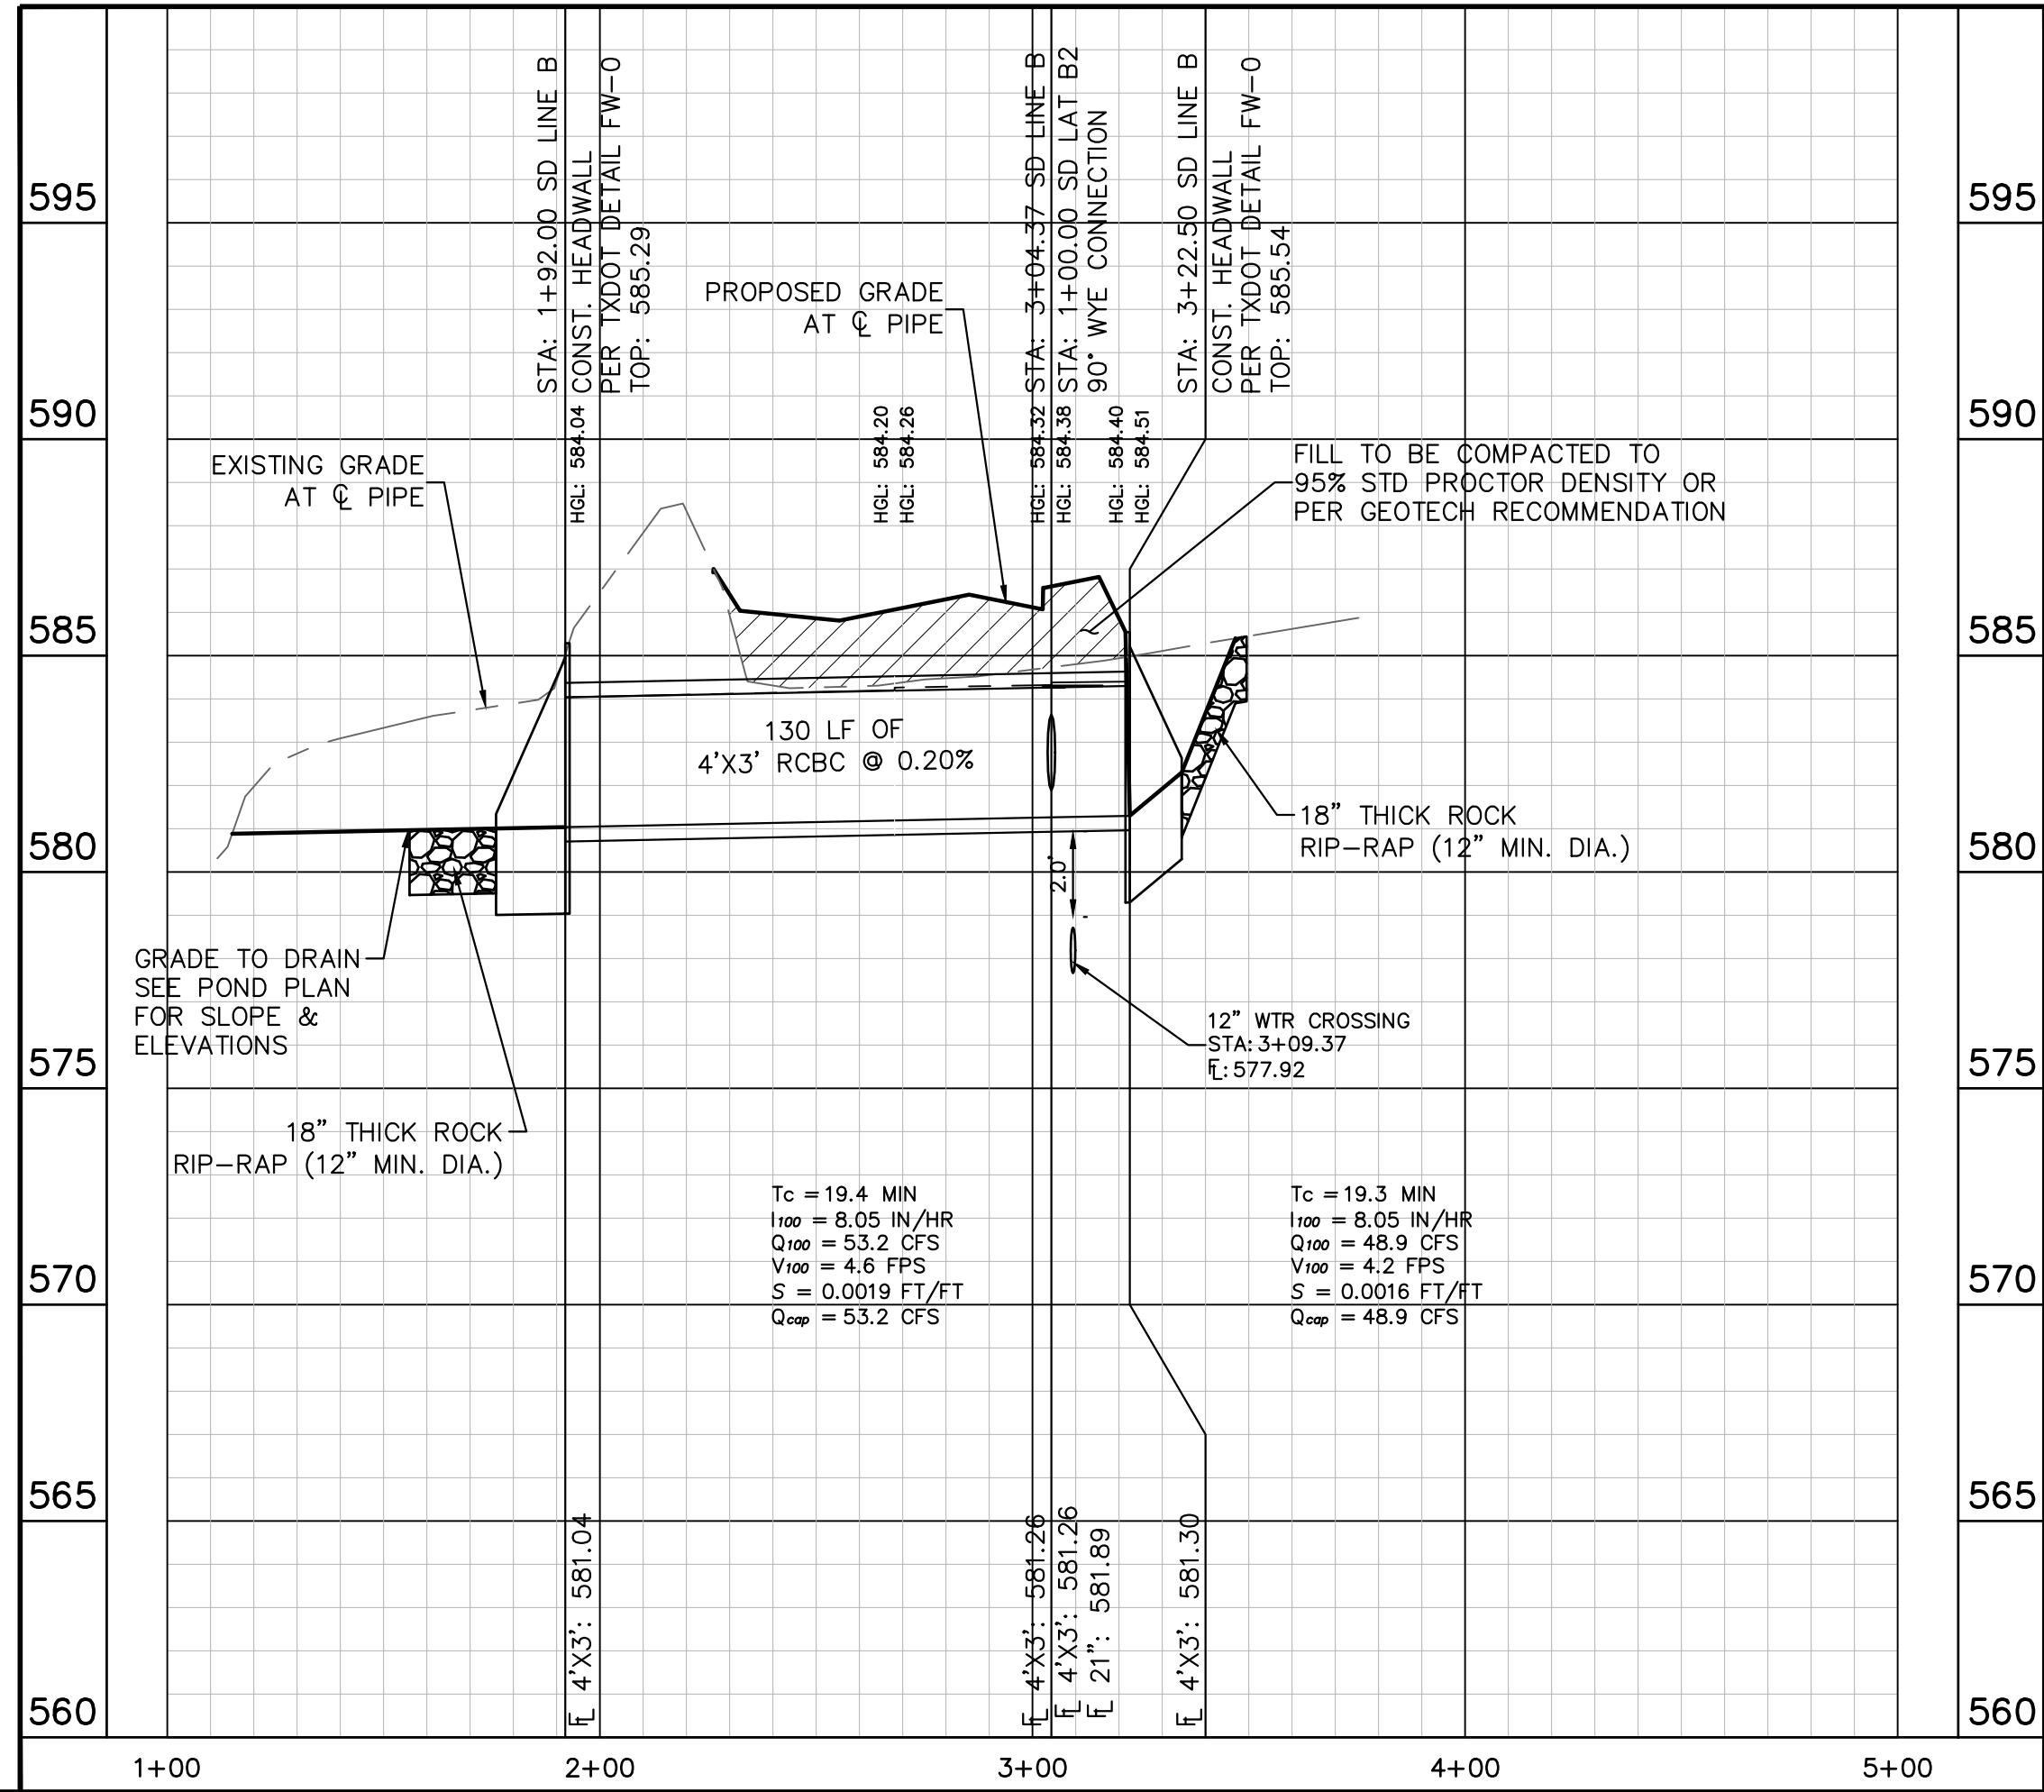SD LAT E1



PROFILE SCALE
1" = 40' HORIZONTAL
1" = 4' VERTICAL

BENCHMARKS

SQUARE CUT IN CENTER OF AN INLET LOCATED ON THE NORTH SIDE OF INTERSTATE HIGHWAY 30, APPROXIMATELY 53 FEET EAST OF THE SOUTHEAST CURB RETURN OF CONVEYORS ST AND HWY 30.
ELEVATION = 587.055 FEET
SQUARE CUT ON NORTHEAST SIDE OF WATER MANHOLE RIM, LOCATED ON THE WEST SIDE OF FM HIGHWAY 549, APPROXIMATELY 1246 FEET NORTH OF THE INTERSECTION OF FM 549 AND HWY 30.
ELEVATION = 610.402 FEET

STORM DRAIN PLAN & PROFILE - LINE SD-B

JUSTIN RD & CONVEYOR'S ST
EXTENSION
CITY OF ROCKWALL
ROCKWALL COUNTY, TEXAS


SHEET NUMBER
C-14

BY	
DATE	
REVISIONS	
No.	


Plotted By: Loeffel, Anthony Date: January 08, 2021 11:27:47am File Path: K:\DEL_Civil\063234203-Rockwall - Commercial Rwy\Drawings\Storm Profiles.dwg

This document, together with the concepts and designs presented herein, is intended only for the specific purpose and client for which it was prepared. Reuse of and improper reliance on this document without written authorization and adaptation by Kimley-Horn and Associates, Inc. shall be without liability to Kimley-Horn and Associates, Inc.

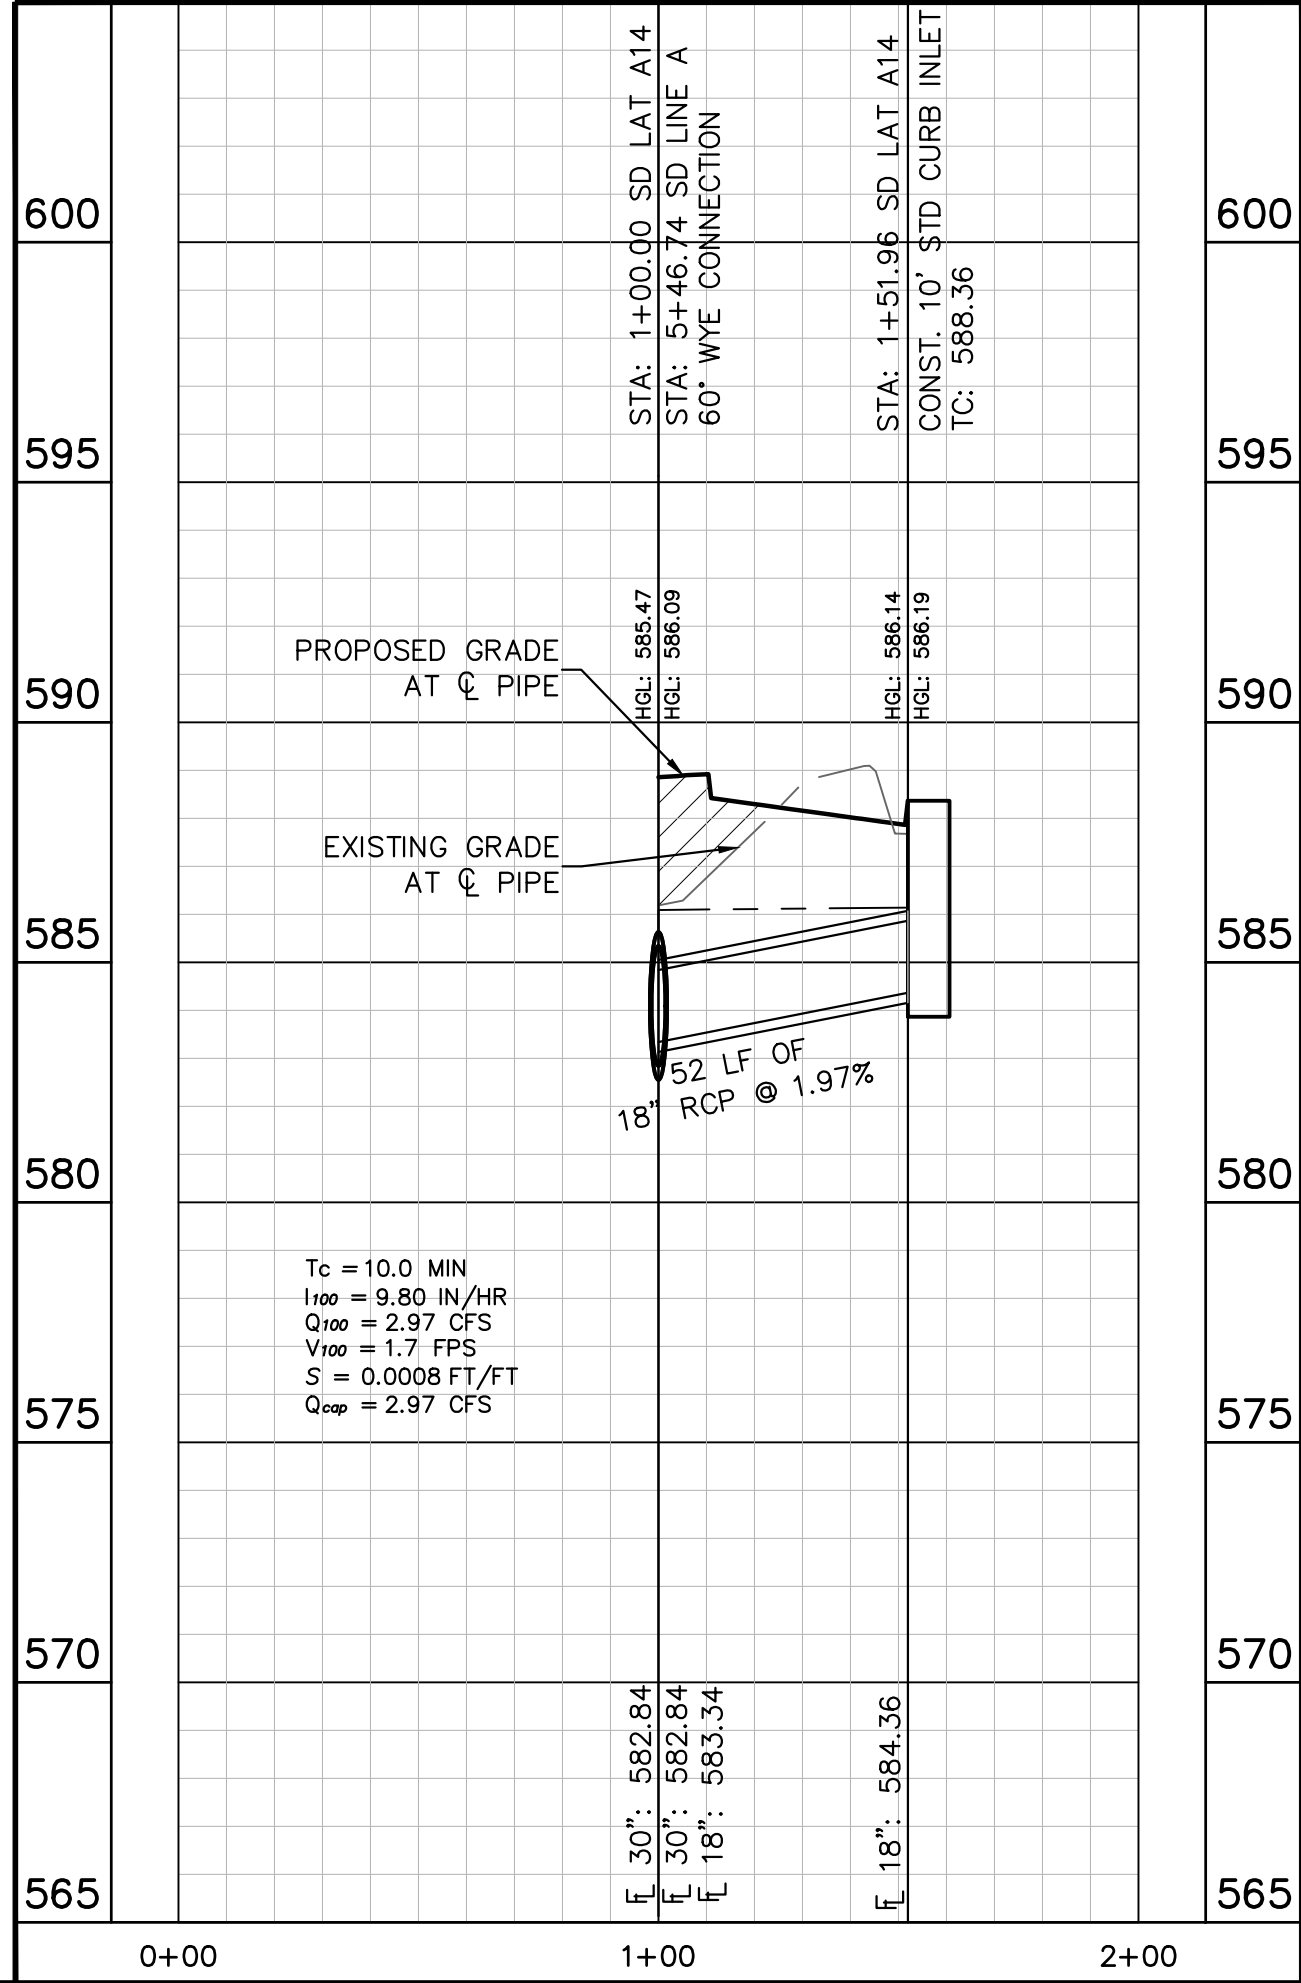
SD LAT A14



SD LAT A15 (FUTURE)

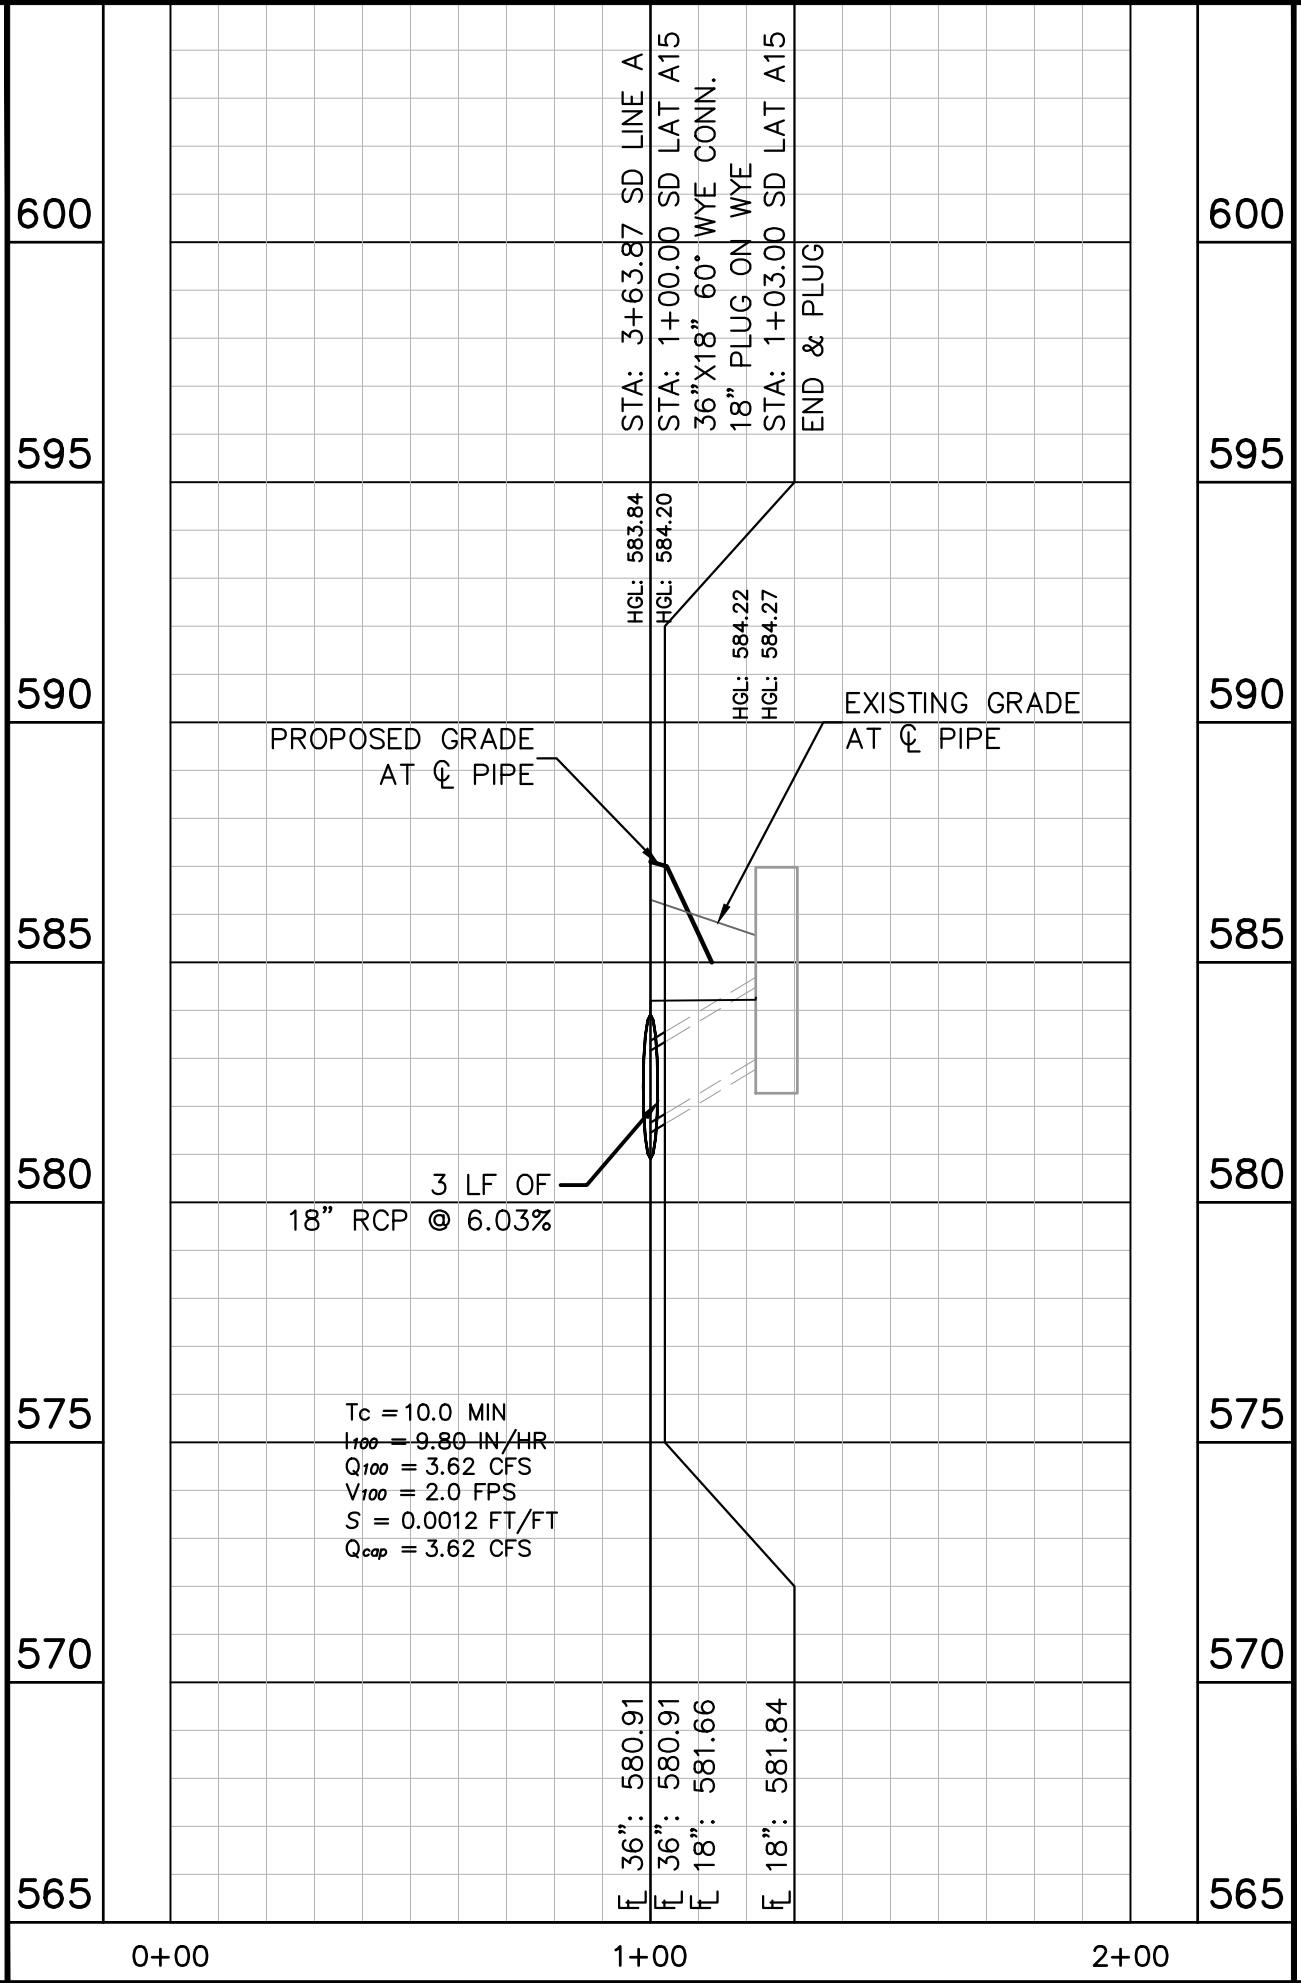

SD LAT A16

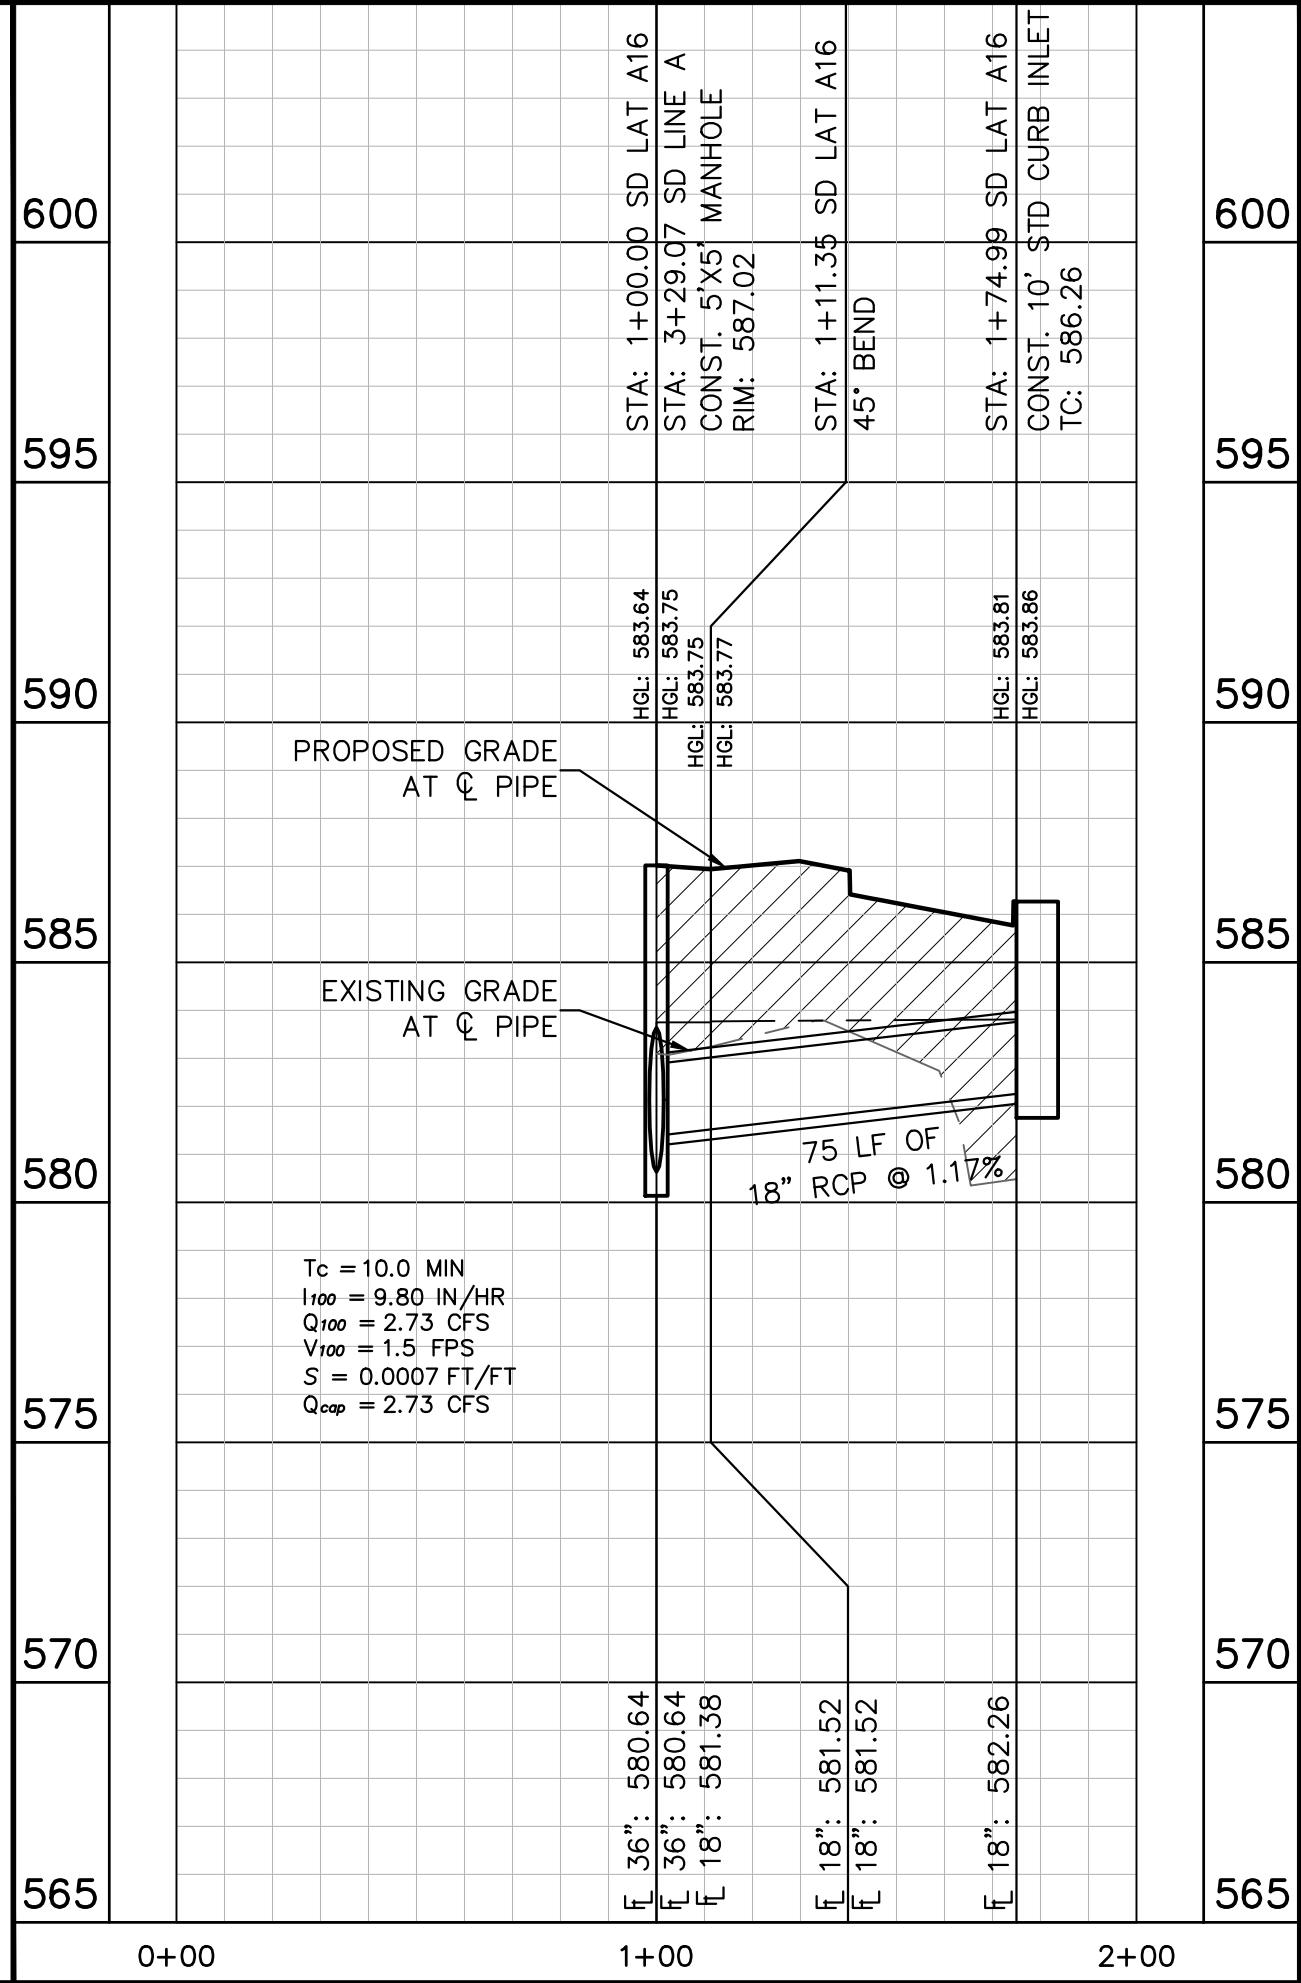

SPACE INTENTIONALLY LEFT BLANK

RECORD DRAWING

THIS DRAWING HAS BEEN REVISED TO SHOW THOSE CHANGES DURING THE CONSTRUCTION PROCESS REPORTED BY THE CONTRACTOR TO KIMLEY-HORN AND ASSOCIATES, INC. AND CONSIDERED TO BE SIGNIFICANT. THIS DRAWING IS NOT GUARANTEED TO BE "AS BUILT" BUT IS BASED ON THE INFORMATION MADE AVAILABLE.

DATE: 01/08/2021 BY: ANTHONY LOEFFEL, P.E.

BENCHMARKS

SQUARE CUT IN CENTER OF AN INLET LOCATED ON THE NORTH SIDE OF INTERSTATE HIGHWAY 30, APPROXIMATELY 53 FEET EAST OF THE SOUTHEAST CURB RETURN OF CONVEYORS ST AND HWY 30.

ELEVATION = 587.055 FEET

SQUARE CUT ON NORTHEAST SIDE OF WATER MANHOLE RIM, LOCATED ON THE WEST SIDE OF FM HIGHWAY 549, APPROXIMATELY 1246 FEET NORTH OF THE INTERSECTION OF FM 549 AND HWY 30.

ELEVATION = 610.402 FEET

**STORM PROFILES -
LATERALS**

**JUSTIN RD & CONVEYOR'S ST
EXTENSION**
CITY OF ROCKWALL
ROCKWALL COUNTY, TEXAS

SHEET NUMBER
C-16

KHA PROJECT
063234203

DATE
MARCH 2020

SCALE: AS SHOWN

DESIGNED BY: AVL

DRAWN BY: DFW

CHECKED BY: BLM

ANTHONY M. LOEFFEL
122029
LICENSED

1-8-21

Kimley»Horn

© 2021 KIMLEY-HORN AND ASSOCIATES, INC.
400 N. OKLAHOMA DRIVE, SUITE 05, CELINA, TX 75009
PHONE: 469-501-2200
WWW.KIMLEY-HORN.COM

TEXAS REGISTERED ENGINEERING FIRM F-928

Precast Drainage Structures

End Elevation

Side Elevation

Plan View

Basic Dimensions

Pipe Dia. (in.)	"A" (in.)	"B" (in.)	"C" (in.)	"D" (in.)	"E" (in.)	"F" (in.)	"G" (in.)	"H" (in.)	"I" (in.)	"J" (in.)	"K" (in.)	"L" (in.)	"M" (in.)	"N" (in.)	"O" (in.)	"P" (in.)	"Q" (in.)	"R" (in.)	"S" (in.)	"T" (in.)	"U" (in.)	"V" (in.)	"W" (in.)	"X" (in.)	"Y" (in.)	"Z" (in.)	Approx. Weight (lbs.)
12	12.00	6.00	12.00	17.00	30.00	48.875	35.00	24.00	2.100																		
15	12.00	6.00	12.00	20.50	30.00	48.875	35.00	24.00	2.100																		
18	12.00	6.00	12.00	24.00	30.00	48.875	35.00	24.00	2.100																		
21	12.00	6.00	12.00	27.50	38.00	69.750	42.00	36.00	3.400																		
24	12.00	6.00	12.00	31.00	38.00	69.750	42.00	36.00	3.400																		
27	12.00	6.00	12.00	35.00	42.00	90.000	49.00	48.00	4.900																		
30	12.00	6.00	12.00	38.50	42.00	90.000	49.00	48.00	4.900																		
33	12.00	6.00	12.00	42.00	60.00	111.500	56.00	60.00	6.700																		
36	12.00	6.00	12.00	45.50	60.00	111.500	56.00	60.00	6.700																		
42	9.00	9.00	18.00	52.50	63.00	153.000	70.00	84.00	14.500																		
48	9.00	9.00	18.00	59.50	63.00	153.000	70.00	84.00	14.500																		

Note:

- 1.) All exposed corners shall be chamfered 3/4".
- 2.) Minimum reinforcing shall be #4 @ 6" (grade 60) or the equivalent steel area provided in the form of welded wire fabric.
- 3.) Concrete for precast (steel formed) sections shall be a minimum of 4,200 psi (MIN 7.0 SACK/CY MIX).
- 4.) At the option and expense of the contractor, the next larger size of headwall may be furnished as long as the "D" dimension cast is that of the required size of pipe.

-No Scale-
All dimensions subject to allowable specification tolerances.

TITLE

PLANT

STATE

SECTION/PAGE

DATE

FORTERRA

Plotted By: Loeffel, Anthony Date: January 08, 2021 11:29:48am File Path: K:\DEL\Civil\063234203-Rockwall - Commercial Rwy\Cod\PlanSheets\C-Pond Plan.dwg

This document, together with the concepts and designs presented herein, as an instrument of service, is intended only for the specific purpose and client for which it was prepared. Reuse of and improper reliance on this document without written authorization and adaptation by Kimley-Horn and Associates, Inc. shall be without liability to Kimley-Horn and Associates, Inc.

DETENTION SYSTEM CALCULATIONS
MODIFIED RATIONAL METHOD
DESIGN FREQUENCY = 100 YEAR STORM

EXISTING CONDITIONS:				PASS THROUGH			
DRAINAGE AREAS	EX7			DRAINAGE AREAS	OS9		
DRAINAGE AREA (A)	9.13 AC			DRAINAGE AREA (A)	3.31 AC		
TIME OF CONC. (T _c)	25.0 MIN			TIME OF CONC. (T _c)	20.0 MIN		
RAINFALL INTENSITY (I)	7.60 IN/HR			RAINFALL INTENSITY (I)	8.30 IN/HR		
RUNOFF COEFFICIENT (C)	0.35			WEIGHTED COEFFICIENT (C)	0.35		
ALLOWABLE DISCHARGE	24.29 CFS			UNDETAINED RUNOFF	9.62 CFS		
PROPOSED ONSITE CONDITIONS:				PROPOSED BYPASS			
PROPOSED DETAINED				PROPOSED DETAINED			
DRAINAGE AREAS	A2-16,POND			DRAINAGE AREAS	OS10		
DRAINAGE AREA (A)	6.12 AC			DRAINAGE AREA (A)	4.92 AC		
TIME OF CONC. (T _c)	17.2 MIN			TIME OF CONC. (T _c)	23.7 MIN		
RAINFALL INTENSITY (I)	8.69 IN/HR			RAINFALL INTENSITY (I)	7.78 IN/HR		
WEIGHTED COEFFICIENT (C)	0.76			WEIGHTED COEFFICIENT (C)	0.35		
UNDETAINED RUNOFF	40.42 CFS			UNDETAINED RUNOFF	13.40 CFS		
ALLOWABLE DISCHARGE	10.9 CFS						
ACTUAL DISCHARGE	10.4 CFS						

TIME (MIN)	TIME (HRS)	I ₁₀₀ (IN/HR)	INFLOW RATE (CFS)	INFLOW VOLUME (FT ³)	OUTFLOW RATE (CFS)	OUTFLOW VOLUME (FT ³)	STORAGE (FT ³)
10	0.17	9.80	56.92	34,154	10.89	8,482	25,672
15	0.25	9.00	52.28	47,049	10.89	10,041	37,008
20	0.33	8.30	48.21	57,853	10.89	11,500	46,353
30	0.50	6.90	40.08	72,142	10.89	14,718	57,424
40	0.67	5.80	33.69	80,854	10.89	17,836	63,018
50	0.83	5.00	29.04	87,128	10.89	20,954	66,173
60	1.00	4.50	26.14	94,098	10.89	24,073	70,025
70	1.17	4.00	23.23	97,583	10.89	27,191	70,392
80	1.33	3.70	21.49	103,159	10.89	30,309	72,850
90	1.50	3.50	20.33	109,781	10.89	33,427	76,354
100	1.67	3.40	19.75	118,493	10.89	36,545	81,948
110	1.83	3.20	18.59	122,676	10.89	39,664	83,012
120	2.00	2.80	16.26	117,099	10.89	42,782	74,318
140	2.33	2.64	15.36	129,026	10.89	49,018	80,308
160	2.67	2.49	14.46	138,784	10.89	55,255	83,530
180	3.00	2.33	13.55	146,374	10.89	61,491	84,883
200	3.33	2.18	12.65	151,795	10.89	67,727	84,068
220	3.67	2.02	11.75	155,048	10.89	73,964	81,085
240	4.00	1.87	10.84	156,132	10.89	80,200	75,932
260	4.33	1.71	9.94	155,048	10.89	86,437	68,512
280	4.67	1.56	9.04	151,795	10.89	92,673	58,123
300	5.00	1.40	8.13	146,374	10.89	98,909	47,465

<== CONTROLS 1.95 AC-FT

DETENTION SYSTEM CALCULATIONS
MODIFIED RATIONAL METHOD
DESIGN FREQUENCY = 10 YEAR STORM

EXISTING CONDITIONS:				PASS THROUGH			
DRAINAGE AREAS	EX7			DRAINAGE AREAS	OS9		
DRAINAGE AREA (A)	9.13 AC			DRAINAGE AREA (A)	3.31 AC		
TIME OF CONC. (T _c)	25.0 MIN			TIME OF CONC. (T _c)	20.0 MIN		
RAINFALL INTENSITY (I)	5.35 IN/HR			RAINFALL INTENSITY (I)	5.90 IN/HR		
RUNOFF COEFFICIENT (C)	0.35			WEIGHTED COEFFICIENT (C)	0.35		
ALLOWABLE DISCHARGE	17.10 CFS			UNDETAINED RUNOFF	6.84 CFS		
PROPOSED ONSITE CONDITIONS:				PROPOSED BYPASS			
PROPOSED DETAINED				PROPOSED DETAINED			
DRAINAGE AREAS	A2-16,POND			DRAINAGE AREAS	OS10		
DRAINAGE AREA (A)	6.12 AC			DRAINAGE AREA (A)	4.92 AC		
TIME OF CONC. (T _c)	17.2 MIN			TIME OF CONC. (T _c)	23.7 MIN		
RAINFALL INTENSITY (I)	6.24 IN/HR			RAINFALL INTENSITY (I)	5.49 IN/HR		
WEIGHTED COEFFICIENT (C)	0.76			WEIGHTED COEFFICIENT (C)	0.35		
UNDETAINED RUNOFF	29.00 CFS			UNDETAINED RUNOFF	9.46 CFS		
ALLOWABLE DISCHARGE	7.6 CFS						
ACTUAL DISCHARGE	7.6 CFS						

TIME (MIN)	TIME (HRS)	I ₁₀ (IN/HR)	INFLOW RATE (CFS)	INFLOW VOLUME (FT ³)	OUTFLOW RATE (CFS)	OUTFLOW VOLUME (FT ³)	STORAGE (FT ³)
10	0.17	7.10	41.24	24,744	7.64	6,173	18,571
15	0.25	6.50	37.76	33,980	7.64	7,308	26,672
20	0.33	5.90	34.27	41,124	7.64	8,443	32,682
30	0.50	4.80	27.88	50,185	7.64	10,712	39,473
40	0.67	4.00	23.23	55,762	7.64	12,982	42,780
50	0.83	3.50	20.33	60,989	7.64	15,251	45,738
60	1.00	3.00	17.43	62,732	7.64	17,521	45,211
70	1.17	2.80	16.26	68,308	7.64	19,790	48,518
80	1.33	2.60	15.10	72,490	7.64	22,060	50,431
90	1.50	2.50	14.52	78,415	7.64	24,329	54,086
100	1.67	2.40	13.94	83,642	7.64	26,599	57,044
110	1.83	2.30	13.36	88,173	7.64	28,868	59,305
120	2.00	1.80	10.46	75,278	7.64	31,138	44,141
140	2.33	1.70	9.87	82,945	7.64	35,677	47,269
160	2.67	1.60	9.29	89,219	7.64	40,216	49,003
180	3.00	1.50	8.71	94,098	7.64	44,755	49,343
200	3.33	1.40	8.13	97,583	7.64	49,294	48,289
220	3.67	1.30	7.55	99,674	7.64	53,833	45,841
240	4.00	1.20	6.97	100,371	7.64	58,372	41,999
260	4.33	1.10	6.39	99,674	7.64	62,911	36,763
280	4.67	1.00	5.81	97,583	7.64	67,450	30,133
300	5.00	0.90	5.23	94,098	7.64	71,989	22,109

<== CONTROLS 1.36 AC-FT

DETENTION SYSTEM CALCULATIONS
MODIFIED RATIONAL METHOD
DESIGN FREQUENCY = 50 YEAR STORM

EXISTING CONDITIONS:				PASS THROUGH			
DRAINAGE AREAS	EX7			DRAINAGE AREAS	OS9		
DRAINAGE AREA (A)	9.13 AC			DRAINAGE AREA (A)	3.31 AC		
TIME OF CONC. (T _c)	25.0 MIN			TIME OF CONC. (T _c)	20.0 MIN		
RAINFALL INTENSITY (I)	6.80 IN/HR			RAINFALL INTENSITY (I)	7.50 IN/HR		
RUNOFF COEFFICIENT (C)	0.35			WEIGHTED COEFFICIENT (C)	0.35		
ALLOWABLE DISCHARGE	21.73 CFS			UNDETAINED RUNOFF	8.69 CFS		
PROPOSED ONSITE CONDITIONS:				PROPOSED BYPASS			
PROPOSED DETAINED				PROPOSED DETAINED			
DRAINAGE AREAS	A2-16,POND			DRAINAGE AREAS	OS10		
DRAINAGE AREA (A)	6.12 AC			DRAINAGE AREA (A)	4.92 AC		
TIME OF CONC. (T _c)	17.2 MIN			TIME OF CONC. (T _c)	23.7 MIN		
RAINFALL INTENSITY (I)	7.84 IN/HR			RAINFALL INTENSITY (I)	6.98 IN/HR		
WEIGHTED COEFFICIENT (C)	0.76			WEIGHTED COEFFICIENT (C)	0.35		
UNDETAINED RUNOFF	36.44 CFS			UNDETAINED RUNOFF	12.02 CFS		
ALLOWABLE DISCHARGE	9.7 CFS						
ACTUAL DISCHARGE	8.8 CFS						



TIME (MIN)	TIME (HRS)	I ₅₀ (IN/HR)	INFLOW RATE (CFS)	INFLOW VOLUME (FT ³)	OUTFLOW RATE (CFS)	OUTFLOW VOLUME (FT ³)	STORAGE (FT ³)
10	0.17	9.00	52.28	31,366	9.71	7,209	24,157
15	0.25	8.10	47.05	42,344	9.71	8,535	33,809
20	0.33	7.50	43.56	52,277	9.71	9,860	42,417
30	0.50	6.10	35.43	63,777	9.71	12,510	51,267
40	0.67	5.20	30.20	72,490	9.71	15,161	57,329
50	0.83	4.50	26.14	78,415	9.71	17,811	60,603
60	1.00	3.90	22.65	81,551	9.71	20,462	61,089
70	1.17	3.70	21.49	90,264	9.71	23,112	67,152
80	1.33	3.50	20.33	97,583	9.71	25,763	71,820
90	1.50	3.30	19.17	103,507	9.71	28,413	75,094
100	1.67	3.00	17.43	104,553	9.71	31,064	73,489
110	1.83	2.90	16.84	111,175	9.71	33,714	77,460
120	2.00	2.45	14.23	102,462	9.71	36,365	66,097
140	2.33	2.32	13.49	113,304	9.71	41,666	71,639
160	2.67	2.19	12.75	122,366	9.71	46,967	75,399
180	3.00	2.07	12.00	129,646	9.71	52,268	77,378
200	3.33	1.94	11.26	135,144	9.71	57,569	77,460
220	3.67	1.81	10.52	138,862	9.71	62,870	75,992
240	4.00	1.68	9.78	140,798	9.71	68,171	72,627
260	4.33	1.56	9.04	140,953	9.71	73,472	67,481
280	4.67	1.43	8.29	139,327	9.71	78,773	60,554
300	5.00	1.30	7.55	135,919	9.71	84,074	51,845

<== CONTROLS 1.78 AC-FT

DETENTION SYSTEM CALCULATIONS
MODIFIED RATIONAL METHOD
DESIGN FREQUENCY = 25 YEAR STORM

EXISTING CONDITIONS:				PASS THROUGH			
DRAINAGE AREAS	EX7			DRAINAGE AREAS	OS9		
DRAINAGE AREA (A)	9.13 AC			DRAINAGE AREA (A)	3.31 AC		
TIME OF CONC. (T _c)	25.0 MIN			TIME OF CONC. (T _c)	20.0 MIN		
RAINFALL INTENSITY (I)	6.05 IN/HR			RAINFALL INTENSITY (I)	7.50 IN/HR		
RUNOFF COEFFICIENT (C)	0.35			WEIGHTED COEFFICIENT (C)	0.35		
ALLOWABLE DISCHARGE	19.33 CFS			UNDETAINED RUNOFF	7.65 CFS		
PROPOSED ONSITE CONDITIONS:				PROPOSED BYPASS			
PROPOSED DETAINED				PROPOSED DETAINED			
DRAINAGE AREAS	A2-16,POND			DRAINAGE AREAS	OS10		
DRAINAGE AREA (A)	6.12 AC			DRAINAGE AREA (A)	4.92 AC		
TIME OF CONC. (T _c)	17.2 MIN			TIME OF CONC. (T _c)	23.7 MIN		
RAINFALL INTENSITY (I)	7.10 IN/HR			RAINFALL INTENSITY (I)	6.19 IN/HR		
WEIGHTED COEFFICIENT (C)	0.76			WEIGHTED COEFFICIENT (C)	0.35		
UNDETAINED RUNOFF	33.03 CFS			UNDETAINED RUNOFF	10.88 CFS		
ALLOWABLE DISCHARGE	8.7 CFS						
ACTUAL DISCHARGE	8.0 CFS						

TIME (MIN)	TIME (HRS)	I ₂₅ (IN/HR)	INFLOW RATE (CFS)	INFLOW VOLUME (FT ³)	OUTFLOW RATE (CFS)	OUTFLOW VOLUME (FT ³)	STORAGE (FT ³)
10	0.17	8.30	48.21	28,926	8.67	6,520	22,406
15	0.25	7.50	43.56	39,207	8.67	7,718	31,489
20	0.33	6.60	38.94	46,003	8.67	8,917	37,086
30	0.50	5.50	31.95	57,504	8.67	11,314	46,190
40	0.67	4.60	26.72	64,126	8.67	13,711	50,415
50	0.83	4.00	23.23	69,702	8.67	16,108	53,594
60	1.00	3.50	20.33	73,187	8.67	18,505	54,682
70	1.17	3.30	19.17	80,506	8.67	20,902	59,604
80	1.33	3.10	18.01	86,430	8.67	23,299	63,132
90	1.50	2.90	16.84	90,961	8.67	25,696	65,265
100	1.67	2.70	15.68	94,098	8.67	28,093	66,005
110	1.83	2.50	14.52	95,840	8.67	30,490	65,302
120	2.00	2.10	12.20	87,825	8.67	32,887	54,938
140	2.33	2.00	11.62	97,583	8.67	37,681	59,902
160	2.67	1.90	11.04	105,947	8.67	42,475	63,472
180	3.00	1.70	10.26	112,917	8.67	47,269	65,648
200	3.33	1.70	9.87	118,493	8.67	52,063	66,431
220	3.67	1.60	9.28	122,676	8.67	56,857	65,819
240	4.00	1.50	8.71	125,464	8.67	61,651	63,813
260	4.33	1.40	8.13	126,858	8.67	66,445	60,413
280	4.67	1.30	7.55	126,858	8.67	71,239	55,619
300	5.00	1.20	6.97	125,464	8.67	76,033	49,431

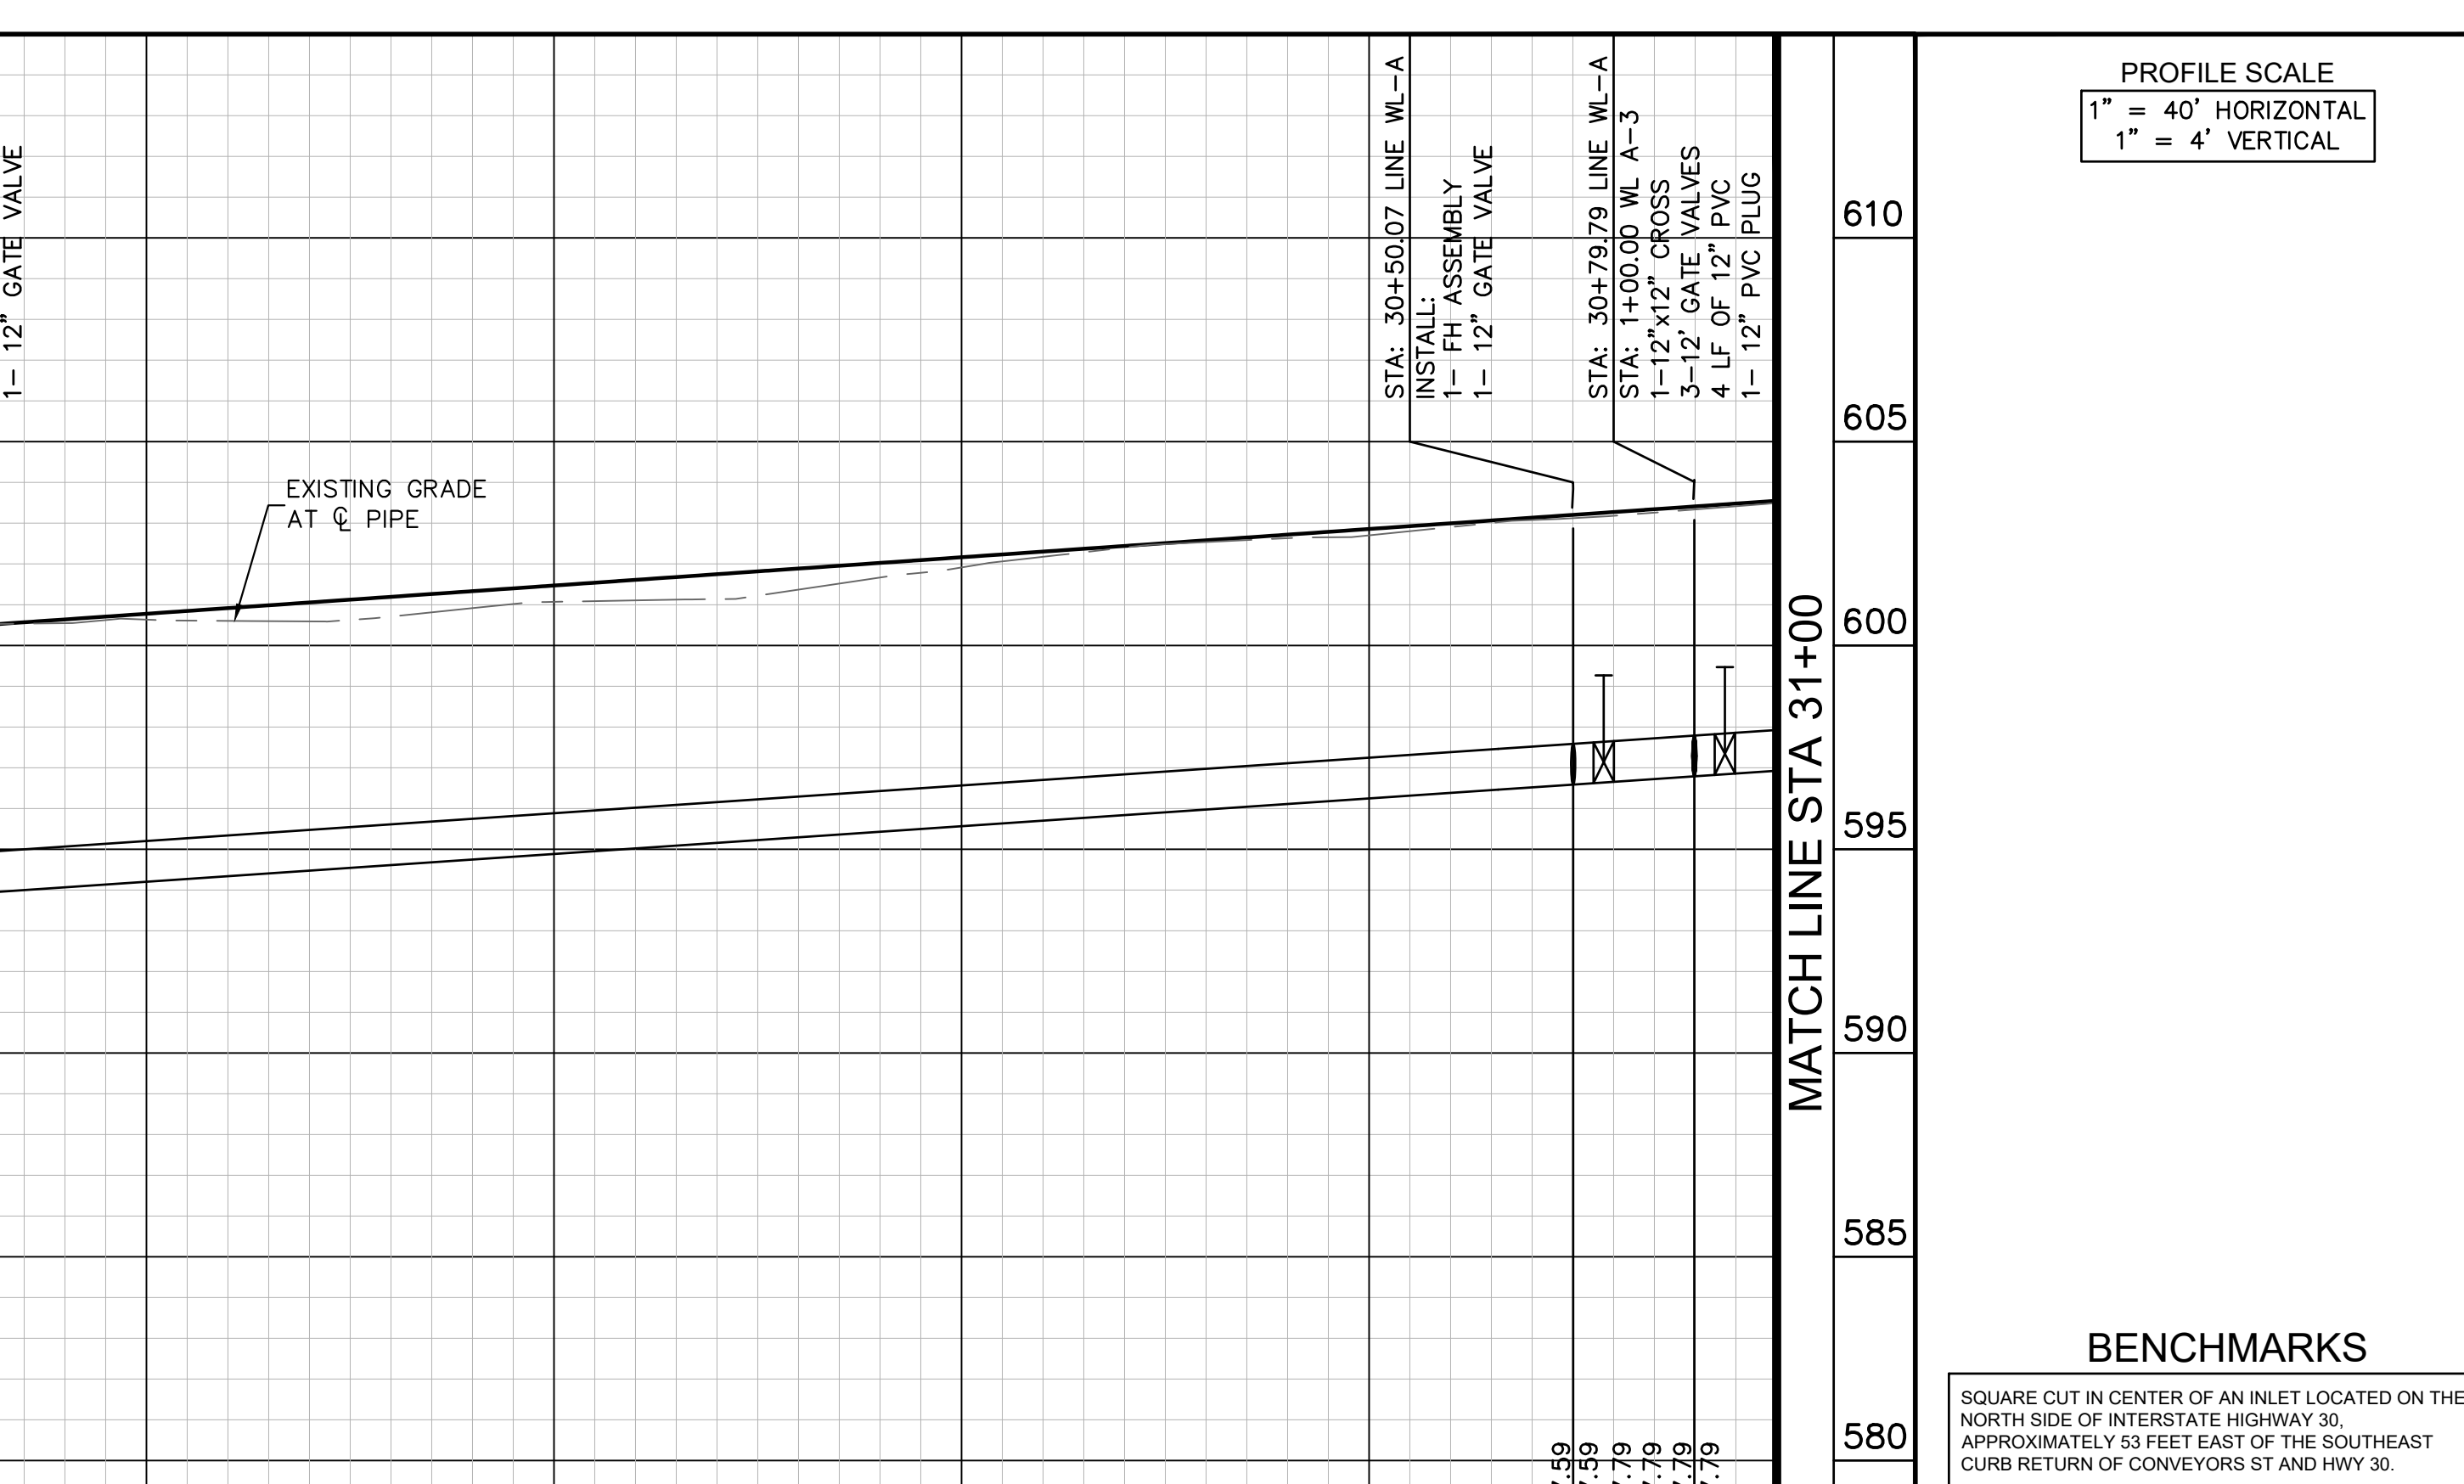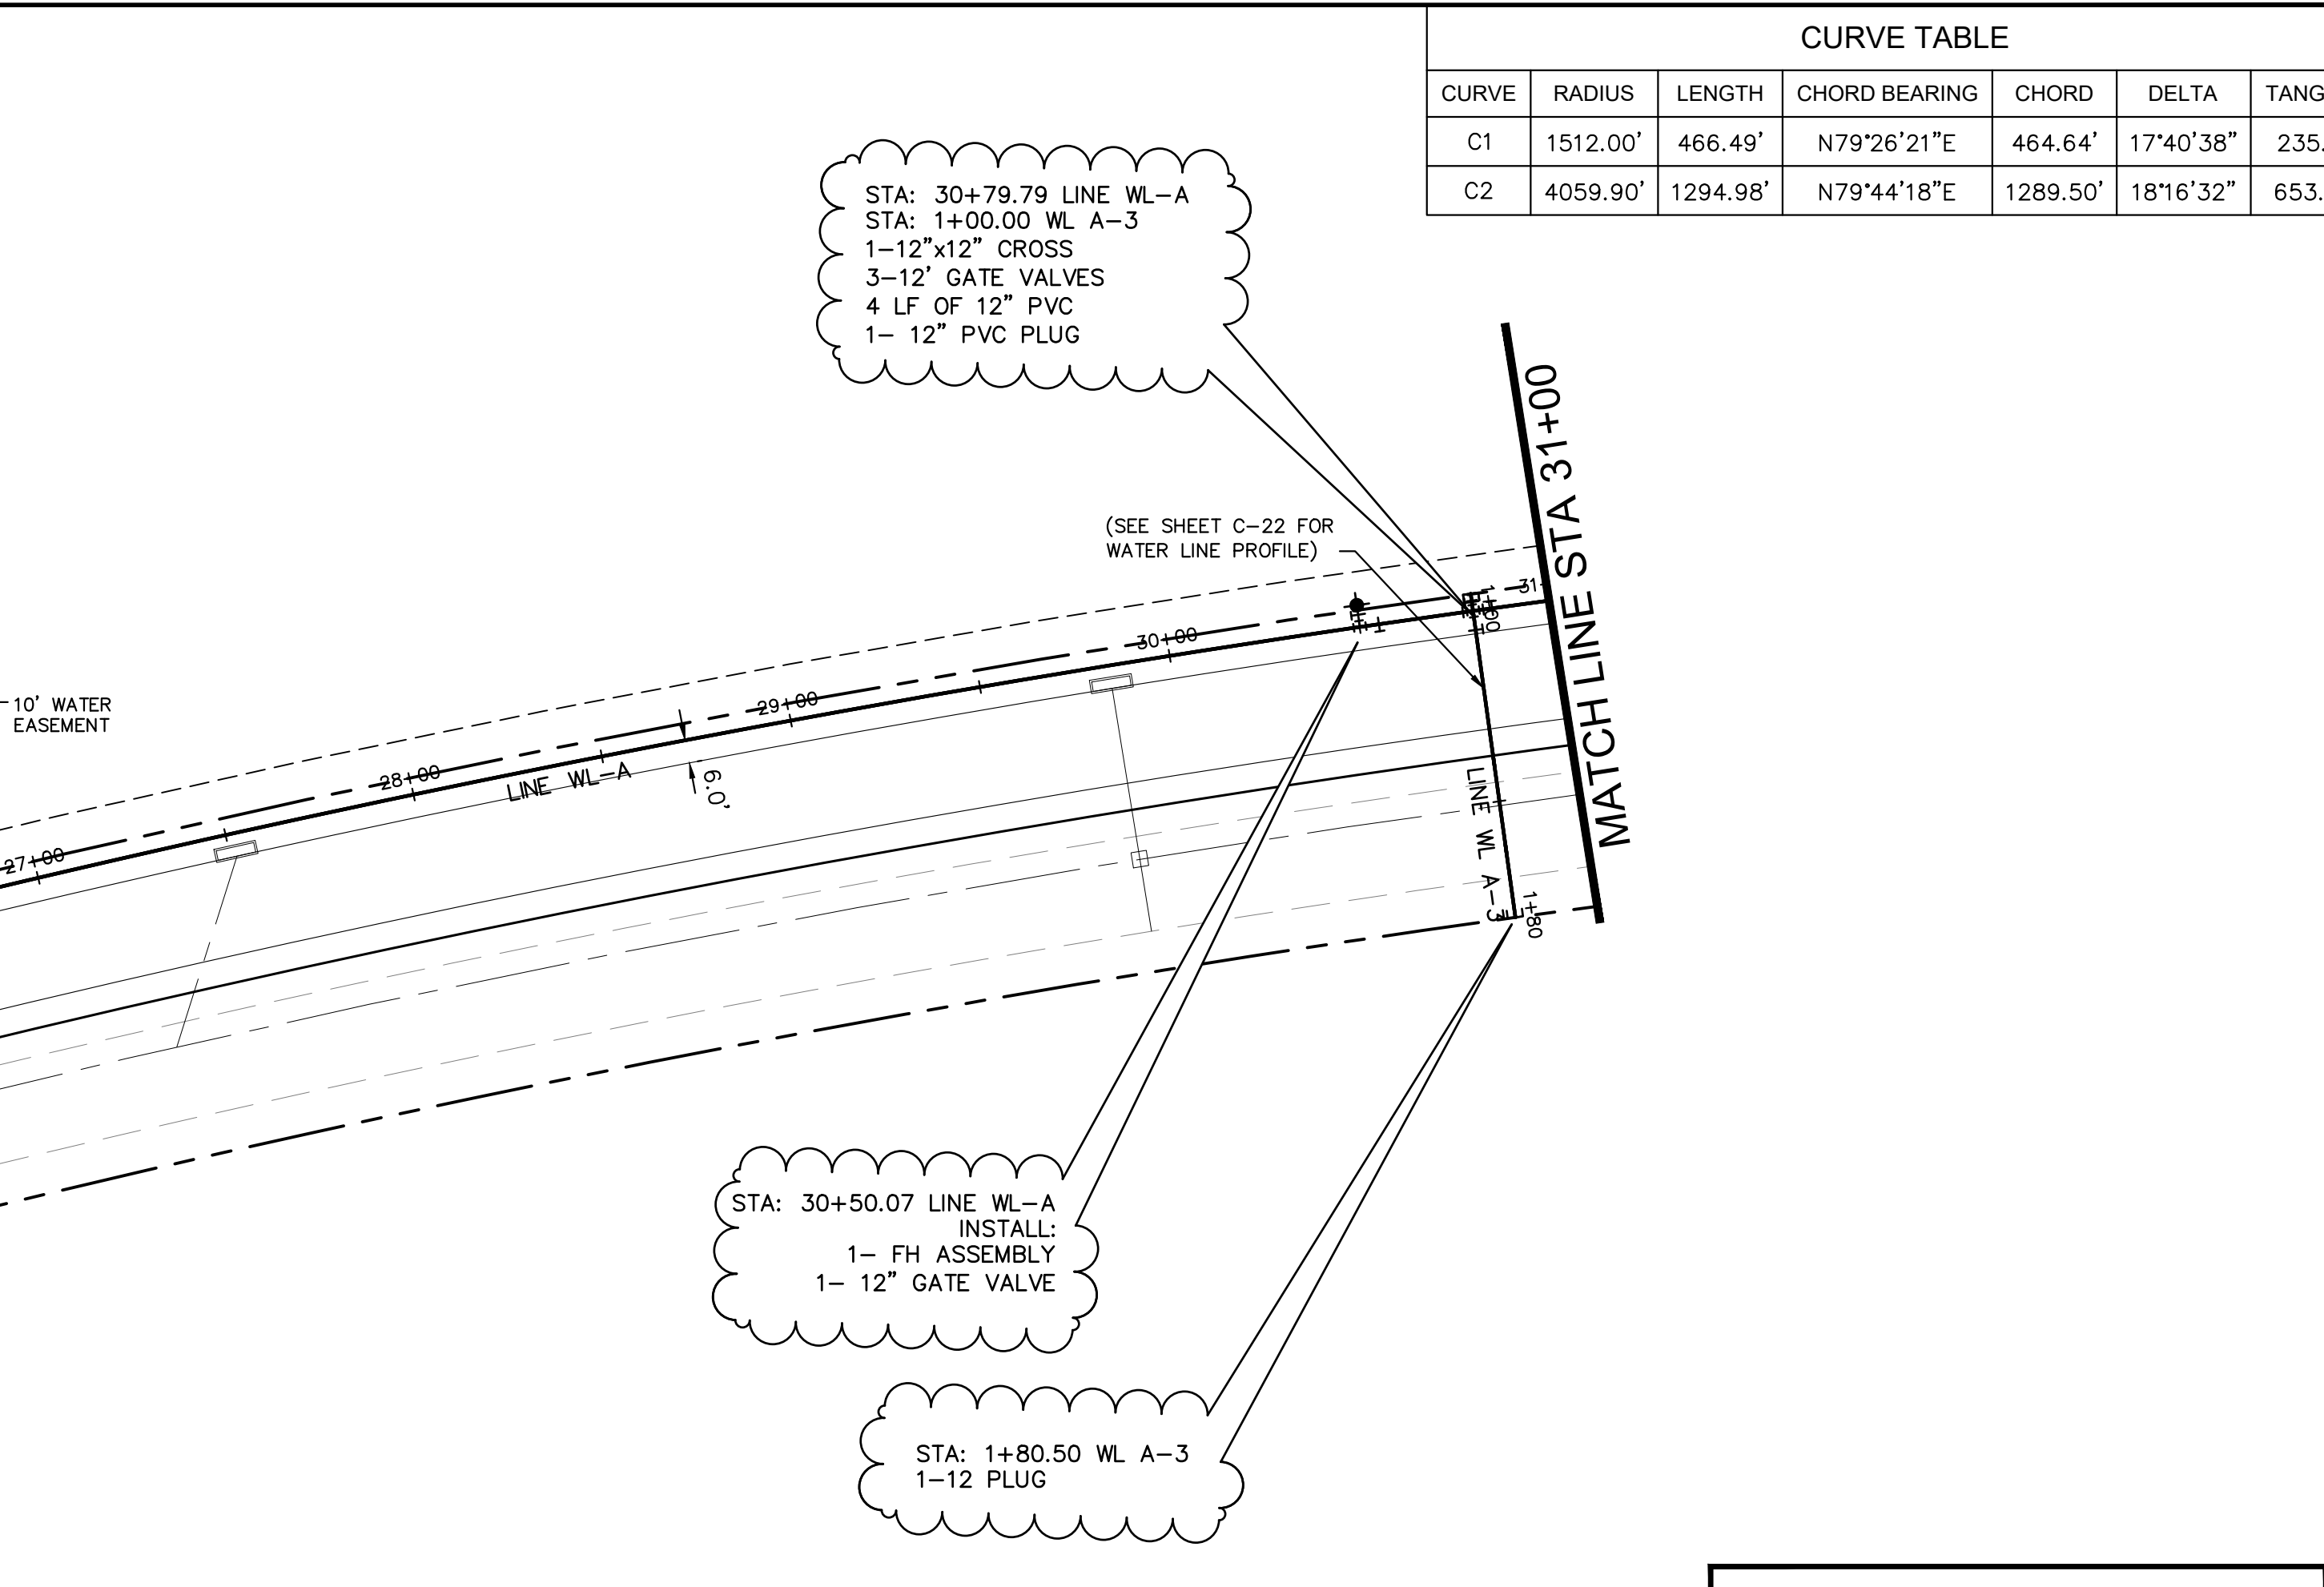
[illegible]

JUSTIN RD & CONVEYOR'S ST
EXTENSION
CITY OF ROCKWALL
ROCKWALL COUNTY, TEXAS

SHEET NUMBER
C-19

Kimley»»Horn

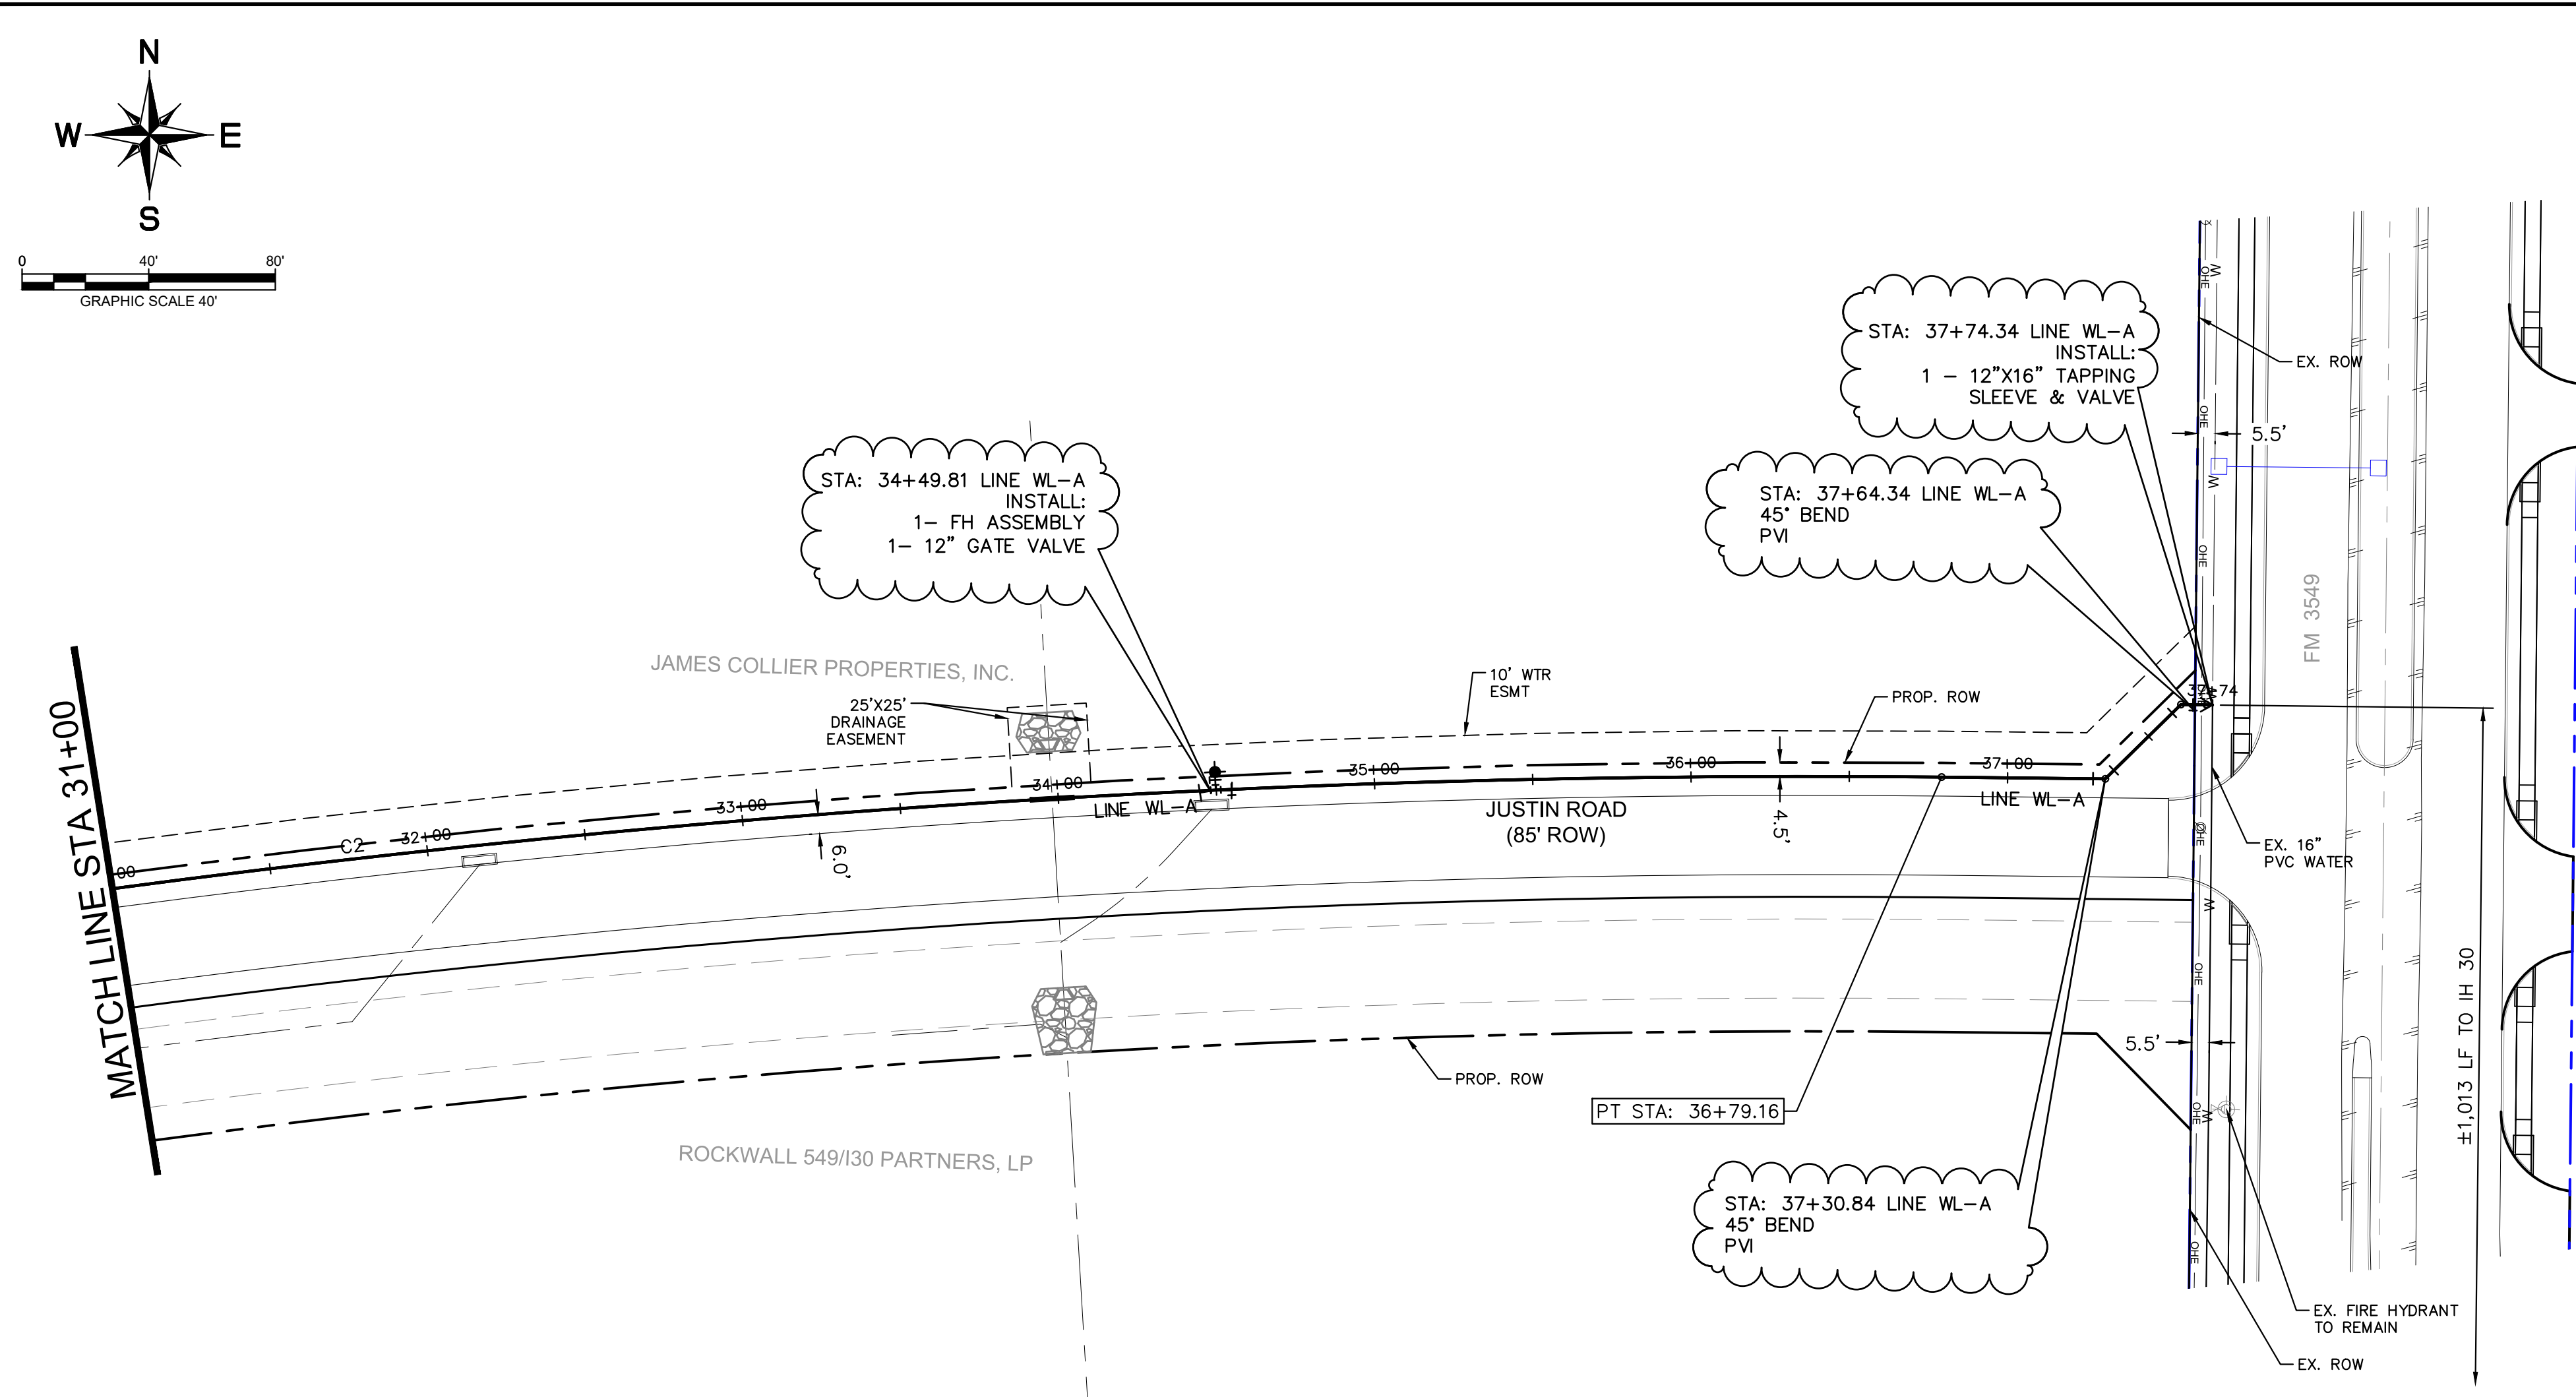© 2021 KIMLEY-HORN AND ASSOCIATES, INC.
400 N. OKLAHOMA DRIVE, SUITE 105, CELINA, TX 75009
PHONE: 469-501-2200
WWW.KIMLEY-HORN.COM
TEXAS REGISTERED ENGINEERING FIRM F-928



CURVE TABLE						
CURVE	RADIUS	LENGTH	CHORD BEARING	CHORD	DELTA	TANGENT
C2	4059.90'	1294.98'	N79°44'18"E	1289.50'	18°16'32"	653.04'



RECORD DRAWING

THIS DRAWING HAS BEEN REVISED TO SHOW THOSE CHANGES DURING THE CONSTRUCTION PROCESS REPORTED BY THE CONTRACTOR TO KIMLEY-HORN AND ASSOCIATES, INC. AND CONSIDERED TO BE SIGNIFICANT. THIS DRAWING IS NOT GUARANTEED TO BE "AS BUILT" BUT IS BASED ON THE INFORMATION MADE AVAILABLE.

DATE: 01/08/2021 BY: ANTHONY LOEFFEL, P.E.

!!WARNING!!

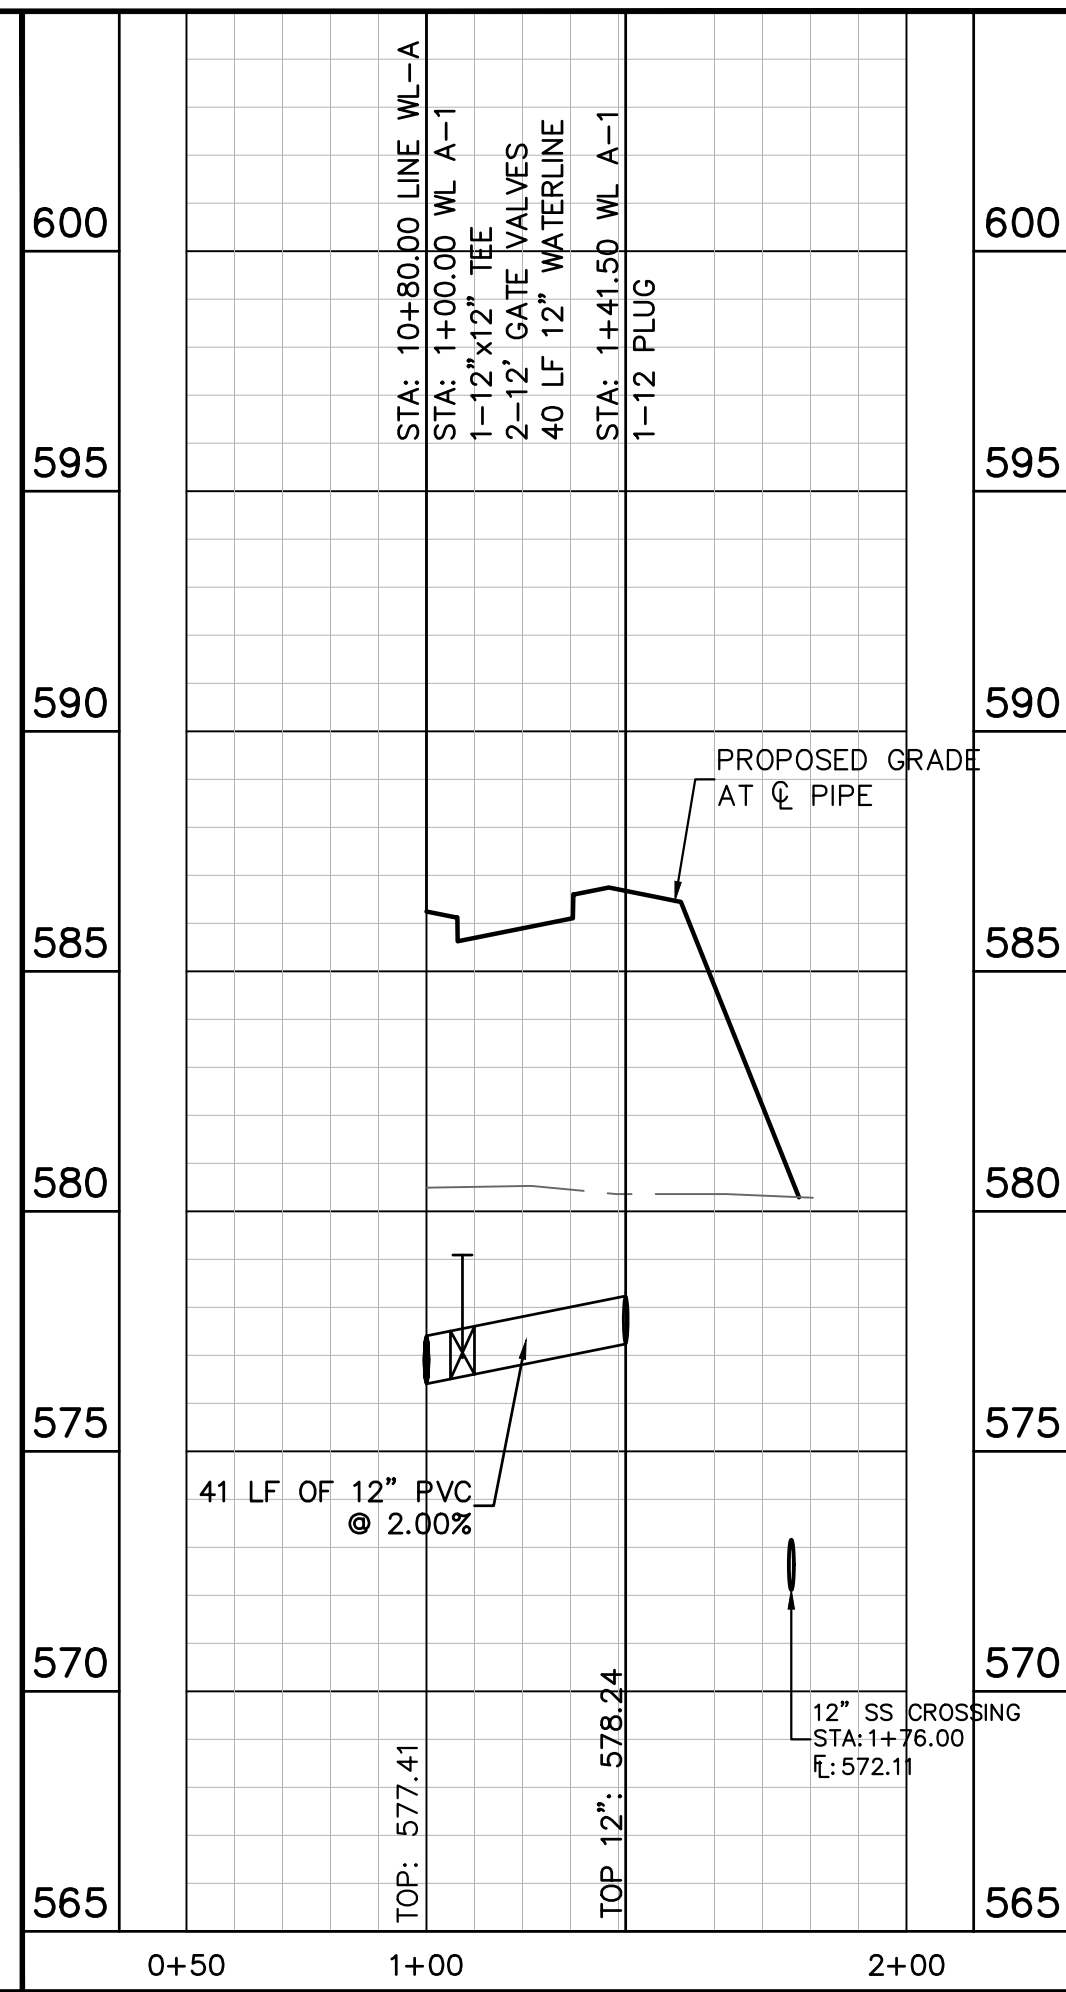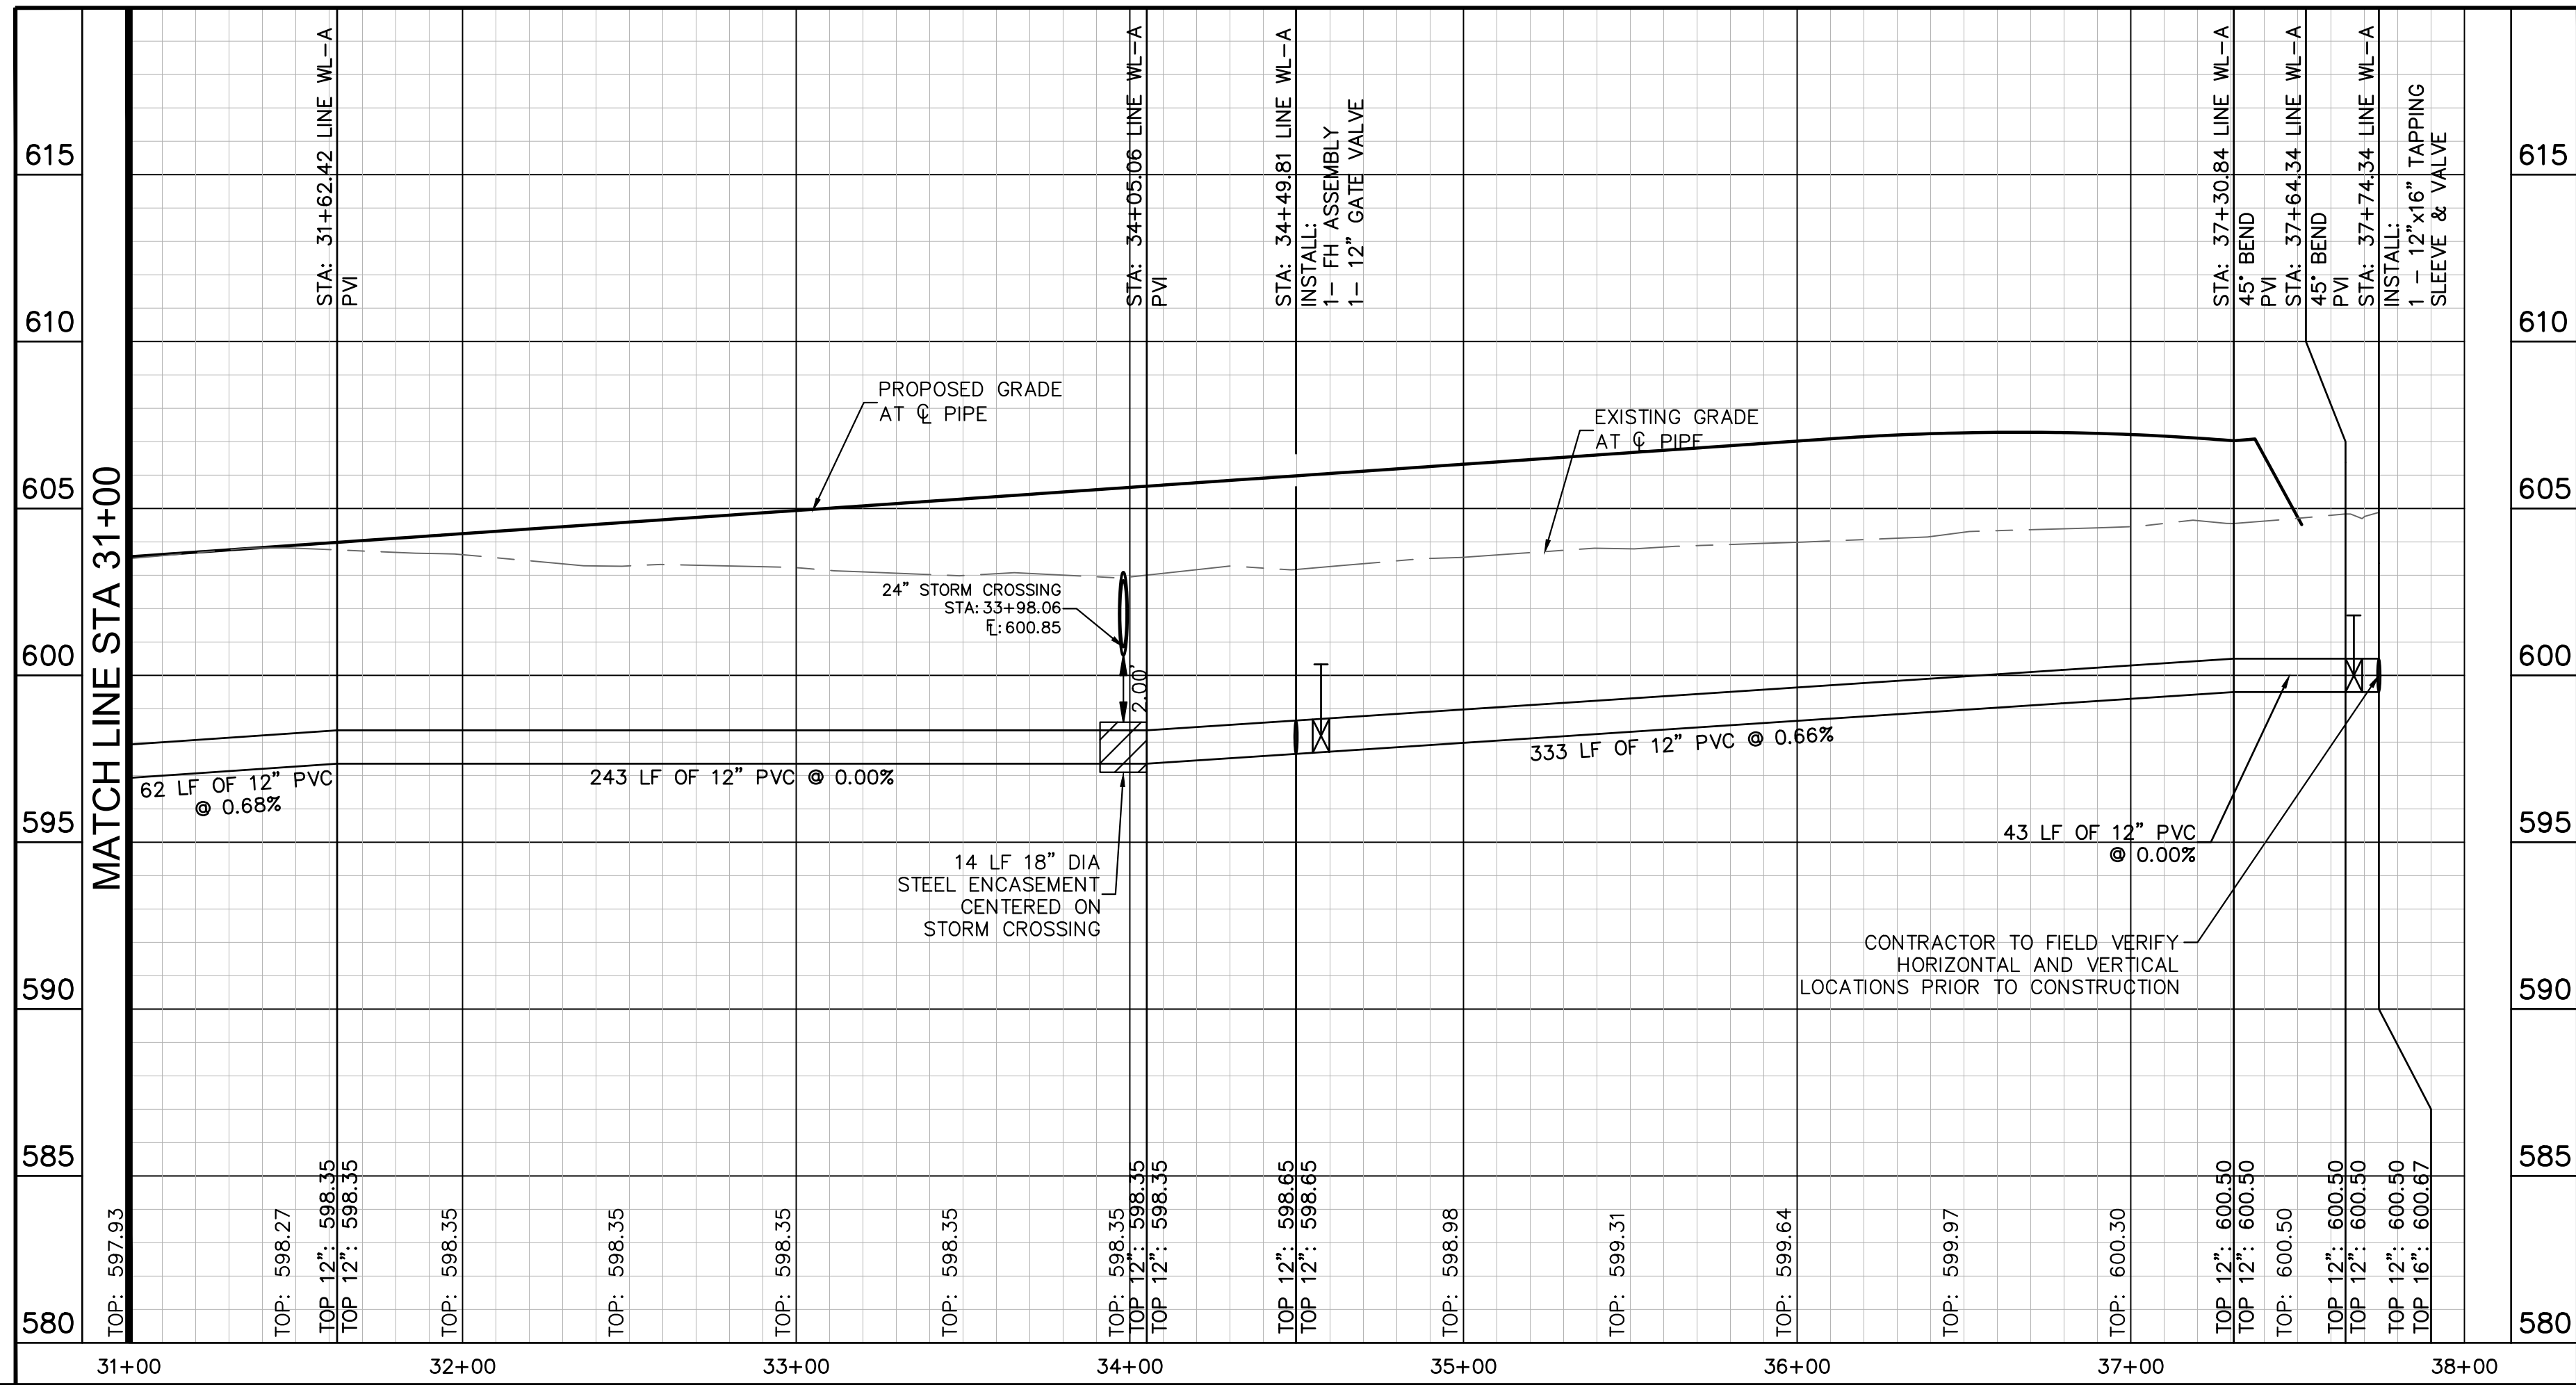EXISTING UTILITIES IN THE AREA.
CONTRACTOR SHALL FIELD VERIFY THE
LOCATION OF ALL EXISTING UTILITIES WITH
THE PROVIDER PRIOR TO START OF
CONSTRUCTION AND SHALL IMMEDIATELY
NOTIFY THE ENGINEER OF ANY CONFLICTS
DISCOVERED. CONTRACTOR IS
RESPONSIBLE FOR COORDINATING UTILITY
RELOCATION WHERE NECESSARY AND
PROTECTING EXISTING UTILITIES (SHOWN
OR NOT SHOWN). IF ANY EXISTING
UTILITIES ARE DAMAGED, THE
CONTRACTOR SHALL REPLACE THEM AT
THEIR OWN EXPENSE.





BENCHMARKS

SQUARE CUT IN CENTER OF AN INLET LOCATED ON THE NORTH SIDE OF INTERSTATE HIGHWAY 30, APPROXIMATELY 53 FEET EAST OF THE SOUTHEAST CURB RETURN OF CONVEYORS ST AND HWY 30.


ELEVATION = 587.055 FEET

SQUARE CUT ON NORTHEAST SIDE OF WATER MANHOLE RM. LOCATED ON THE WEST SIDE OF FM HIGHWAY 549, APPROXIMATELY 1246 FEET NORTH OF THE INTERSECTION OF FM 549 AND HWY 30.


ELEVATION = 610.402 FEET

SHEET NUMBER	JUSTIN RD & CONVEYOR'S ST EXTENSION CITY OF ROCKWALL ROCKWALL COUNTY, TEXAS	WATER PLAN & PROFILE - LINE WL-A (3 OF 3)	KHA PROJECT 063234203 DATE MARCH 2020 SCALE: AS SHOWN DESIGNED BY: AML DRAWN BY: LRT CHECKED BY: BLM	 <i>Anthony M. Loeffel</i> 1-8-21	 © 2021 KIMLEY-HORN AND ASSOCIATES, INC. 400 N. OKLAHOMA DRIVE, SUITE 105, CELINA, TX 75009 PHONE: 469-501-2200 WWW.KIMLEY-HORN.COM TEXAS REGISTERED ENGINEERING FIRM F-928	No.	REVISIONS	DATE	BY

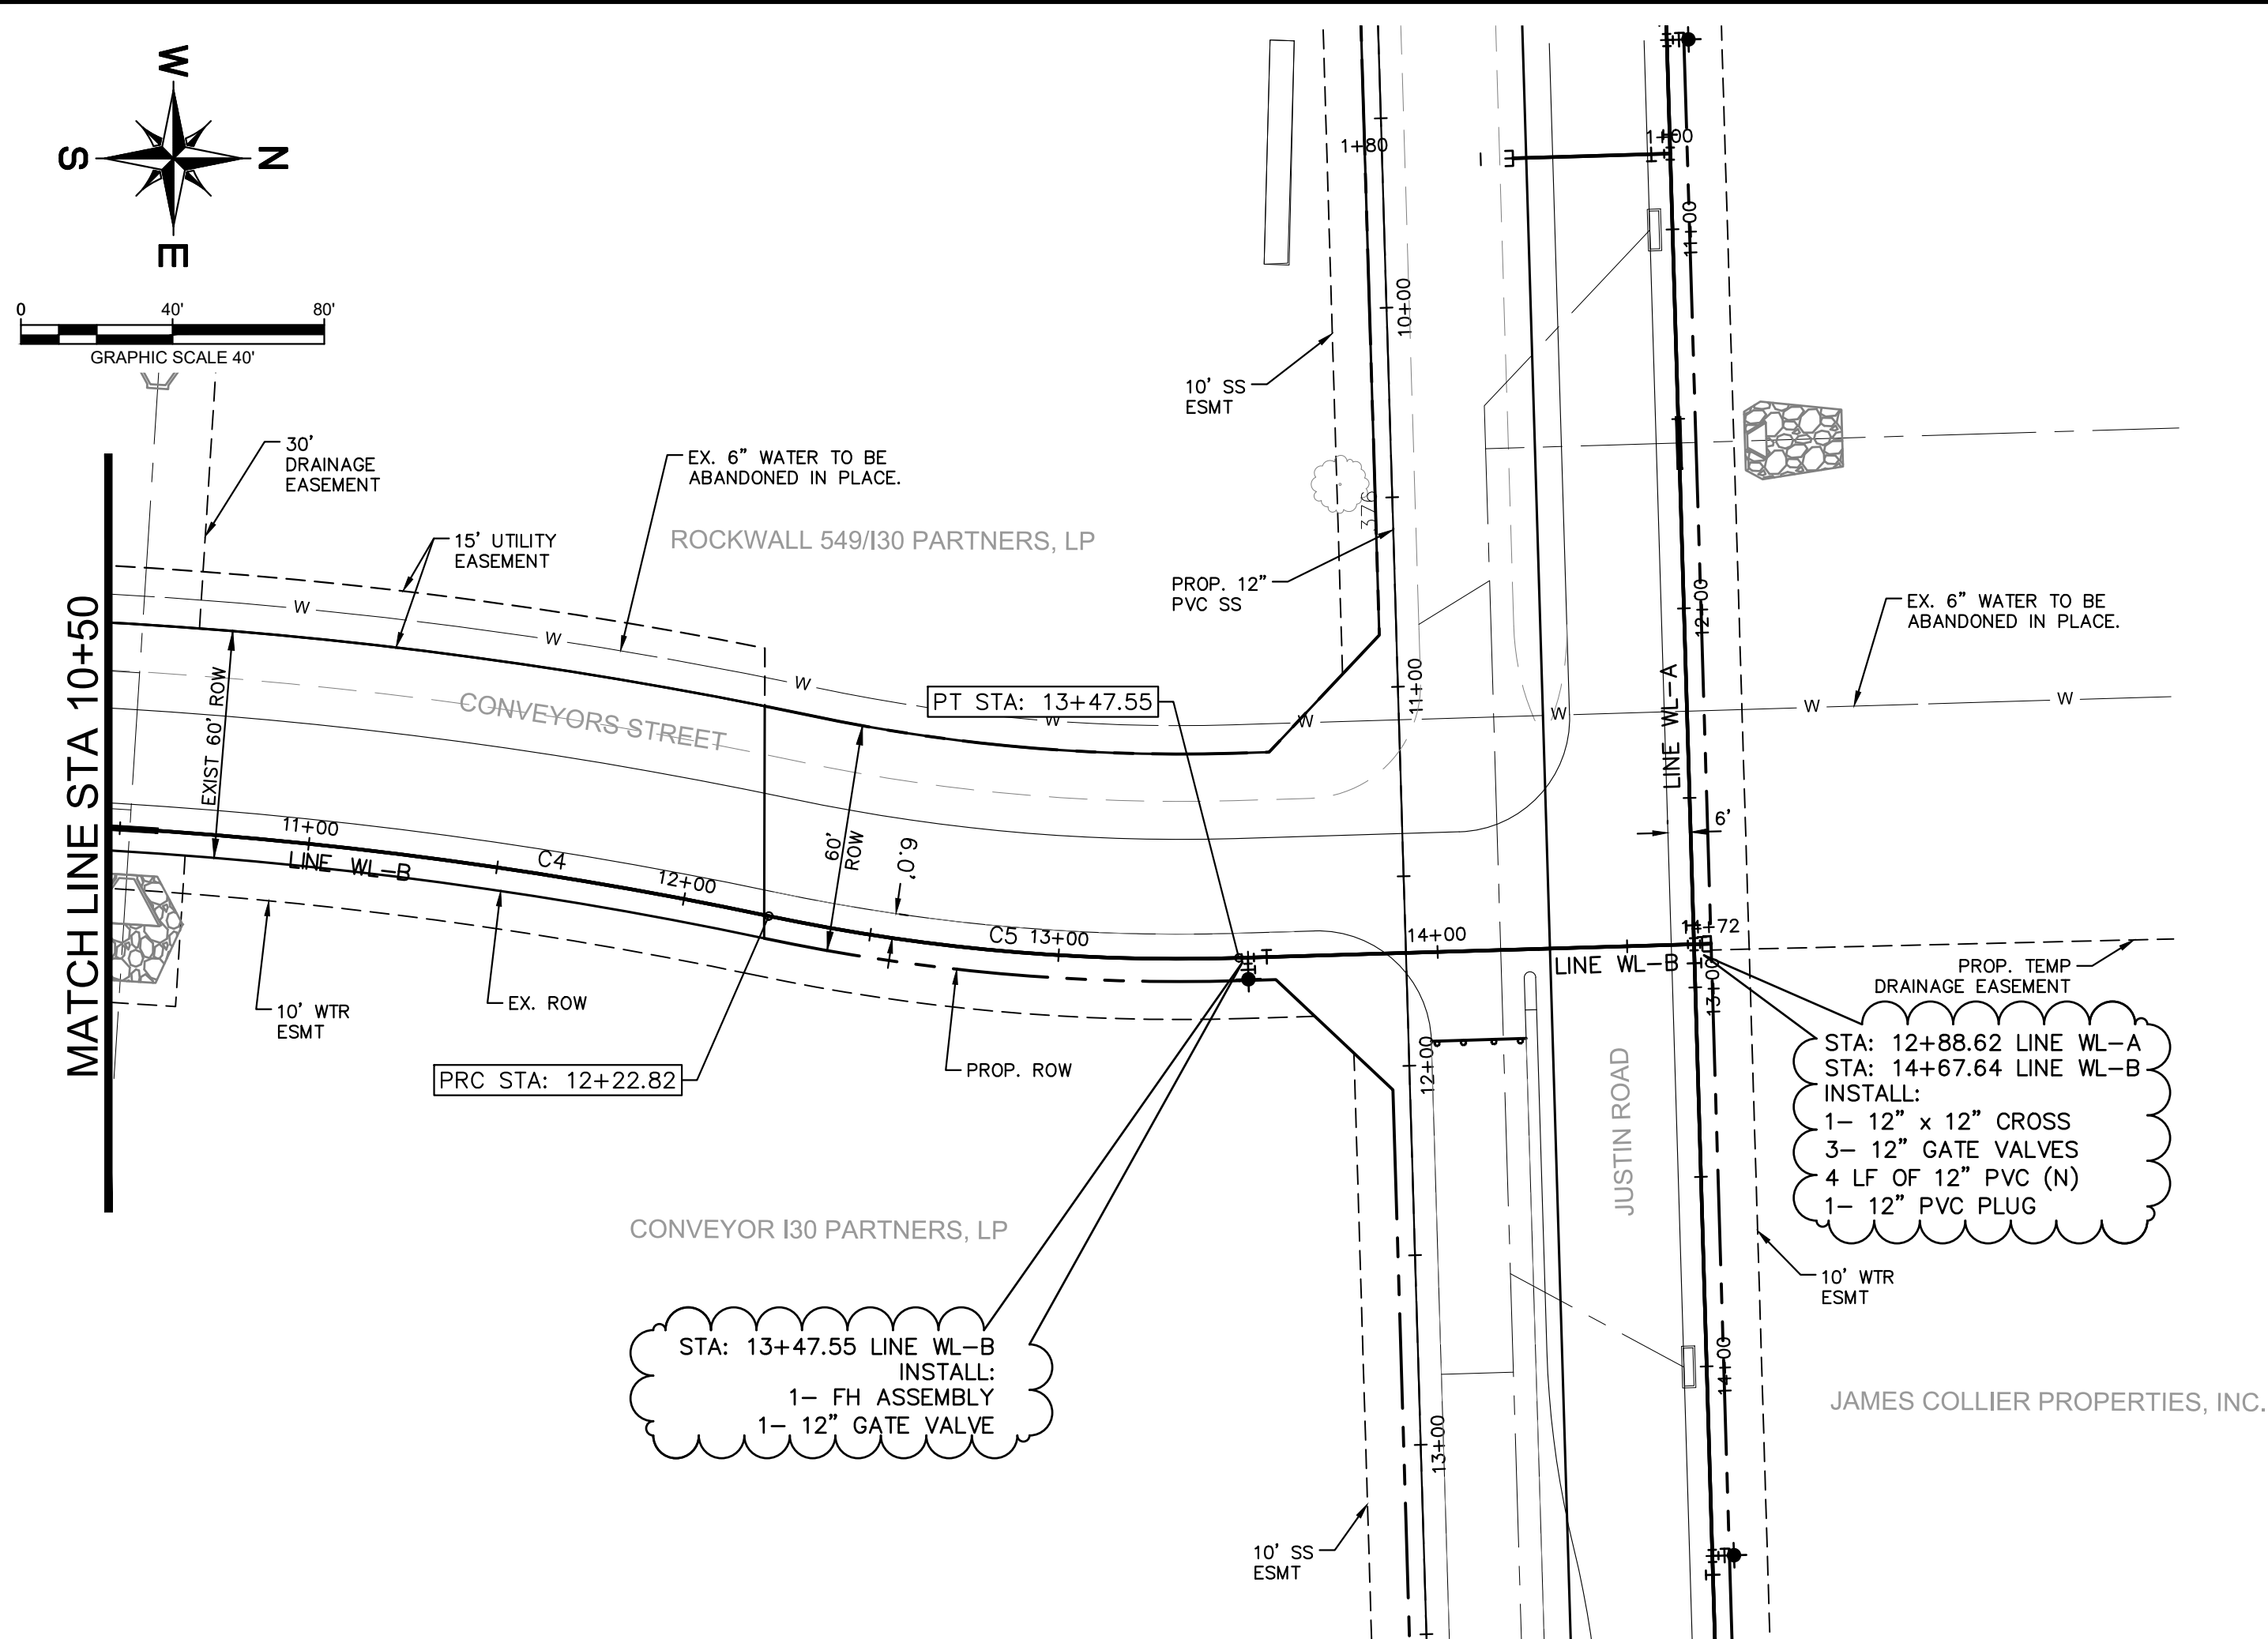
Plotted By: Loeffel, Anthony Date: January 08, 2021 11:32:30am File Path: K:\DEL_Civil\063234203-Rockwall - Commercial Rwy\CityPlanSheets\C-Water Plan.dwg
This document, together with the concepts and designs presented herein, is intended only for the specific purpose and client for which it was prepared. Reuse of and improper reliance on this document without written authorization and adaptation by Kimley-Horn and Associates, Inc. shall be without liability to Kimley-Horn and Associates, Inc.




LINE WL-B

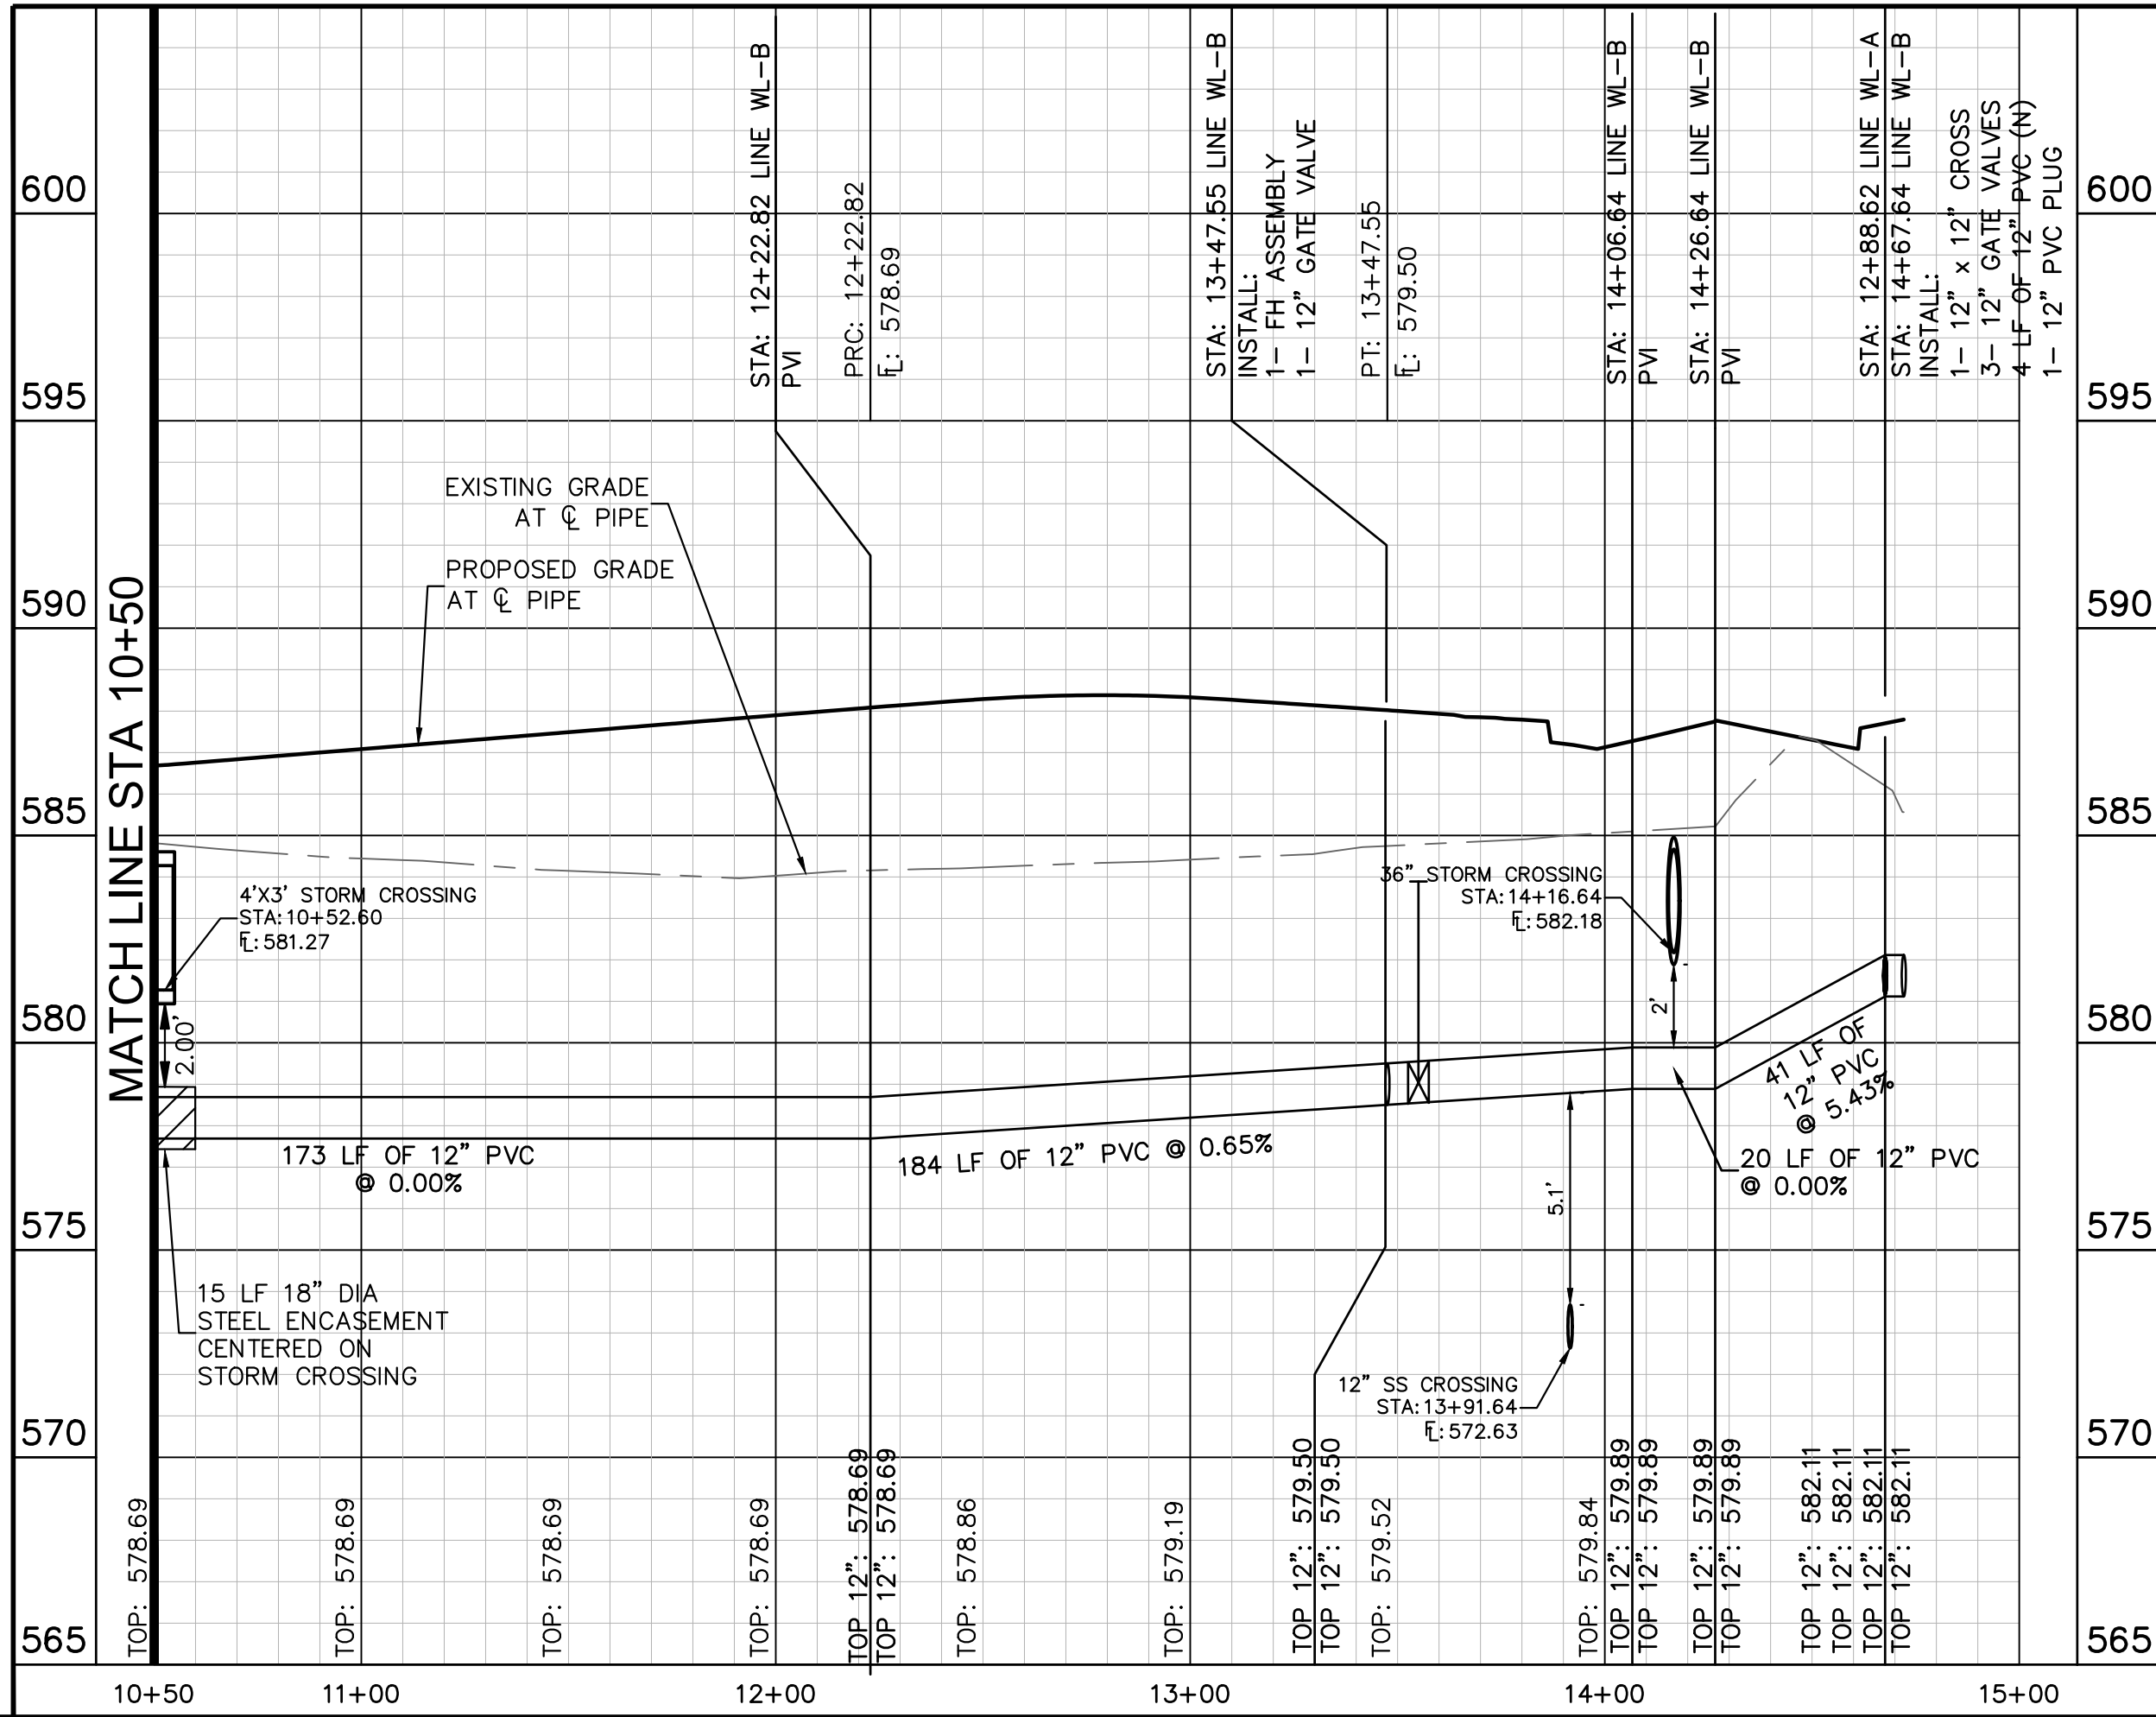

WL A-2

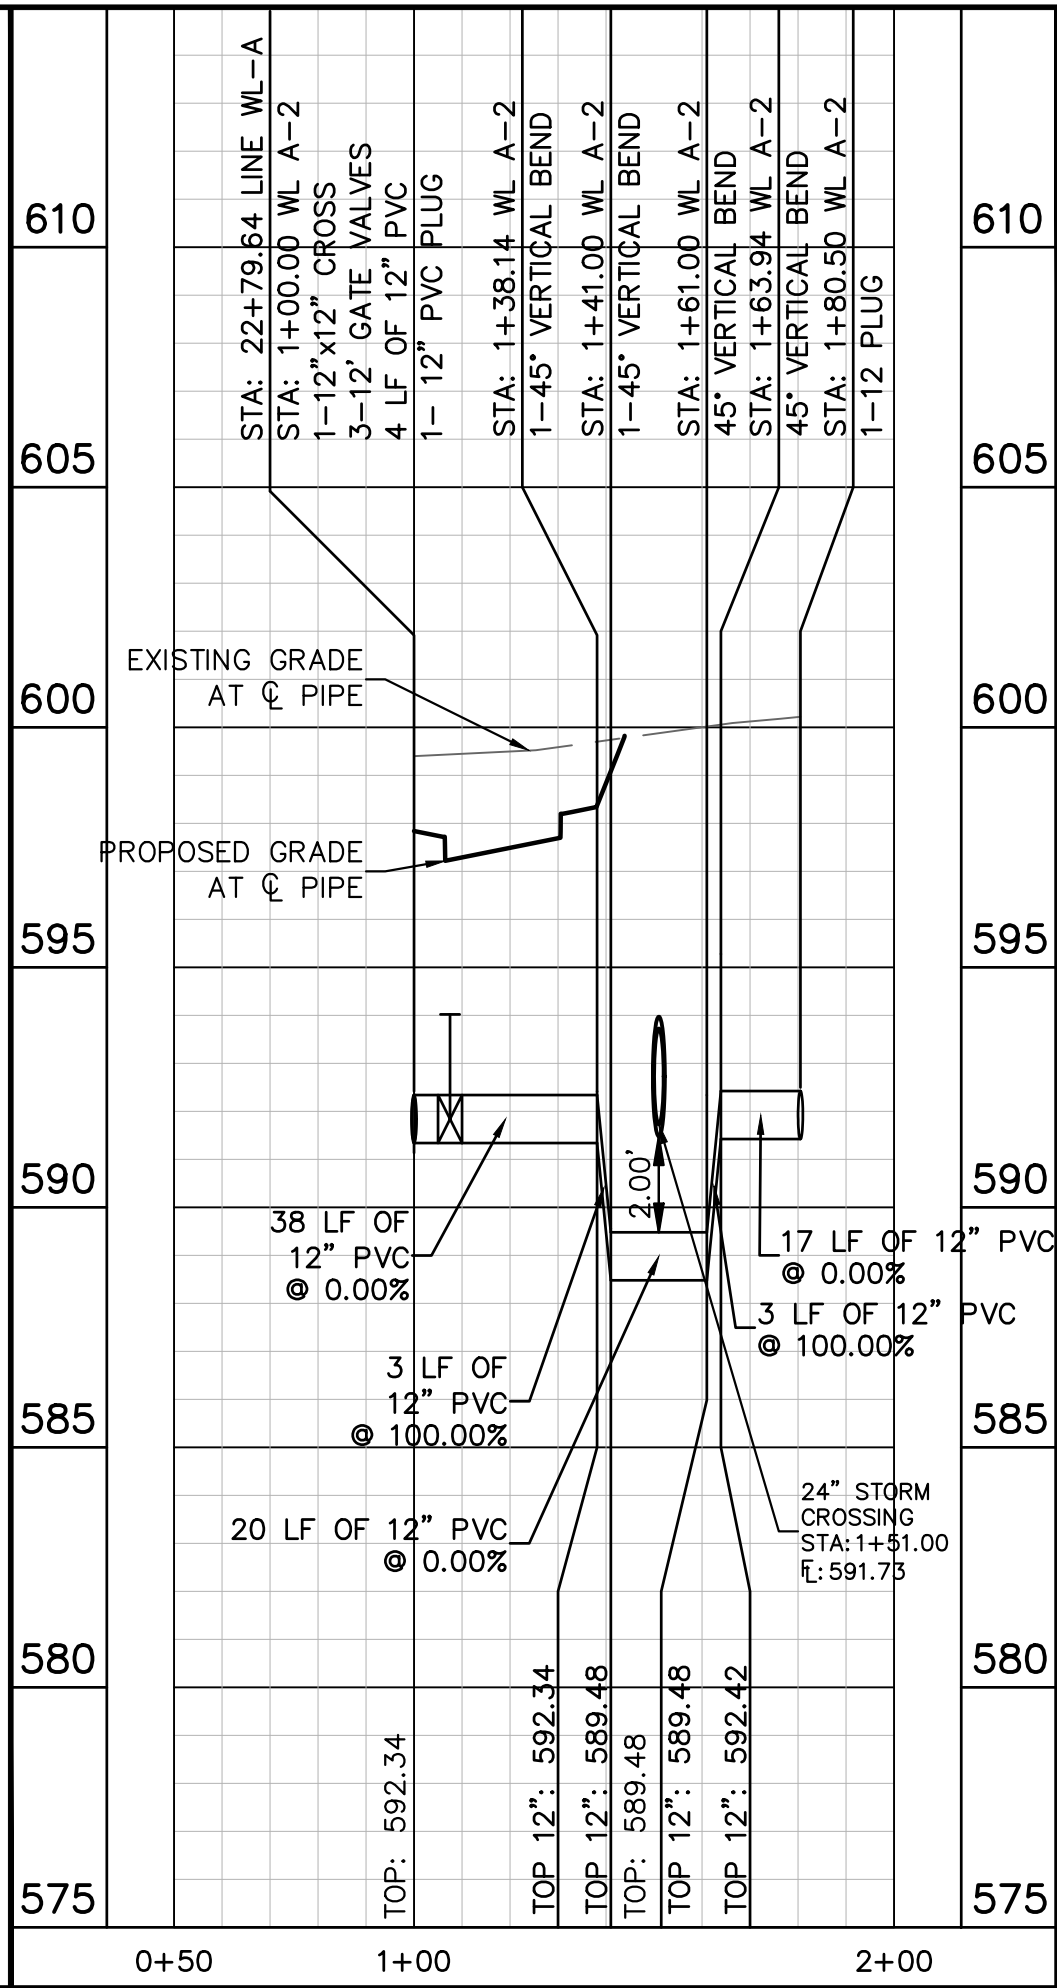

WL A-3

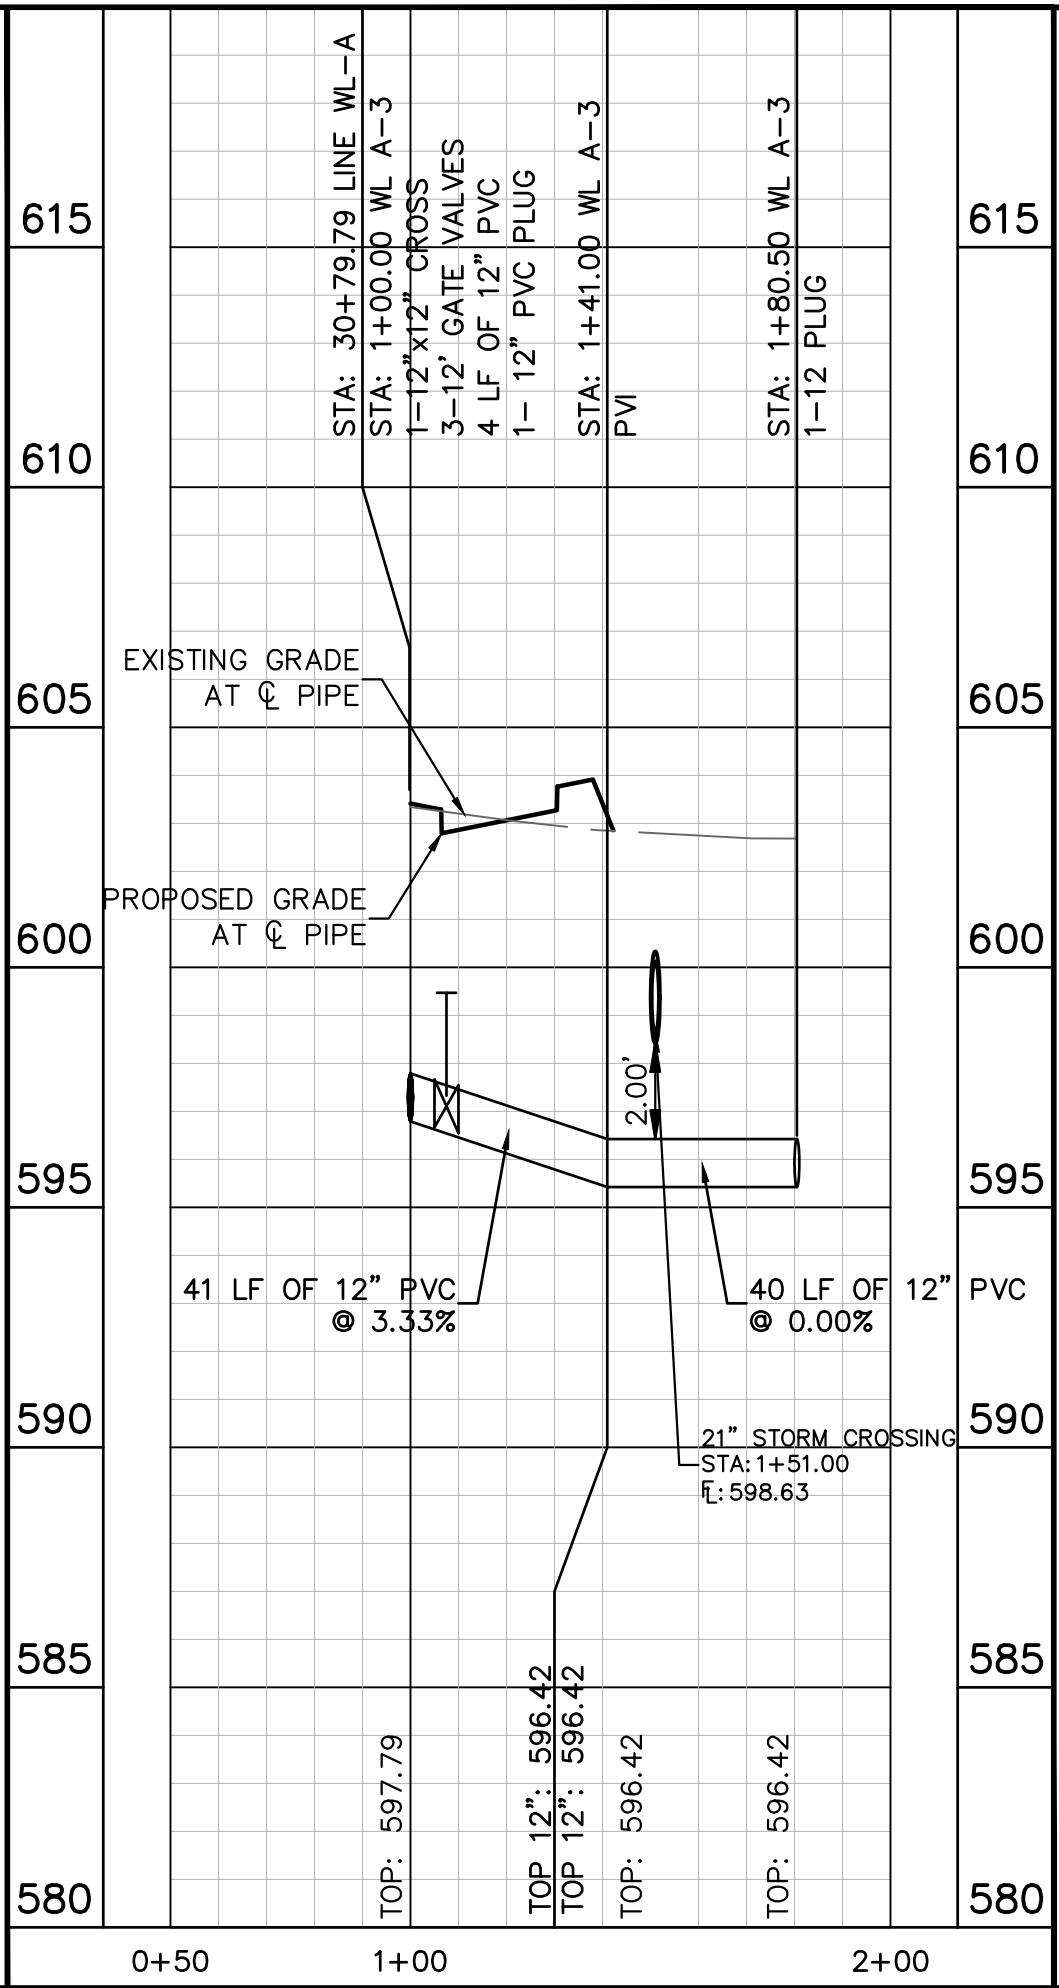

BENCHMARKS

SQUARE CUT IN CENTER OF AN INLET LOCATED ON THE NORTH SIDE OF INTERSTATE HIGHWAY 30, APPROXIMATELY 53 FEET EAST OF THE SOUTHEAST CURB RETURN OF CONVEYORS ST AND HWY 30.
ELEVATION = 587.055 FEET
SQUARE CUT ON NORTHEAST SIDE OF WATER MANHOLE RIM, LOCATED ON THE WEST SIDE OF FM HIGHWAY 549, APPROXIMATELY 1246 FEET NORTH OF THE INTERSECTION OF FM 549 AND HWY 30.
ELEVATION = 610.402 FEET

CURVE TABLE						
CURVE	RADIUS	LENGTH	CHORD BEARING	CHORD	DELTA	TANGENT
C4	1175.92'	310.70'	N4°20'47"E	309.80'	15°08'20"	156.26'
C5	524.00'	124.73'	N5°05'49"E	124.43'	13°38'17"	62.66'

RECORD DRAWING


THIS DRAWING HAS BEEN REVISED TO SHOW THOSE CHANGES DURING THE CONSTRUCTION PROCESS REPORTED BY THE CONTRACTOR TO KIMLEY-HORN AND ASSOCIATES, INC. AND IS CONSIDERED TO BE SIGNIFICANT. THIS DRAWING IS NOT GUARANTEED TO BE AS BUILT BUT IS BASED ON THE INFORMATION MADE AVAILABLE.
DATE: 01/08/2021 BY: ANTHONY LOEFFEL, P.E.

!!WARNING!!

EXISTING UTILITIES IN THE AREA. CONTRACTOR SHALL FIELD VERIFY THE LOCATION OF ALL EXISTING UTILITIES WITH THE PROVIDER PRIOR TO START OF CONSTRUCTION AND SHALL IMMEDIATELY NOTIFY THE ENGINEER OF ANY CONFLICTS DISCOVERED. CONTRACTOR IS RESPONSIBLE FOR COORDINATING UTILITY RELOCATION WHERE NECESSARY AND PROTECTING EXISTING UTILITIES (SHOWN OR NOT SHOWN). IF ANY EXISTING UTILITIES ARE DAMAGED, THE CONTRACTOR SHALL REPLACE THEM AT THEIR OWN EXPENSE.

Kimley»Horn

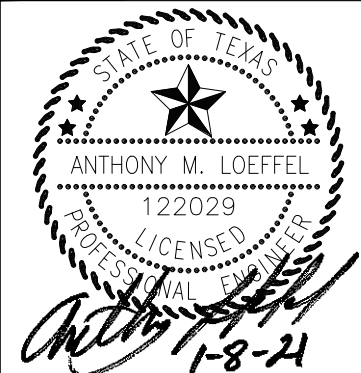© 2021 KIMLEY-HORN AND ASSOCIATES, INC.
400 N. OKLAHOMA DRIVE, SUITE 105, CELINA, TX 75009
PHONE: 469-501-2200
WWW.KIMLEY-HORN.COM
TEXAS REGISTERED ENGINEERING FIRM F-928



KHA PROJECT	063234203
DATE	MARCH 2020
SCALE	AS SHOWN
DESIGNED BY:	AVL
DRAWN BY:	LRT
CHECKED BY:	BLM

WATER PLAN & PROFILE -
LINE WL-B (2 OF 2)

JUSTIN RD & CONVEYOR'S ST
EXTENSION
CITY OF ROCKWALL
ROCKWALL COUNTY, TEXAS

SHEET NUMBER
C-22

RECORD DRAWING

THIS DRAWING HAS BEEN REVISED TO SHOW THOSE CHANGES DURING THE CONSTRUCTION PROCESS REPORTED BY THE CONTRACTOR TO KIMLEY-HORN AND ASSOCIATES, INC. AND CONSIDERED TO BE SIGNIFICANT. THIS DRAWING IS NOT GUARANTEED TO BE "AS BUILT" BUT IS BASED ON THE INFORMATION MADE AVAILABLE.

DATE: 01/08/2021 BY: ANTHONY LOEFFEL, P.E.

© 2021 KIMLEY-HORN AND ASSOCIATES, INC.
400 N. OKLAHOMA DRIVE, SUITE 105, CELINA, TX 75009
PHONE: 469-501-2200
WWW.KIMLEY-HORN.COM




KHA PROJECT 063234203	DATE MARCH 2020	SCALE: AS SHOWN	DESIGNED BY: AML	DRAWN BY: LRT
--------------------------	--------------------	-----------------	------------------	---------------

SANITARY SEWER
PLAN & PROFILE -
LINE SS-A (1 OF 2)

JUSTIN RD & CONVEYOR'S ST
EXTENSION
CITY OF ROCKWALL
ROCKWALL COUNTY TEXAS

SHEET NUMBER
C-23

No.	REVISIONS	DATE	BY
-----	-----------	------	----

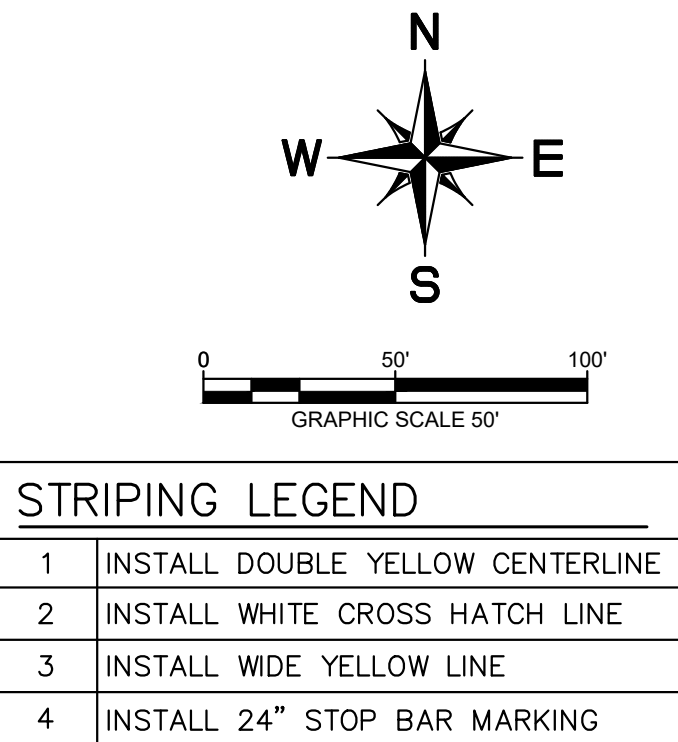



NOTES

1. CONTRACTOR IS RESPONSIBLE FOR RELOCATION OF ANY SIGNS AND COORDINATION WITH THE OWNER ON ANY NECESSARY MODIFICATIONS.
2. DOUBLE YELLOW CENTERLINE SHALL BE INSTALLED PER THE CITY OF ROCKWALL'S STANDARD DETAIL R-2320.
3. WHITE CROSS HATCH LINE SHALL BE INSTALLED PER THE CITY OF ROCKWALL'S STANDARD DETAIL R-2320 AND R-2330. SPACING B SHALL BE 5'.
4. WIDE YELLOW LINE SHALL BE INSTALLED PER THE CITY OF ROCKWALL'S STANDARD DETAIL R-2320.
5. STOP BAR STRIPING SHALL BE THERMOPLASTIC WITH A MINIMUM THICKNESS OF 100 MILS.
6. BARRICADES SHALL CONTAIN NO WOODEN MATERIALS.


RECORD DRAWING

THIS DRAWING HAS BEEN REVISED TO SHOW THOSE CHANGES DURING THE CONSTRUCTION PROCESS REPORTED BY THE CONTRACTOR TO KIMLEY-HORN AND ASSOCIATES, INC. AND CONSIDERED TO BE SIGNIFICANT. THIS DRAWING IS NOT GUARANTEED TO BE "AS BUILT" BUT IS BASED ON THE INFORMATION MADE AVAILABLE.

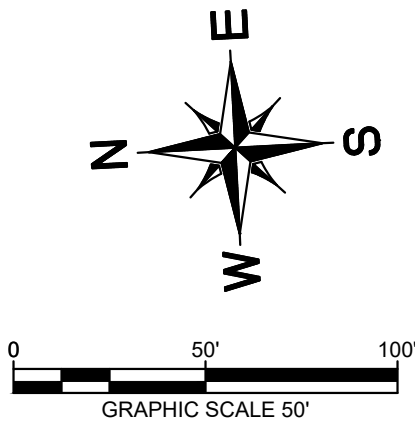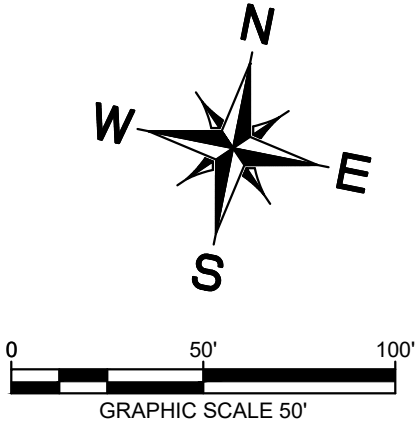DATE: 01/08/2021 BY: ANTHONY LOEFFEL, P.E.

[illegible]

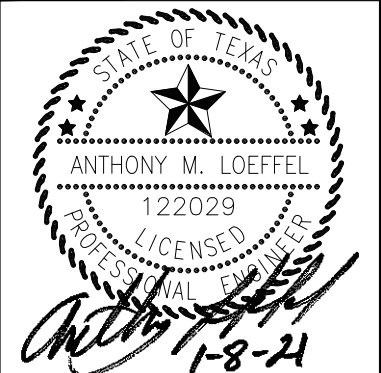Kimley»»Horn
© 2021 KIMLEY-HORN AND ASSOCIATES, INC.
400 N. OKLAHOMA DRIVE, SUITE 105, CELINA, TX 75009
PHONE: 469-501-2200
WWW.KIMLEY-HORN.COM
TEXAS REGISTERED ENGINEERING FIRM F-928



KHA PROJECT 063234203	DATE MARCH 2020	SCALE: AS SHOWN	DESIGNED BY: AMU	DRAWN BY: AMU	CHECKED BY: BLN
--------------------------	--------------------	-----------------	------------------	---------------	-----------------

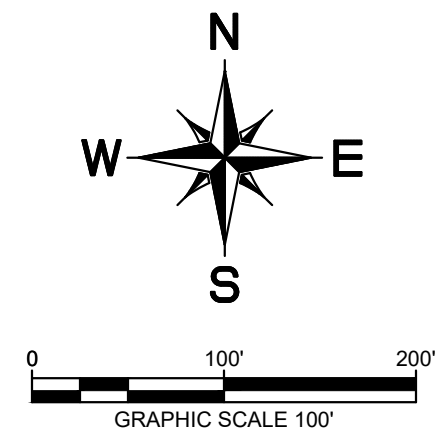
STREET LIGHT, STRIPING & SIGN PLAN

JUSTIN RD & CONVEYOR'S ST
EXTENSION
CITY OF ROCKWALL
ROCKWALL COUNTY, TEXAS

SHEET NUMBER
C-25

Plotted By:Loeffel, Anthony Date:January 08, 2011 11:31:36am
 This document, together with the concepts and designs presented herein, is intended only as an instrument of the specific purpose and client for which it was prepared. Reuse or other improper reliance on this document without authorization and adaptation by Kinney-Horn and Associates, Inc. shall be without liability to Kinney-Horn and Associates, Inc.
 File Path:K:\OE\Civil\06323424203-Reckwall - Commercial Rxdy\Cod\PlanSheets-C-Street Light & Sign Plan.dwg

Plotted By: Loeffel, Anthony Date: January 08, 2021 11:34:05am File Path: K:\CEL\Civil\063234203-Rockwall - Commercial\Rock\PlanSheets\CE-Erosion Control Plan.dwg
This document, together with the concepts and designs presented herein, is an instrument of service, and is intended only for the specific purpose and client for which it was prepared. Reuse of and improper reliance on this document without written authorization and adaptation by Kimley-Horn and Associates, Inc. shall be without liability to Kimley-Horn and Associates, Inc.



SITE MAP GENERAL NOTES

- CONTRACTOR IS SOLELY RESPONSIBLE FOR SELECTION, IMPLEMENTATION, MAINTENANCE, AND EFFECTIVENESS OF ALL SWPPP CONTROLS - CONTROLS SHOWN ON THIS SITE MAP ARE SUGGESTED CONTROLS ONLY.
- CONTRACTOR SHALL RECORD INSTALLATION, MAINTENANCE OR MODIFICATION, AND REMOVAL DATES FOR EACH BMP EMPLOYED (WHETHER CALLED OUT ON ORIGINAL SWPPP OR NOT) DIRECTLY ON THE SITE MAP.
- DRAINAGE PATTERNS ARE SHOWN ON THIS PLAN BY PROPOSED AND EXISTING CONTOURS, FLOW ARROWS AND/OR SLOPES.
- TEMPORARY AND PERMANENT STABILIZATION PRACTICES AND BMP'S SHALL BE INSTALLED AT THE EARLIEST POSSIBLE TIME DURING THE CONSTRUCTION SEQUENCE. AS AN EXAMPLE, PERIMETER SILT FENCE SHALL BE INSTALLED BEFORE COMMENCEMENT OF ANY GRADING ACTIVITIES. OTHER BMP'S SHALL BE INSTALLED AS SOON AS PRACTICABLE AND SHALL BE MAINTAINED UNTIL FINAL SITE STABILIZATION IS ATTAINED. CONTRACTOR SHALL ALSO REFERENCE CIVIL AND LANDSCAPE PLANS SINCE PERMANENT STABILIZATION IS PROVIDED BY LANDSCAPING, THE BUILDING(S), AND SITE PAVING.
- BMP'S HAVE BEEN LOCATED AS INDICATED ON THIS PLAN IN ACCORDANCE WITH GENERALLY ACCEPTED ENGINEERING PRACTICES IN ORDER TO MINIMIZE SEDIMENT TRANSFER. FOR EXAMPLE: SILT FENCES LOCATED AT TOE OF SLOPE AND INLET PROTECTION FOR INLETS RECEIVING SEDIMENT FROM SITE RUN-OFF.
- SANITARY SEWER EFFLUENT IS DISPOSED OF VIA AN ONSITE SEWER SYSTEM CONNECTED TO A MUNICIPAL SEWER SYSTEM.

VEGETATIVE STABILIZATION REQUIREMENTS

TEMPORARY SEEDING

ALL DISTURBED AREAS WHICH WILL BE LEFT DORMANT FOR GREATER THAN 14 DAYS SHALL BE SEED WITH FAST-GERMINATING TEMPORARY VEGETATION IMMEDIATELY FOLLOWING GRADING OPERATIONS. SELECTION OF THE SEED WILL DEPEND ON THE TIME OF YEAR IT IS APPLIED (SEE DESCRIPTIONS IN TABLE 2). REFERENCE LANDSCAPE PLAN FOR PERMANENT STABILIZATION REQUIREMENTS. ALL TEMPORARY SEEDING MATERIALS SHALL BE APPROVED BY THE OWNER'S REPRESENTATIVE PRIOR TO APPLICATION.

TABLE 2 VEGETATION TABLE*

TEMPORARY SEEDING SPECIES	PLANTING RATE	PLANTING DATES
CRIMSON CLOVER	7#/ACRE	8/15 - 11/30
MILLET, FOXTAIL	30#/ACRE	5/1 - 8/31
RYEGRASS, ANNUAL	30#/ACRE	8/15 - 9/30
SPRANGLETOP, GREEN	2.5#/ACRE	2/1 - 5/1
TALL FESCUE	7-10#/1000 SF	9/1 - 10/15

*USE ONLY USDA CERTIFIED SEED.

SURFACE PREPARATION FOR TEMPORARY SEEDING

- INSTALL EROSION STRUCTURES SUCH AS DIKES, DIVERSIONS, ETC. PRIOR TO SEEDING.
- FURROW SLOPES STEEPER THAN 3:1 ON THE CONTOUR LINE BEFORE SEEDING.
- ENSURE SEED BED IS PULVERIZED, LOOSE, AND UNIFORM.

APPLICATION

- WHEN HYDROMULCHING IS USED, DO NOT MIX SEED AND FERTILIZER MORE THAN 30 MINUTES PRIOR TO APPLICATION.
- APPLY SEED EVENLY USING PROPER EQUIPMENT AND WATER TO AID VEGETATION GROWTH.
- EROSION CONTROL NETTING SHALL BE INSTALLED OVER FILL SLOPES WHICH HAVE BEEN BROUGHT TO FINAL GRADE AND HAVE BEEN SEED TO PROTECT AGAINST EROSION. MULCH (STRAW OR FIBER) SHALL BE USED ON RELATIVELY FLAT SLOPES.

EROSION CONTROL SCHEDULE AND PHASING

THE PROJECT SHALL GENERALLY CONFORM TO THE FOLLOWING:

PHASE A - GRADING

- CONSTRUCT TEMPORARY CONSTRUCTION ENTRANCE, SILT FENCE, DIKE, AND TREE PROTECTION FENCE ACCORDING TO THE APPROXIMATE LOCATION AND SHOWN ON GRADING AND EROSION CONTROL PLAN NOTES AND DETAIL SHEET.
- BEGIN CLEARING AND GRADING OF SITE.
- SEED AND REVEGETATE SLOPES WHERE SHOWN.

PHASE B - UTILITIES

- KEEP ALL STORM WATER POLLUTION PREVENTION MEASURES IN PLACE.
- INSTALL STORM DRAINS, SANITARY SEWER, AND WATER AS SPECIFIED ON PLAN SHEETS.

PHASE C - PAVING

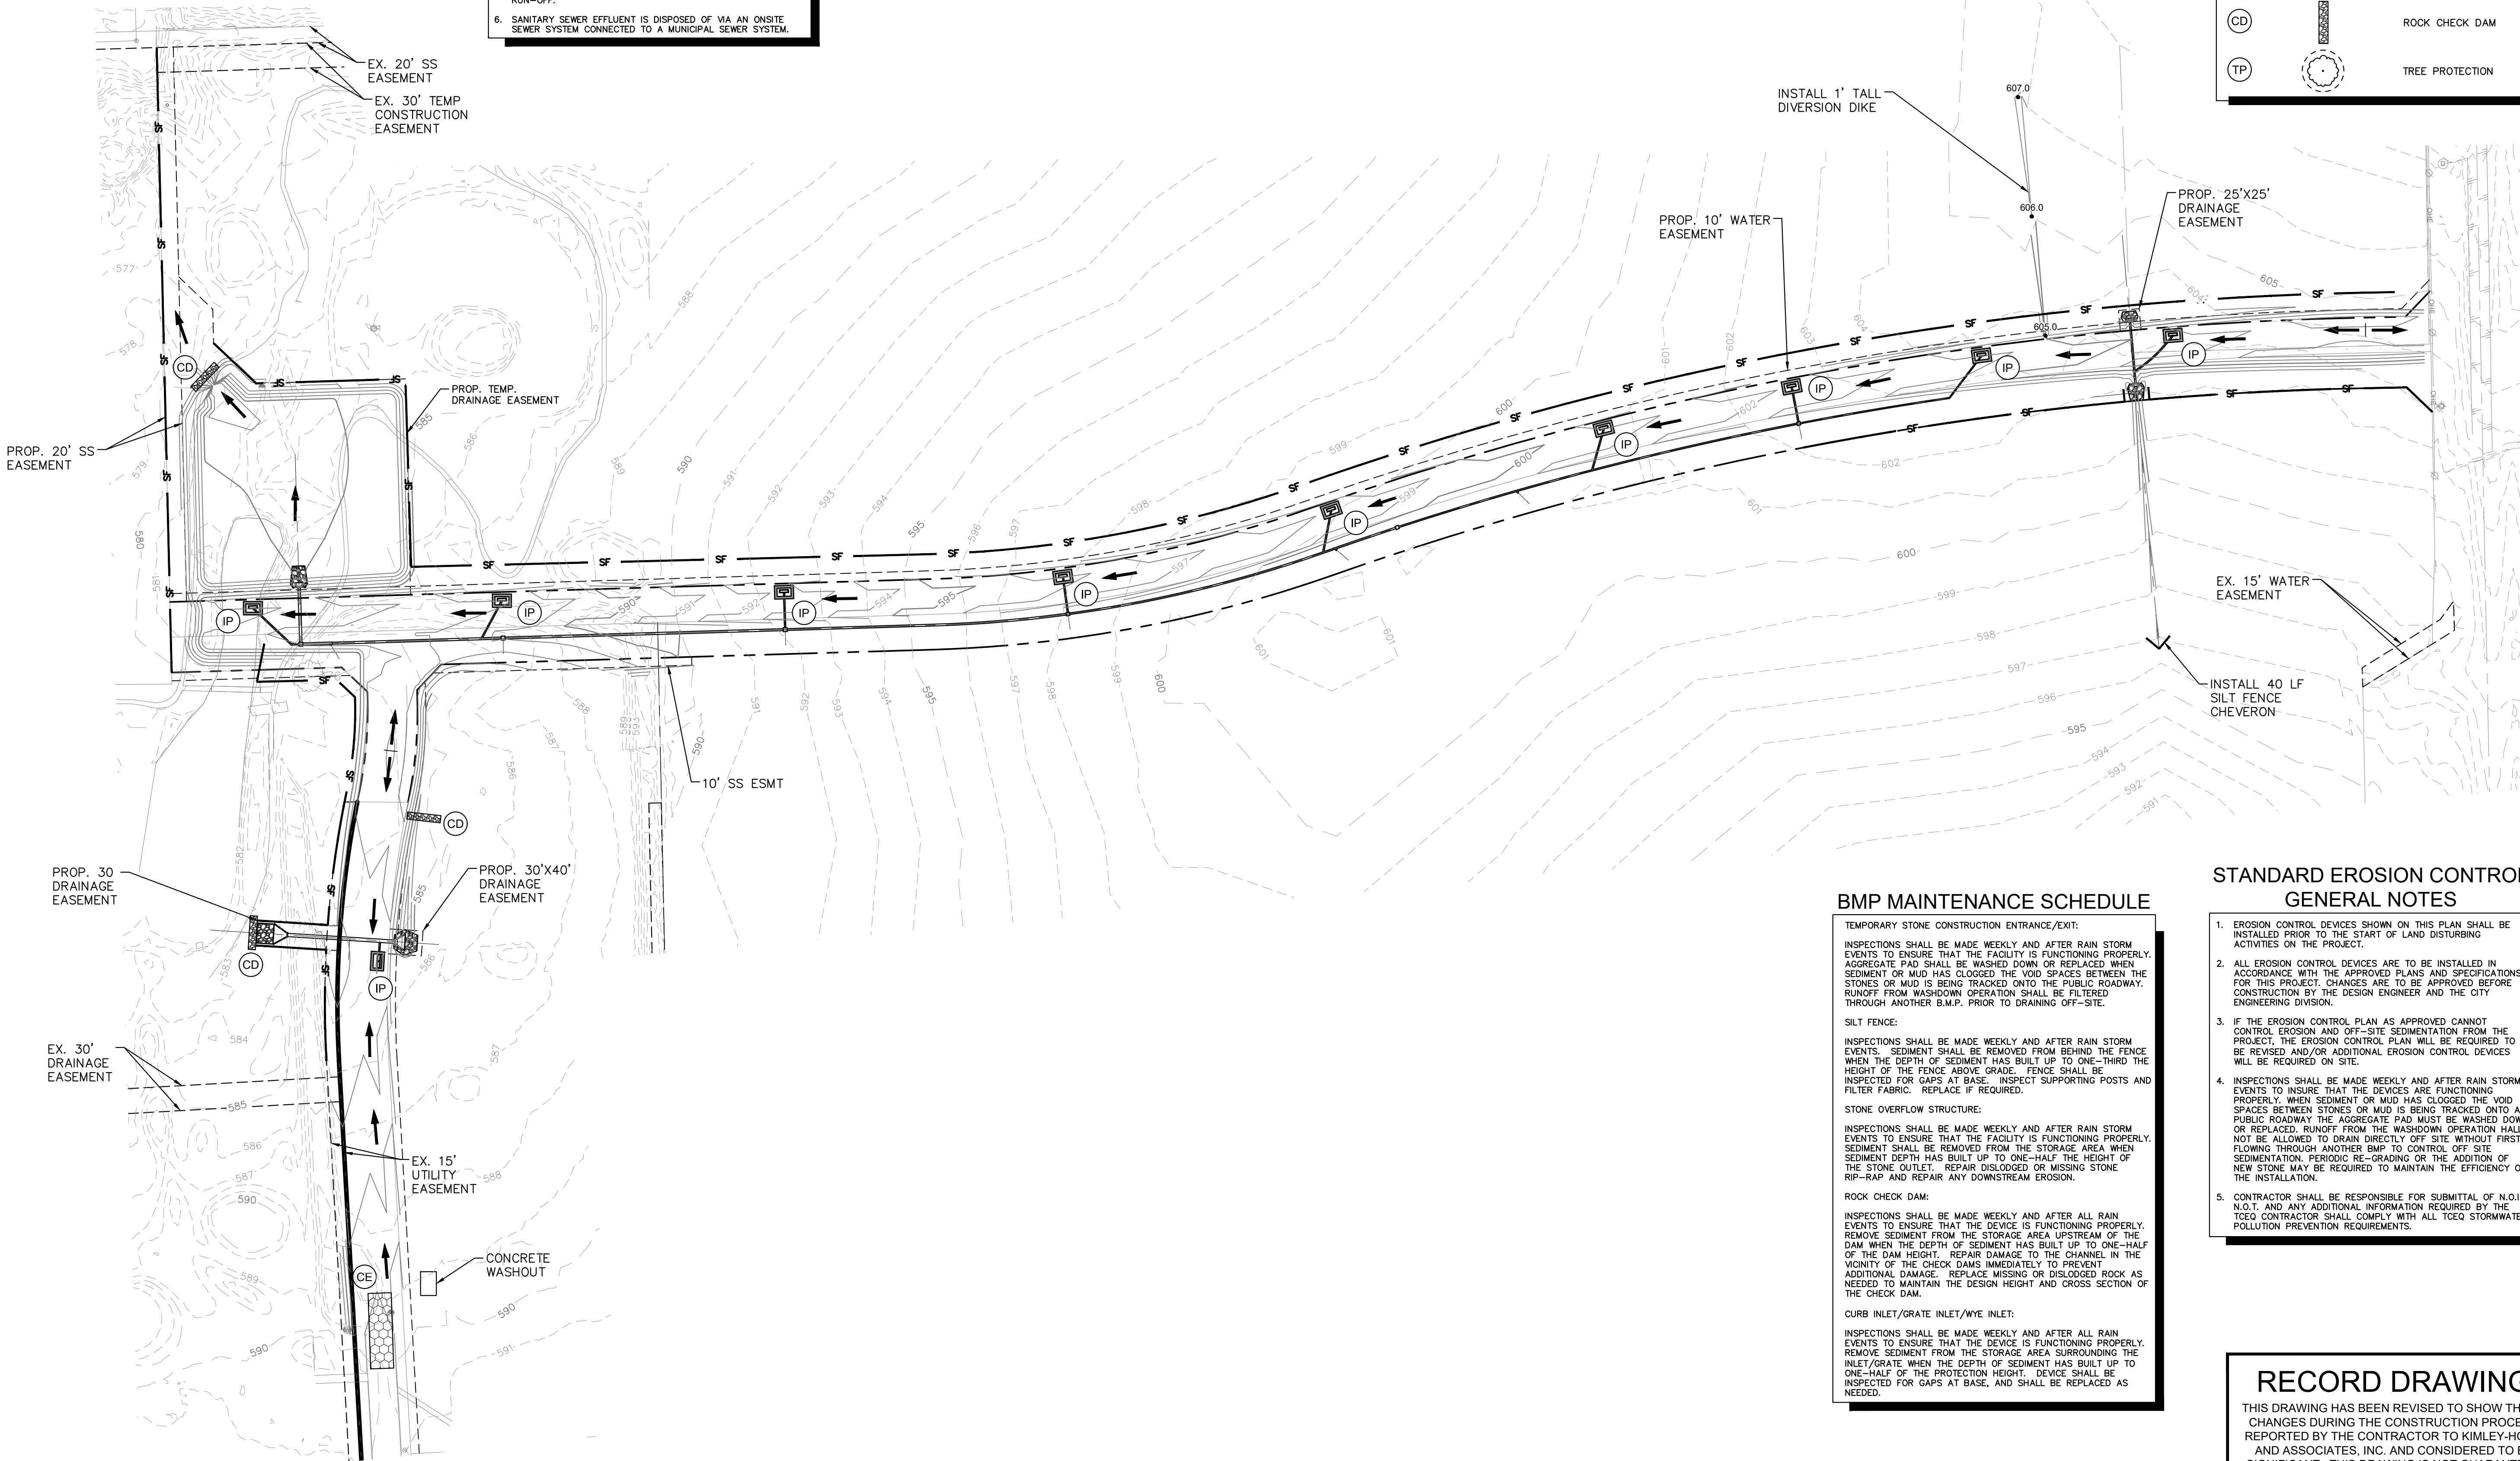
- KEEP ALL STORM WATER POLLUTION PREVENTION MEASURES IN PLACE. REMOVE AS NEEDED TO PAVE.
- STABILIZE SUBGRADE.
- PAVE STREETS AND SIDEWALKS AS SPECIFIED ON PLAN SHEETS.
- RE-INSTALL ANY STORM WATER POLLUTION PREVENTION MEASURES REMOVED FOR PAVING OPERATIONS.

PHASE D - LANDSCAPING AND SOIL STABILIZATION

- REVEGETATE LOT AND PARKWAYS.
- LANDSCAPE CONTRACTOR SHALL REVEGETATE ALL AREAS RESERVED FOR LANDSCAPE VEGETATIVE COVERS.
- REMOVE EROSION CONTROL DEVICES WHEN MINIMUM 70% GROUND COVER IS ESTABLISHED. VEGETATION MUST BE ESTABLISHED BEFORE STRUCTURAL CONTROLS REMOVED.

EROSION CONTROL LEGEND

- PROPOSED CONTOUR
- EXISTING CONTOUR
- HIGH POINT
- SWALE
- CX
- CURLEX
- SEEDED HAY MAT
- SF
- SILT FENCE
- LD
- LIMITS OF DISTURBANCE
- CE
- CONSTRUCTION ENTRANCE/EXIT
- IP
- INLET PROTECTION
- CD
- ROCK CHECK DAM
- TP
- TREE PROTECTION



BMP MAINTENANCE SCHEDULE

TEMPORARY STONE CONSTRUCTION ENTRANCE/EXIT:

INSPECTIONS SHALL BE MADE WEEKLY AND AFTER RAIN STORM EVENTS TO ENSURE THAT THE FACILITY IS FUNCTIONING PROPERLY. AGGREGATE PAD SHALL BE WASHED DOWN OR REPLACED WHEN SEDIMENT OR MUD HAS CLOGGED THE VOID SPACES BETWEEN THE STONES OR MUD IS BEING TRACKED ONTO THE PUBLIC ROADWAY. RUNOFF FROM WASHDOWN OPERATION SHALL BE FILTERED THROUGH ANOTHER B.M.P. PRIOR TO DRAINING OFF-SITE.

SILT FENCE:

INSPECTIONS SHALL BE MADE WEEKLY AND AFTER RAIN STORM EVENTS. SEDIMENT SHALL BE REMOVED FROM BEHIND THE FENCE WHEN THE DEPTH OF SEDIMENT HAS BUILT UP TO ONE-THIRD THE HEIGHT OF THE FENCE ABOVE GRADE. FENCE SHALL BE INSPECTED FOR GAPS AT BASE. INSPECT SUPPORTING POSTS AND FILTER FABRIC. REPLACE IF REQUIRED.

STONE OVERFLOW STRUCTURE:

INSPECTIONS SHALL BE MADE WEEKLY AND AFTER RAIN STORM EVENTS TO ENSURE THAT THE DEVICE IS FUNCTIONING PROPERLY. WHEN SEDIMENT OR MUD HAS CLOGGED THE VOID SPACES BETWEEN STONES OR MUD IS BEING TRACKED ONTO A PUBLIC ROADWAY THE AGGREGATE PAD MUST BE WASHED DOWN OR REPLACED. RUNOFF FROM THE WASHDOWN OPERATION SHALL NOT BE ALLOWED TO DRAIN DIRECTLY OFF SITE WITHOUT FIRST FLOWING THROUGH ANOTHER BMP TO CONTROL OFF SITE SEDIMENTATION. PERIODIC RE-GRADING OR THE ADDITION OF NEW STONE MAY BE REQUIRED TO MAINTAIN THE EFFECTIVENESS OF THE INSTALLATION.

ROCK CHECK DAM:

INSPECTIONS SHALL BE MADE WEEKLY AND AFTER ALL RAIN EVENTS TO ENSURE THAT THE DEVICE IS FUNCTIONING PROPERLY. REMOVE SEDIMENT FROM THE STORAGE AREA UPSTREAM OF THE DAM WHEN THE DEPTH OF SEDIMENT HAS BUILT UP TO ONE-HALF OF THE DAM HEIGHT. REPAIR DAMAGE TO THE CHANNEL IN THE VICINITY OF THE CHECK DAMS IMMEDIATELY TO PREVENT ADDITIONAL DAMAGE. REPLACE MISSING OR DISLODGED ROCK AS NEEDED TO MAINTAIN THE DESIGN HEIGHT AND CROSS SECTION OF THE CHECK DAM.

CURB INLET/GRATE INLET/WYE INLET:

INSPECTIONS SHALL BE MADE WEEKLY AND AFTER ALL RAIN EVENTS TO ENSURE THAT THE DEVICE IS FUNCTIONING PROPERLY. REMOVE SEDIMENT FROM THE STORAGE AREA SURROUNDING THE INLET/GRATE WHEN THE DEPTH OF SEDIMENT HAS BUILT UP TO ONE-HALF OF THE PROTECTION HEIGHT. DEVICE SHALL BE INSPECTED FOR GAPS AT BASE, AND SHALL BE REPLACED AS NEEDED.

STANDARD EROSION CONTROL GENERAL NOTES

- EROSION CONTROL DEVICES SHOWN ON THIS PLAN SHALL BE INSTALLED PRIOR TO THE START OF LAND DISTURBING ACTIVITIES ON THE PROJECT.
- ALL EROSION CONTROL DEVICES ARE TO BE INSTALLED IN ACCORDANCE WITH THE APPROVED PLANS AND SPECIFICATIONS FOR THIS PROJECT. CHANGES ARE TO BE APPROVED BEFORE CONSTRUCTION BY THE DESIGN ENGINEER AND THE CITY ENGINEERING DIVISION.
- IF THE EROSION CONTROL PLAN AS APPROVED CANNOT CONTROL EROSION AND OFF-SITE SEDIMENTATION FROM THE PROJECT, THE EROSION CONTROL PLAN WILL BE REQUIRED TO BE REVISED AND/OR ADDITIONAL EROSION CONTROL DEVICES WILL BE REQUIRED ON SITE.
- INSPECTIONS SHALL BE MADE WEEKLY AND AFTER RAIN STORM EVENTS TO INSURE THAT THE DEVICES ARE FUNCTIONING PROPERLY. WHEN SEDIMENT OR MUD HAS CLOGGED THE VOID SPACES BETWEEN STONES OR MUD IS BEING TRACKED ONTO A PUBLIC ROADWAY THE AGGREGATE PAD MUST BE WASHED DOWN OR REPLACED. RUNOFF FROM THE WASHDOWN OPERATION SHALL NOT BE ALLOWED TO DRAIN DIRECTLY OFF SITE WITHOUT FIRST FLOWING THROUGH ANOTHER BMP TO CONTROL OFF SITE SEDIMENTATION. PERIODIC RE-GRADING OR THE ADDITION OF NEW STONE MAY BE REQUIRED TO MAINTAIN THE EFFECTIVENESS OF THE INSTALLATION.
- CONTRACTOR SHALL BE RESPONSIBLE FOR SUBMITTAL OF N.O.I., N.O.T. AND ANY ADDITIONAL INFORMATION REQUIRED BY THE TCEQ CONTRACTOR SHALL COMPLY WITH ALL TCEQ STORMWATER POLLUTION PREVENTION REQUIREMENTS.


RECORD DRAWING

THIS DRAWING HAS BEEN REVISED TO SHOW THOSE CHANGES DURING THE CONSTRUCTION PROCESS REPORTED BY THE CONTRACTOR TO KIMLEY-HORN AND ASSOCIATES, INC. AND CONSIDERED TO BE SIGNIFICANT. THIS DRAWING IS NOT GUARANTEED TO BE "AS BUILT" BUT IS BASED ON THE INFORMATION MADE AVAILABLE.

DATE: 01/08/2021 BY: ANTHONY LOEFFEL, P.E.

Kimley»Horn

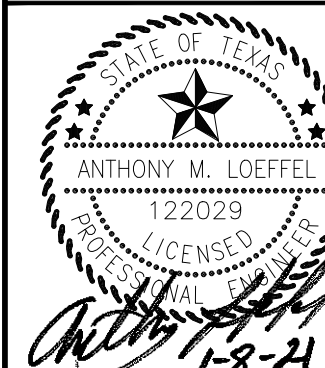© 2021 KIMLEY-HORN AND ASSOCIATES, INC.
400 N. OKLAHOMA DRIVE, SUITE 05, CELINA, TX 75009
PHONE: 469-501-2200
WWW.KIMLEY-HORN.COM



KHA PROJECT	063234203
DATE	MARCH 2020
SCALE	AS SHOWN
DESIGNED BY:	AVL
DRAWN BY:	XXX
CHECKED BY:	BLM

EROSION CONTROL PLAN

JUSTIN RD & CONVEYOR'S ST
EXTENSION
CITY OF ROCKWALL
ROCKWALL COUNTY, TEXAS


SHEET NUMBER

C-26


BY	
DATE	
REVISIONS	
No.	

Plotted By: Loeffel, Anthony, Date: January 08, 2021 11:34:06am File Path: K:\DEL_Civil\063234203-Rockwall - Commercial Rwy\Cod\PlanSheets\CE-Erosion Control Plan.dwg

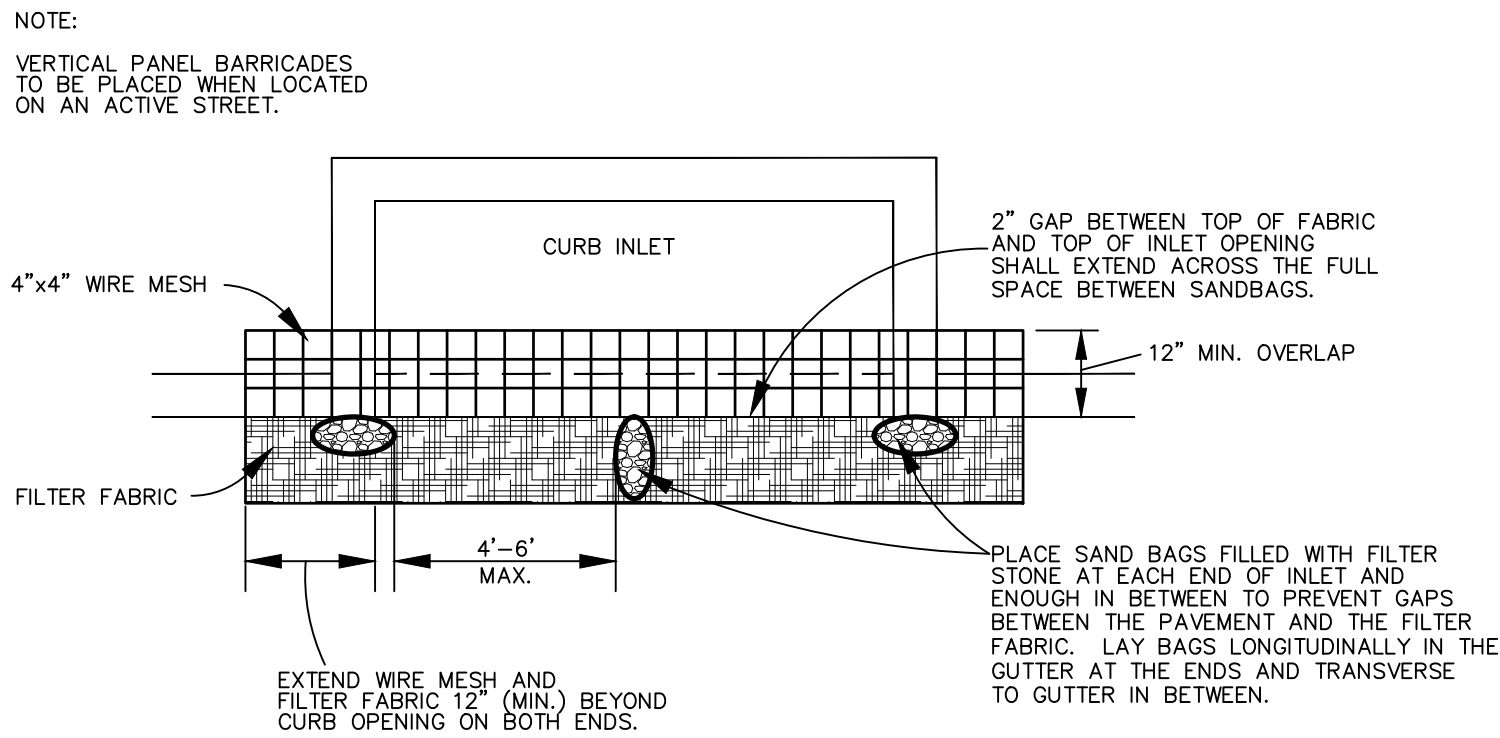This document, together with the concepts and designs presented herein, as an instrument of service, is intended only for the specific purpose and client for which it was prepared. Reuse of and improper reliance on this document without written authorization and adaptation by Kimley-Horn and Associates, Inc. shall be without liability to Kimley-Horn and Associates, Inc.




INLET PLAN VIEW

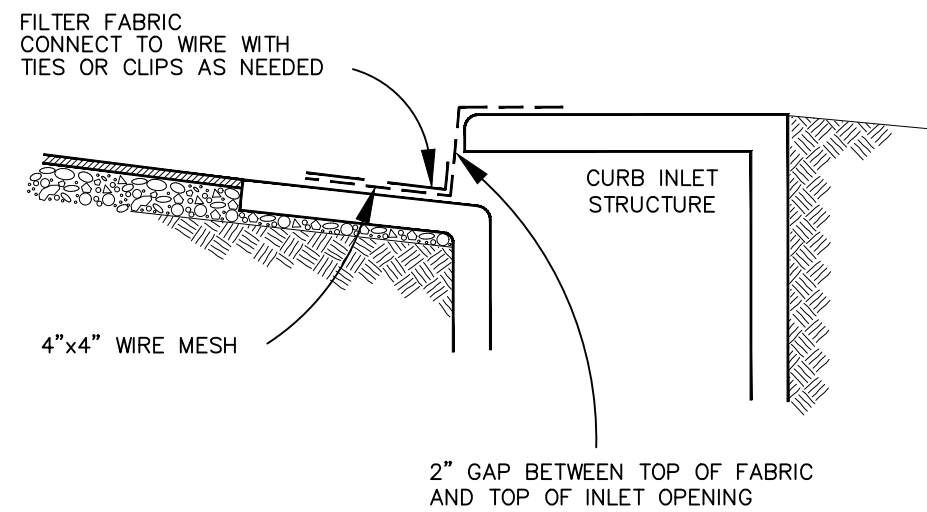


INLET SECTION

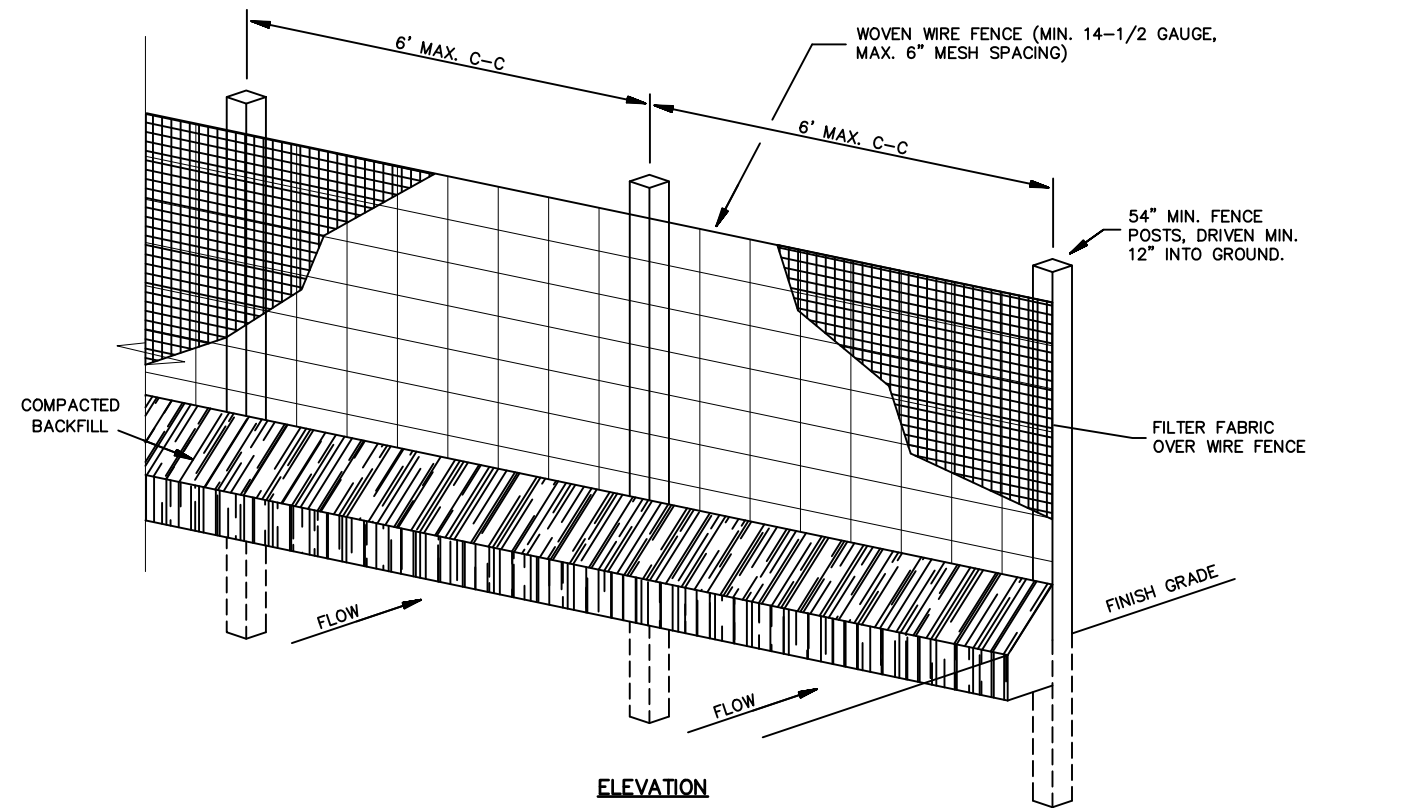IP CURB INLET PROTECTION
N.T.S.




ELEVATION

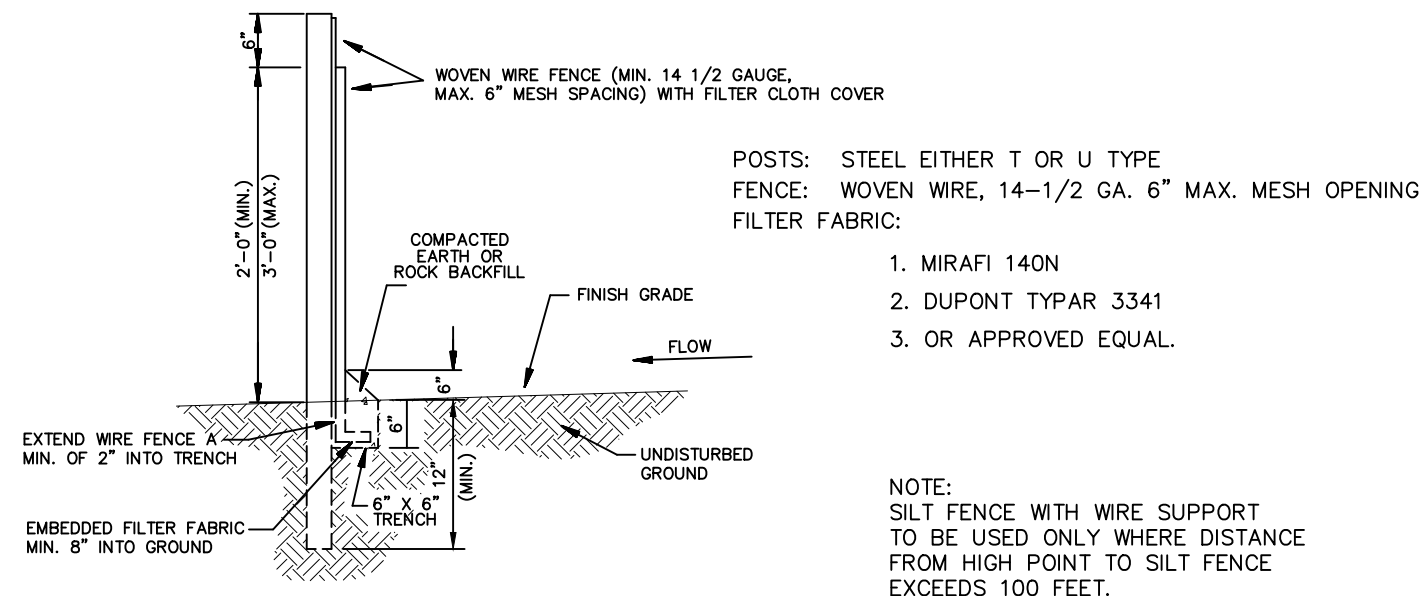

CROSS-SECTION

SF SEDIMENTATION/SILT FENCE WITH WIRE SUPPORT
N.T.S.

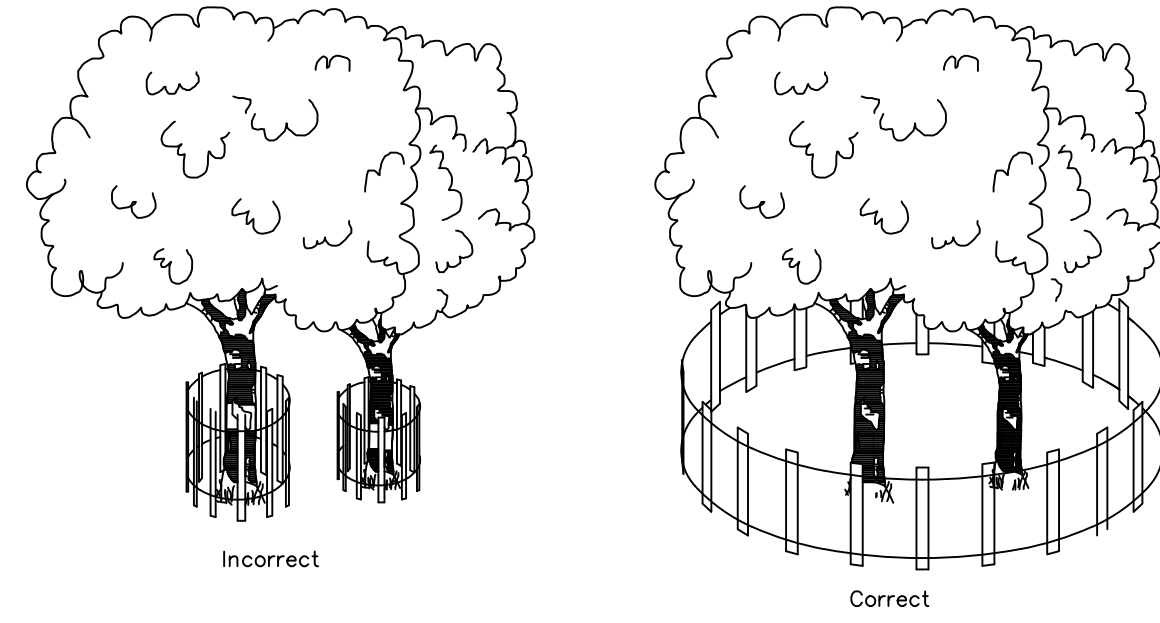NOTES:
IN SPITE OF PRECAUTIONS, SOME DAMAGE TO PROTECTED TREES MAY OCCUR. IN SUCH CASES REPAIR ANY DAMAGE TO THE CROWN, TRUNK OR ROOT SYSTEM IMMEDIATELY.
- REPAIR ROOTS BY CUTTING OFF THE DAMAGED AREAS AND PAINTING THEM WITH TREE PAINT. SPREAD PEAT MOSS OR MOIST TOPSOIL OVER EXPOSED ROOTS.
- REPAIR DAMAGE TO BARK BY TRIMMING AROUND THE DAMAGED AREAS, TAPER THE CUT TO PROVIDE DRAINAGE, AND PAINT WITH TREE PAINT.
- CUT OFF ALL DAMAGED TREE LIMBS ABOVE THE TREE COLLAR AT THE TRUNK OR MAIN BRANCH. USE THREE SEPARATE CUTS TO AVOID 'HEELING' BARK FROM HEALTHY AREAS OF THE TREE.




Incorrect


Correct

BARRIER SHOULD BE INSTALLED AT THE DRIP
LINE OF TREE BRANCHES

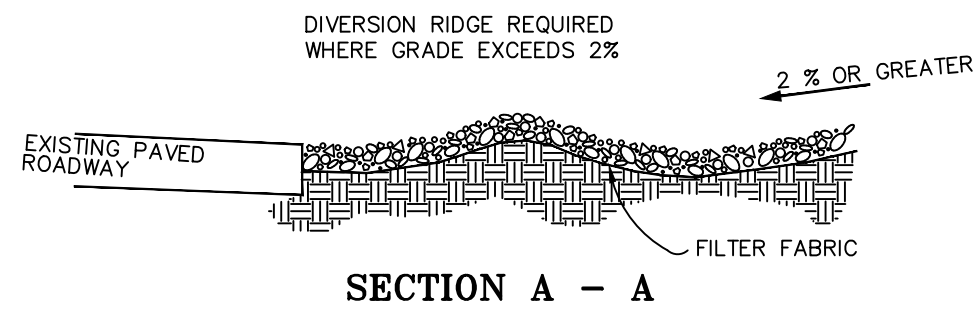
TP TREE PROTECTION
N.T.S.




SECTION A - A

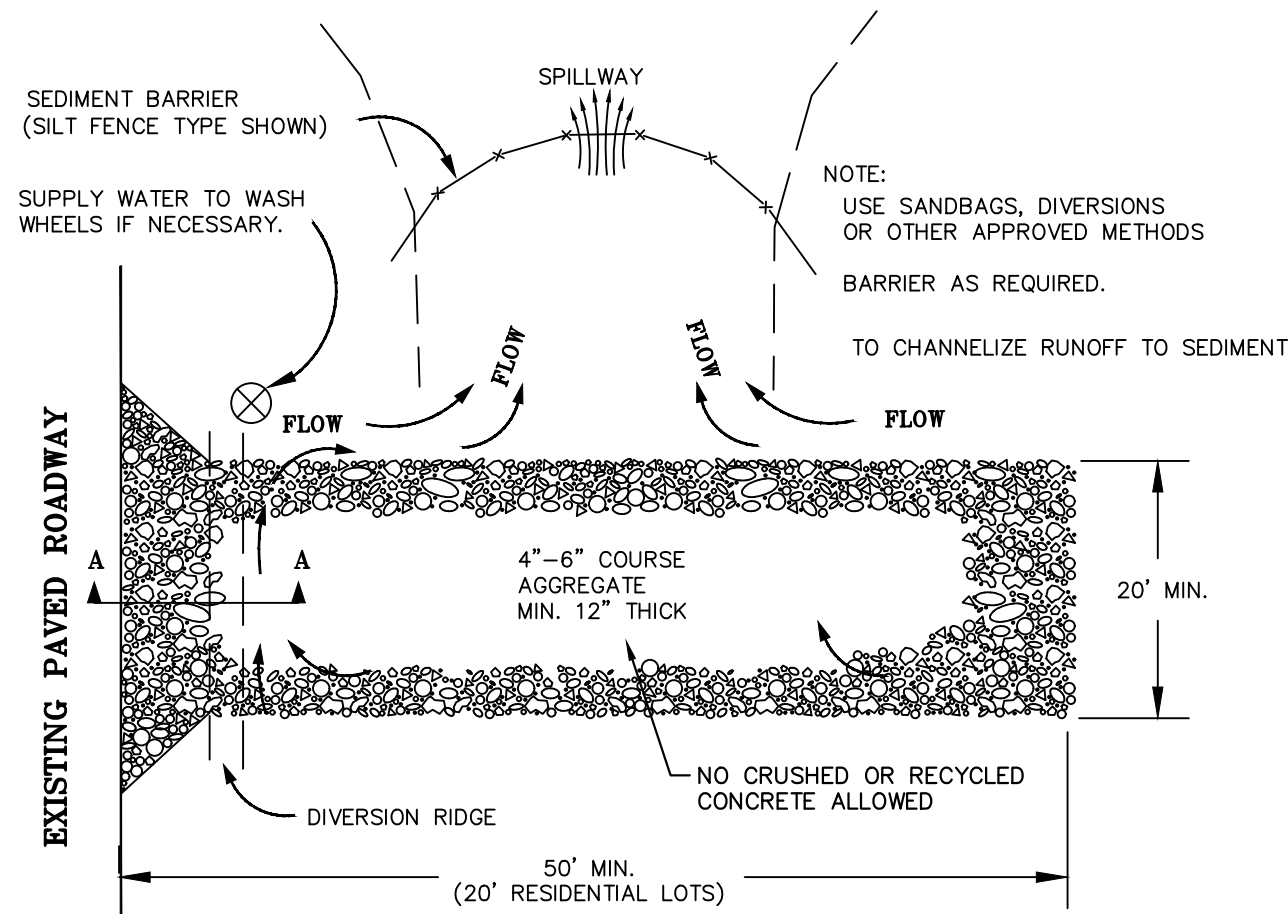

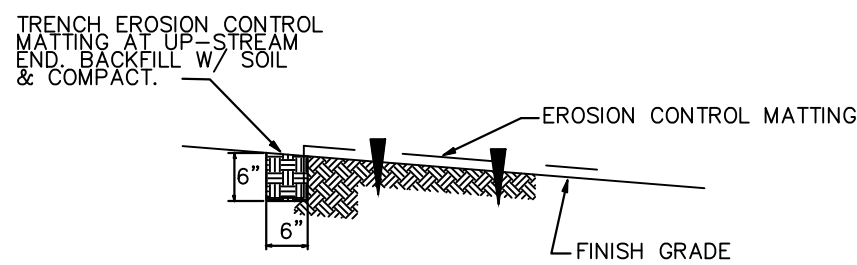**CE TEMPORARY STONE CONSTRUCTION
ENTRANCE / EXIT**
N.T.S.




UPSTREAM ANCHORING

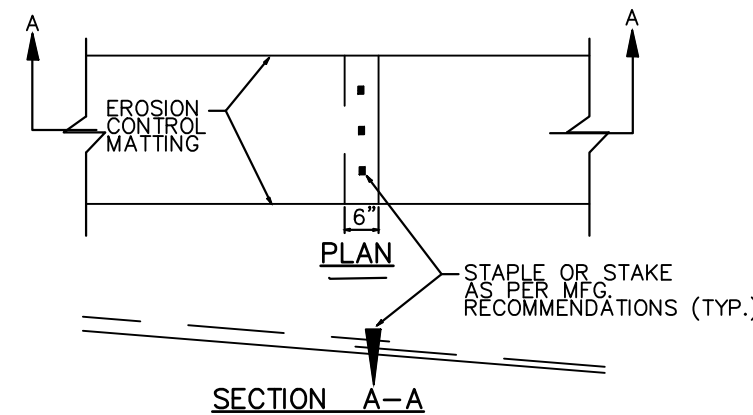


TYPICAL JOINT OVERLAP

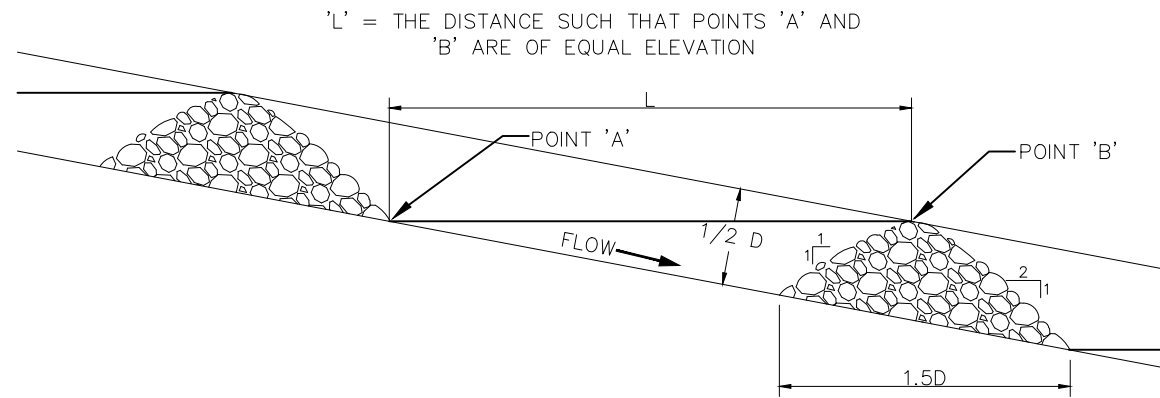
CX EROSION CONTROL MATTING (CURLEX)
N.T.S.



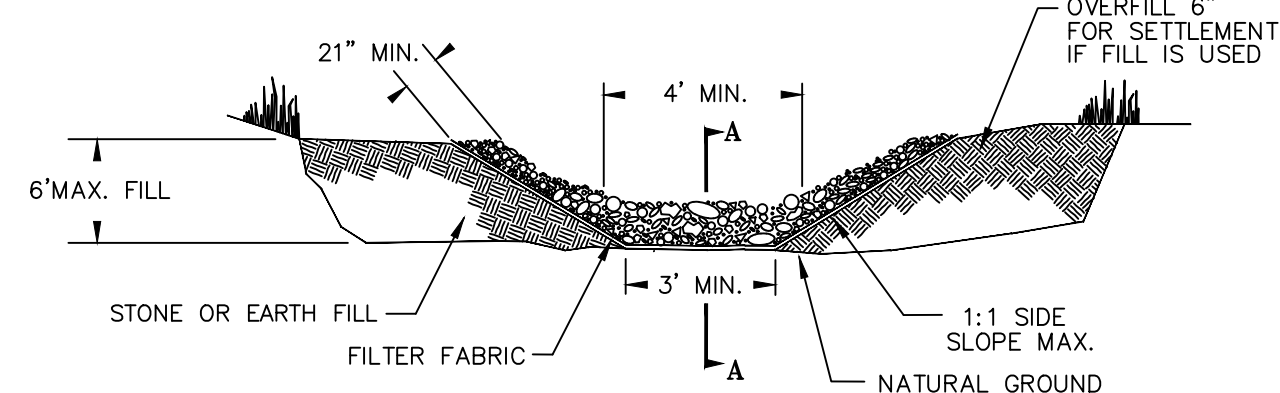SECTION A - A AND SPACING BETWEEN CHECK DAMS



VIEW LOOKING UPSTREAM

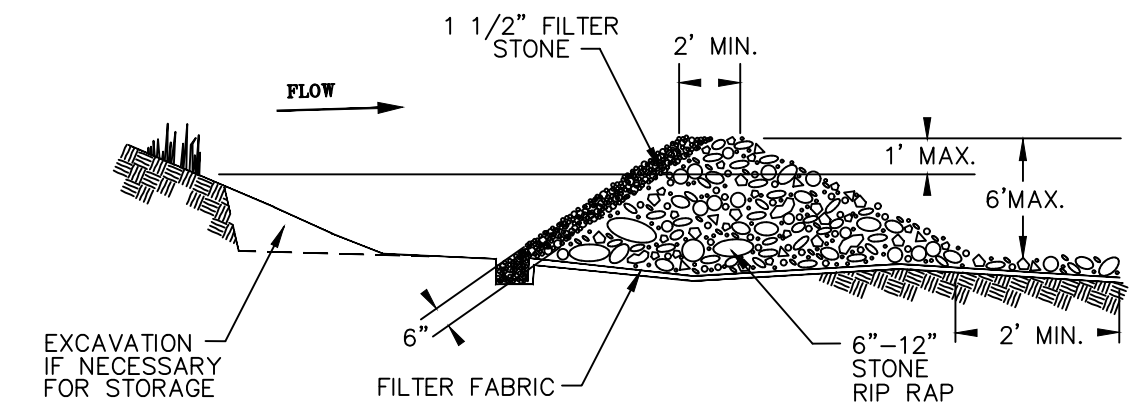

SECTION

RC ROCK CHECK DAM
N.T.S.

RECORD DRAWING

THIS DRAWING HAS BEEN REVISED TO SHOW THOSE CHANGES DURING THE CONSTRUCTION PROCESS REPORTED BY THE CONTRACTOR TO KIMLEY-HORN AND ASSOCIATES, INC. AND CONSIDERED TO BE SIGNIFICANT. THIS DRAWING IS NOT GUARANTEED TO BE "AS BUILT" BUT IS BASED ON THE INFORMATION MADE AVAILABLE.

DATE: 01/08/2021 BY: ANTHONY LOEFFEL, P.E.

NO.	REVISIONS	DATE	BY

Kimley»Horn

© 2021 KIMLEY-HORN AND ASSOCIATES, INC.
400 N. OKLAHOMA DRIVE, SUITE 05, CELINA, TX 75009
PHONE: 469-501-2200
WWW.KIMLEY-HORN.COM

TEXAS REGISTERED ENGINEERING FIRM F-928

KHA PROJECT 063234203	DATE MARCH 2020	SCALE: AS SHOWN	DESIGNED BY: AVL	DRAWN BY: XXX	CHECKED BY: BLM
ANTHONY M. LOEFFEL 122029 LICENSED 1-8-21					

EROSION CONTROL DETAILS

JUSTIN RD & CONVEYOR'S ST
EXTENSION
CITY OF ROCKWALL
ROCKWALL COUNTY, TEXAS

SHEET NUMBER

C-27