




TOCS
1-800-245-4545
tdticket@1-call.com

GRAPHIC SCALE

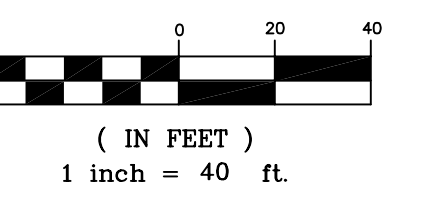

LEGEND

- 5" CONCRETE PAVING (3,600 PSI W/ COMPACTED SUBGRADE)
- 6" CONCRETE PAVING (3,600 PSI W/ LIME TREATED SUBGRADE - 5 SACK MIN. FOR MACHINE PLACED - 6.5 SACK MIN. FOR HAND PLACED)
- 7" CONCRETE PAVING (3,600 PSI W/ LIME TREATED SUBGRADE)
- STRIPING/MARKING "NO PARKING"

NOTE: REFER TO GEOTECHNICAL ENGINEERING REPORT (RONE ENGINEERING NO. 07-13883) FOR PAVING SECTION DETAILS AND SUBGRADE REQUIREMENTS. IN LIEU OF LIME TREATMENT OF PAVING SUBGRADE, THE CONCRETE SECTIONS MAY BE INCREASED BY 1-INCH AND LIME TREATMENT MAY BE OMITTED (PER REPORT).

R RADIUS

(5) PARKING SPACE COUNT

SCREENING WALL


TYPICAL DUMPSTER LAYOUT

PROPOSED RETAINING WALL

NOTES:

1. ALL DIMENSIONS ARE TO FACE OF CURB WHERE CURB IS PRESENT
2. ALL DIMENSIONS ARE APPROXIMATE AND SUBJECT TO ADJUSTMENT
3. ALL FIRELANE WIDTHS ARE 24' WITH 20' RADII FOR THE MULTI-FAMILY SITE AND 24' WITH 39' RADII FOR THE AGE-RESTRICTED MULTI-FAMILY SITE.
4. ALL OTHER RADII ARE 3' UNLESS NOTED OTHERWISE
5. ALL PARKING SPACES ARE 9'X18'

RECORD DRAWING
RECORD INFORMATION PROVIDED BY
CONASTER CONSTRUCTION, FORT WORTH, TEXAS
ELEVATION VERIFICATION PERFORMED BY
SURVEY CONSULTANTS, INC., PLANO, TEXAS

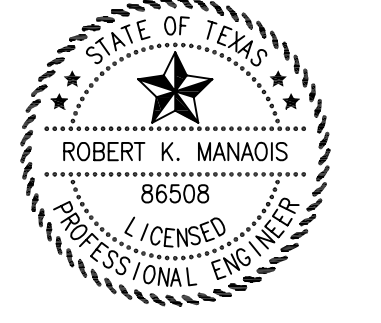

| REV. | DATE | REMARKS | BY |
|------|------|---------|----|
| | | | |
| | | | |

DIMENSION CONTROL & PAVING PLAN

MANSIONS FAMILY
CITY OF ROCKWALL, TEXAS

RKM Consulting Engineers, Inc.
7616 LBJ Freeway, Suite 530
Dallas, Texas 75251
phone (214) 432-8070
fax (214) 432-8069
Form No. 5/2/2007

| CHECKED | DESIGN | DRAWN | JOB | DATE | SCALE | SHEET |
|---------|--------|-------|----------|----------|--------|----------|
| RKM | JRY | JRY | 1026-005 | 05/27/09 | 1"=40' | 4 |

OF 33

