


NOTES:
 1. CONTRACTOR TO ADJUST PROPOSED MANHOLE RIM ELEVATION TO MATCH PROPOSED FINISHED GRADE.
 2. ALL SANITARY SEWER MANHOLES TO BE SEALED.

RECORD INFORMATION PROVIDED BY
 CONSTAR CONSTRUCTION, FORT WORTH, TEXAS
 ELEVATION VERIFICATION PERFORMED BY
 SURVEY CONSULTANTS, INC., PLANO, TEXAS

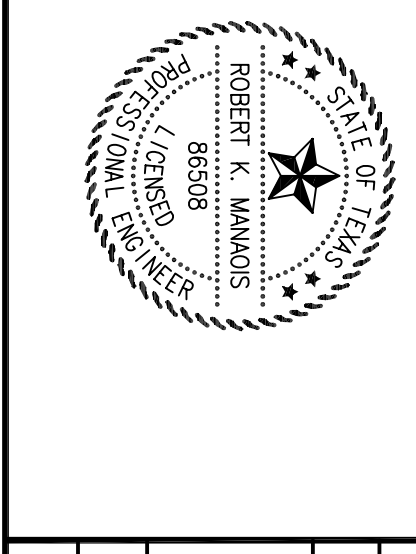

RKM Consulting Engineers, Inc.
 7616 EBI Freeway, Suite 500
 Dallas, Texas 75231
 Phone (214) 432-8070
 Fax (214) 432-8069
 www.rkm.com

CITY OF ROCKWALL, TEXAS
MANSIONS FAMILY
SANITARY SEWER PROFILES

CHECKED	DESIGN	DRAWN	JOB	DATE	SCALE	SHEET
RKM	JRY	JRY	1026-005	05/27/09	1"=40' (H) 1"=4' (V)	27 OF 33