

- 2" VALVE
- 2" IRRIGATION METER

12"X8" TEE
- 8" PLUG
2" METER

2 - 8" 45° BENDS

3 - VALVES

VALVE

AS-BUILT LEGEND
FUTURE

DISCLAIMER
TO THE BEST OF OUR KNOWLEDGE, THE WALLACE GROUP, INC. HEREBY STATES THAT THIS PLAN IS AS-BUILT/RECORD DRAWINGS. THE INFORMATION PROVIDED IS BASED ON SURVEYING CONDUCTED AT THE SITE AND INFORMATION PROVIDED BY THE CONTRACTOR.

CONTRACTOR TO EXPOSE APPROXIMATELY 80' OF EXISTING 12" WATERLINE AND RAISE TO ALLOW PROPOSED 12" CONNECTION OVER 6X3 RCB WITHOUT 90 ELBOW

INSTALL:
1-12"X6" TEE
1-12" VALVE
1-6" VALVE
1-FIRE HYDRANT


INSTALL:
1-12"-45° BEND

INSTALL:
1-12"X12" TAPPING SLEEVE
2-12" VALVE

CONTRACTOR TO RECONNECT EXISTING 12" WATERLINE WITH TWO 45 DEGREE VERTICAL BENDS ONCE RAISING HAS BEEN ACCOMPLISHED.

NOTE-CONTRACTOR SHALL ENSURE WHEN EXISTING WATER LINE HAS BEEN RAISED THERE IS A MINIMUM 4' OF COVER OVER THE PIPE.

REV	DATE	BY	DESCRIPTION
1	6-8-07	MM	Revised 8" Fire line and 2" Domestic Service to Staples
2	5-25-07	RS3	Revised 8" Fire line and 2" Domestic Service to Staples
3	3-30-07	MM	Revised existing waterline on Rough Hill to get over proposed 6'X3' RCB
4	2-19-07	RS3	Revised utility service connections & removed fire hydrants

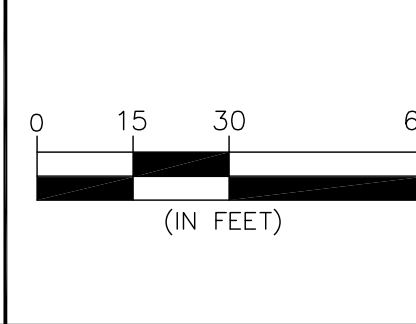

DESIGNED: _____
DRAWN: _____
CHECKED: _____

"THE SEAL APPEARING ON THIS DOCUMENT WAS AUTHORIZED BY MATTHEW D. MORGAN, P.E. # 96329 ON THE DATE SHOWN ON THE DAYSTAMP. ALTERATION OF A SEALED DOCUMENT WITHOUT PROPER NOTIFICATION TO THE RESPONSIBLE ENGINEER IS AN OFFENSE UNDER THE TEXAS ENGINEERING PRACTICE ACT"

ENGINEERS ARCHITECTS SURVEYORS PLANNERS
THE WALLACE GROUP INC.

THE WOODMONT COMPANY
PLAZA AT ROCKWALL
UTILITY PLAN C

SHEET 24
C4.3
OF 56 SHEETS