


appr. by:
 drawn by:
 date: 09-30-04

revisions
10-14-04
10-29-04
04-12-05
05-02-05
05-19-05
6/15/06-15-05

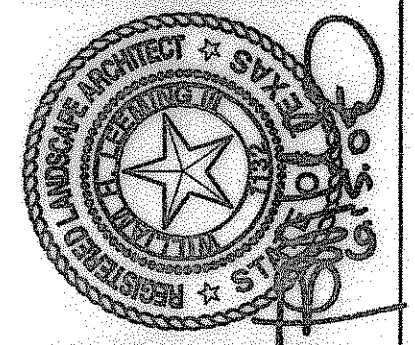

Leeming Design Group
 Landscape Architecture
 P.O. Box 153393 Fort Worth, Texas 76155
 972.264.8060
 972.263.0005


SITE LANDSCAPE

ROCKWALL M.O.B.
 RALPH HALL PARKWAY
 ROCKWALL, TEXAS

file name:
 c:\rockwall\mobs\phase2\10\p3\2-base\FULL.dwg

north
 scale: 1" = 20'-0"

sheet
 P-3

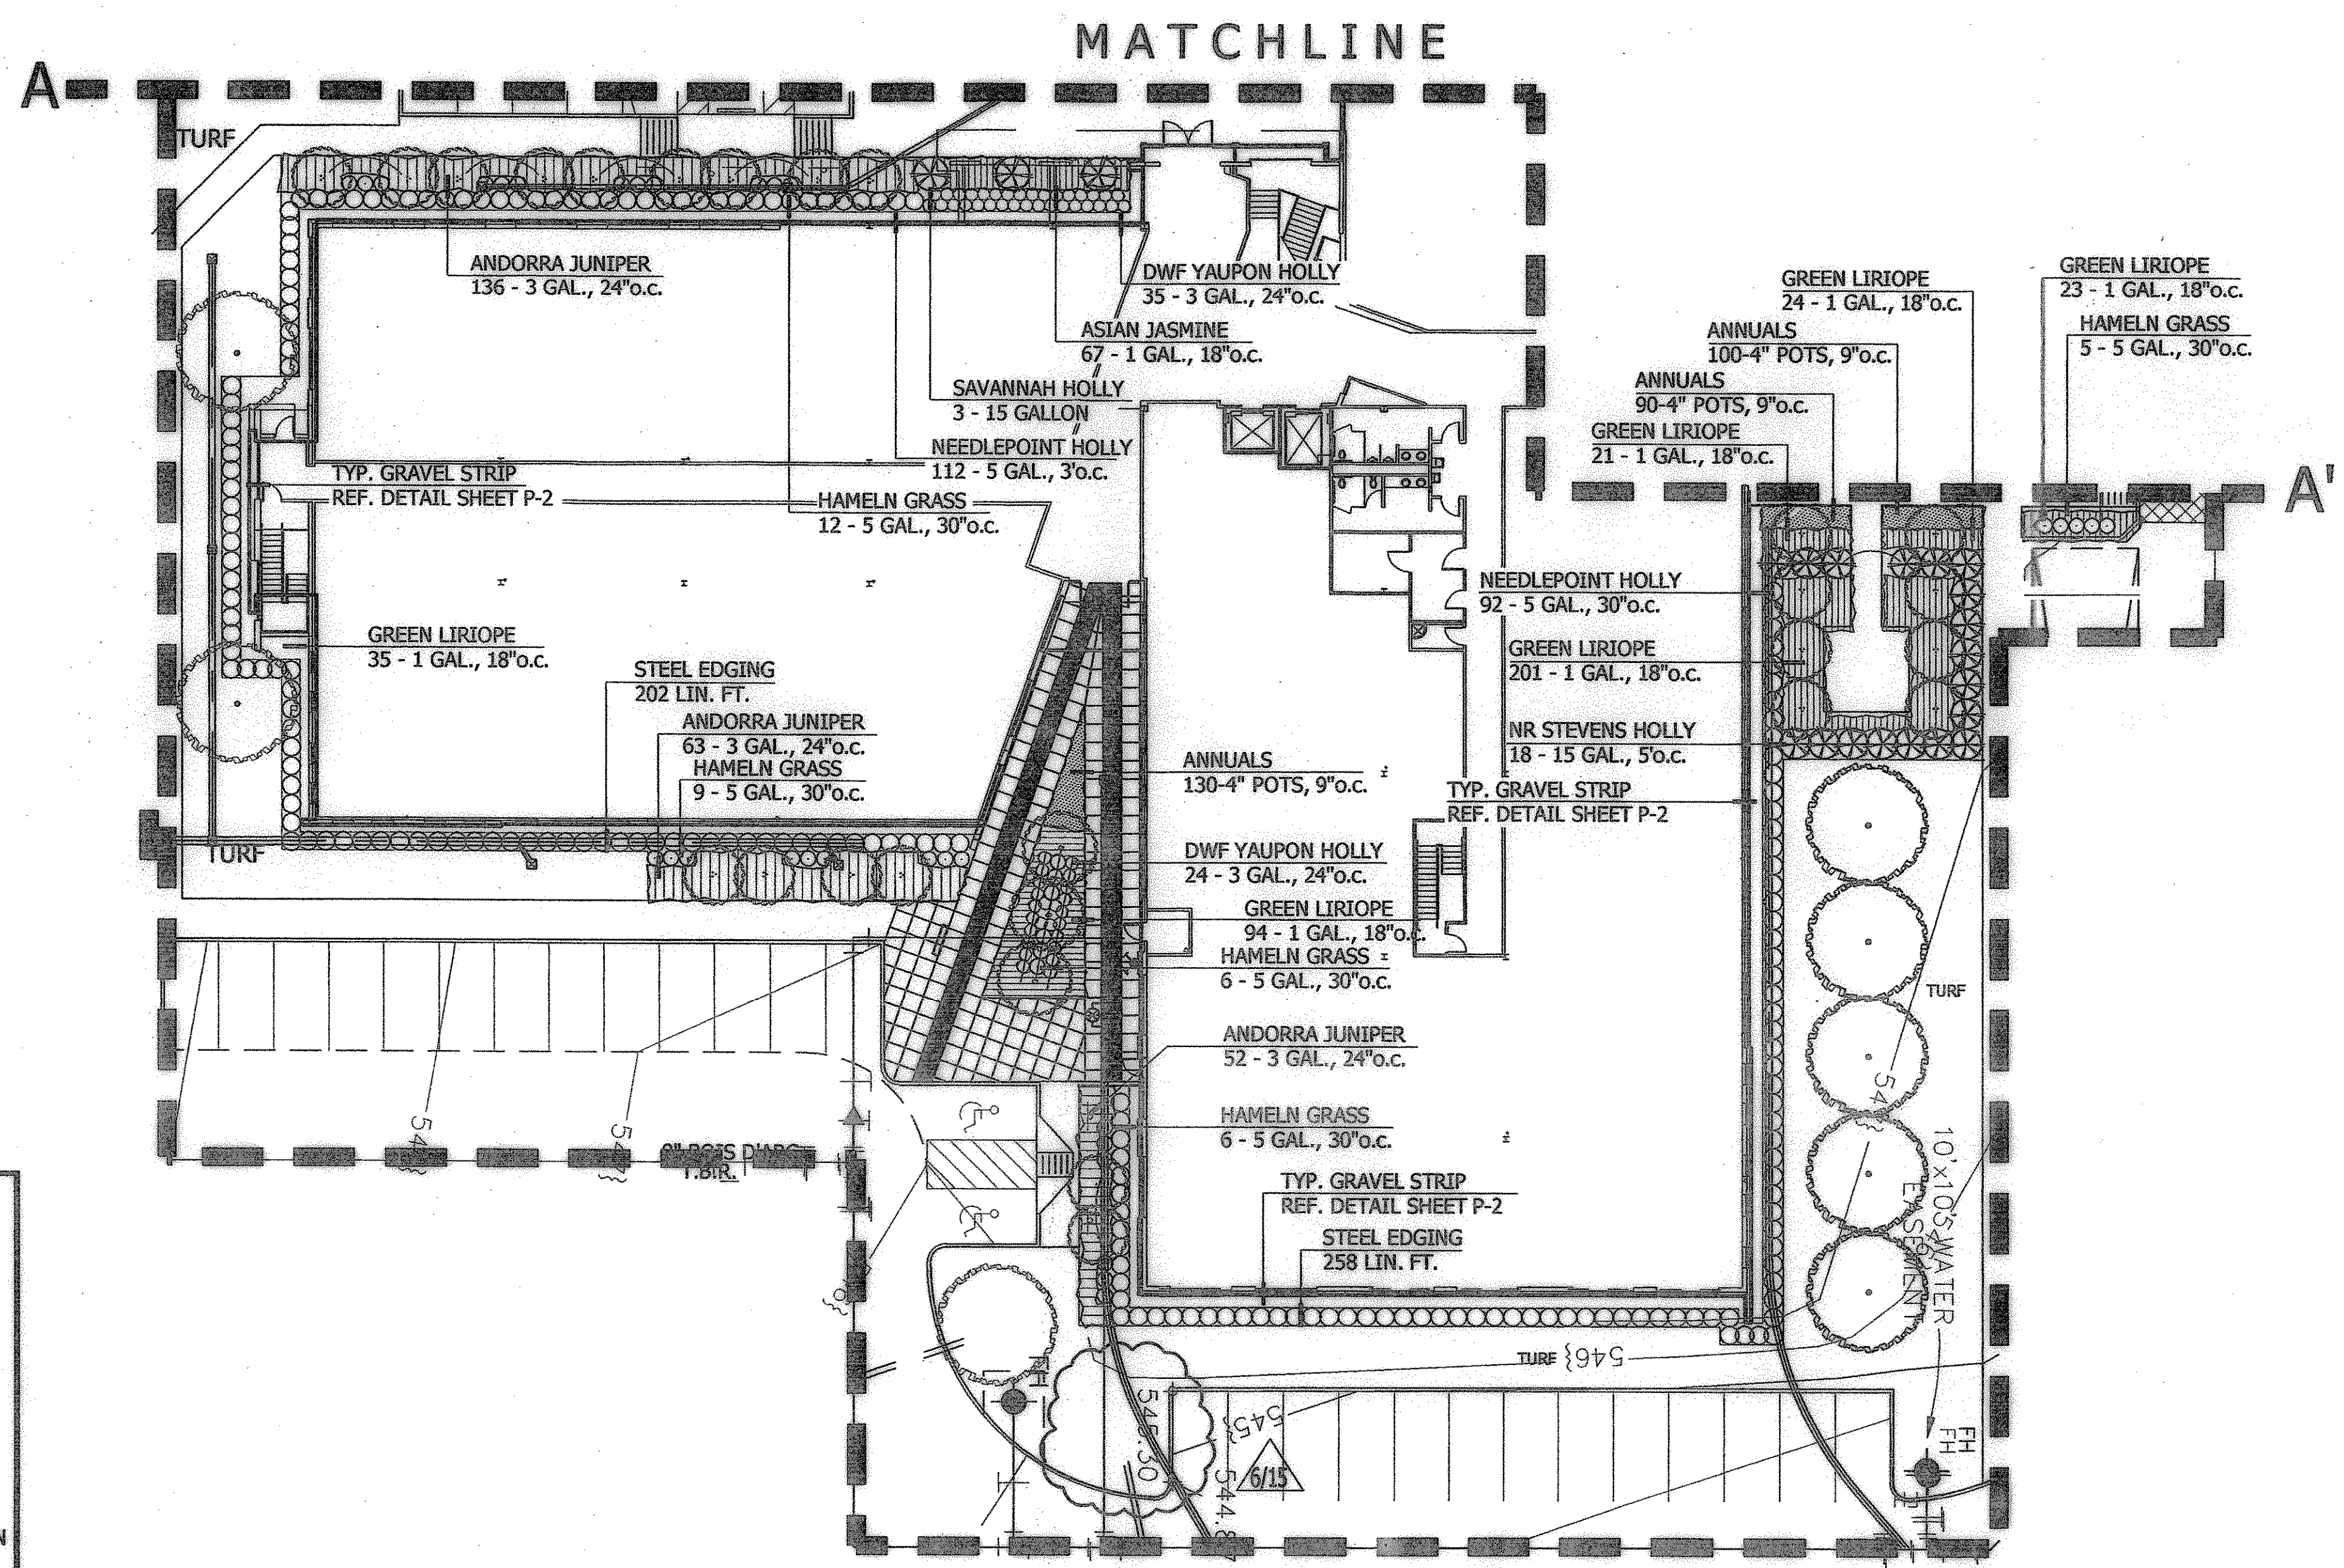

PLANTLIST

MATERIAL	QNTY	SIZE	HT	SP	NOTES
LIVE OAK	19	3" CAL.	10-12'	5-6'	NURSERY GROWN
QUERCUS VIRGINIANA					
BURR OAK	19	3" CAL.	10-12'	5-6'	NURSERY GROWN
QUERCUS MACROPHYLLA					
LACEBARK ELM	14	3" CAL.	10-12'	6-7'	NURSERY GROWN
ULMUS PARVIFOLIA SEMPERVIRENS					
CHINESE PISTACHE	10	3" CAL.	10-12'	5-6'	NURSERY GROWN
PISTACHIA CHINENSIS					
BALD CYPRESS	4	3" CAL.	9-11'	5-6'	NURSERY GROWN
TAXODIUM DISTICHUM					
CHINESE PISTACHE	10	3" CAL.	10-12'	5-6'	NURSERY GROWN
PISTACHIA CHINENSIS					
NATCHEZ CRAPE MYRTLE	19	30 GAL.	8-10'	5-6'	CONTAINER GROWN
LAGERSTROEMIA INDICA 'NATCHEZ'					
CRAPE MYRTLE	14	30 GAL.	8-10'	5-6'	CONTAINER GROWN
LAGERSTROEMIA INDICA 'TUSCARORA'					
RIVER BIRCH	7	30 GAL.	8-10'	5-6'	CONTAINER GROWN
BETULA NIGRA					
WAX MYRTLE	10	6-8' HT.	6-8'	3-4'	NURSERY GROWN
MYRICA CERIFERA					
NR STEVENS HOLLY	18	15 GAL.	4-5'	36"	FULL TO GROUND
ILEX CORNUTA 'NEEDLEPOINT'					
NEEDLEPOINT HOLLY	508	5 GAL.	30"	24"	FULL
ILEX CORNUTA 'NEEDLEPOINT'					
SOFT-LEAF YUCCA	22	5 GAL.	30"	24"	FULL
YUCCA RECURVIFOLIA					
HAMELN GRASS	61	5 GAL.	24"	20"	FULL
PENNISETUM ALOPECUROIDES 'HAMELN'					
ANDORRA JUNIPER	299	3 GAL.	12"	18"	FULL
JUNIPERUS HORIZONTALIS 'PLUMOSA'					
SALVIA GREGGI	13	3 GAL.	12"	12"	FULL
SALVIA GREGGI					
DWF YAUPON HOLLY	59	3 GAL.	12"	12"	FULL
ILEX VOMITORIA 'NANA'					
CARPET ROSE	30	2 GAL.	10"	12"	FULL
ROSA SPP. 'RED'					
GREEN LIRIOPE	1129	1 GAL.	10"	10"	FULL
LIRIOPE MUSCARI 'BIG BLUE'					
ASIAN JASMINE	67	1 GAL.	10"	10"	FULL
TRACHELOSPERUM ASIATICUM					
ANNUALS	650	4" POTS			TO BE DETERMINED
STEEL EDGING	1190	LIN. FT.			REF. DETAIL

LANDSCAPE NOTES

1. PLANT LIST FOR SHEETS P-1 THRU P-3 ONLY.
2. PLANT LIST TO BE USED AS AIDE TO BIDDER ONLY. LANDSCAPE
3. AFTER INSTALLATION OF STEEL EDGING, ALL BEDS SHALL BE TILLED TO A DEPTH OF 4-6", RAKING OUT ALL DEAD VEGETATION.
4. APPLY A 2-3" DEPTH OF ORGANIC MATERIAL OVER ENTIRE BED AND TILL INTO EXISTING SOIL. ORGANIC MATERIAL SHALL BE ONE OF FOLLOWING:
 VITAL EARTH COMPOST
 BACK-TO-EARTH SOIL CONDITIONER
 LIVING EARTH COMPOST
 SOIL BUILDING SYSTEMS COMPOST
 SILVER CREEK MATERIALS COMPOST
5. TOPDRESS ENTIRE BED WITH MINIMUM 2" DEPTH SHREDDED NATIVE CEDAR MULCH.
6. ALL SHADE TREES AND ORNAMENTAL TREES SHALL BE PLANTED AS PER DETAILS ON SHEET P-1.
7. ALL AREAS LABELED "TURF" SHALL BE COMMON BERMUDA HYDROMULCH.