
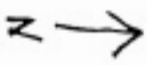


7-11

N. GOLIA D

AREA To make
disconnect + Plug

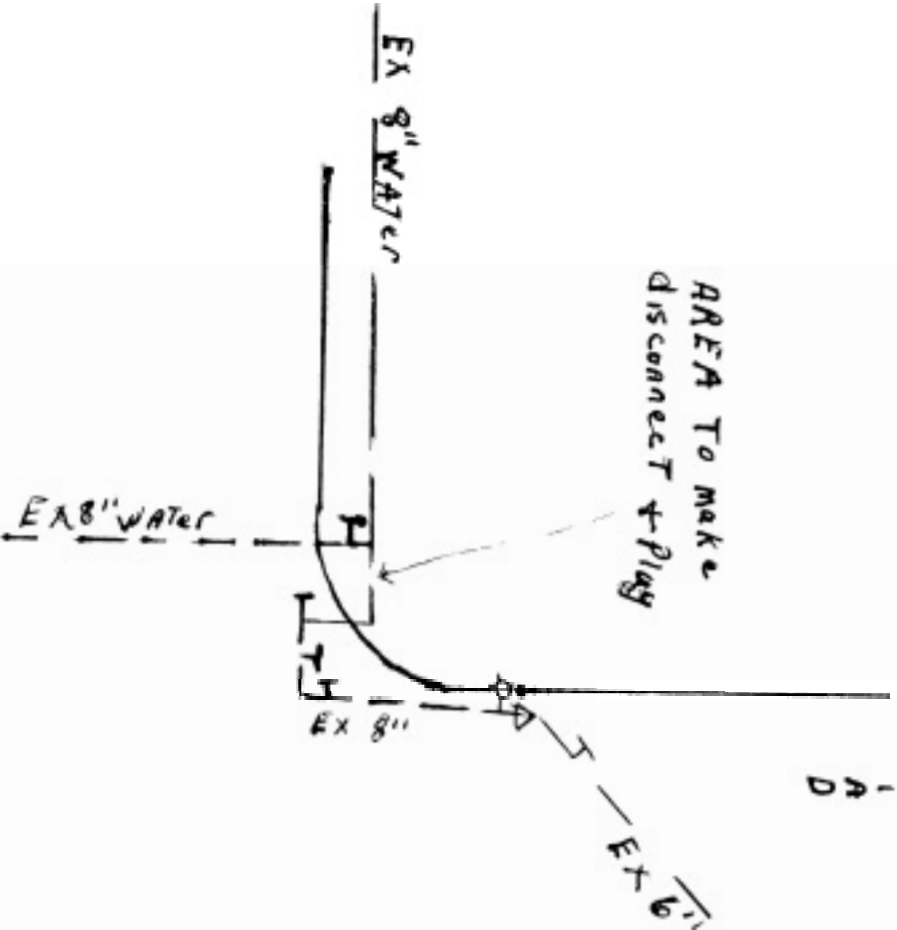



More Info

Rockwall County
Sheet # C

1946 Water Pl
Goliad + Kauf

UTILITY Imp
Job # 870c
Sheet #

Kaufman

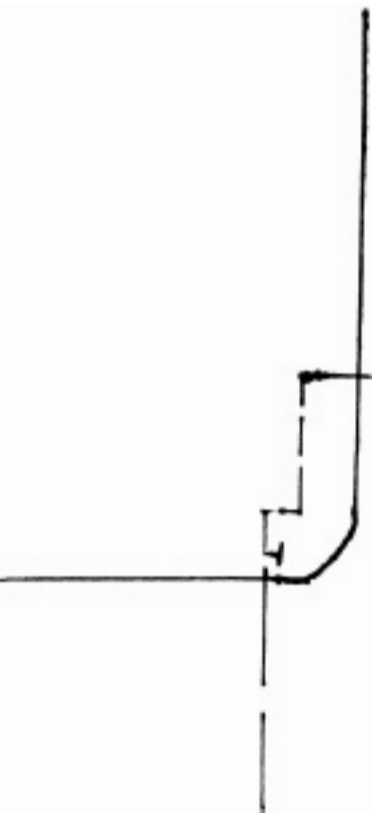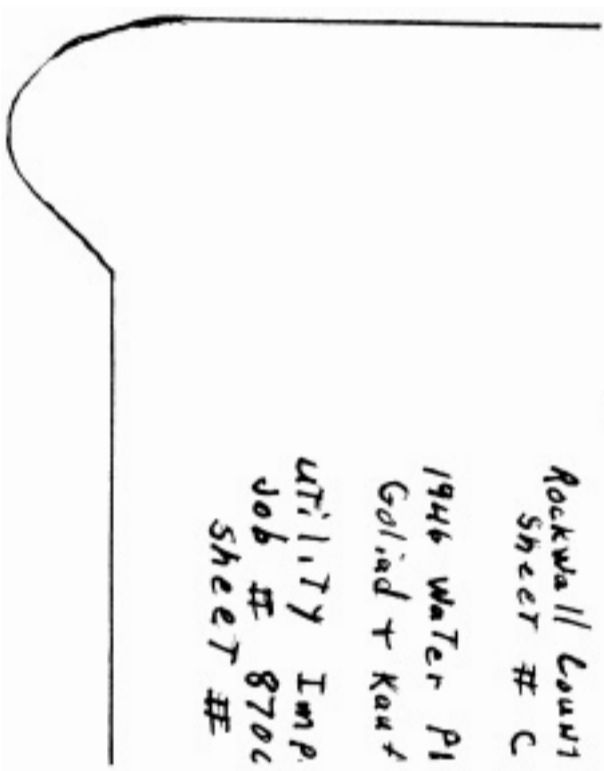

County
Court House

