

W. D. AUSTIN'S ADDITION

BARNES ADDITION

NATIONAL BANK ADDITION

27  
26  
25  
24  
23  
22

REL. Halford  
C.A. Brownwell  
2651397

Joe Spafford, Jr.  
2651276

Smith  
2651401

H.H. Barringer  
2651402

Bryant  
2651400

Geo. Cade  
2651395

Kimbrell  
2651396

Barnhardt  
2651180  
Ed Shoemaker  
3 962 150

Existing to remain in service

Reconnect all services to houses fronting on new main with Copper tubing to meter

6" C.I. Main Laid Feb. 1946



Abandon Existing 3/4"

Match Line

F.H. Removed 2009

6" x 2" Tapped Plug

Fence - Assumed P.L.

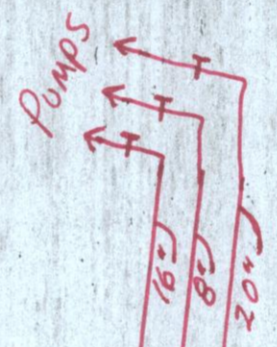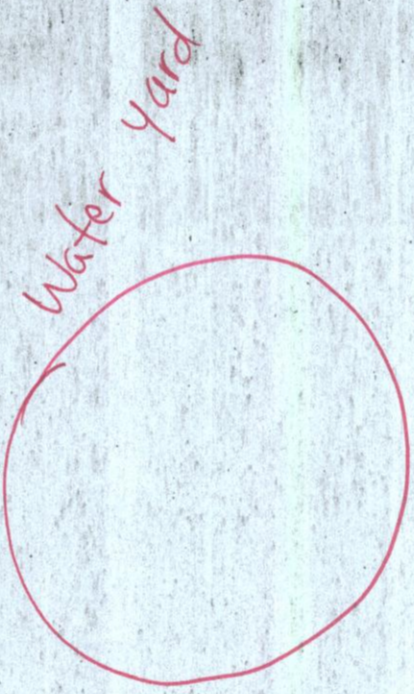

2" poly Connection Made 2011 Curtis

(FANNIN) ATHERTON STREET

2" PVC

HEATH ST.

FRESE & NICHOLS  
Consulting Engineers  
February, 1946