




10

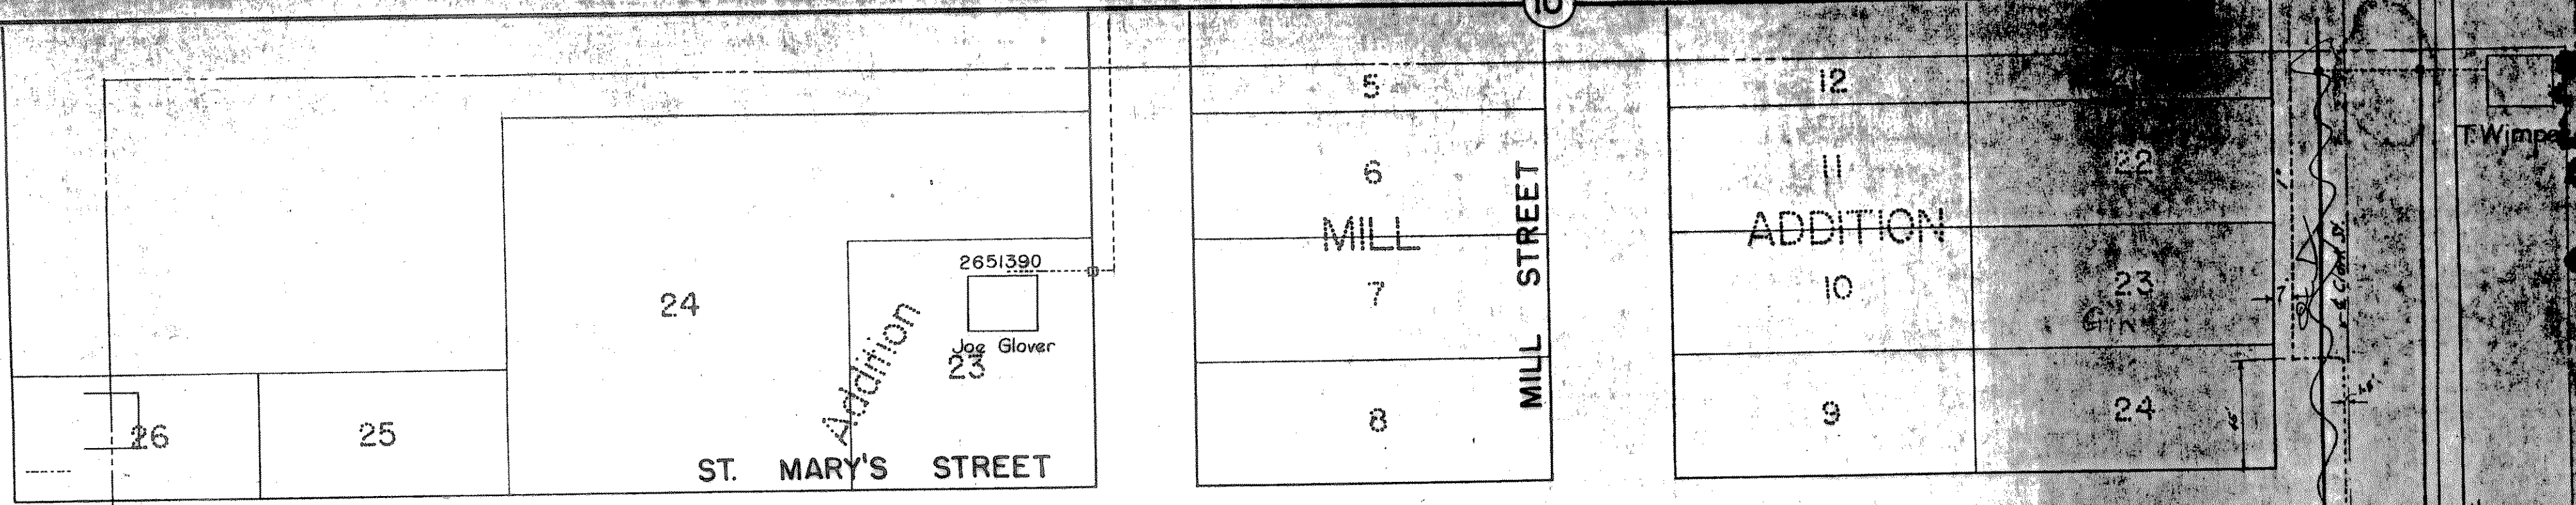

12

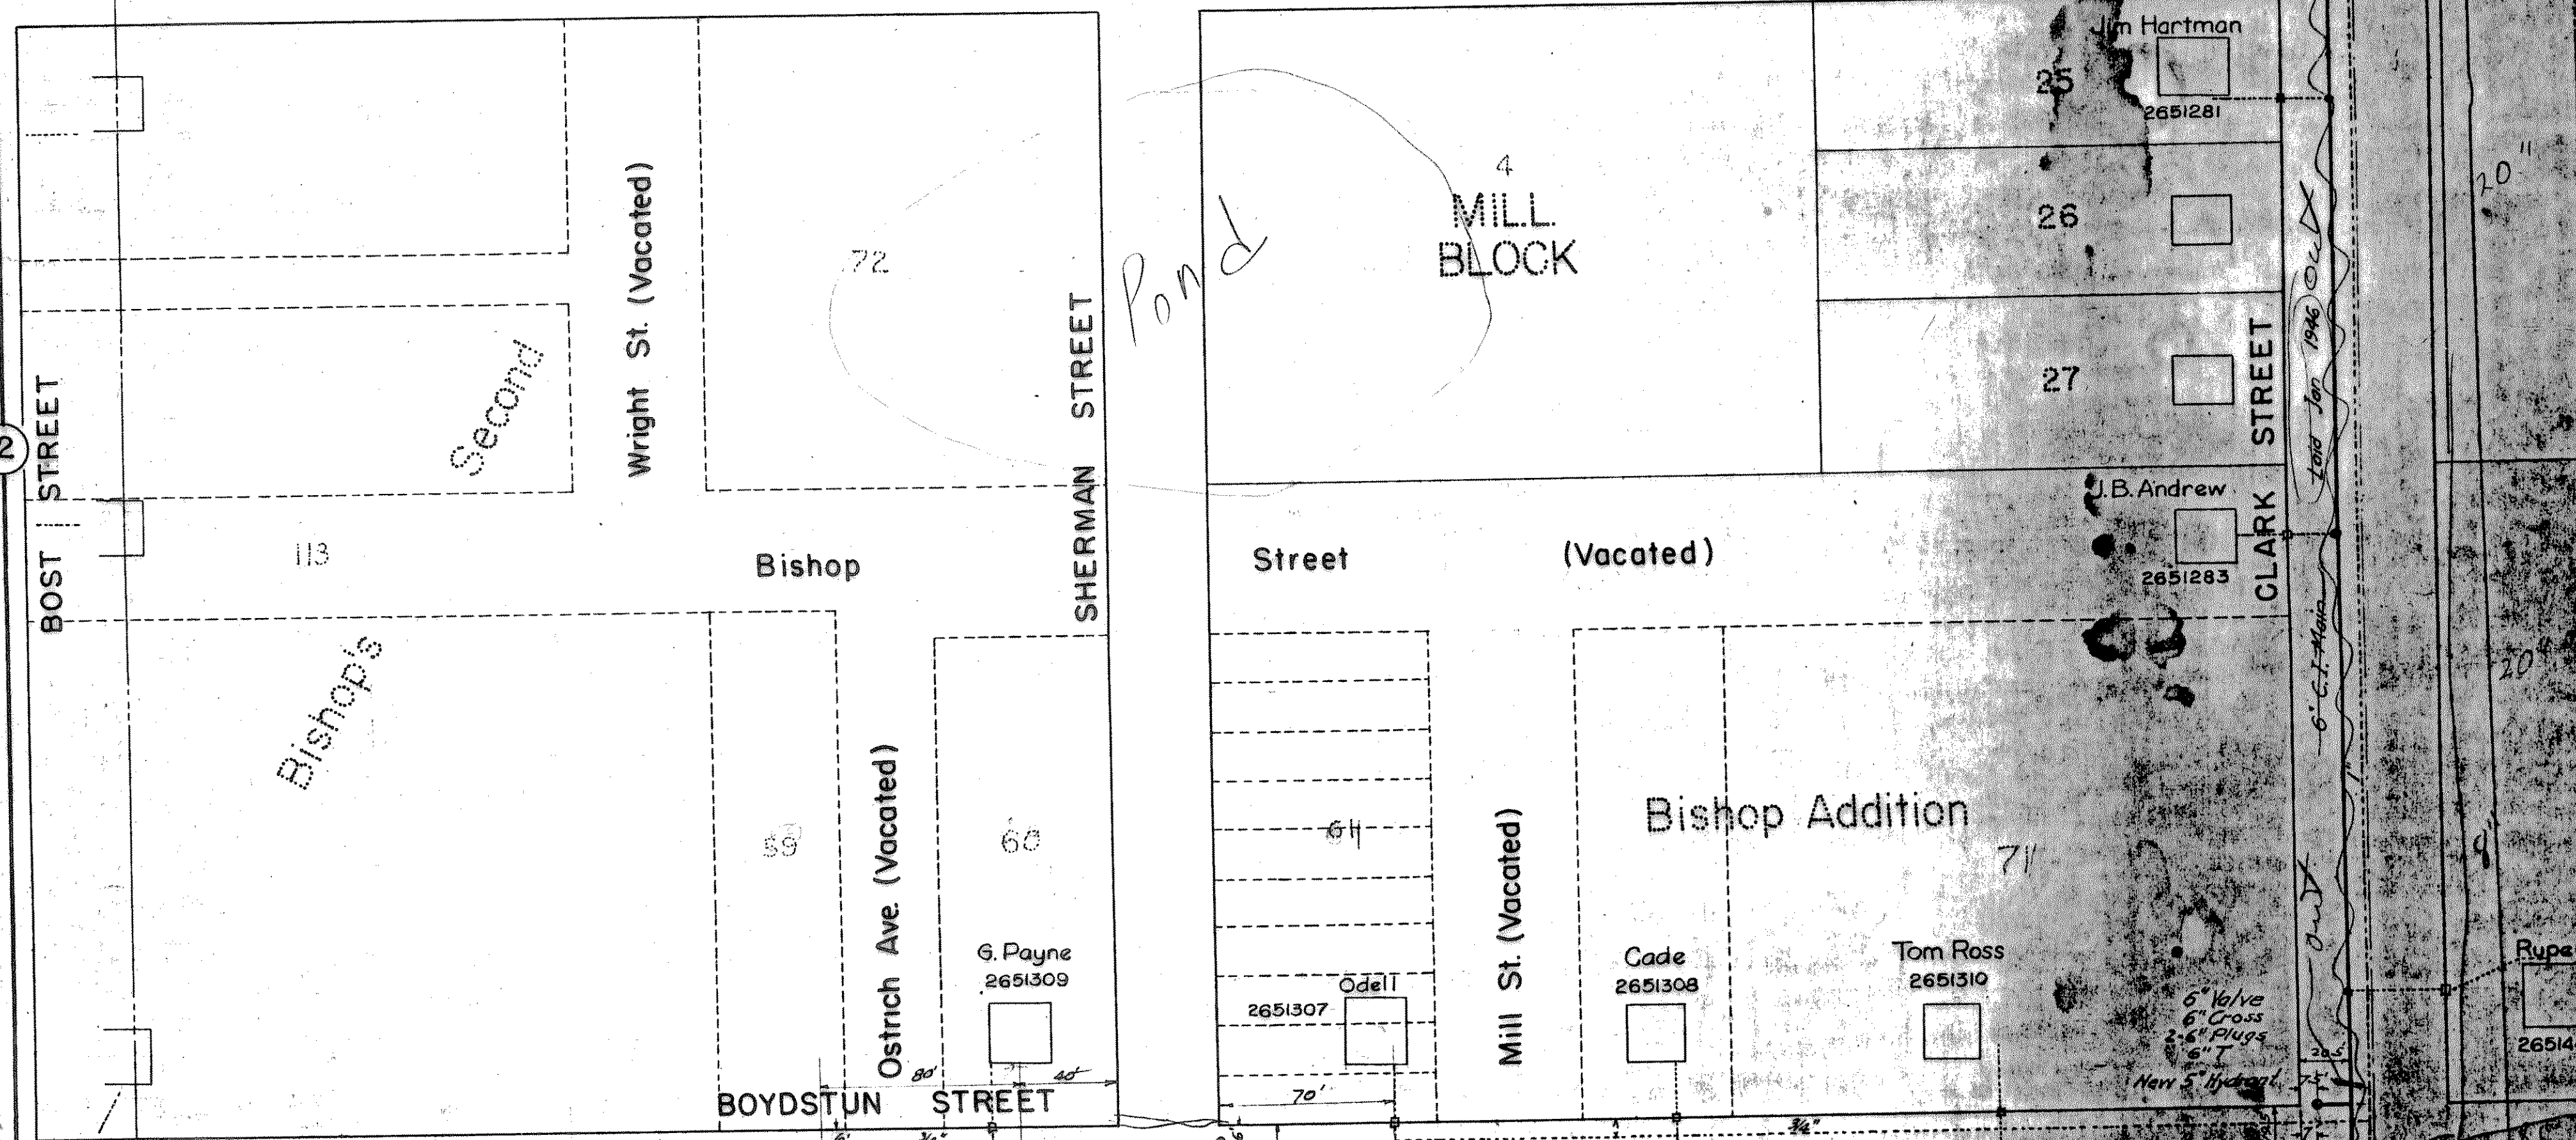

13

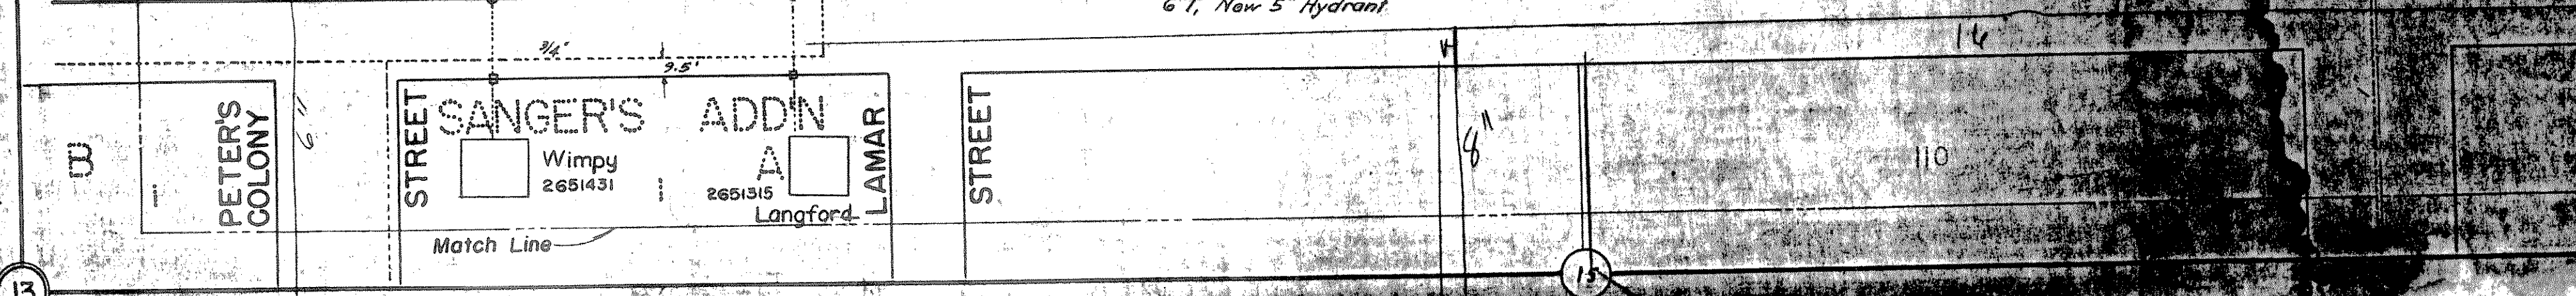

15

FRESE & NICHOLS
Consulting Engineers
February 1946

13