



INTERSECTION - ROSE & STORR'S AVE.


FANNIN

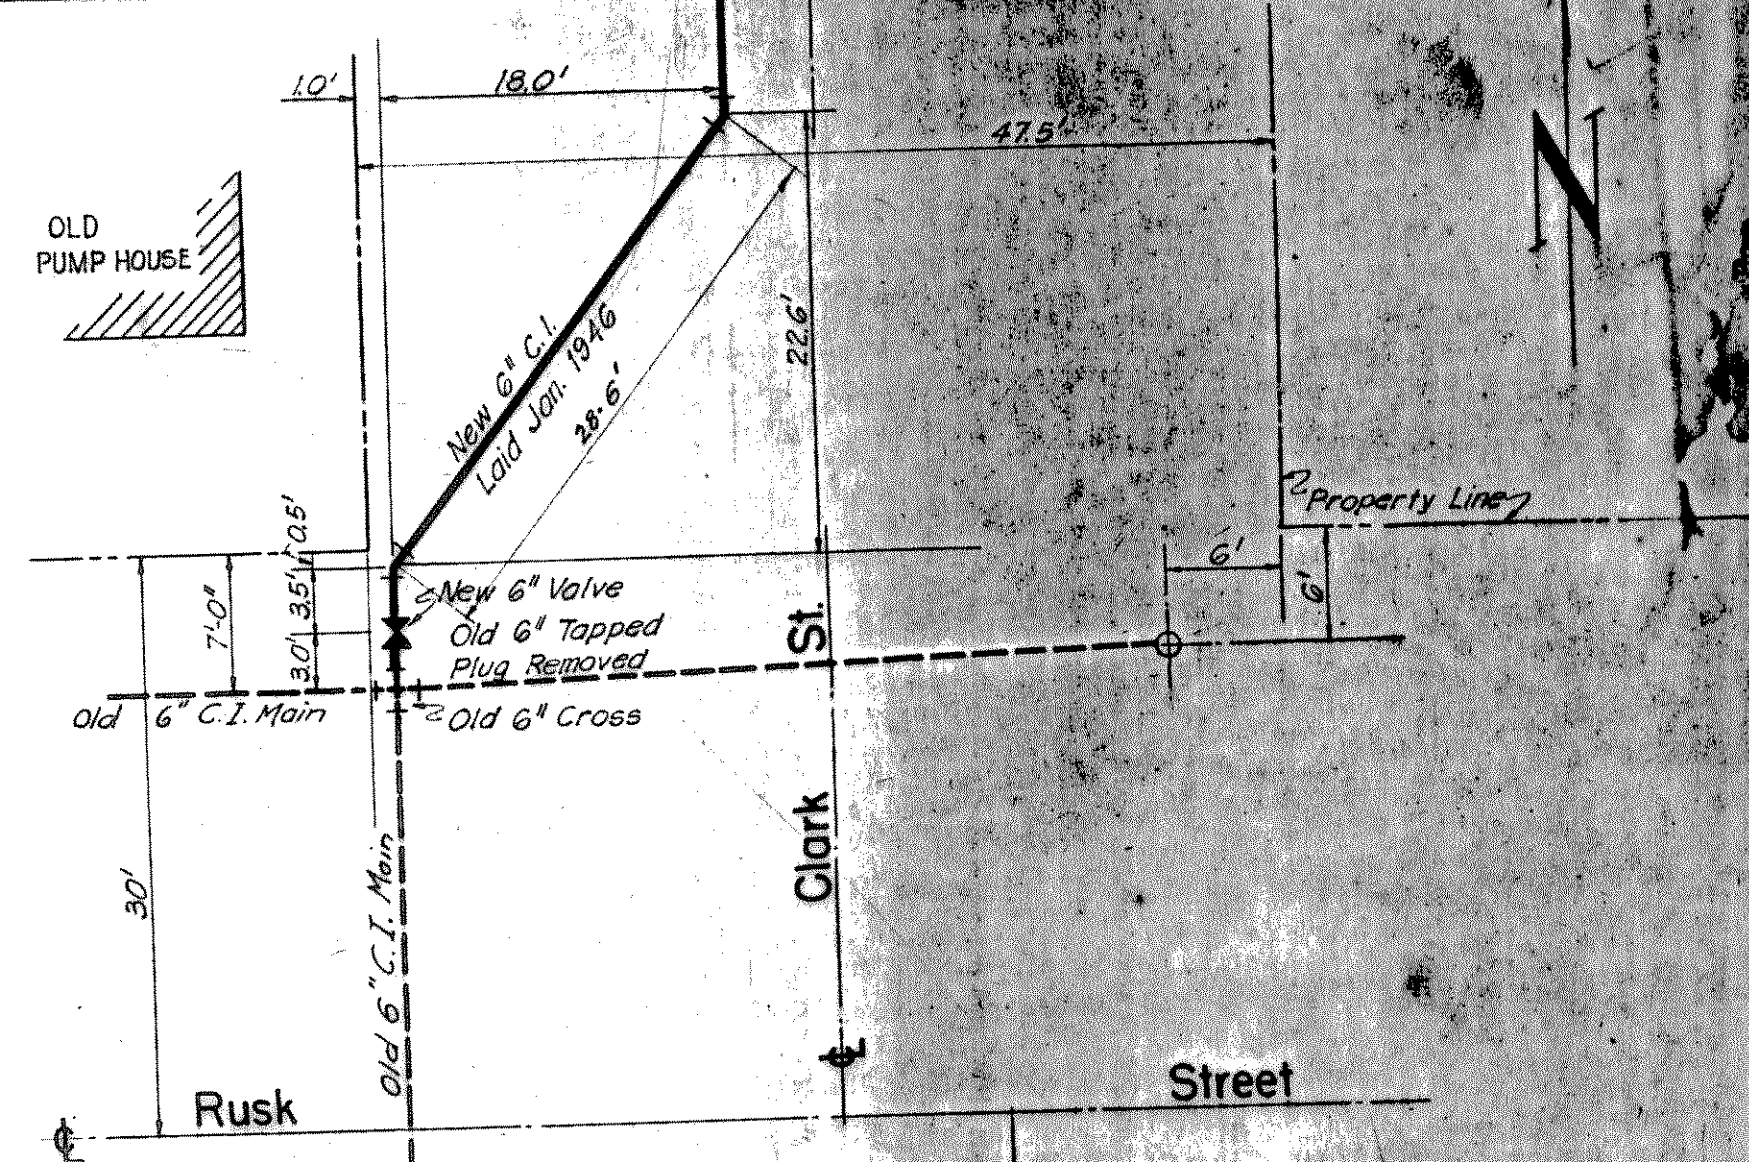

INTERSECTION - RUSK & CLARK STS.

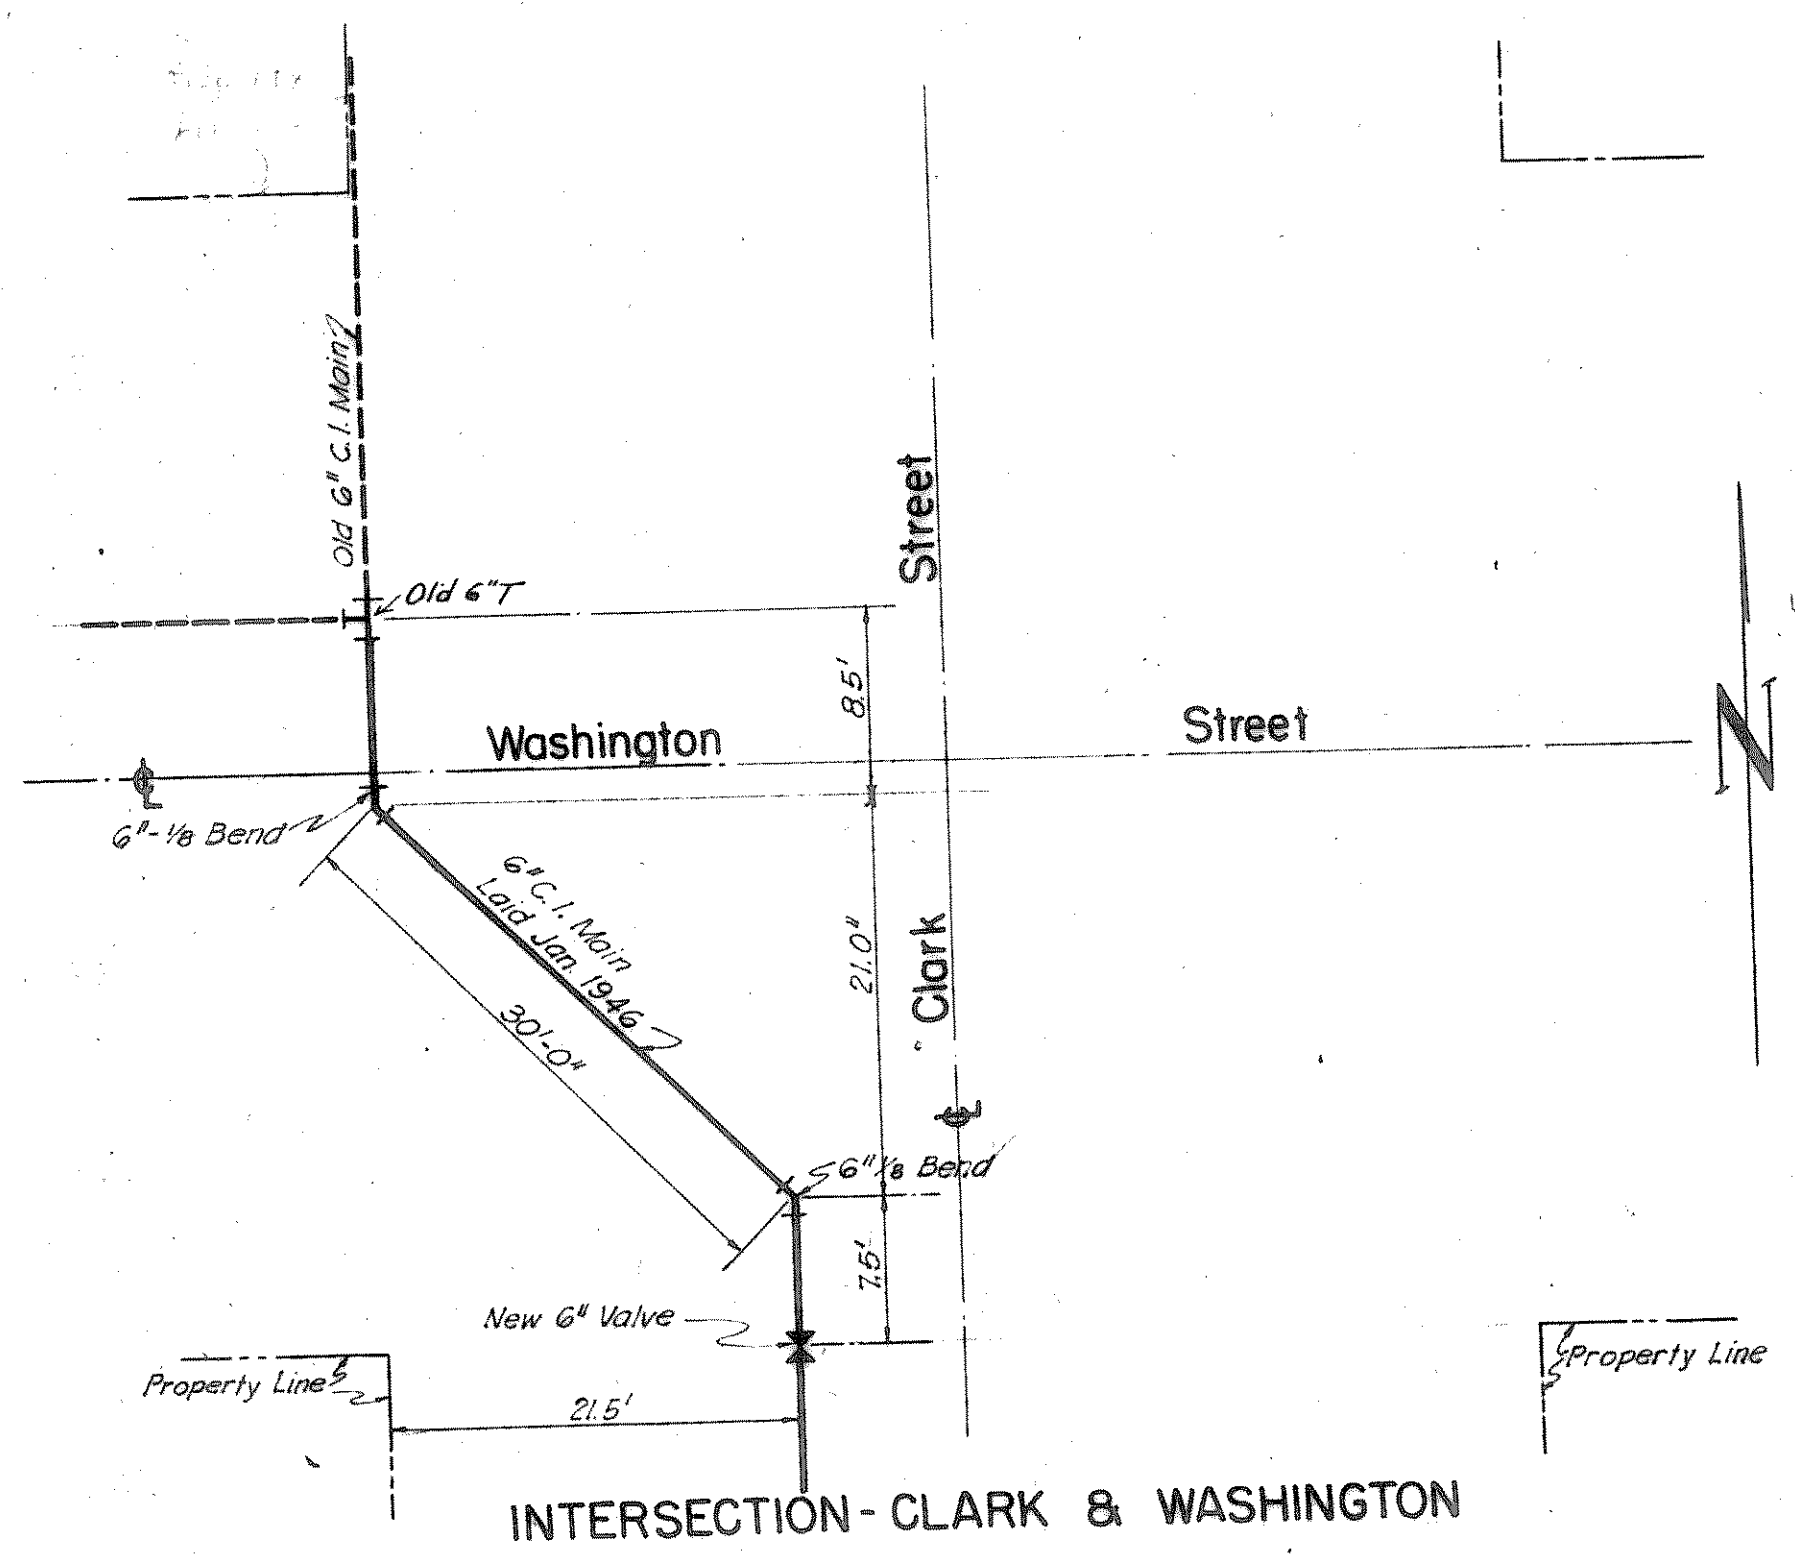

INTERSECTION - CLARK & WASHINGTON

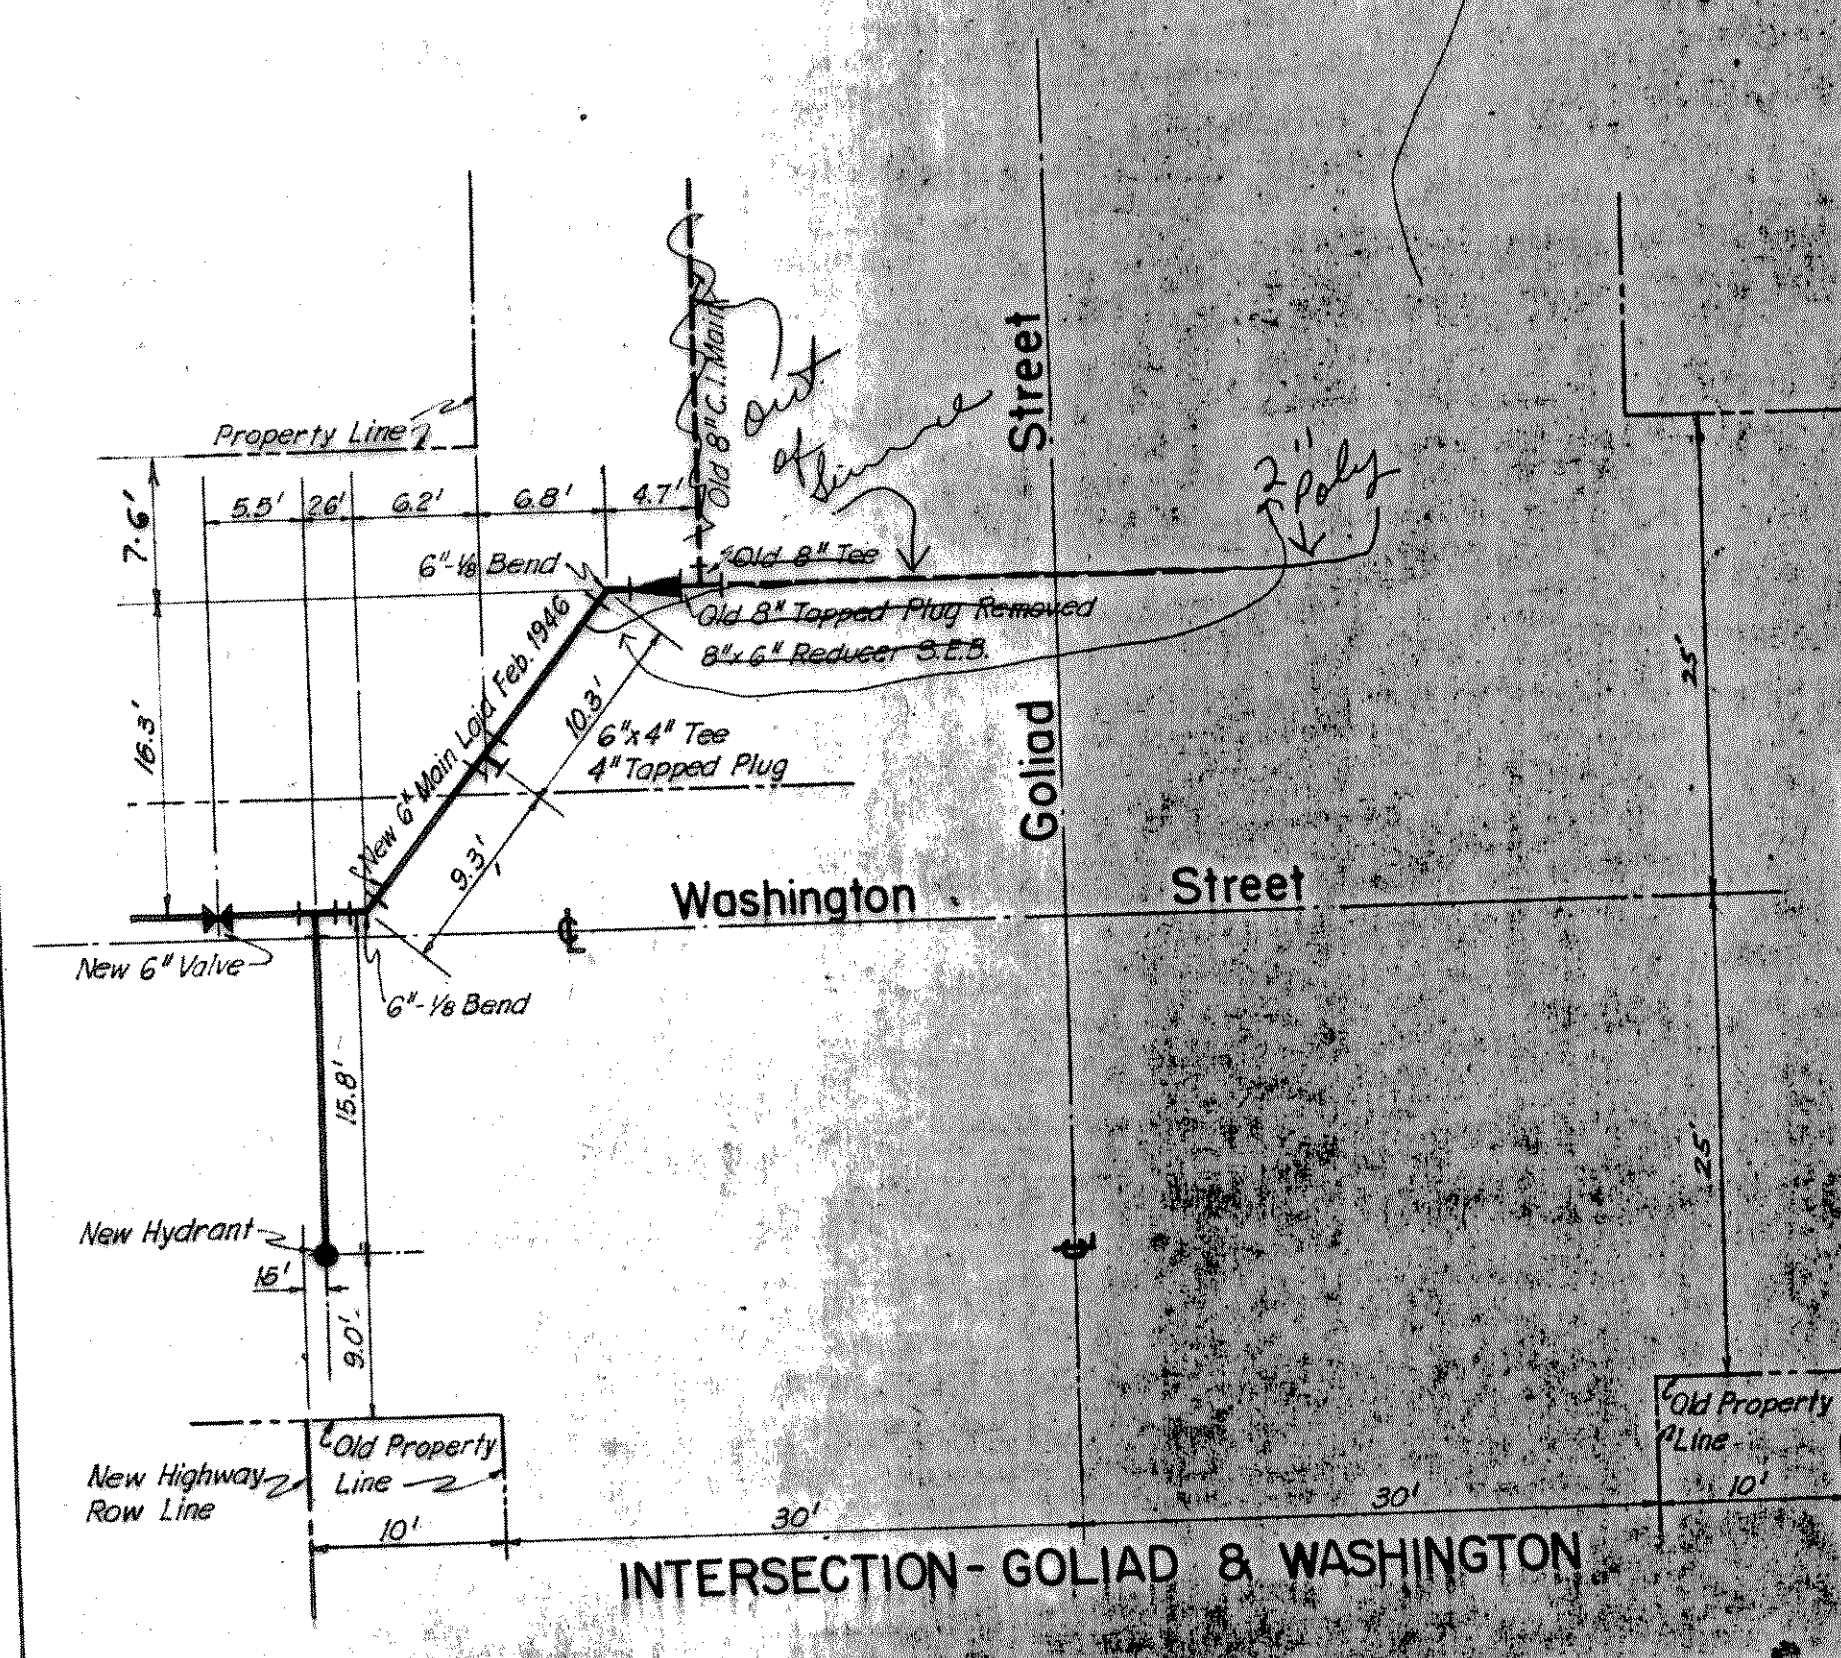

INTERSECTION - GOLIAD & WASHINGTON

FREESE, B. NICHOLS  
 Consulting Engineers  
 Fort Worth, Texas

INTERSECTION DETAILS  
 SCALE 1" = 10'