


13
State Highway
Department

H H
8

Rogers
2651361

Lib
3

Edwards
2651361

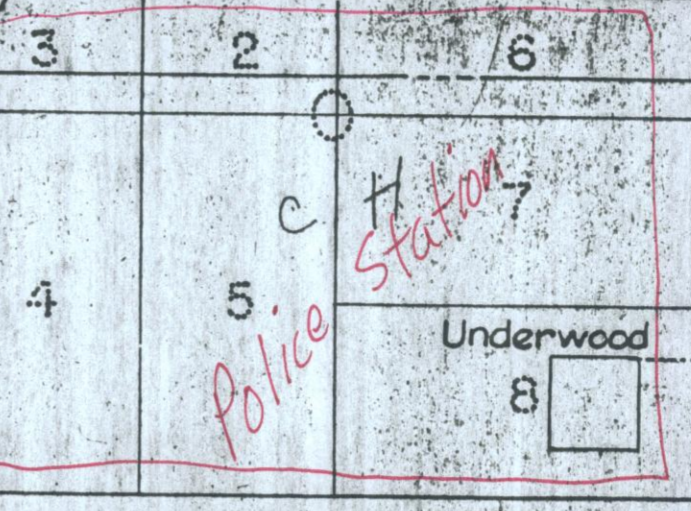

Bost
5

2651385
Hotel

Connect to tapped plug

WASHINGTON STREET

6" C.I. Main laid Feb. 1946

Abandon Existing 3/4"

2" PVC

Walker
2651255

14

Carr
2651278

Wright
2651251

Old 4" Hydrant from Square
6" Tee
6" Tapped Plug

Carter
2651382

Wyatt
2651256

4

3
Lewis
2651384

2
Dial
2651252

Shoemaker
2651357

4
Lewis
2651384

2
Dial
2651252

6

Hartman
2651386

2

2651388

Stephenson

6

4

5

7

8

HOUSTON STREET

WEST STREET

W. ELGINS ORIGINAL PLAT

ALAMO STREET

GOLIAD STREET

SECOND ST.

FIRST STREET

C E M E T E R Y

Match Line

Not to scale
1-6-50
400

W. ELGINS & NICHOLS
Consulting Engineers
February 1946