

7 M^r Donald
2651363

Darr
2651367

Pearson
2651407

42
Walters
2651408

Smith
2651297

43
Remhardt
2651296

SAN ANTONIO

WASHINGTON STREET

Existing 6" Main

Old 6" Main

Petholt
2651293

Baptist Parsonage
2651295

Joe Wilkinson
2651377

Trotter
2651375

Payne
2651410

44
Bean
2651409

45
Leonard
Vacant


46
Walker
2651294

74
Clark
Vacant

Dowell
2651405

47
White
2651406

6" Valve
2-6" 45° Bends

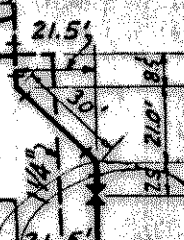

Latham

TYLER STREET

DENISON AVENUE

Ross
2651298

48

Chas. Hall
2651317

HARTMAN ST

6" Tee
New 5" Hydrant

2- 1" Taps
1/4" Connection

CLARK STREET

EPPSTEIN'S

ADDITION

SHERMAN STREET

7
Webb

6

5
Fondren

14

9

10

11

12

13

8

7

6

5

4

73

Sears
2651322
49

FREESE & NICHOLS
Consulting Engineers
February 1946

See Sheet 7

Match Line

7

8

10

4

8

8"

8"

8"

New 6" C.I.

1 1/2"

8"

21.5"

21.5"

