


SECTION A-A  
 PAVING DETAIL LANE WIDENING

NOTE: SAWCUT TO NEAT LINE.



NOTE: ALL CONSTRUCTION WITHIN HWY 276 RIGHT-OF-WAY SHALL BE TO TxDOT STANDARDS AND SPECIFICATIONS.  
 ALL CONCRETE LANE WIDENING SHALL REQUIRE A 1" ± SAW CUT OF EXISTING ASPHALT FOR LANE CONNECTION.

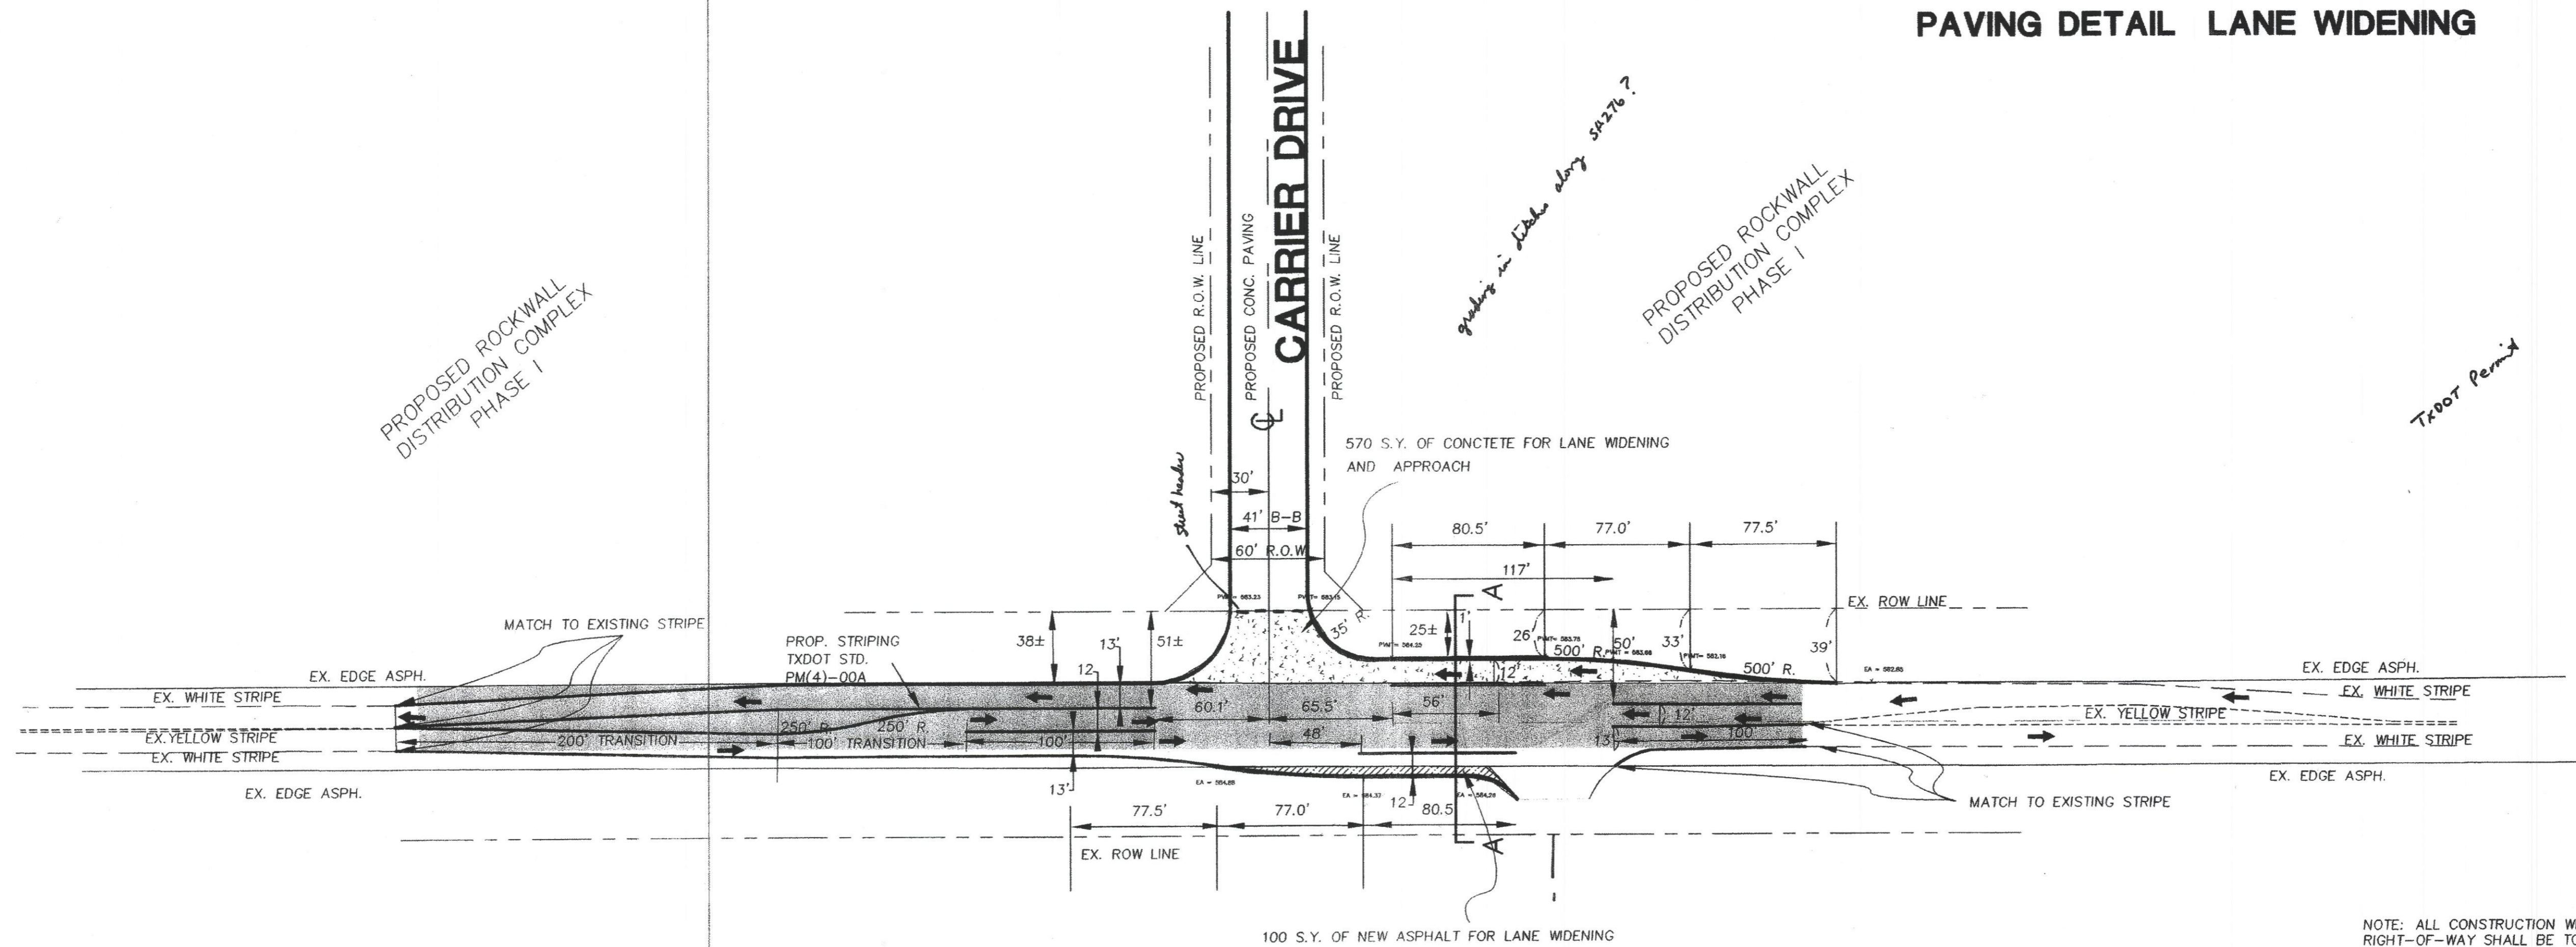

THE SEAL APPEARING ON THIS DOCUMENT WAS AUTHORIZED BY THE BOARD OF ENGINEERING EXAMINERS OF THE STATE OF TEXAS P.E. NO. 60102 ON

**DOUPHRATE & ASSOCIATES, INC.**  
 ENGINEERING - PROJECT MANAGEMENT - SURVEYING  
 2235 BRIDGE RD., # 200 ROCKWALL, TEXAS 75087  
 PHONE: (972)771-9004 FAX: (972)771-9005

**PAVING DETAILS**  
**ROCKWALL DISTRIBUTION COMPLEX, PHASE I**  
 CITY OF ROCKWALL  
 ROCKWALL COUNTY, TEXAS

REVISION	PER CITY COMMENTS
-	06/17/02

W.L.D.  
 CHECKED  
 D.B.  
 DRAWN  
 10/01  
 DATE  
 0033PAVDET1  
 PROJECT