


Revision	Date	Description



Owner:
SPRING HAVEN INVESTMENTS, INC.
 6750 HILLCREST PLAZA DR. • STE 325
 DALLAS, TEXAS 75230 • Phone: 972-386-3333

The Highlands

F.C. CUNY CORPORATION
 #2 Horizon Court • Ste. 500 • Heath, Texas 75032
 Phone: 469-402-7700
 Fax: 469-402-0700

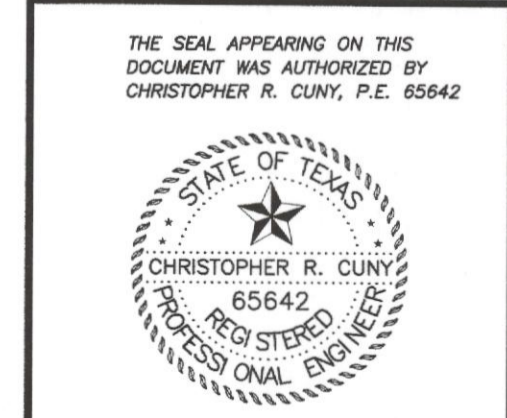

Drawn By: MSC
 Checked By: JW
 Date: 09/25/2007
 Project No.: 06-004
 Sheet Title:
East Glen Paving Plan & Profile
 Scale: 1" = 40'
 Sheet No.: 13 of 61

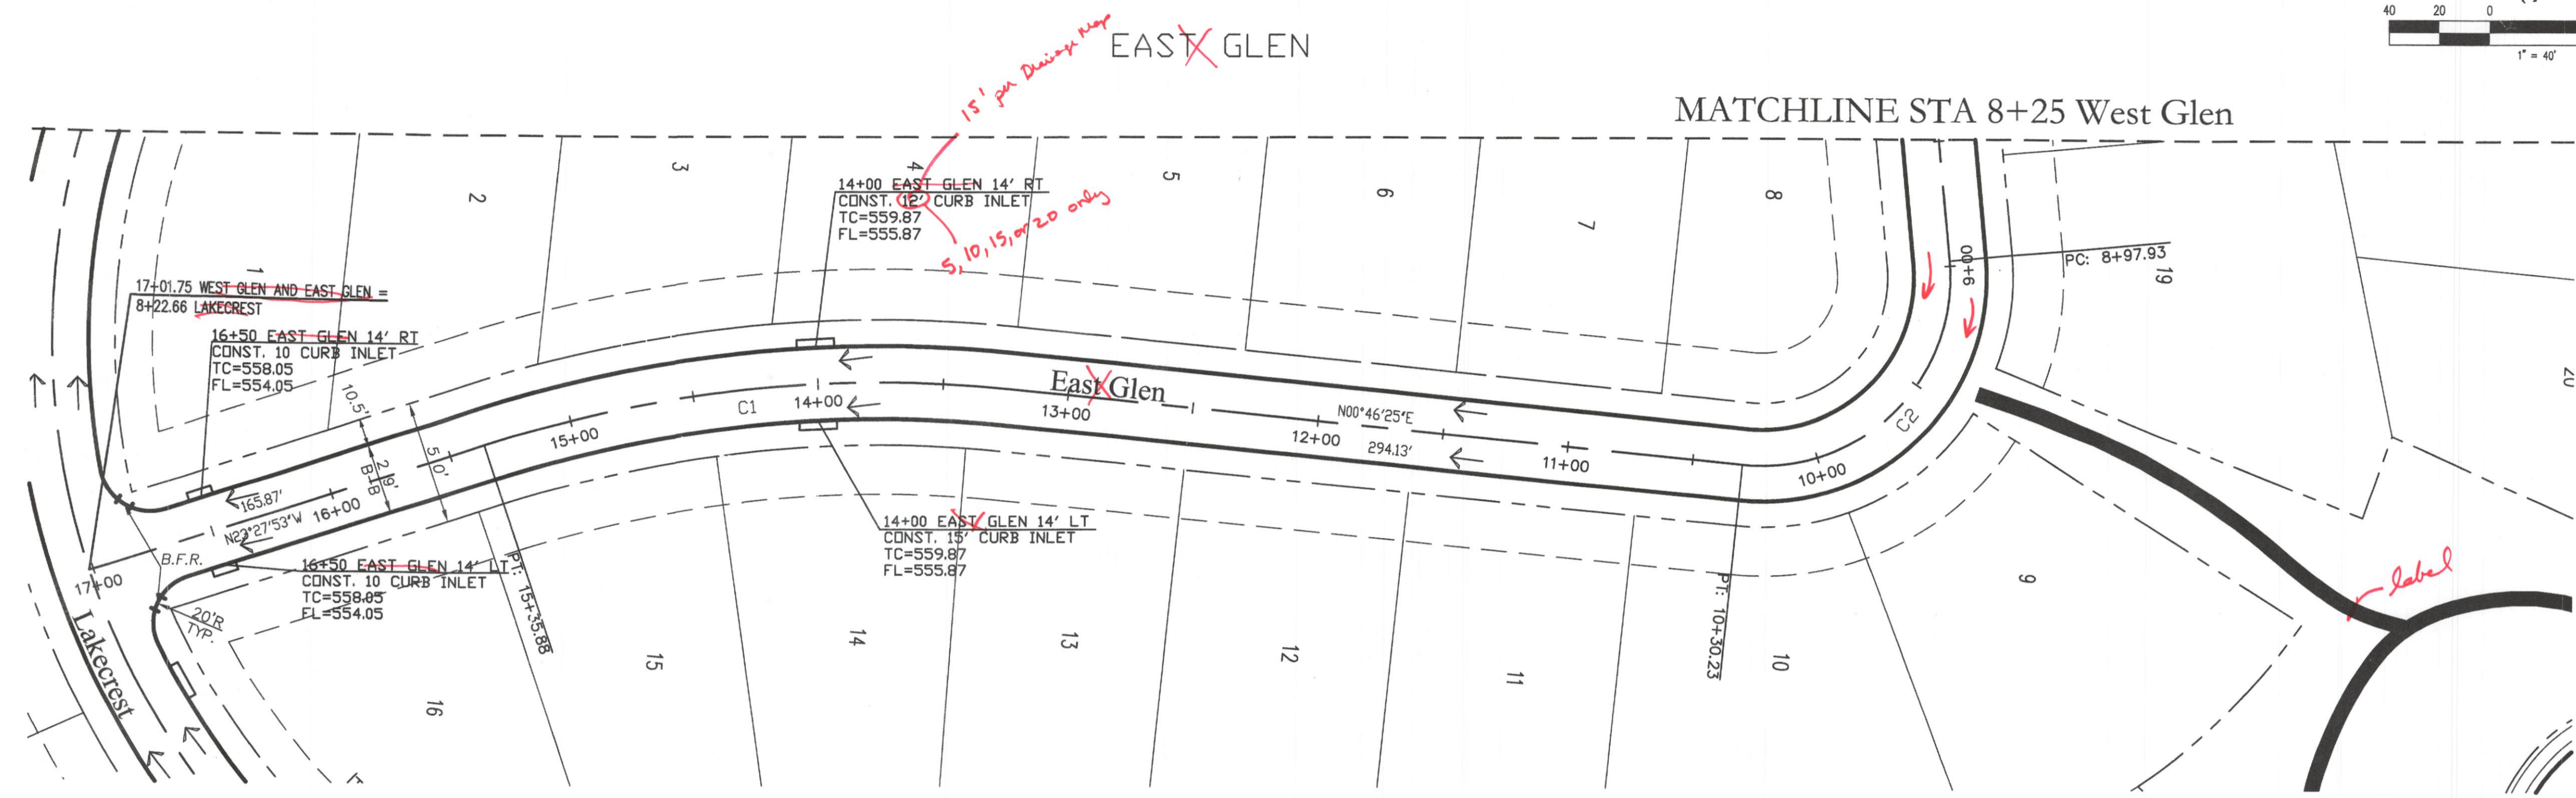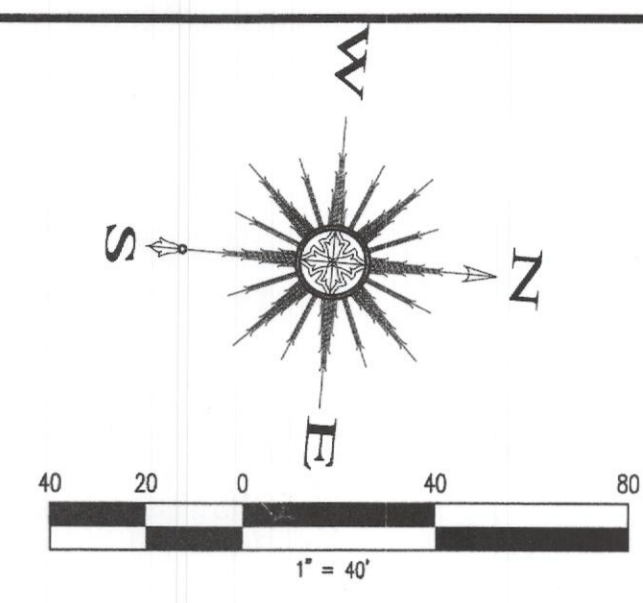

CURVE	LENGTH	RADIUS	DELTA	TANGENT	CHORD	BEARING
C1	211.52'	500.00	24°14'18"	107.37'	209.94'	S11°20'44"E
C2	132.30'	75.00	101°04'16"	91.10'	115.80'	N49°45'43"W

