


CURVE TABLE						
CURVE	LENGTH	RADIUS	DELTA	TANGENT	CHORD	BEARING
C40	97.75'	400.00	14°00'07"	49.12'	97.51'	N07°46'28"E
C41	109.89'	400.00	15°44'26"	55.29'	109.54'	N07°05'48"W
C42	109.89'	400.00	15°44'26"	55.29'	109.54'	S07°05'48"E

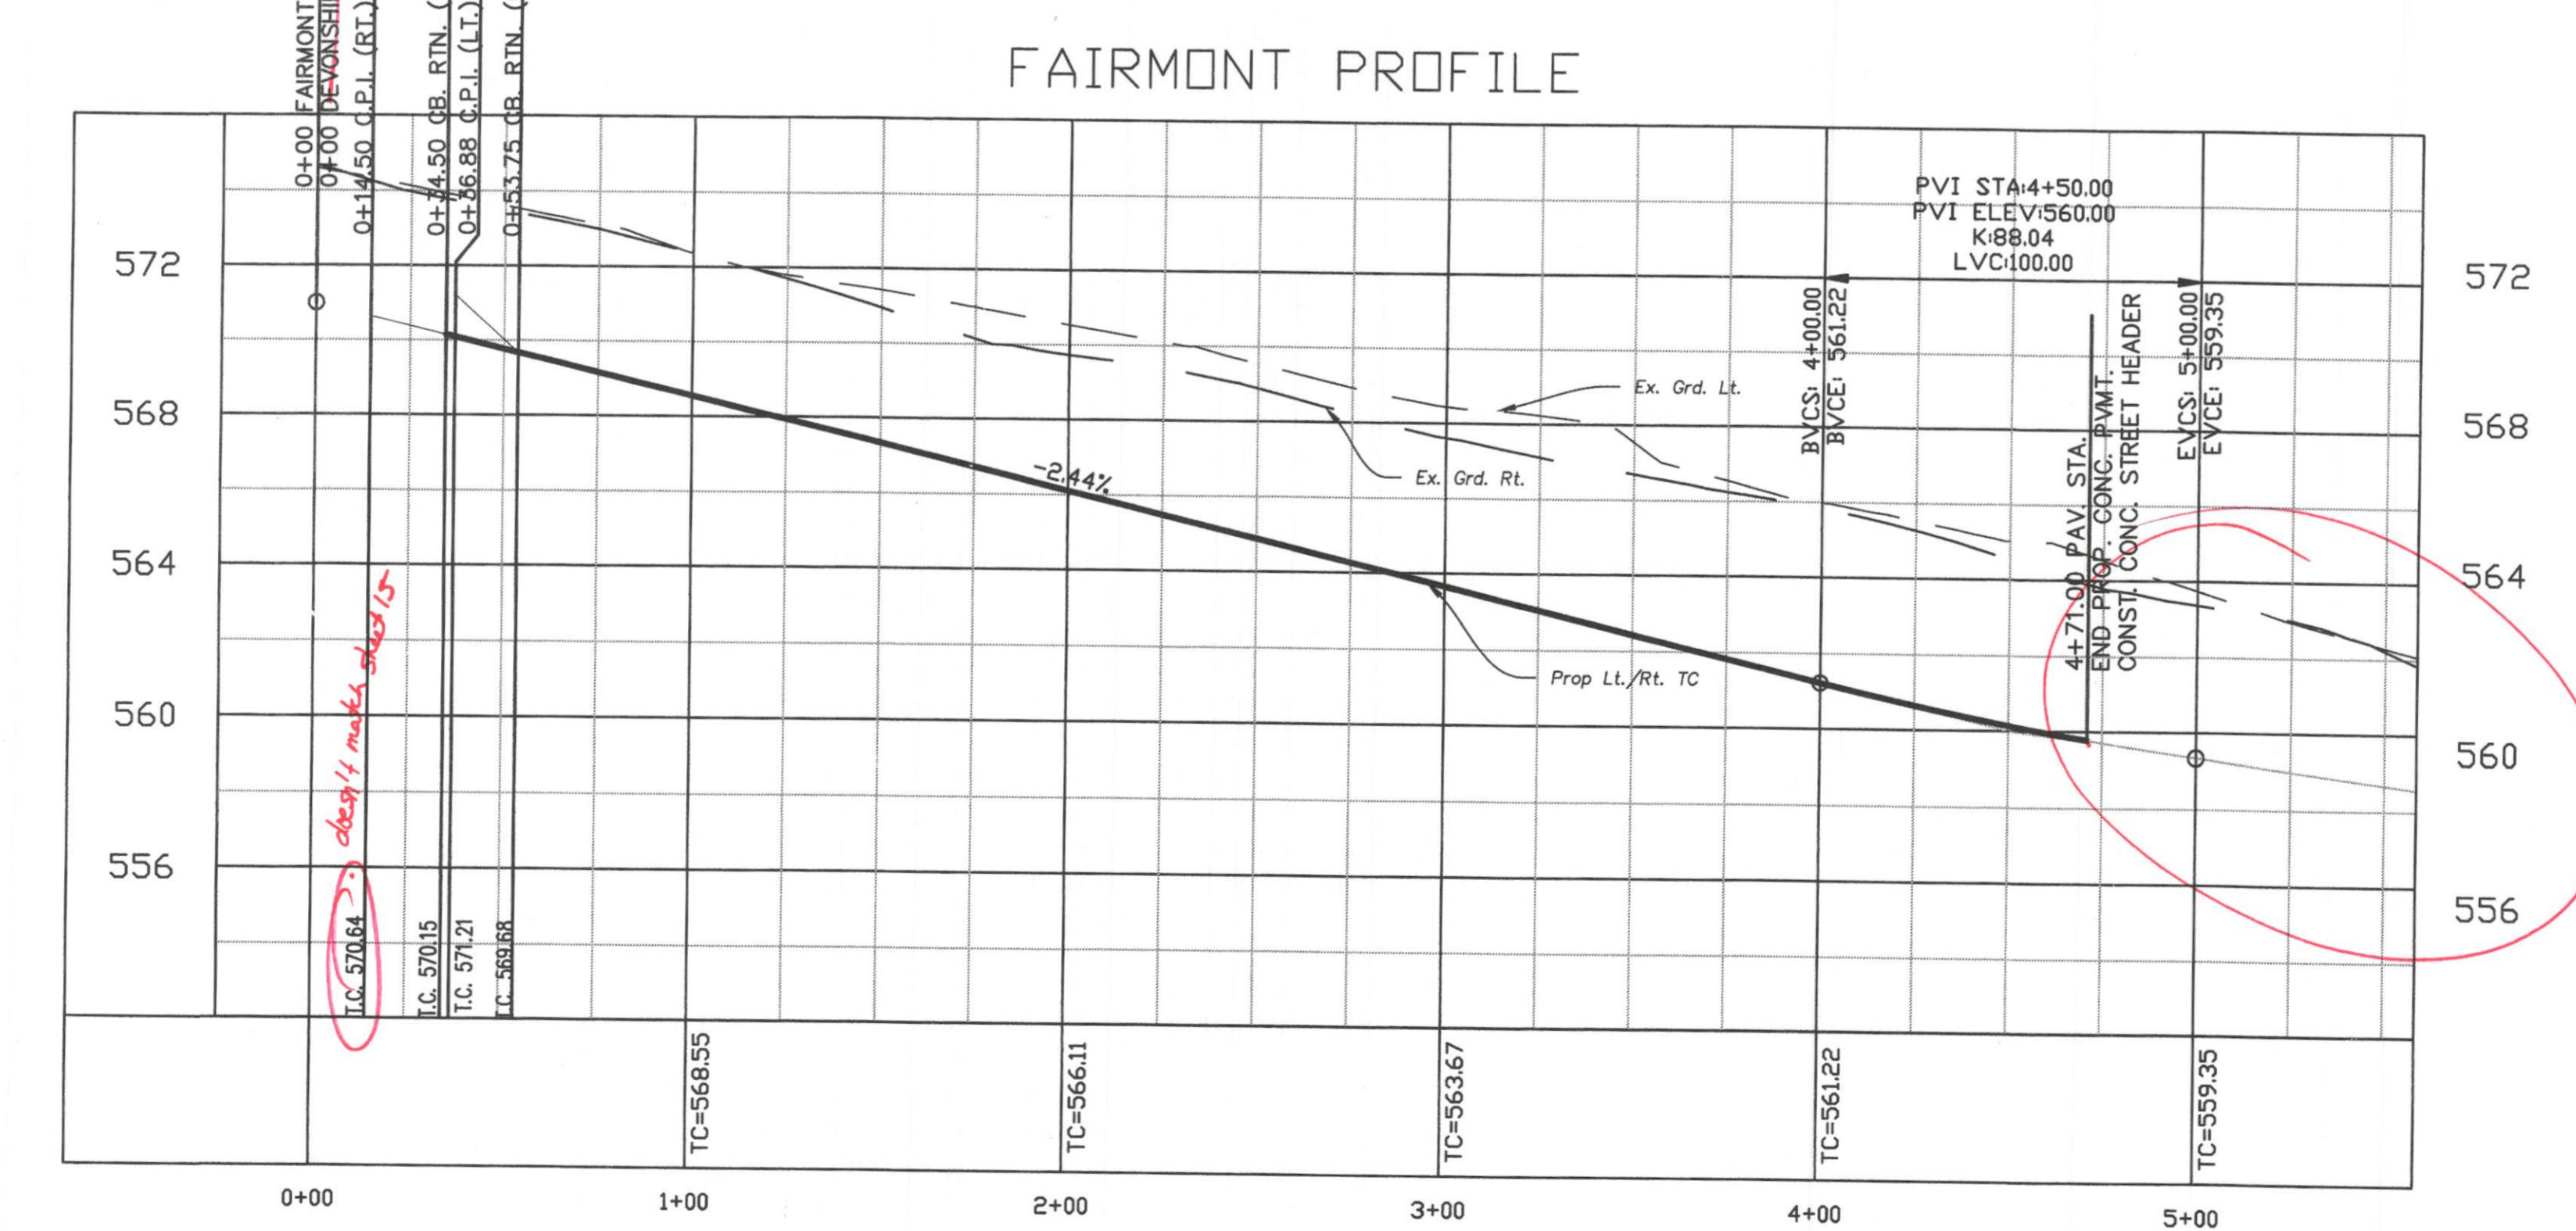

*need profile
need temp
road east*

*where does
drainage go?
see sheet*

Revision	Date	Description

Owner:
SPRING HAVEN INVESTMENTS, INC.
6750 HILLCREST PLAZA DR. • STE 325
DALLAS, TEXAS 75230 • Phone: 972-386-3333

**The
Highlands**

F.C. CUNY CORPORATION
#2 Horizon Court • Ste. 500 • Heath, Texas 75032
Phone: 469-402-7700
Fax: 469-402-0700

THE SEAL APPEARING ON THIS DOCUMENT WAS AUTHORIZED BY CHRISTOPHER R. CUNY, P.E. 65642



Drawn By: MSC	Checked By: JW
Date: 09/25/2007	Project No.: 06-004
Sheet Title: Fairmont Street Paving Plan & Profile	
Scale: 1" = 40'	Sheet No.: 14 of 61