
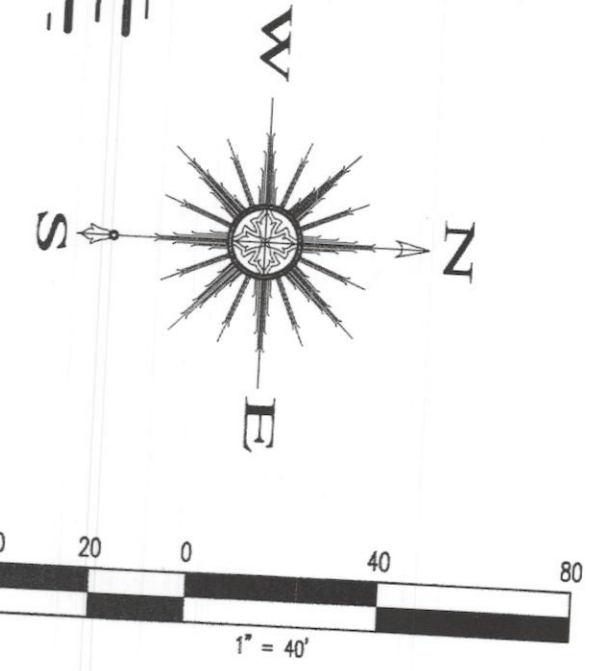


CURVE TABLE

CURVE	LENGTH	RADIUS	DELTA	TANGENT	CHORD	BEARING
C72	314.39'	720.00	25°01'06"	158.74'	311.80'	N12°00'54\"/>
C73	141.48'	280.00	28°57'04"	72.28'	139.98'	S13°58'53\"/>

CANON DR PROFILE

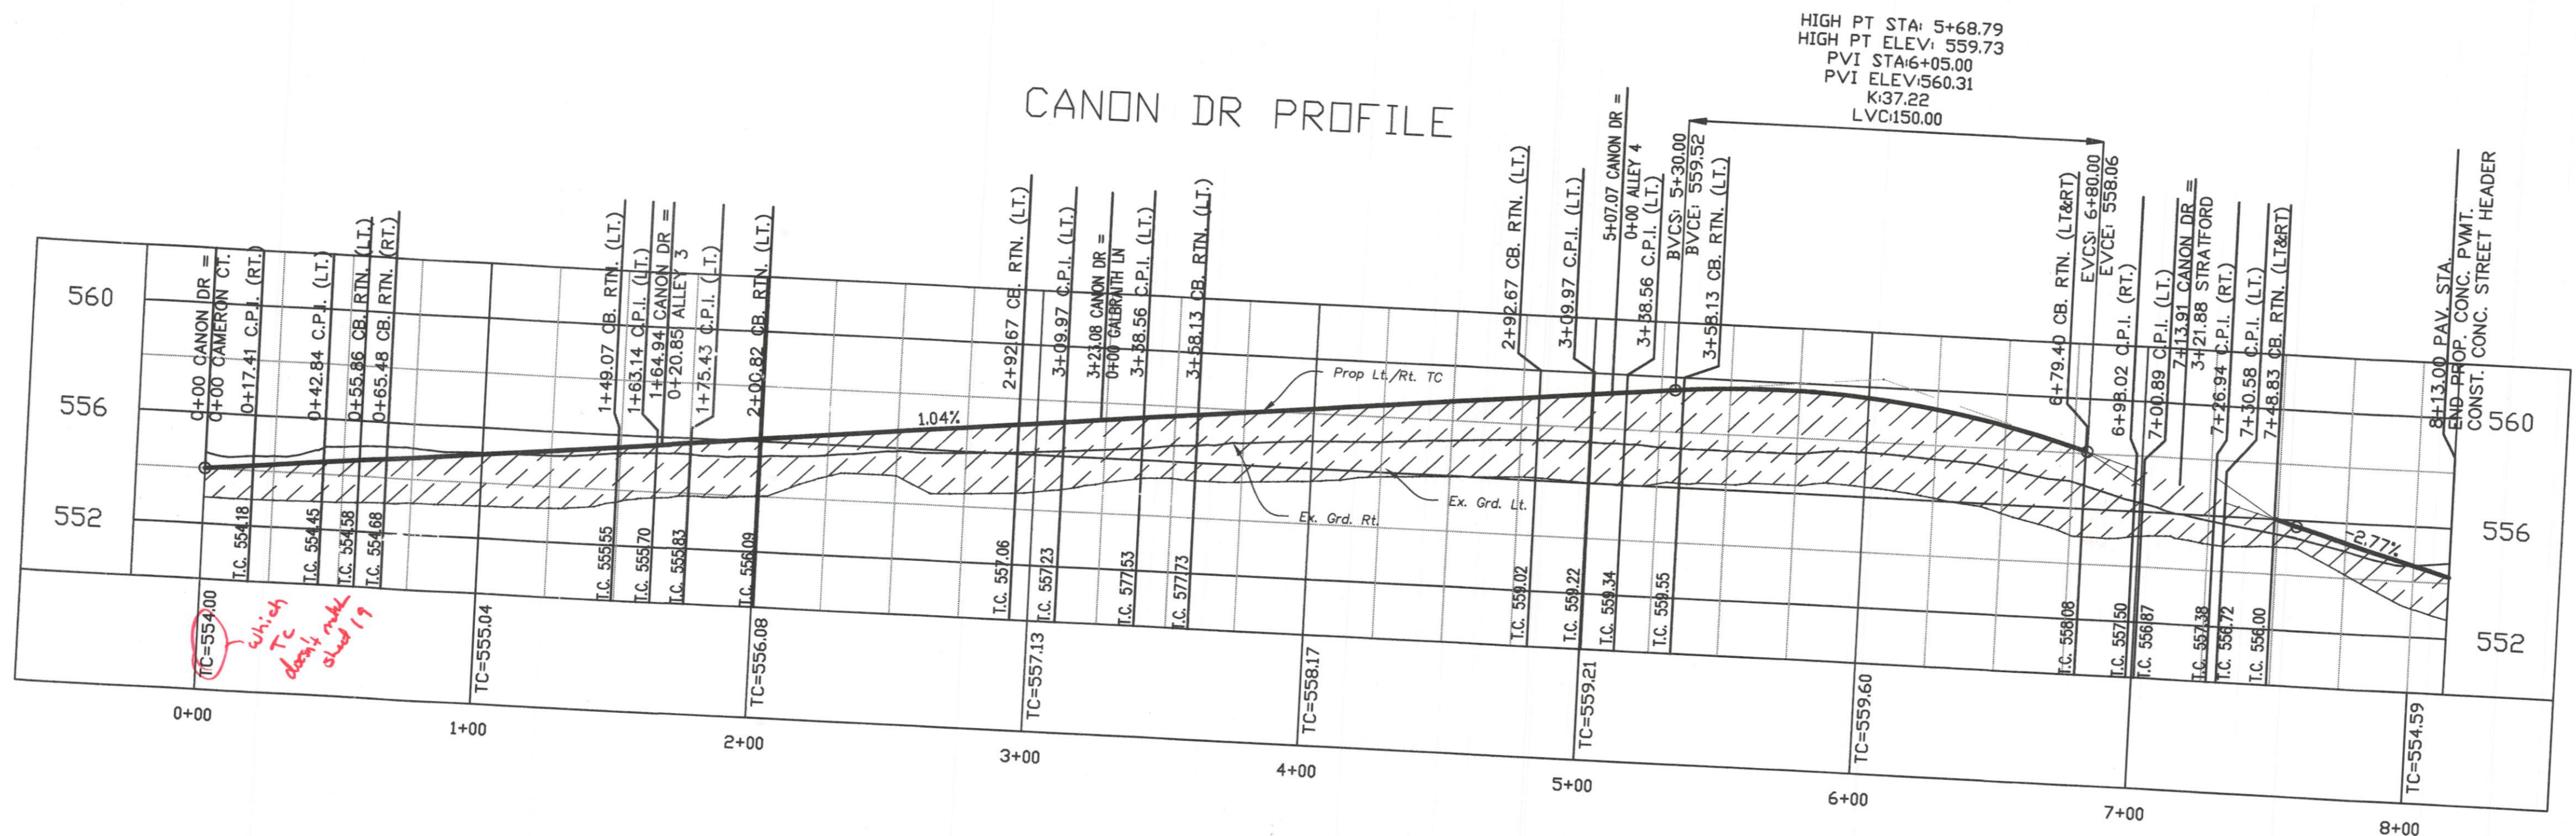


Revision	Date	Description

Owner:
SPRING HAVEN INVESTMENTS, INC.
 6750 HILLCREST PLAZA DR. • STE 325
 DALLAS, TEXAS 75230 • Phone: 972-386-3333

The Highlands

F.C. CUNY CORPORATION
 #2 Horizon Court • Ste. 500 • Heath, Texas 75032
 Phone: 469-402-7700
 Fax: 469-402-0700

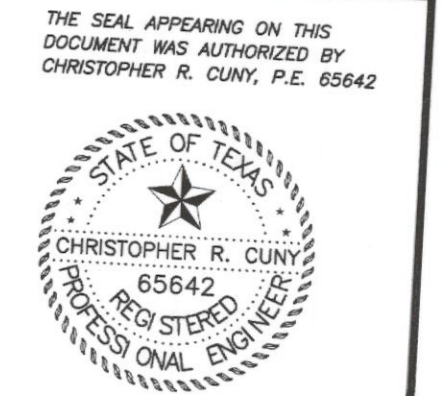

Drawn By: MSC	Checked By: JW
Date: 09/25/2007	Project No.: 06-004
Sheet Title: Canon Street Paving Plan & Profile	
Scale: 1" = 40'	Sheet No.: 17 of 61