


Revision	Date	Description


Owner:  
**SPRING HAVEN INVESTMENTS, INC.**  
 6750 HILLCREST PLAZA DR. • STE 325  
 DALLAS, TEXAS 75230 • Phone: 972-386-3333

**The Highlands**

**F.C. CUNY CORPORATION**  
 #2 Horizon Court • Ste. 300 • Heath, Texas 75032  
 Phone: 469-402-7700  
 Fax: 469-402-0700


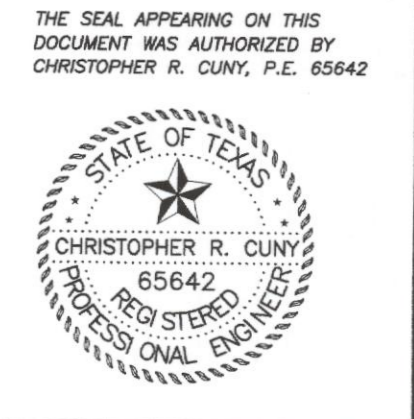


Drawn By: MSC  
 Checked By: JW  
 Date: 09/25/2007  
 Project No.: 08-004  
 Sheet Title:  
**Kerry Lane Paving Plan & Profile**  
 Scale: 1" = 40'  
 Sheet No.: 20 of 61

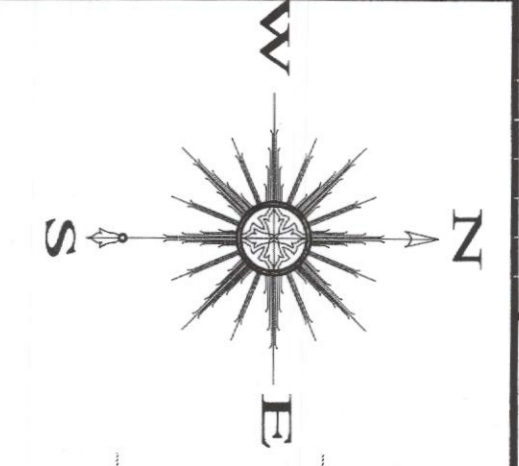


HWY 276

*advised?*

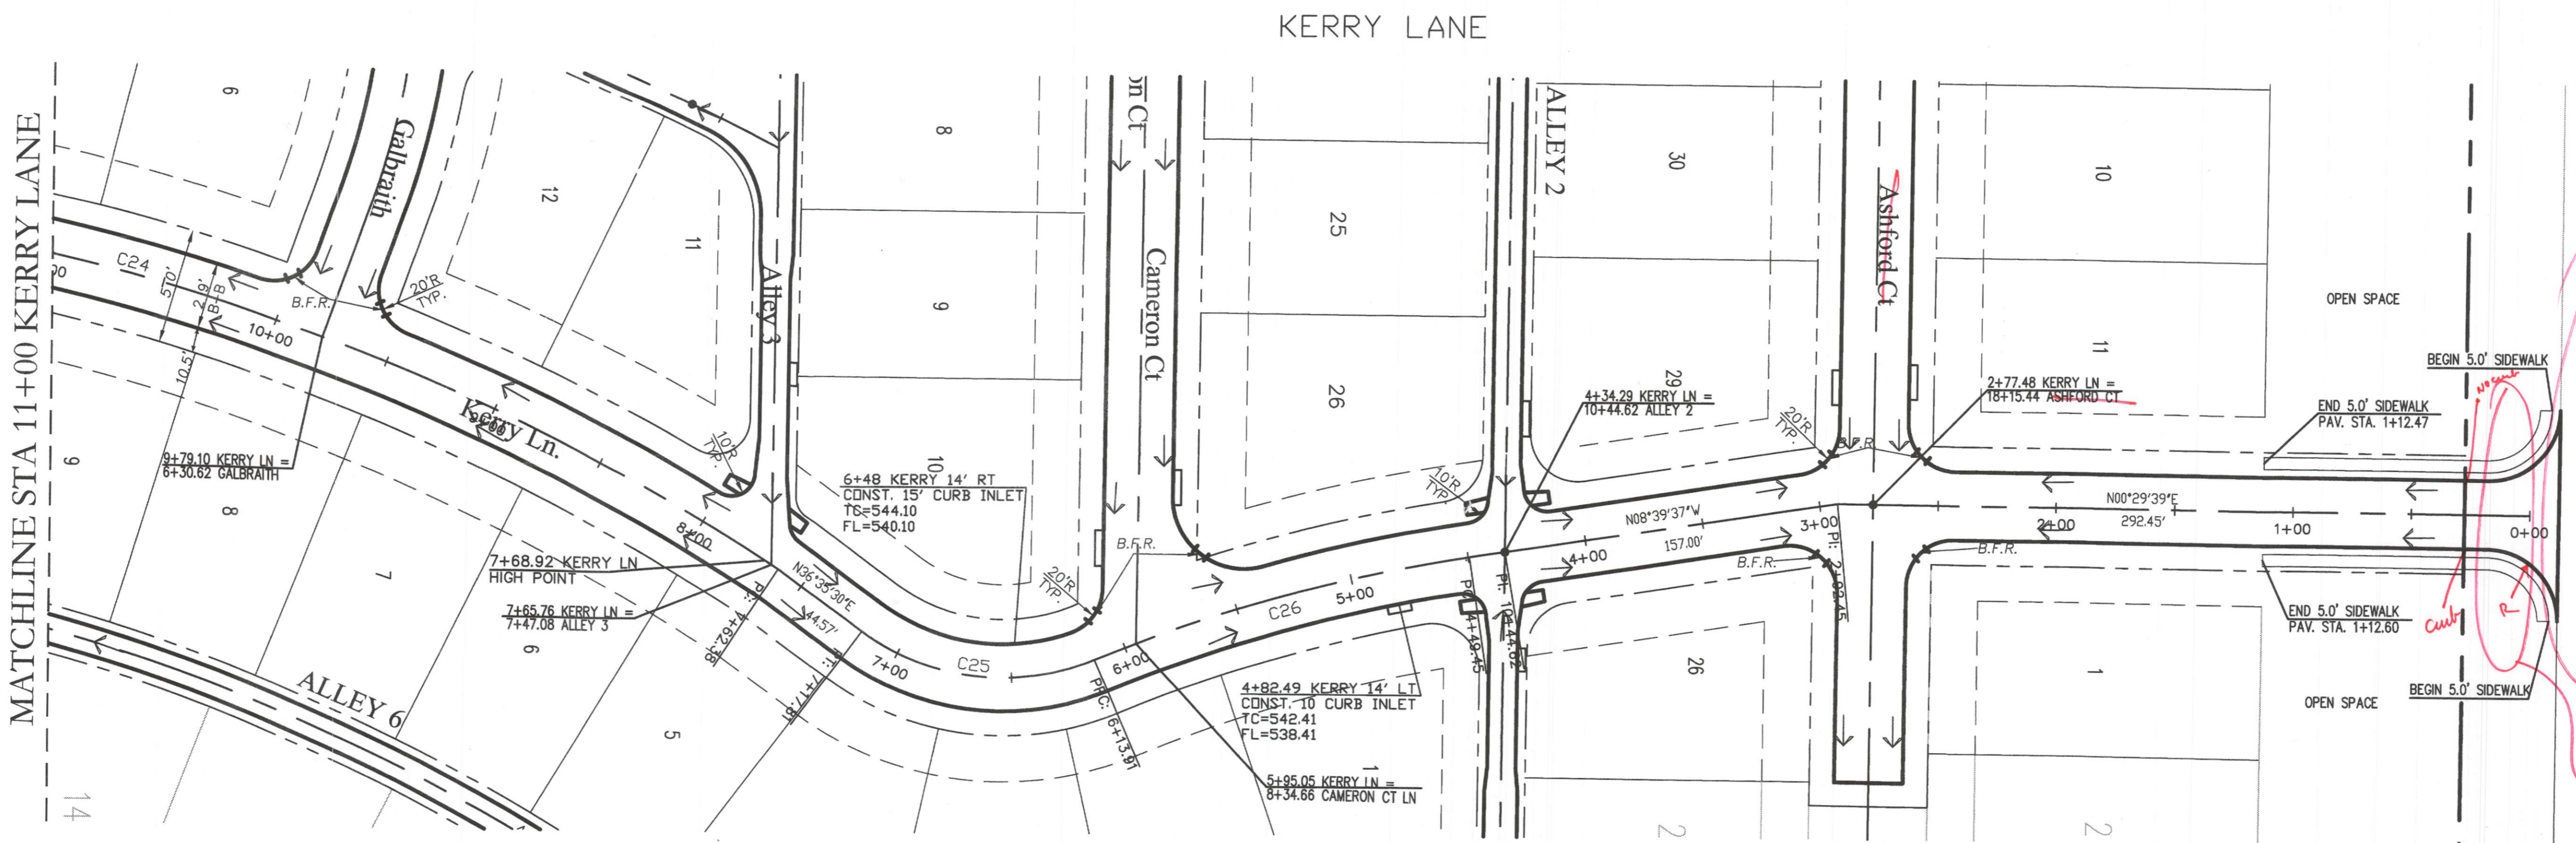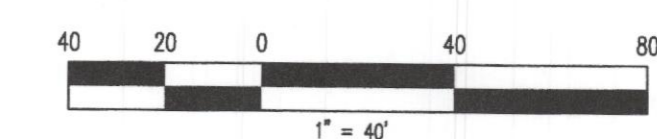

MATCHLINE STA 11+00 KERRY LANE

KERRY LN

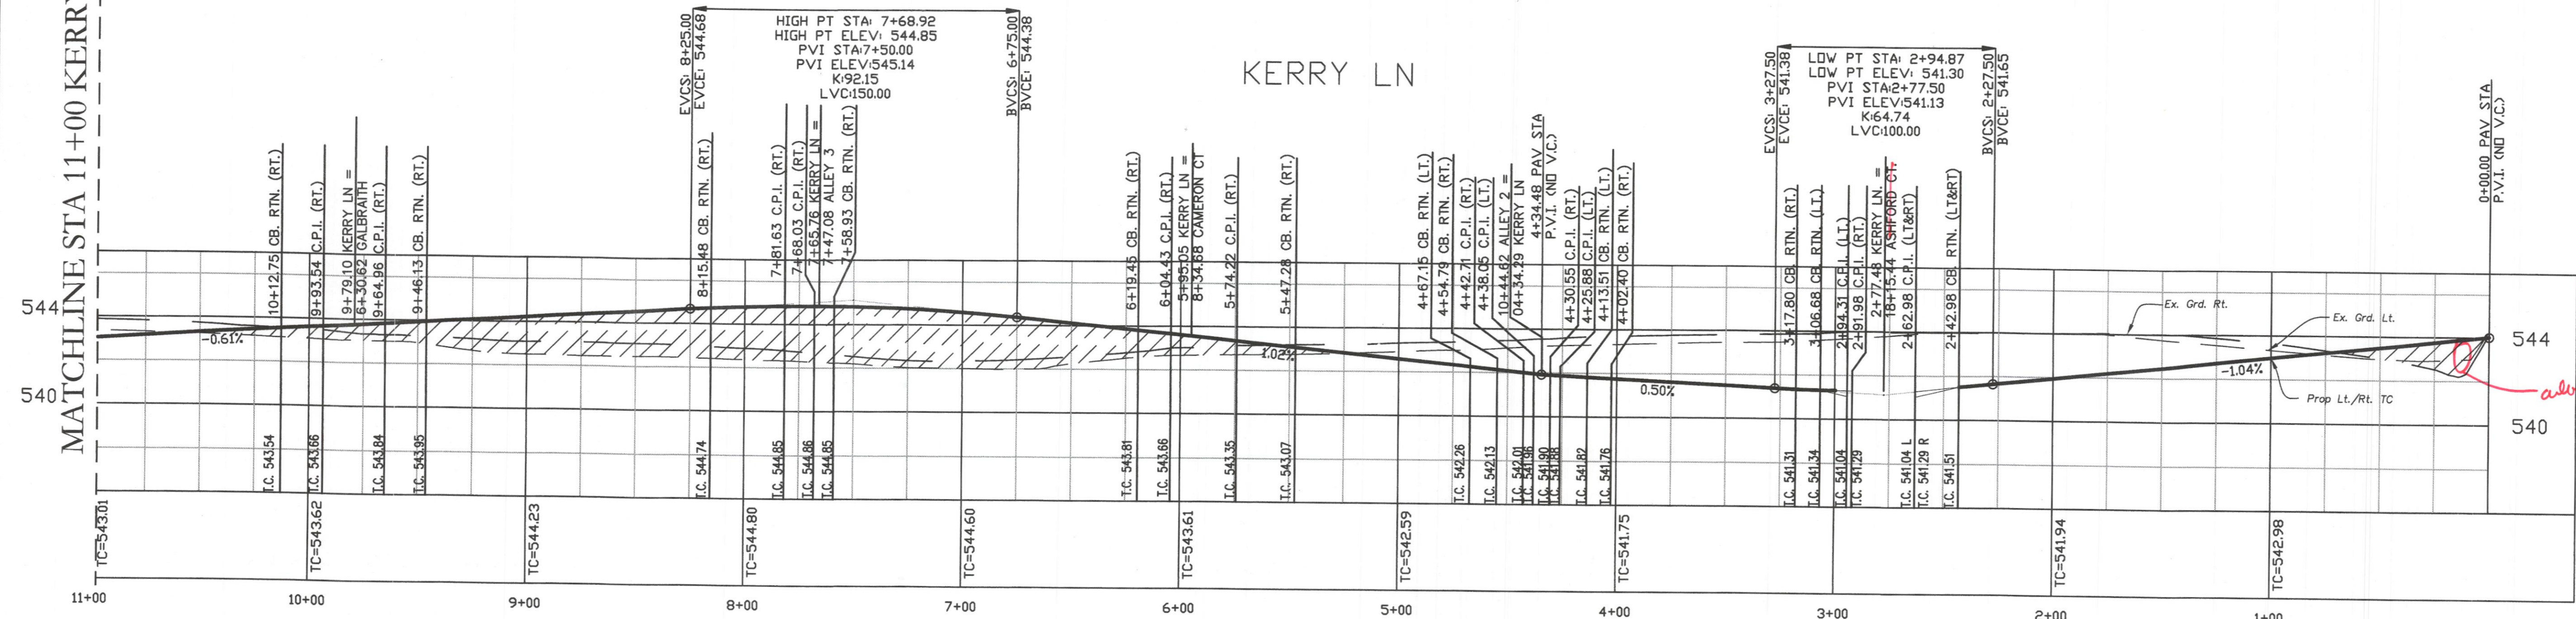

CURVE	LENGTH	RADIUS	DELTA	TANGENT	CHORD	BEARING
C24	802.36'	959.79'	35°57'31"	311.47'	592.52'	S14°46'27"W
C25	103.90'	100.00'	59°31'44"	57.19'	99.29'	N06°49'38"E
C26	164.46'	660.00'	14°16'37"	82.66'	164.03'	S15°47'56"E