

Revision	Date	Description

Owner:
SPRING HAVEN INVESTMENTS, INC.
 6750 HILLCREST PLAZA DR. • STE 325
 DALLAS, TEXAS 75230 • Phone: 972-386-3333


The Highlands

F.C. CUNY CORPORATION
 #2 Horizon Court • Ste. 300 • Heath, Texas 75022
 Phone: 469-402-7700
 Fax: 469-402-0700


THE SEAL APPEARING ON THIS DOCUMENT WAS AUTHORIZED BY CHRISTOPHER R. CUNY, P.E. 65642



Drawn By: MSC	Checked By: JW
Date: 09/25/2007	Project No.: 08-004
Sheet Title: Storm Drain Line C Plan & Profile (0+00-5+50)	
Scale: 1" = 40'	Sheet No.: 36 of 61

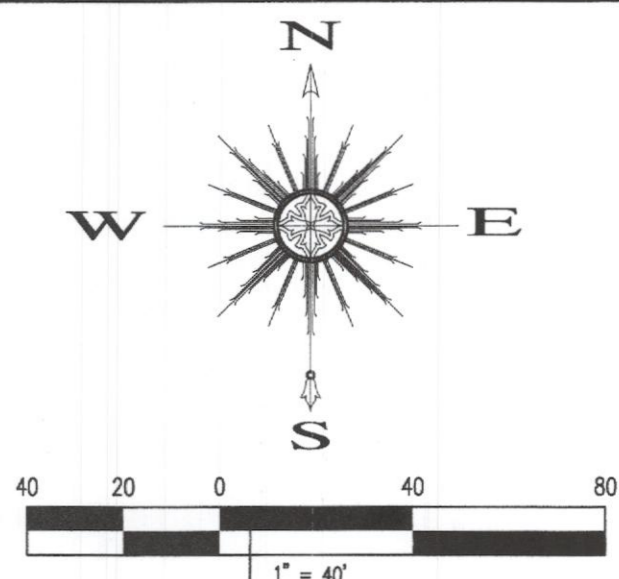


Storm Drain Line C

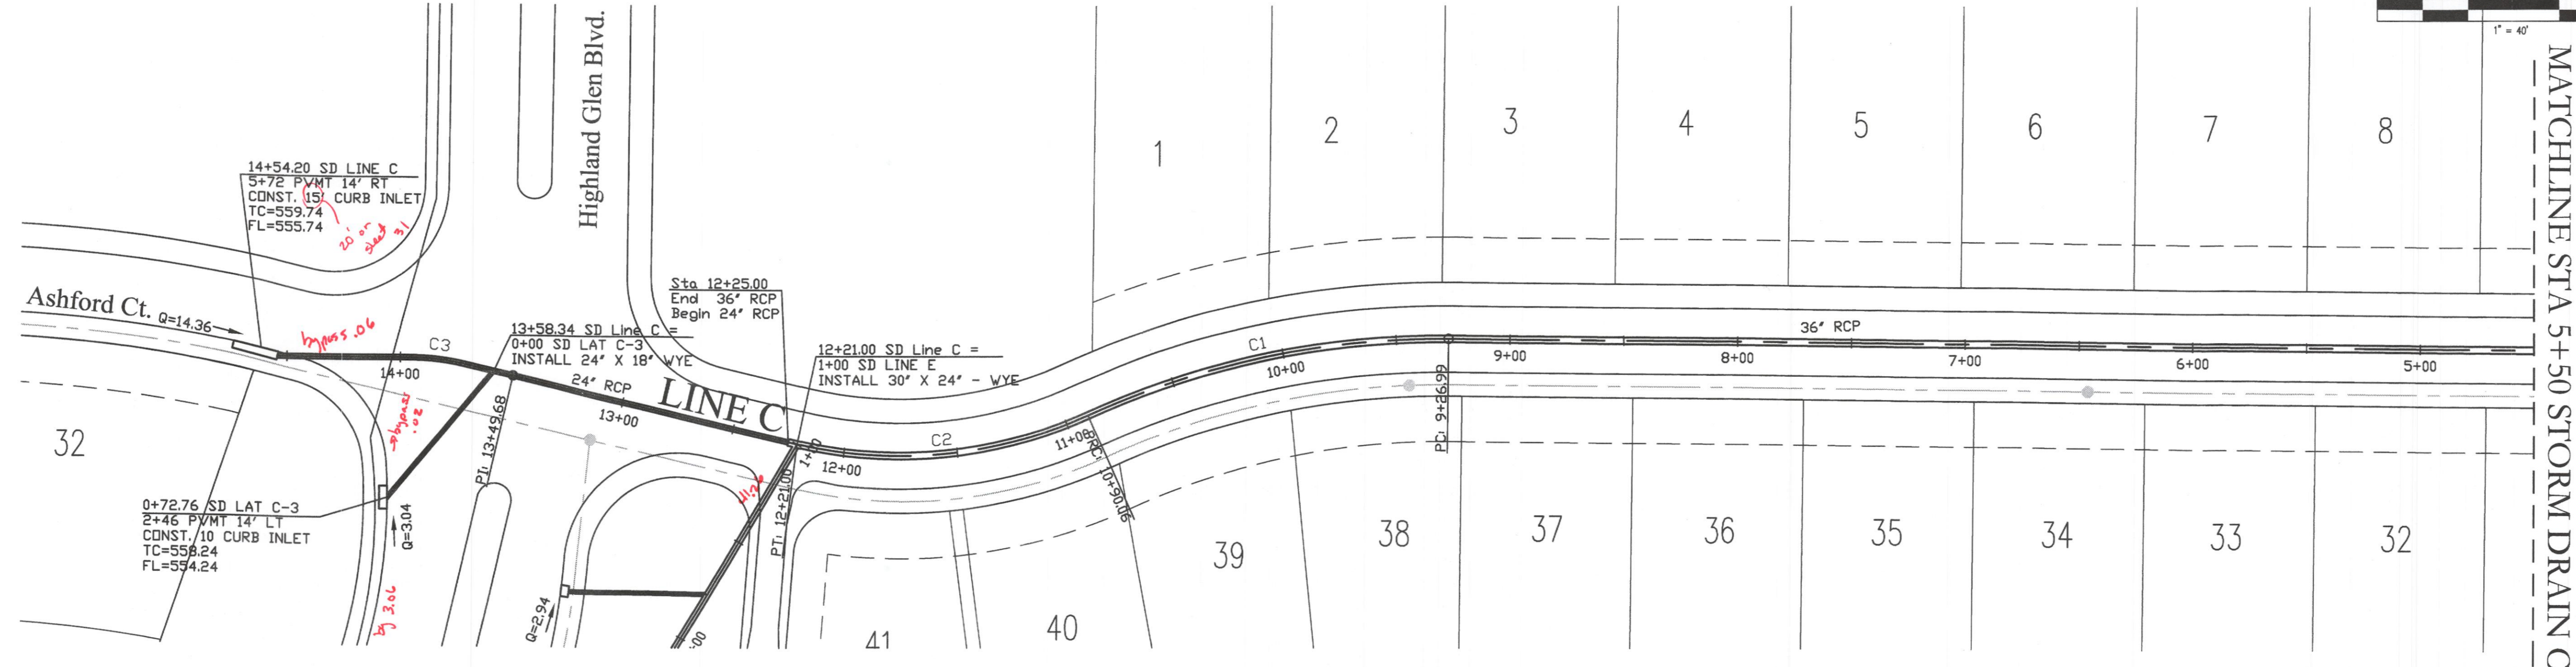

CURVE	DELTA	RADIUS	LENGTH	CHORD	BEARING
C1	24°54'54"	375.00	163.07	161.79	S 78°2'13" W
C2	37°30'49"	200.00	130.95	128.62	N 84°20'10" E
C3	13°5'13"	100.00	22.84	22.79	N 83°27'23" W

SD Line C PROFILE

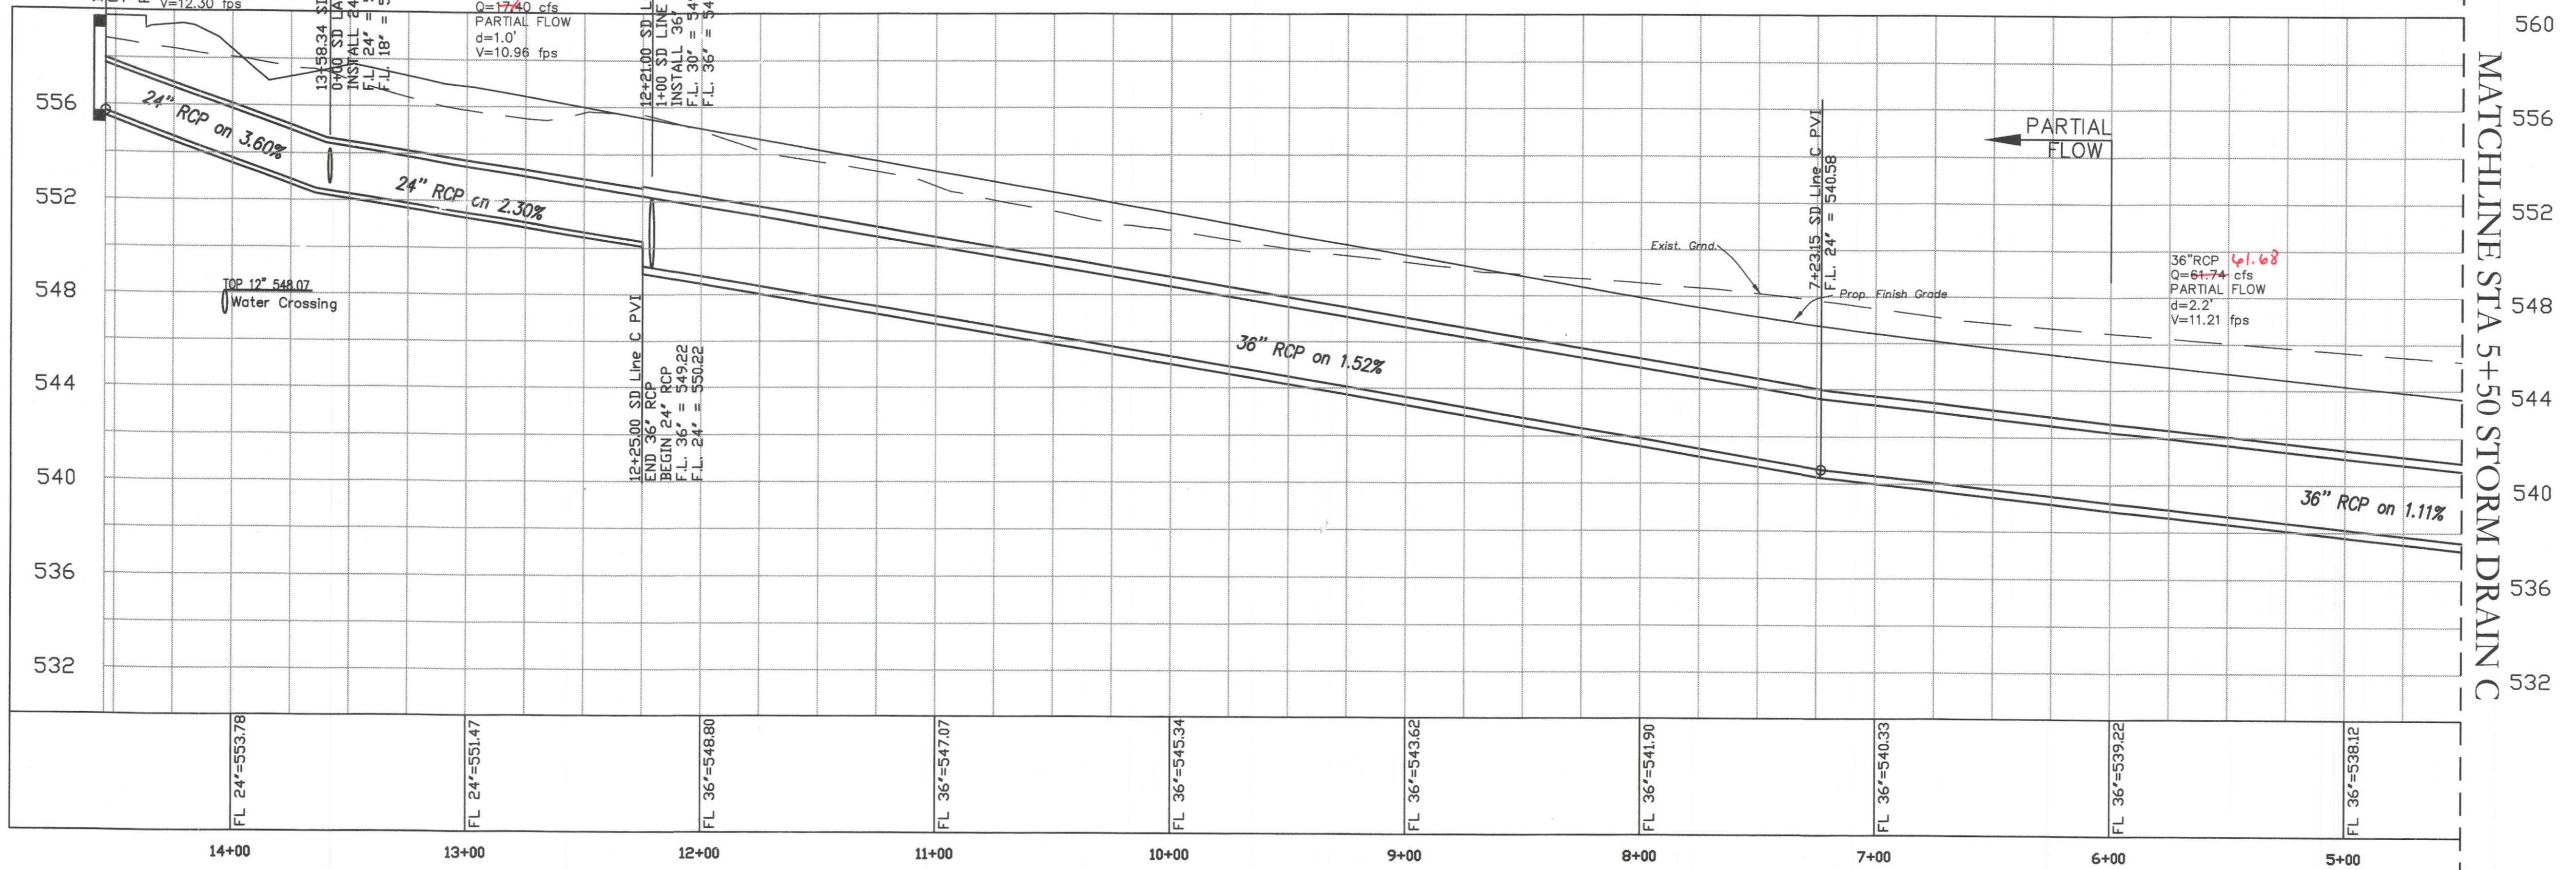

14+00	13+00	12+00	11+00	10+00	9+00	8+00	7+00	6+00	5+00
FL 24"=553.78	FL 24"=551.47	FL 36"=548.80	FL 36"=547.07	FL 36"=545.34	FL 36"=543.62	FL 36"=541.90	FL 36"=540.33	FL 36"=539.22	FL 36"=538.12