

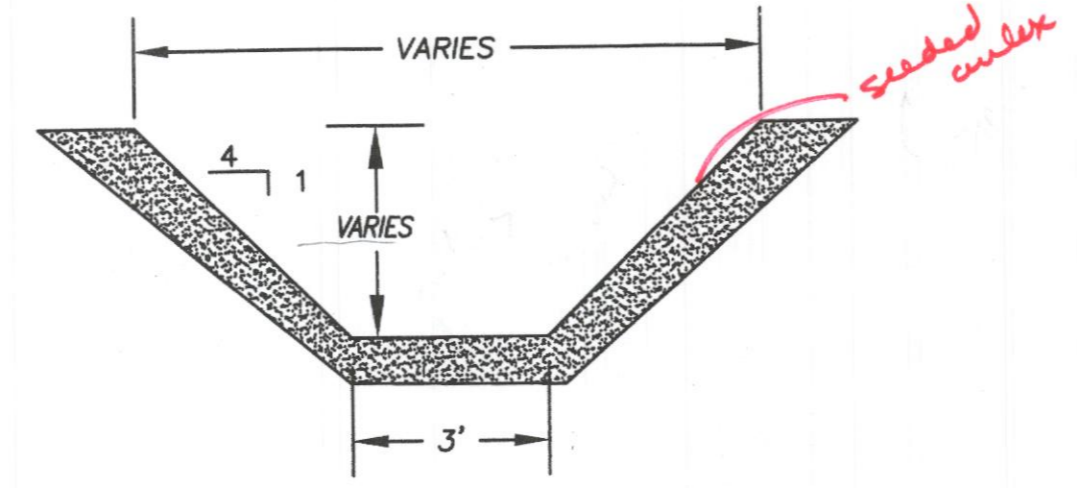
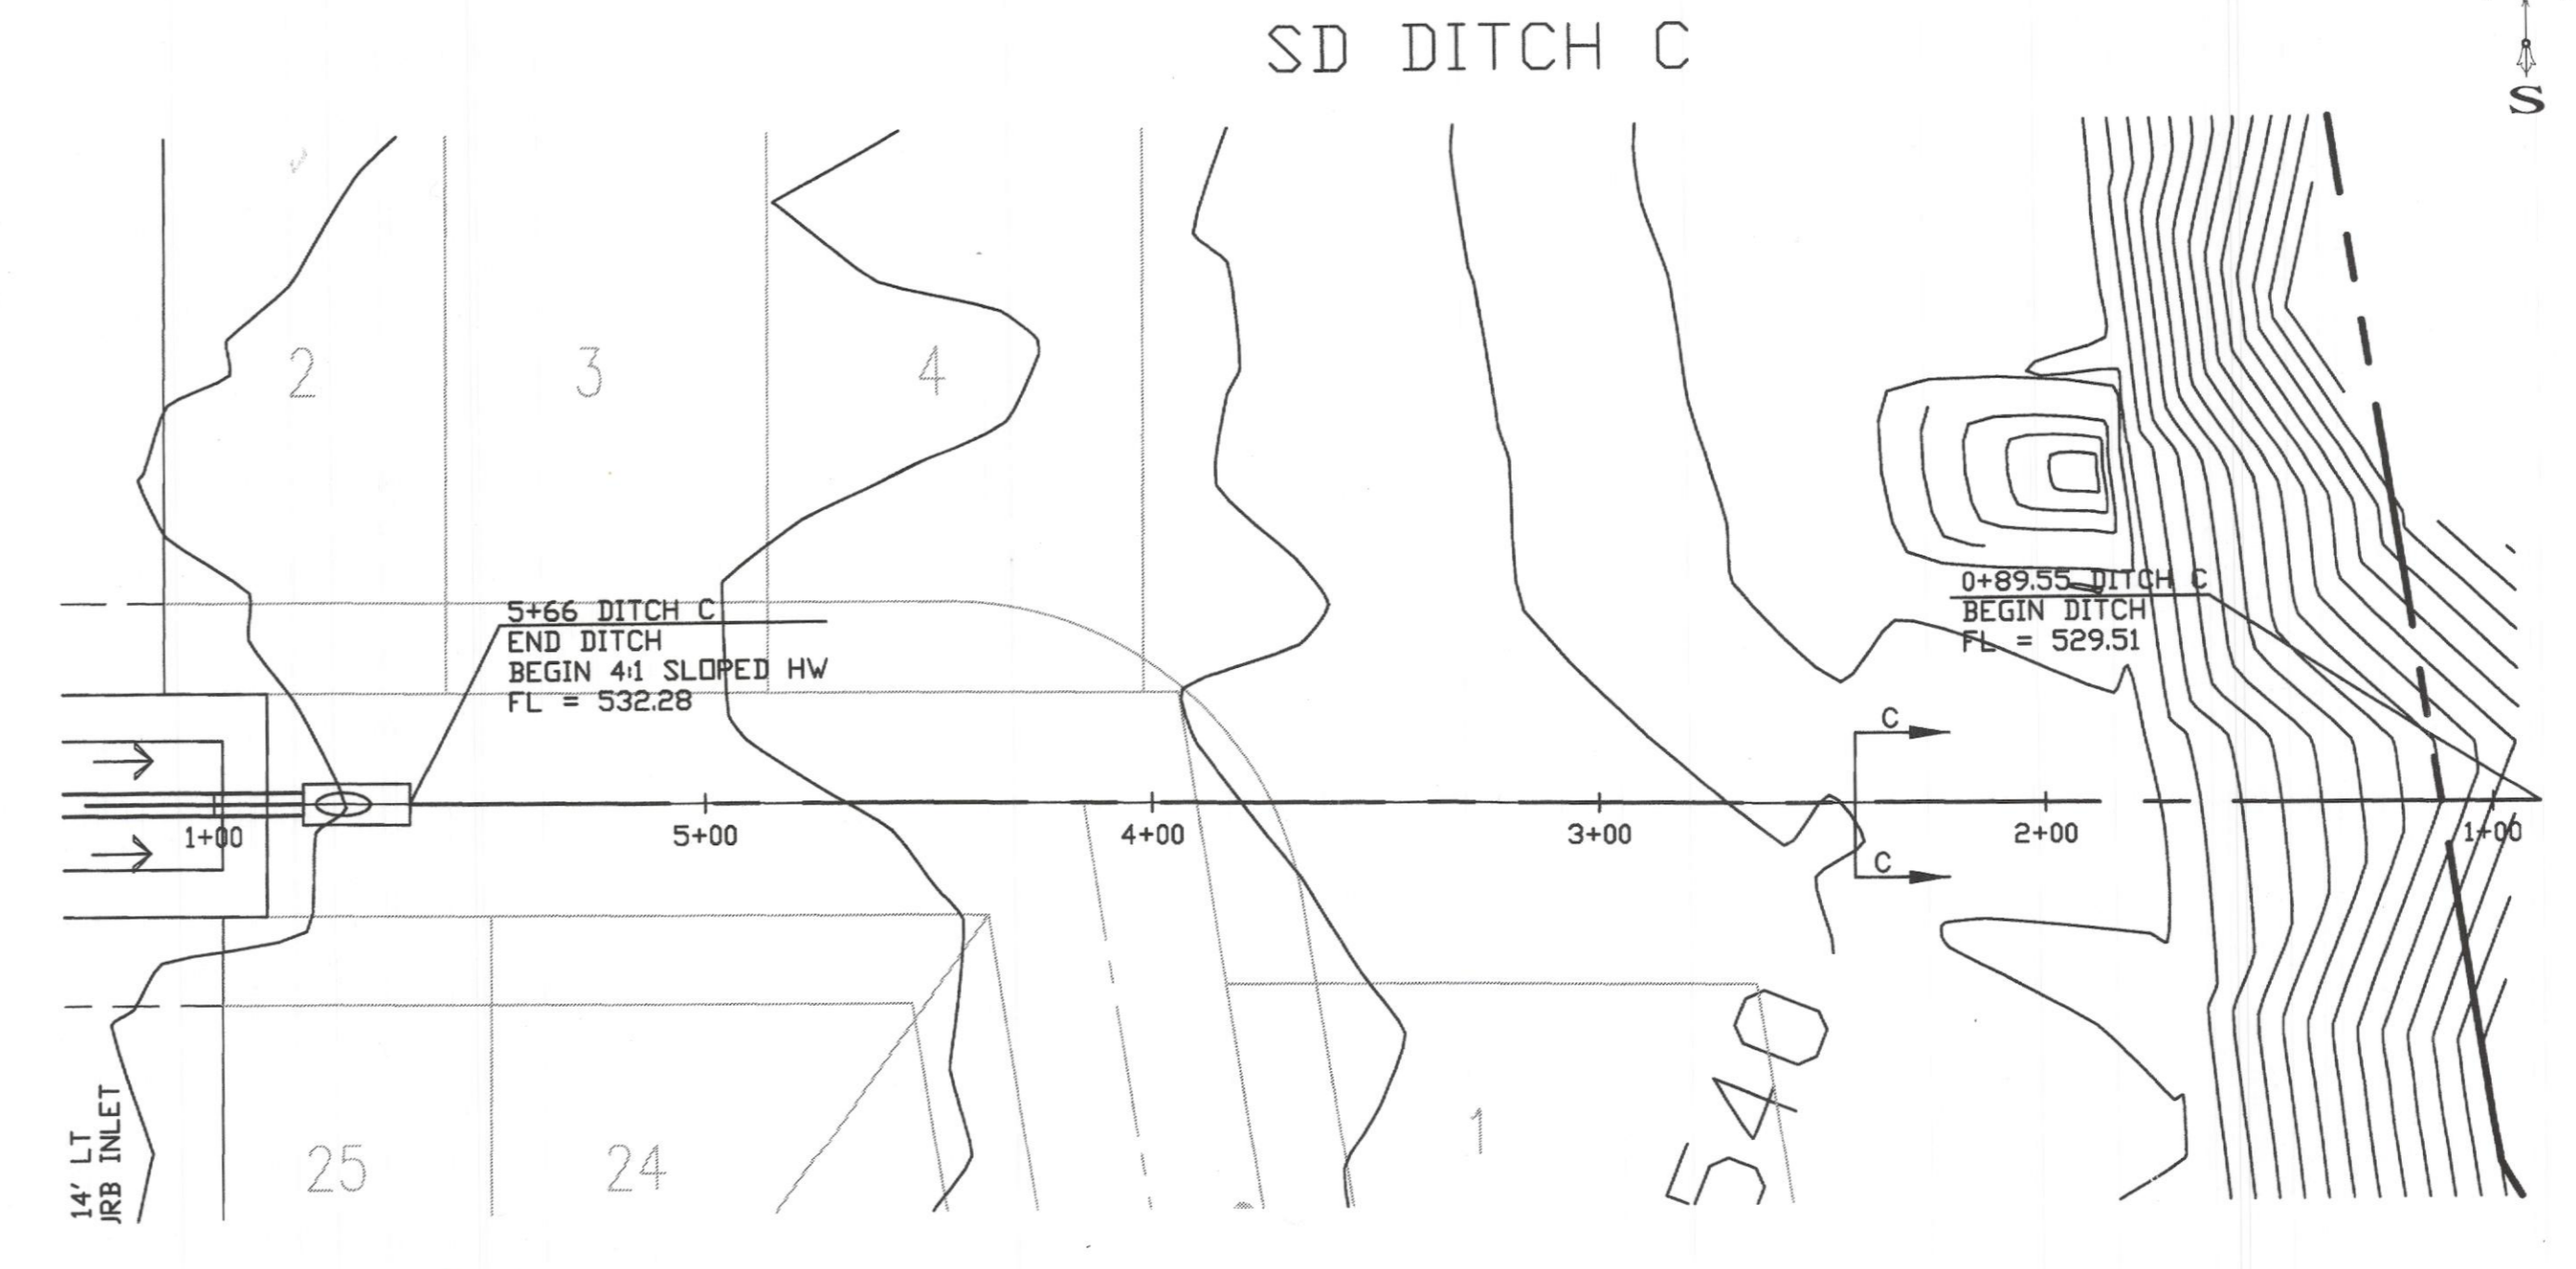
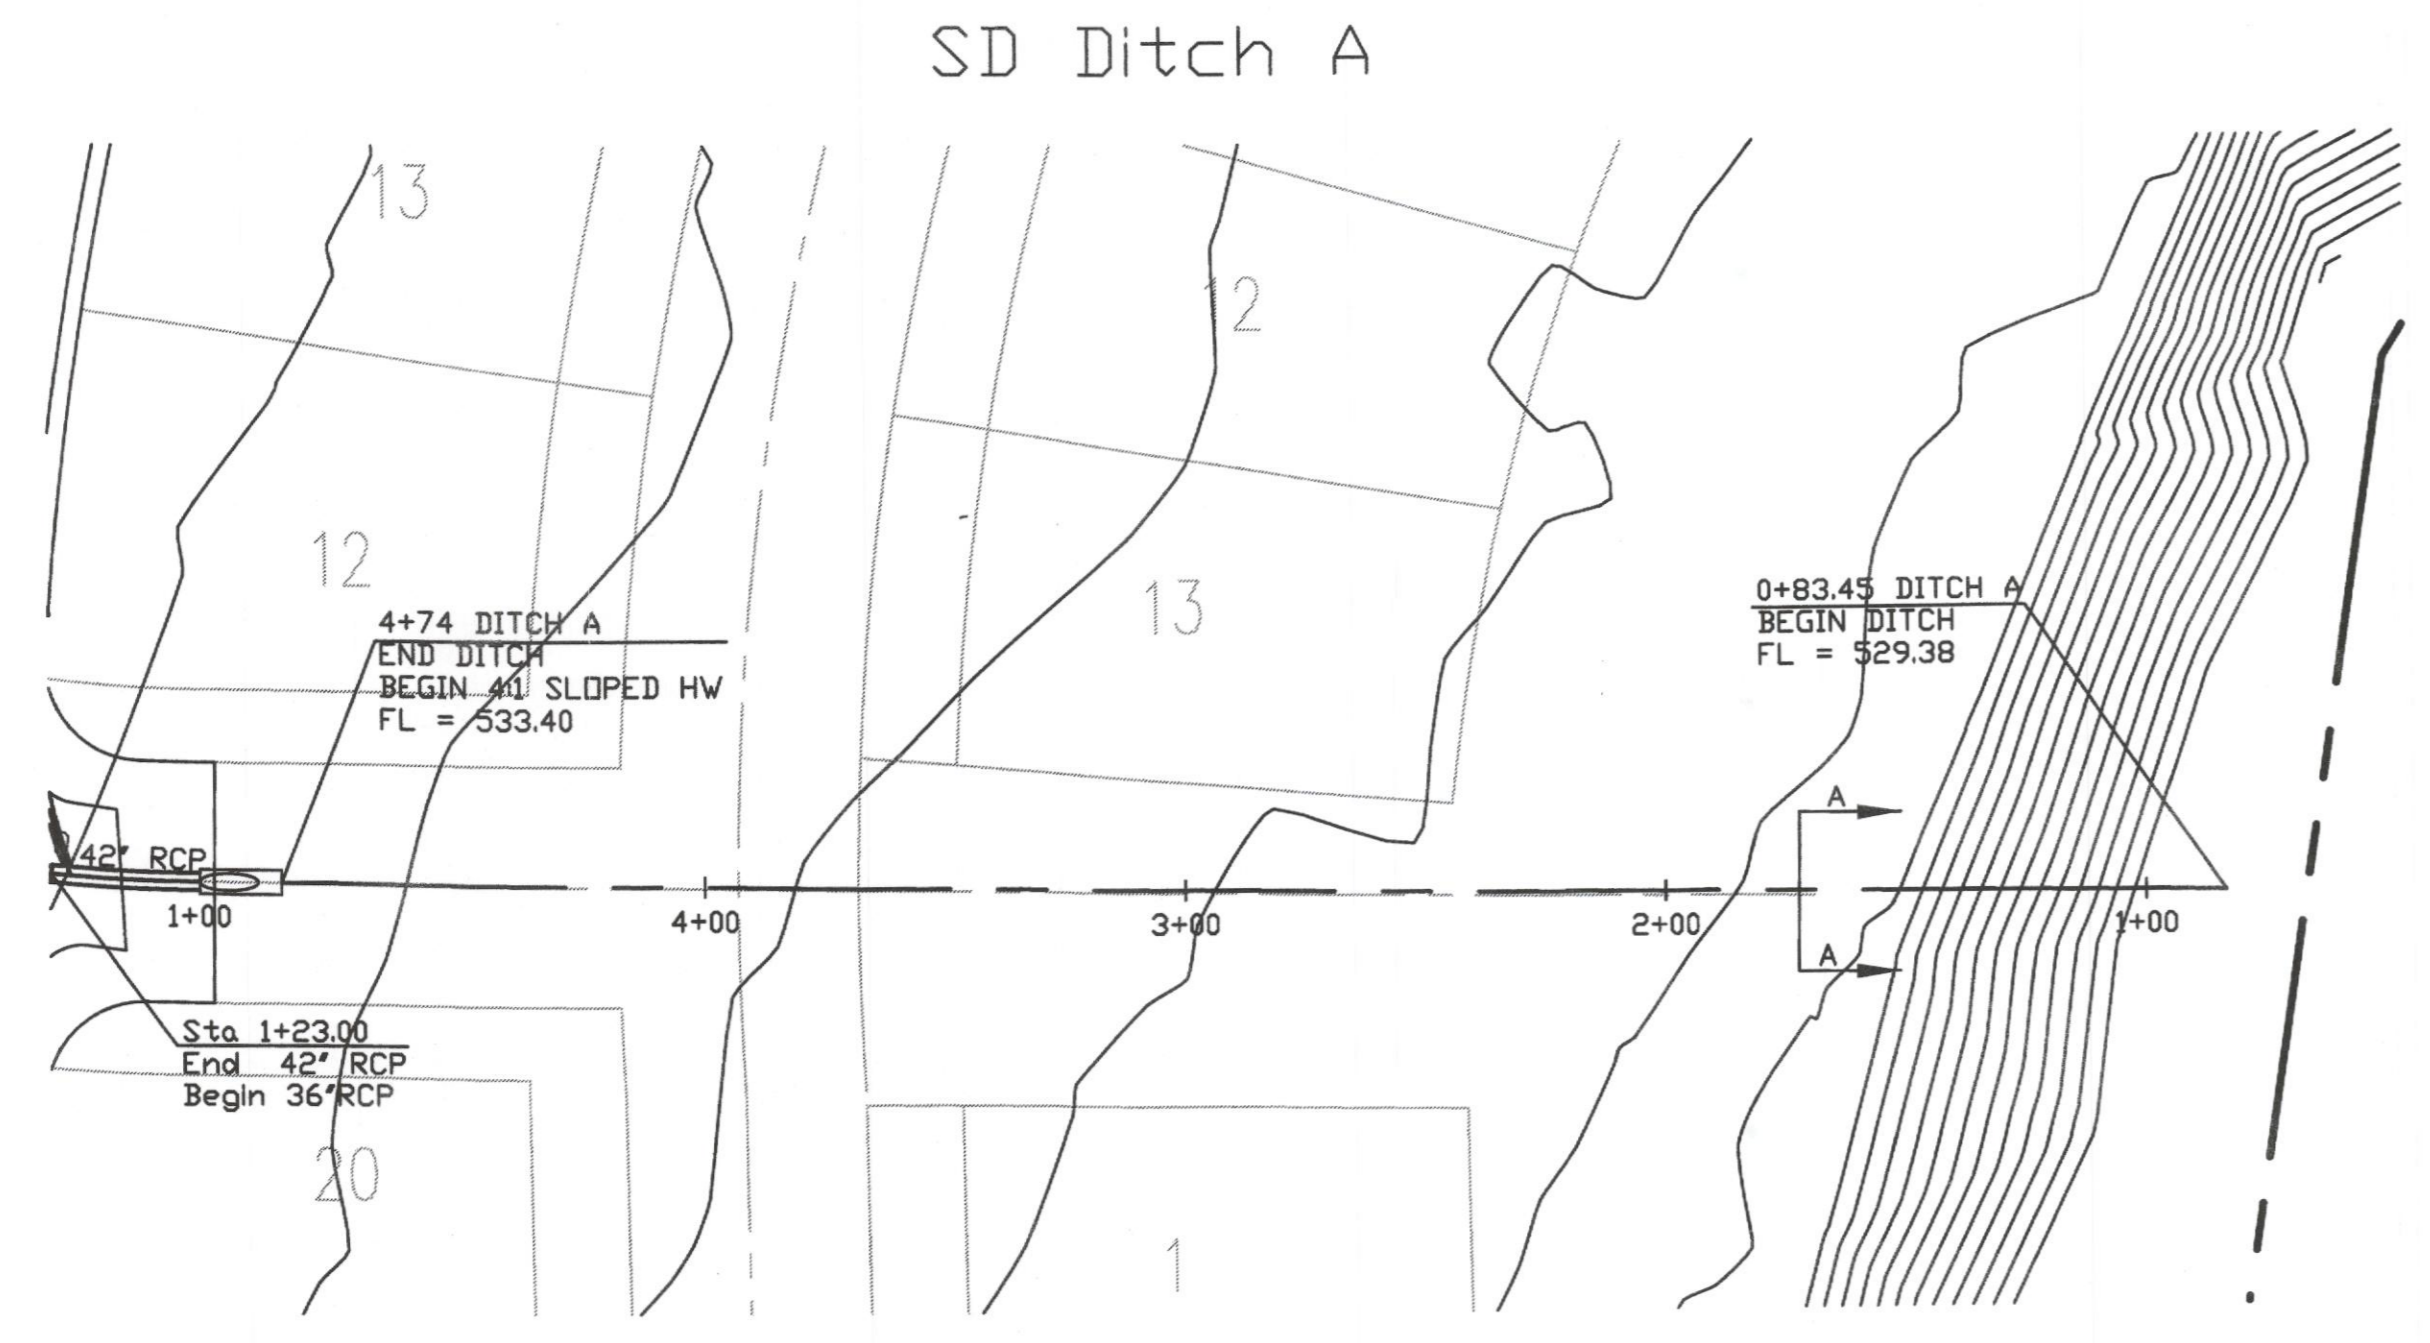
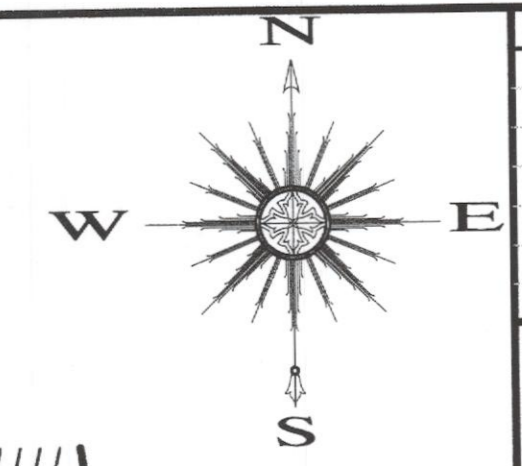


Revision	Date	Description

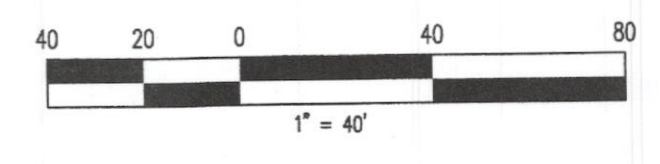


DITCH CROSS-SECTION
NTS

SD Ditch A PROFILE

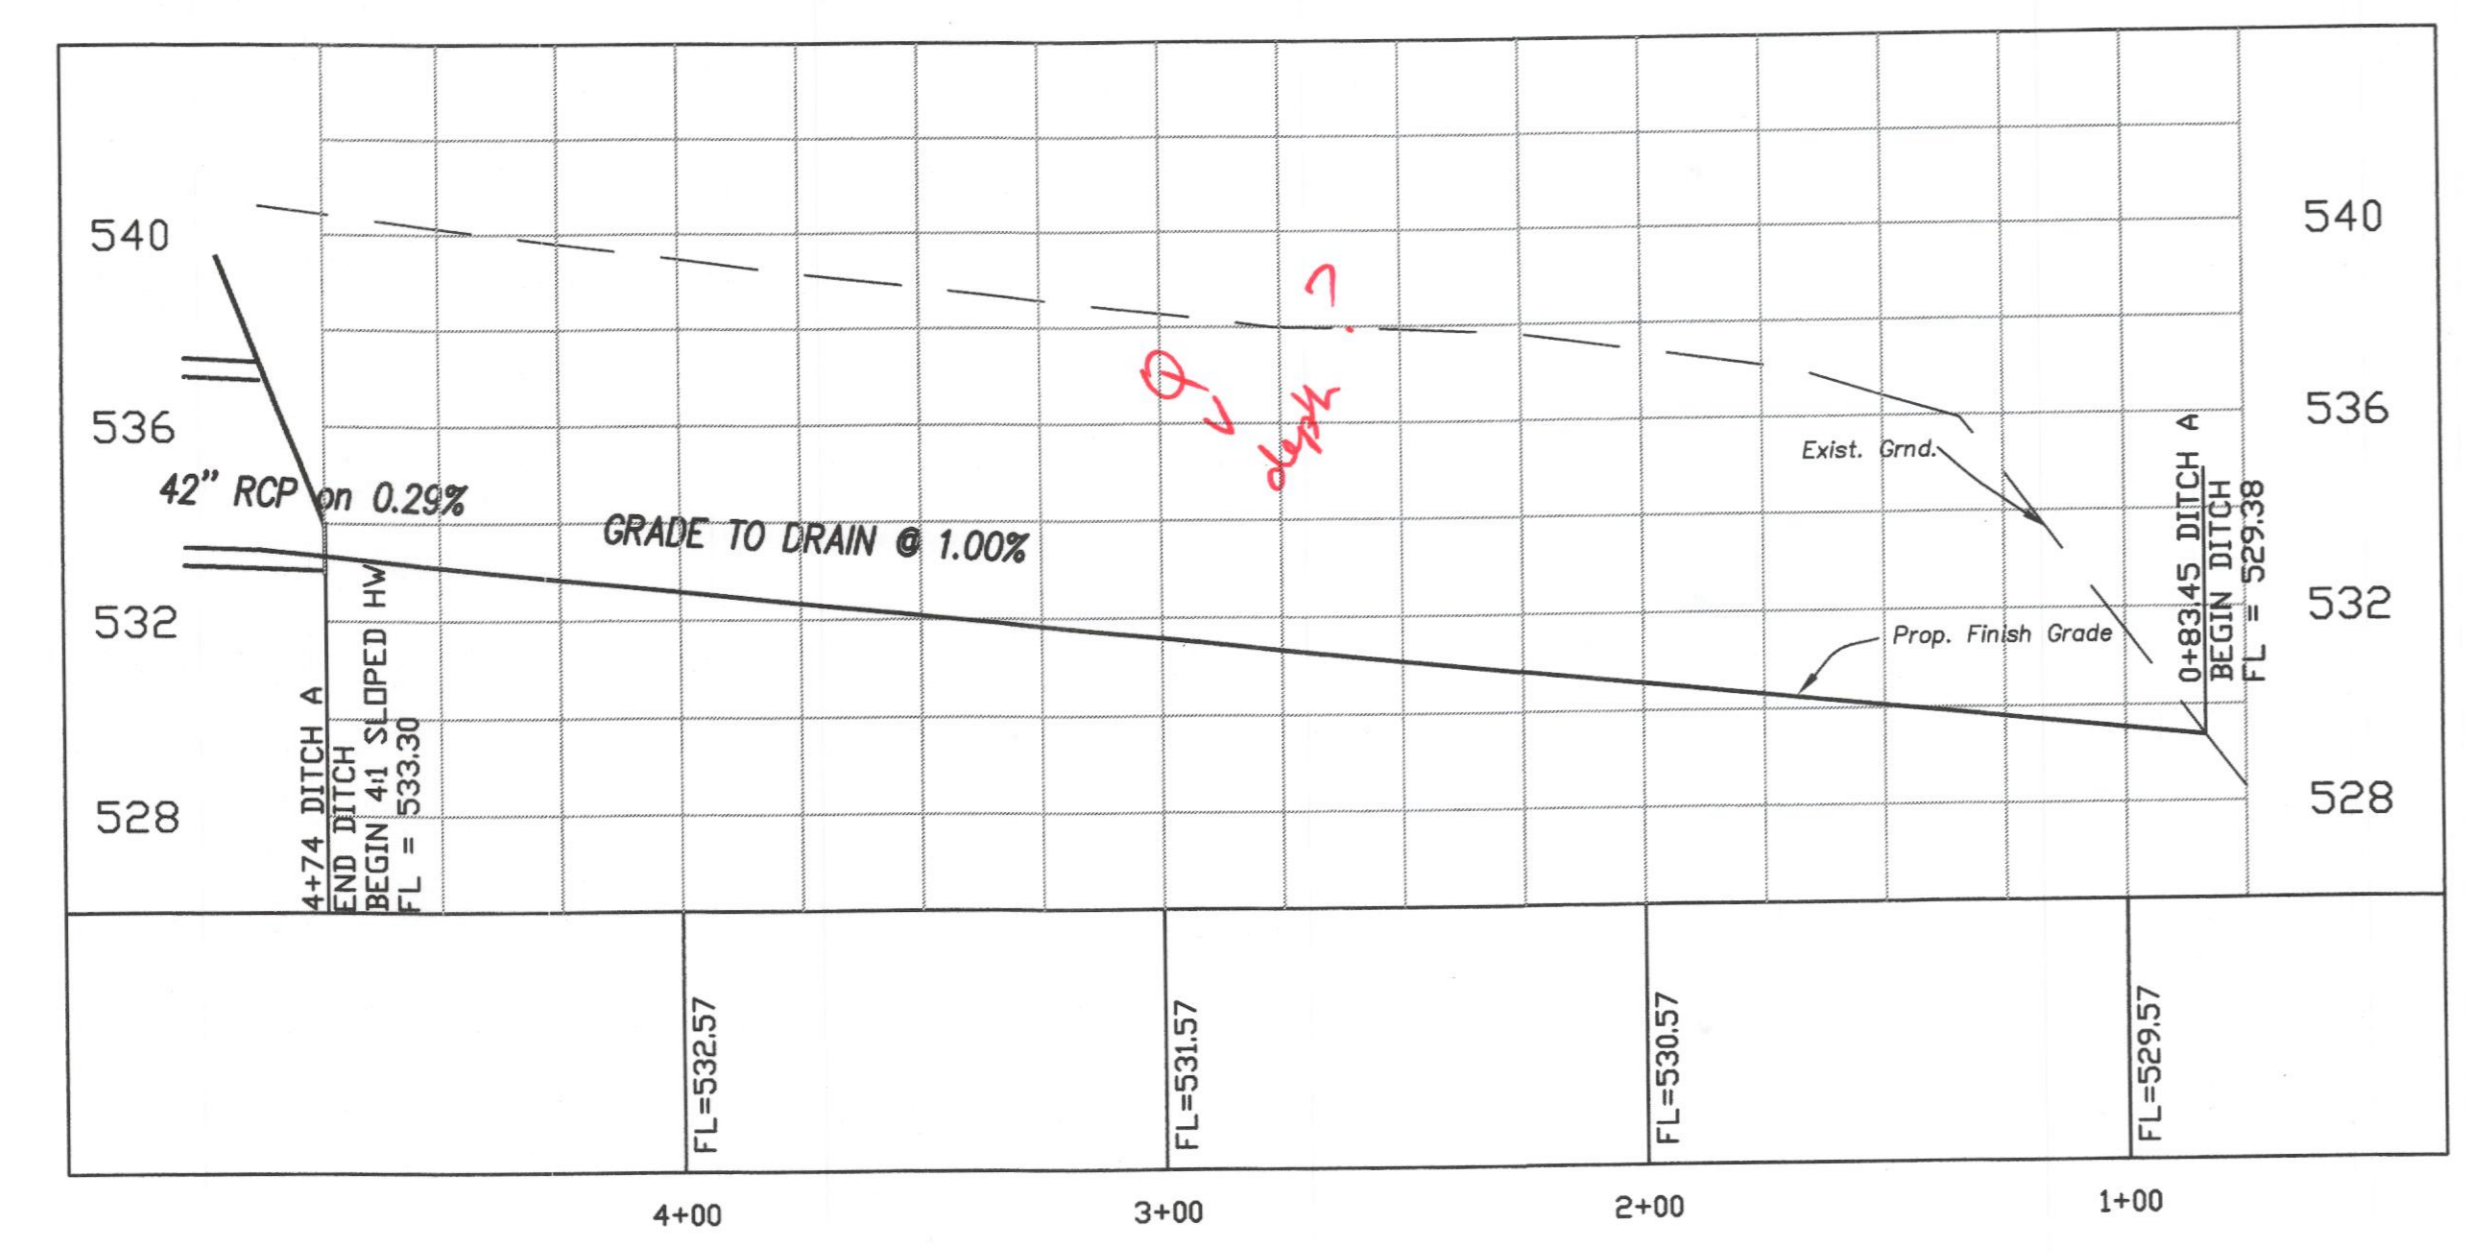


SD DITCH C PROFILE

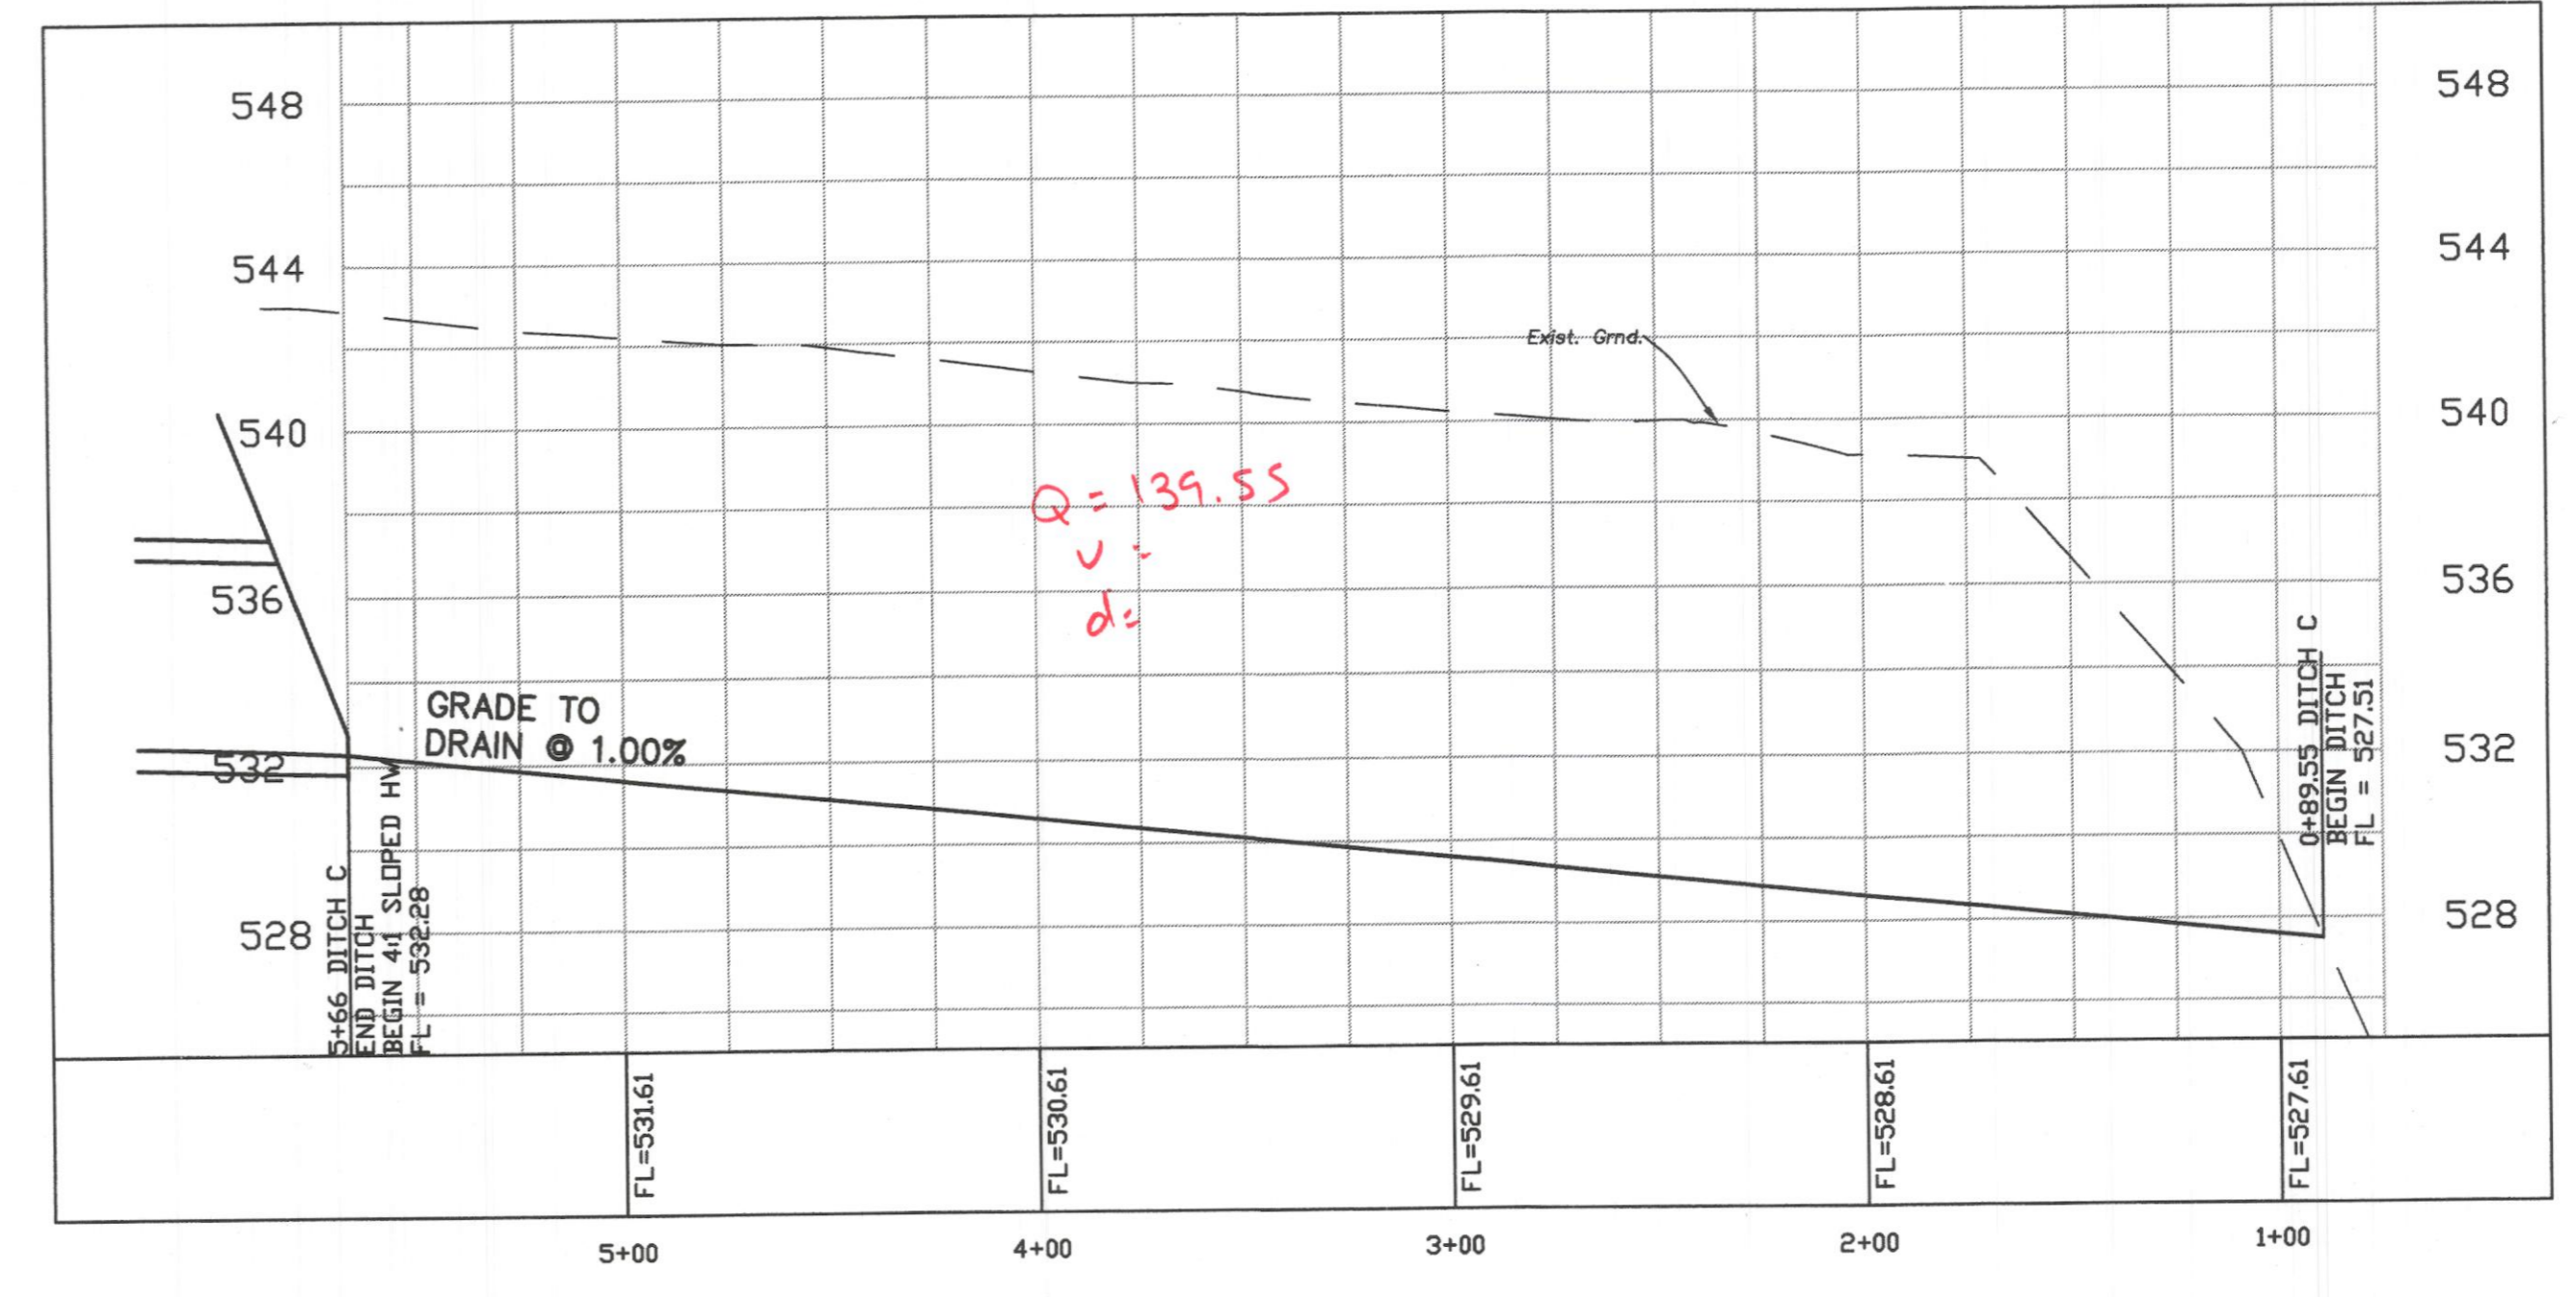

Owner:
SPRING HAVEN INVESTMENTS, INC.
6750 HILLCREST PLAZA DR. • STE 325
DALLAS, TEXAS 75230 • Phone: 972-386-3333

The Highlands

F.C. CUNY CORPORATION
#2 Horizon Court • Ste. 500 • Heath, Texas 75032
Phone: 469-402-7700
Fax: 469-402-0700

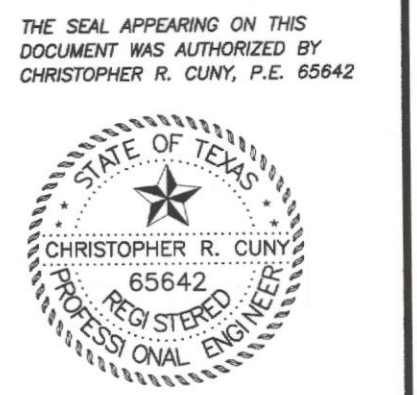

Drawn By: MSC	Checked By: JW
Date: 08/25/2007	Project No.: 06-004
Sheet Title: Storm Drain Ditch A & C Plan & Profile	
Scale: 1" = 40'	Sheet No.: 41 of 61