




Sewer Line-C PROFILE

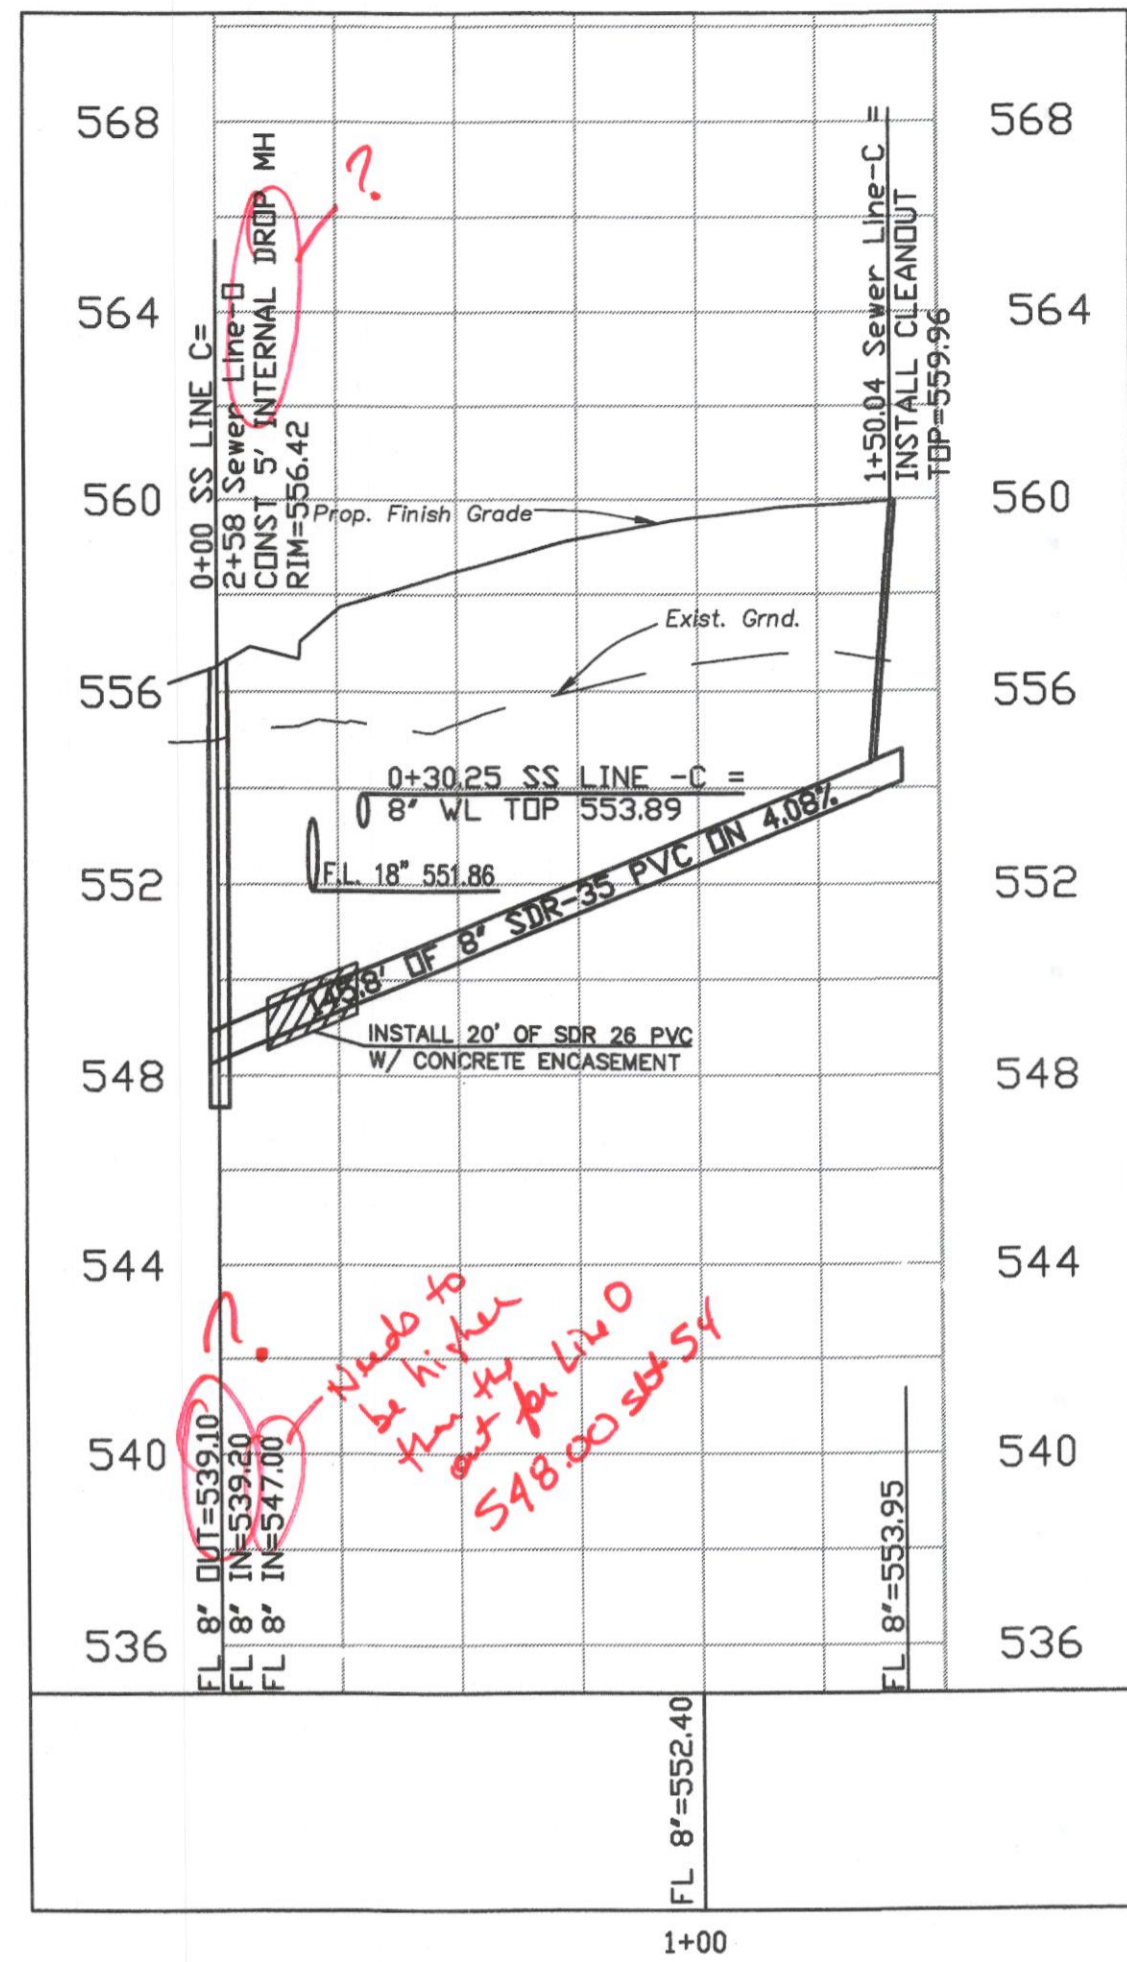

Sewer Line-D PROFILE

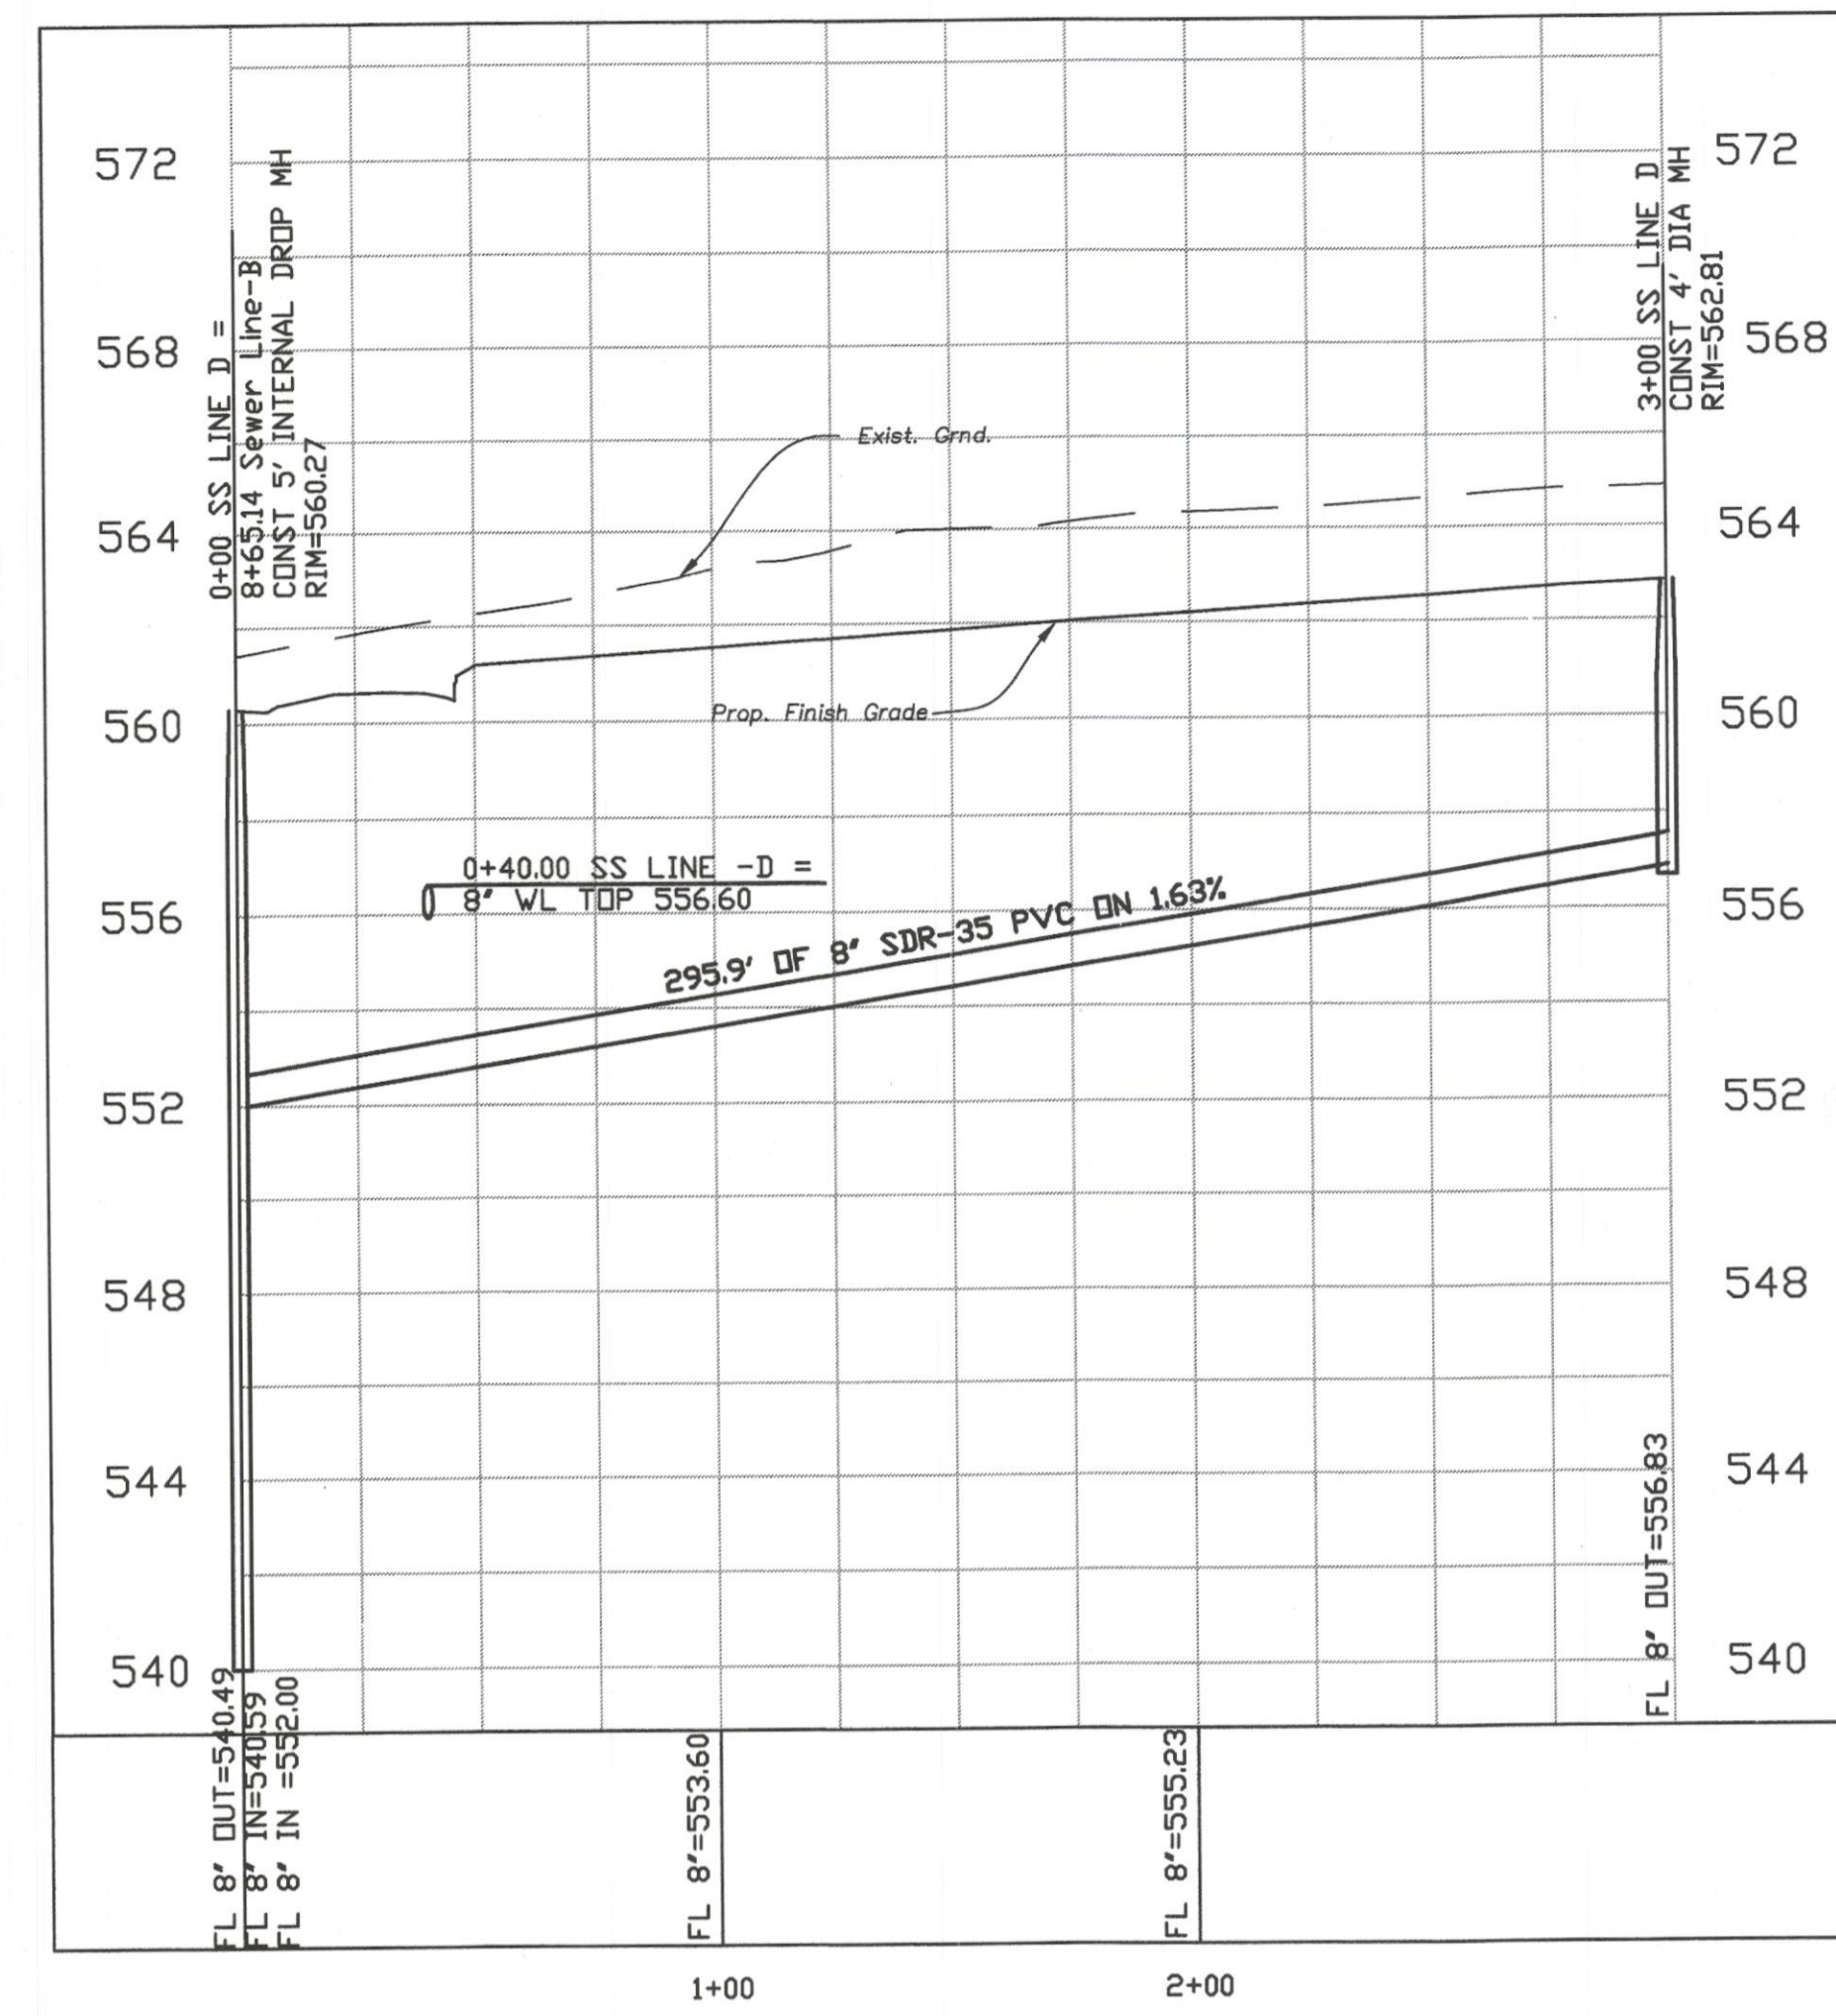

Line "E"

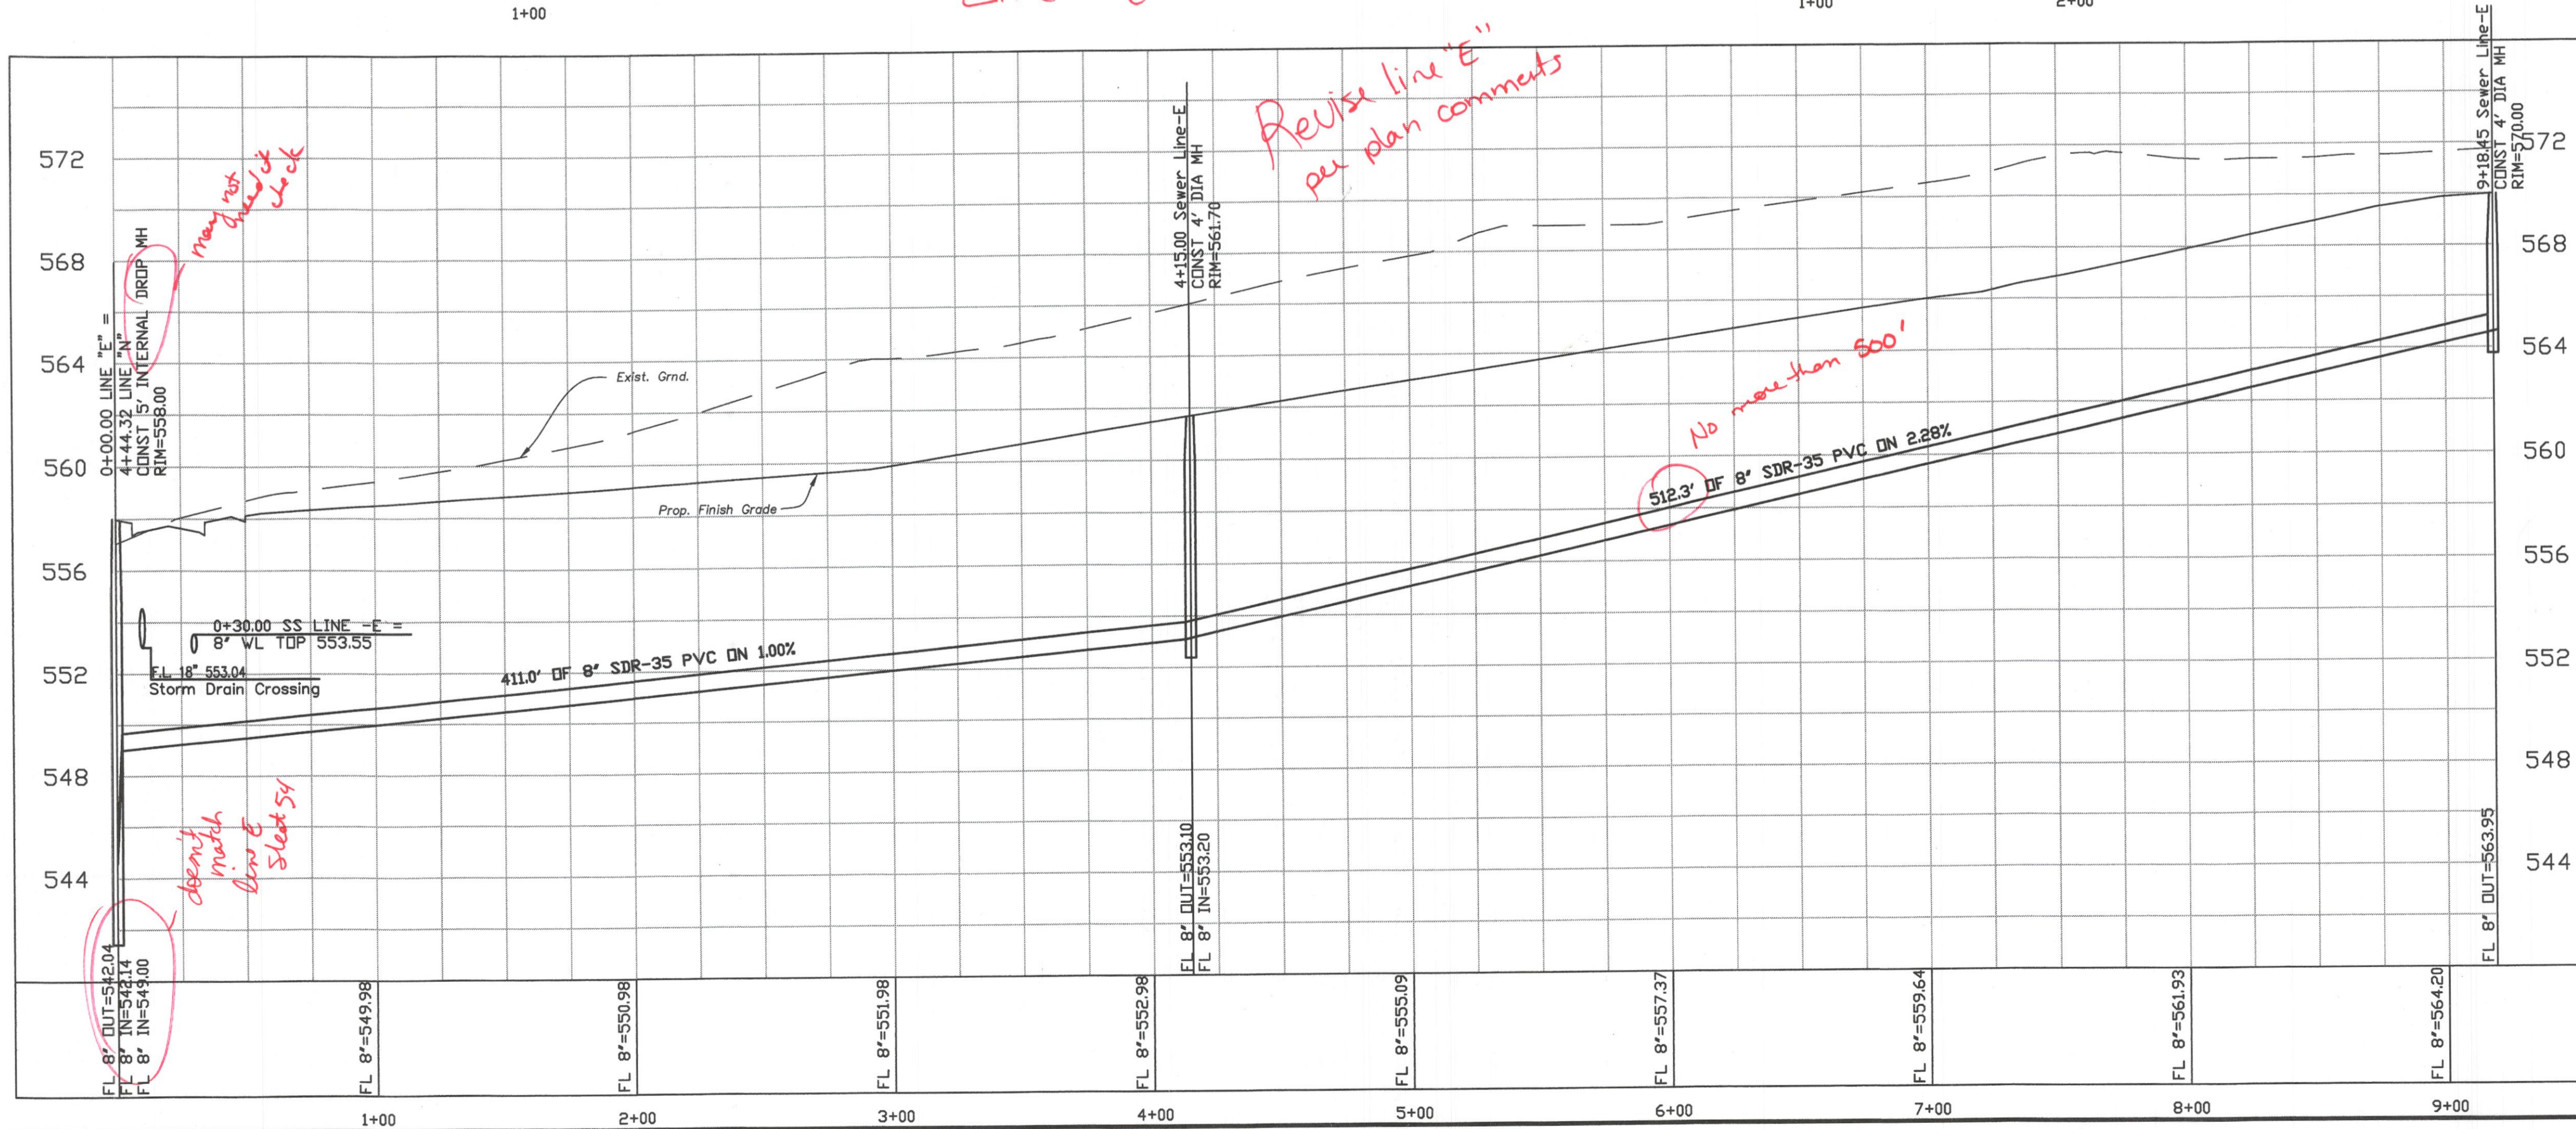

Revision	Date	Description

Owner:  
**SPRING HAVEN INVESTMENTS, INC.**  
6750 HILLCREST PLAZA DR. • STE 325  
DALLAS, TEXAS 75230 • Phone: 972-386-3333

**The Highlands**

**F.C. CUNY CORPORATION**  
#2 Horizon Court • Ste. 500 • Heath, Texas 75032  
Phone: 469-402-7700  
Fax: 469-402-0700

THE SEAL APPEARING ON THIS DOCUMENT WAS AUTHORIZED BY CHRISTOPHER R. CUNY, P.E. 65642



Drawn By: MSC	Checked By: JW
Date: 09/25/2007	Project No.: 06-004
Sheet Title: <b>SEWER LINES C, D, E Profile</b>	
Scale: 1" = 40'	Sheet No.: 47 of 61