



Sewer Line-F PROFILE

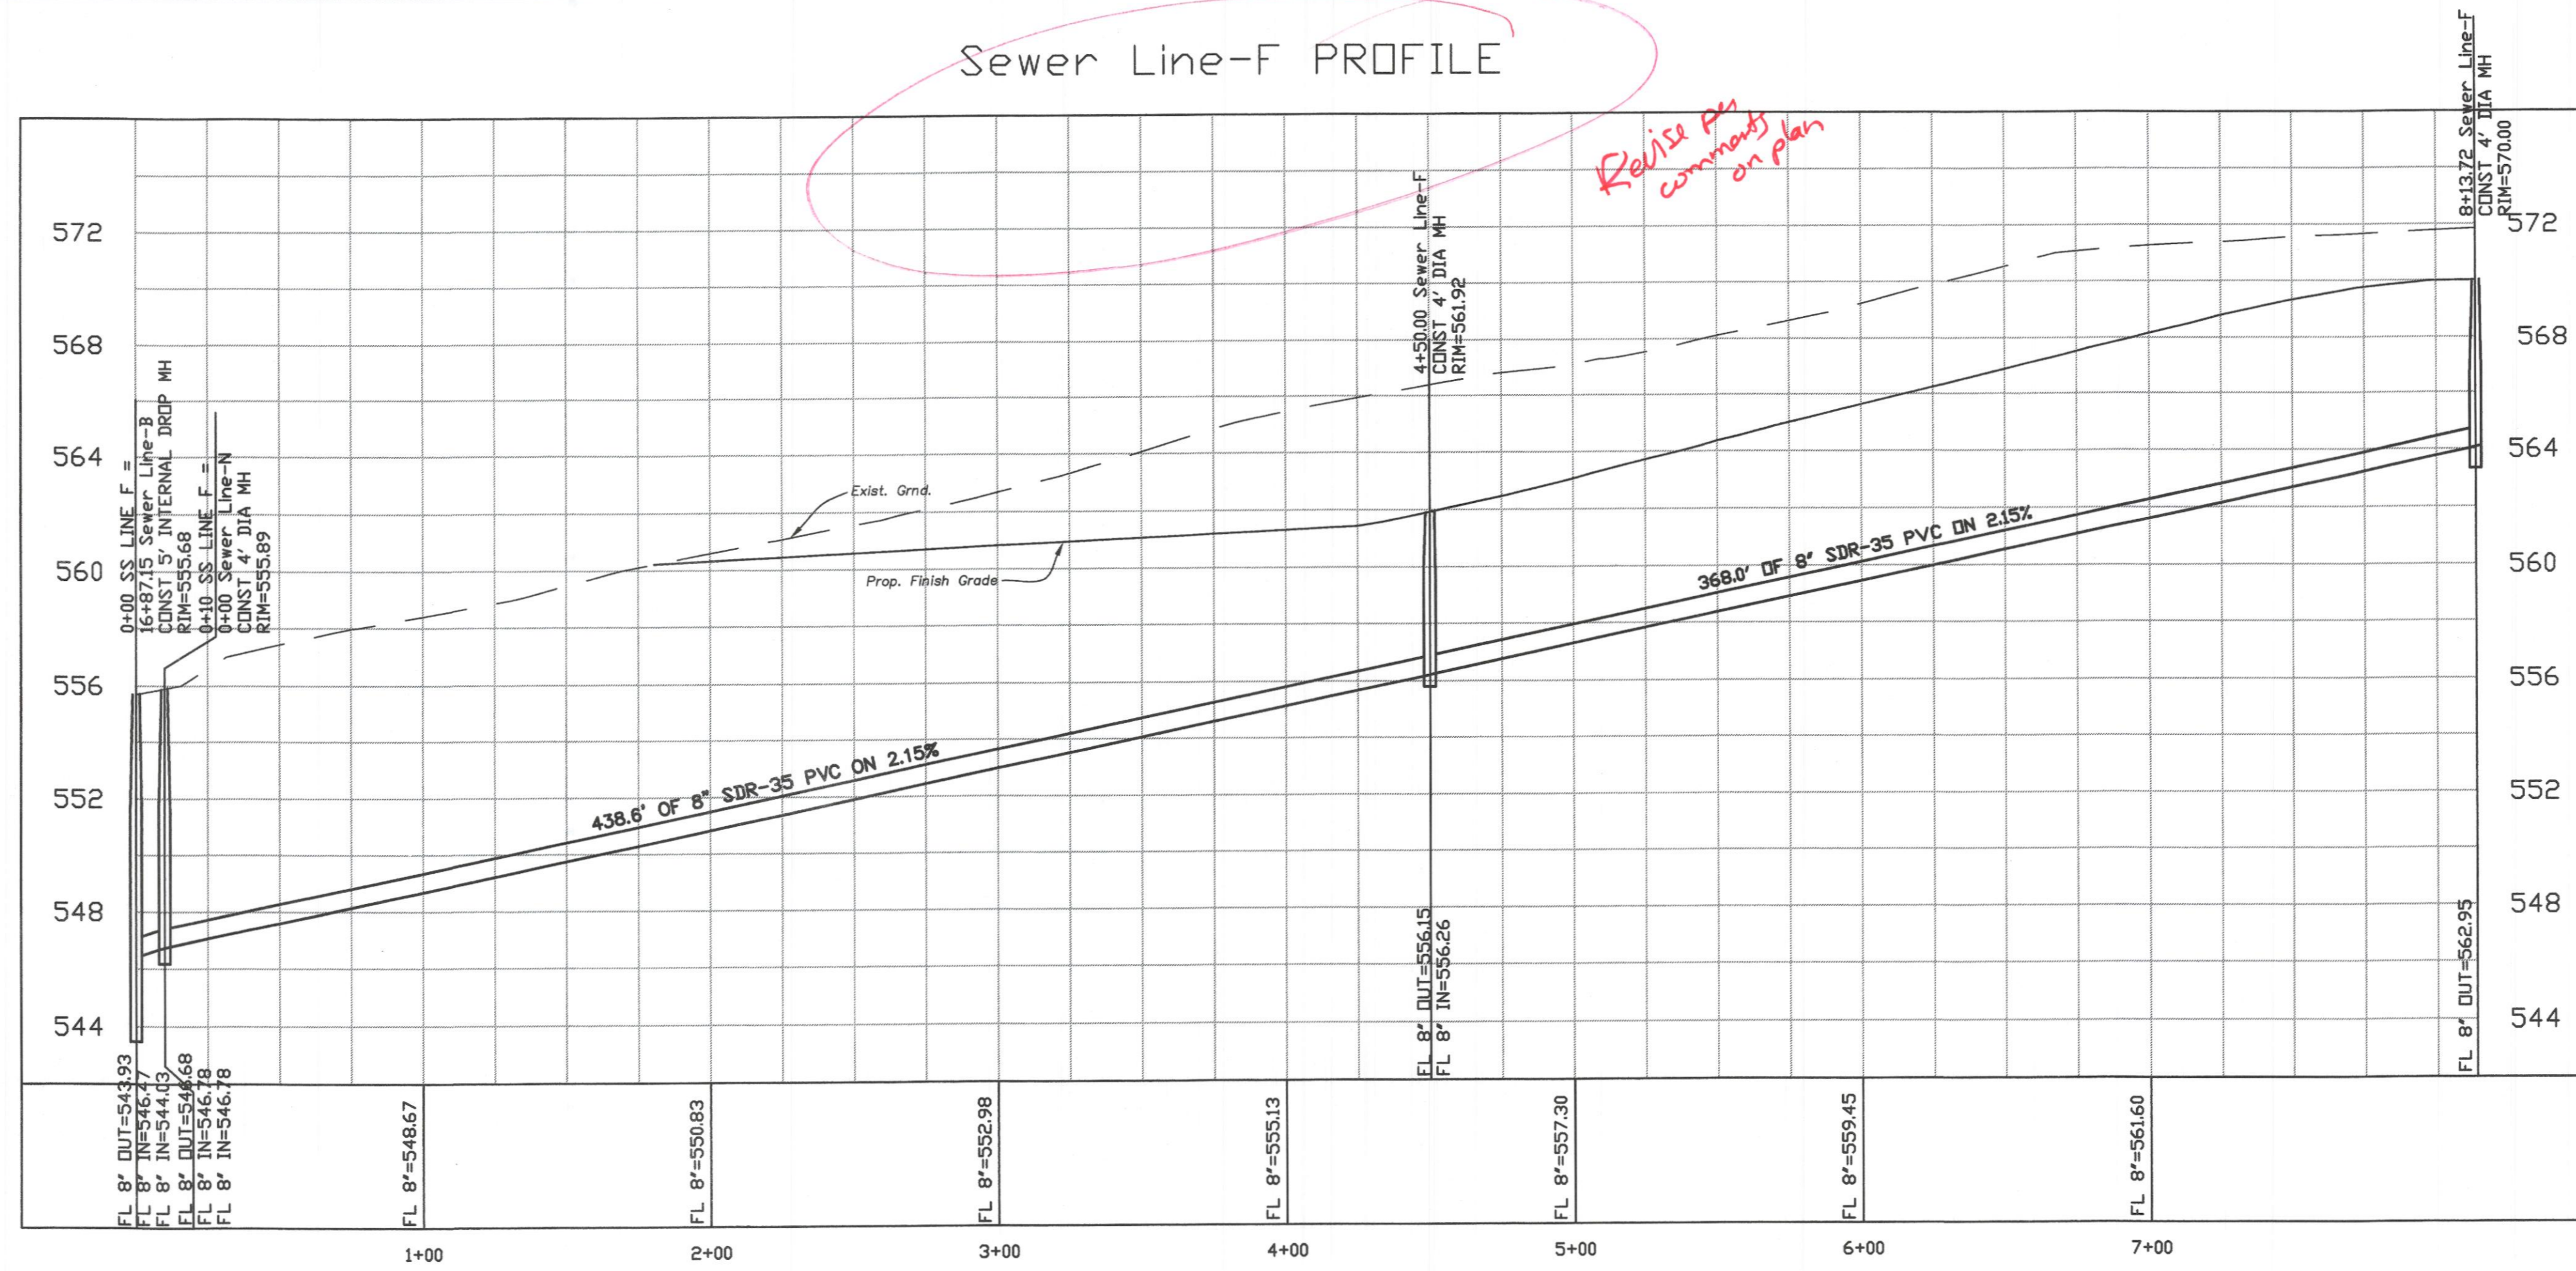

Sewer Line-G PROFILE

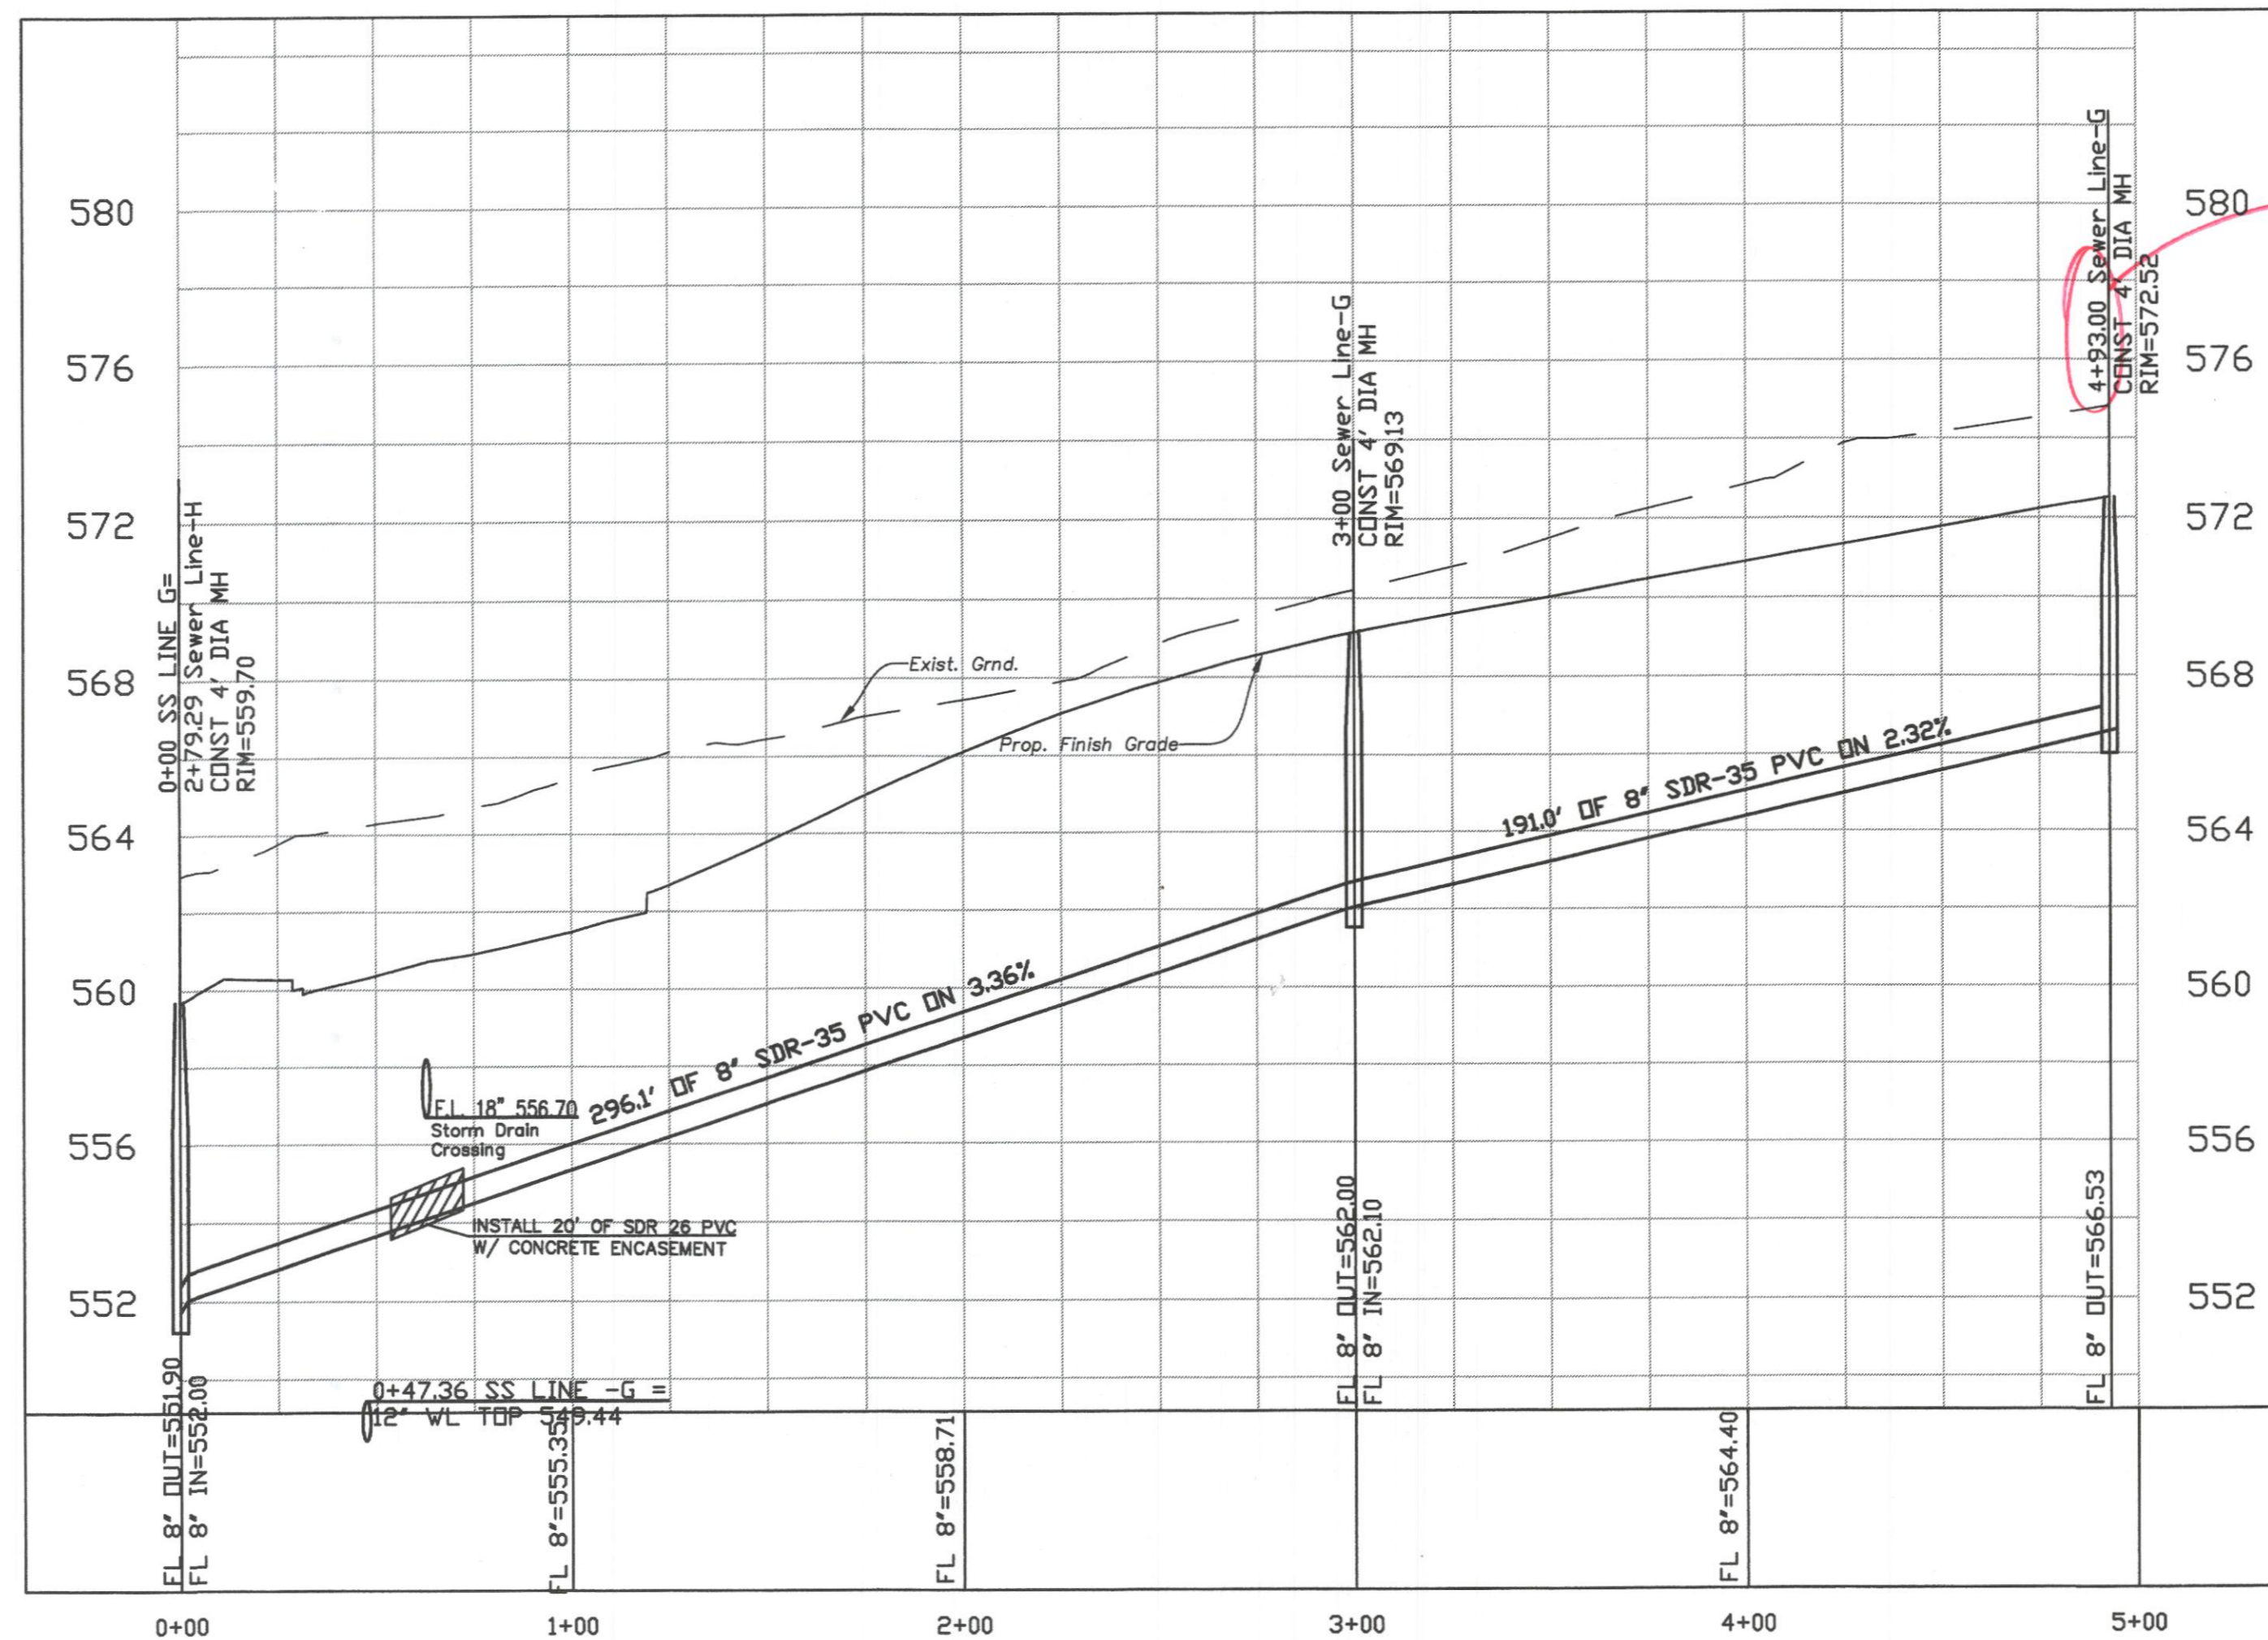

Revision	Date	Description

Owner:
SPRING HAVEN INVESTMENTS, INC.
 6750 HILLCREST PLAZA DR. • STE 325
 DALLAS, TEXAS 75230 • Phone: 972-386-3333

The Highlands

F.C. CUNY CORPORATION
 #2 Horizon Court • Ste. 500 • Heath, Texas 75032
 Phone: 469-402-7700
 Fax: 469-402-0700

THE SEAL APPEARING ON THIS DOCUMENT WAS AUTHORIZED BY CHRISTOPHER R. CUNY, P.E. 65642



Drawn By: MSC
 Checked By: JW

Date: 09/25/2007
 Project No.: 06-004

Sheet Title:
SEWER LINE F & G Profile

Scale: 1" = 40'
 Sheet No.: 48 of 61