


Revision	Date	Description


Owner:
SPRING HAVEN INVESTMENTS, INC.
 6750 HILLCREST PLAZA DR. • STE 325
 DALLAS, TEXAS 75230 • Phone: 972-386-3333

The Highlands


F.C. CUNY CORPORATION
 42 Horizon Court • Ste. 500 • Heath, Texas 75042
 Phone: 469-402-7700
 Fax: 469-402-0700

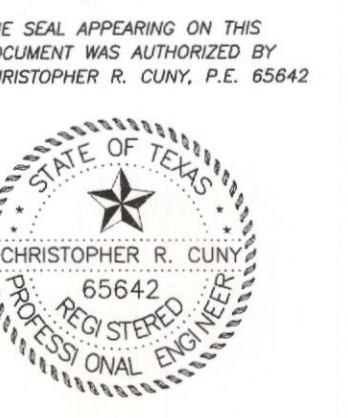


Drawn By: MSC	Checked By: JW
Date: 09/25/2007	Project No.: 06-004
Sheet Title: UTILITY PLAN	
Scale: 1" = 100'	Sheet No.: 58 of 61

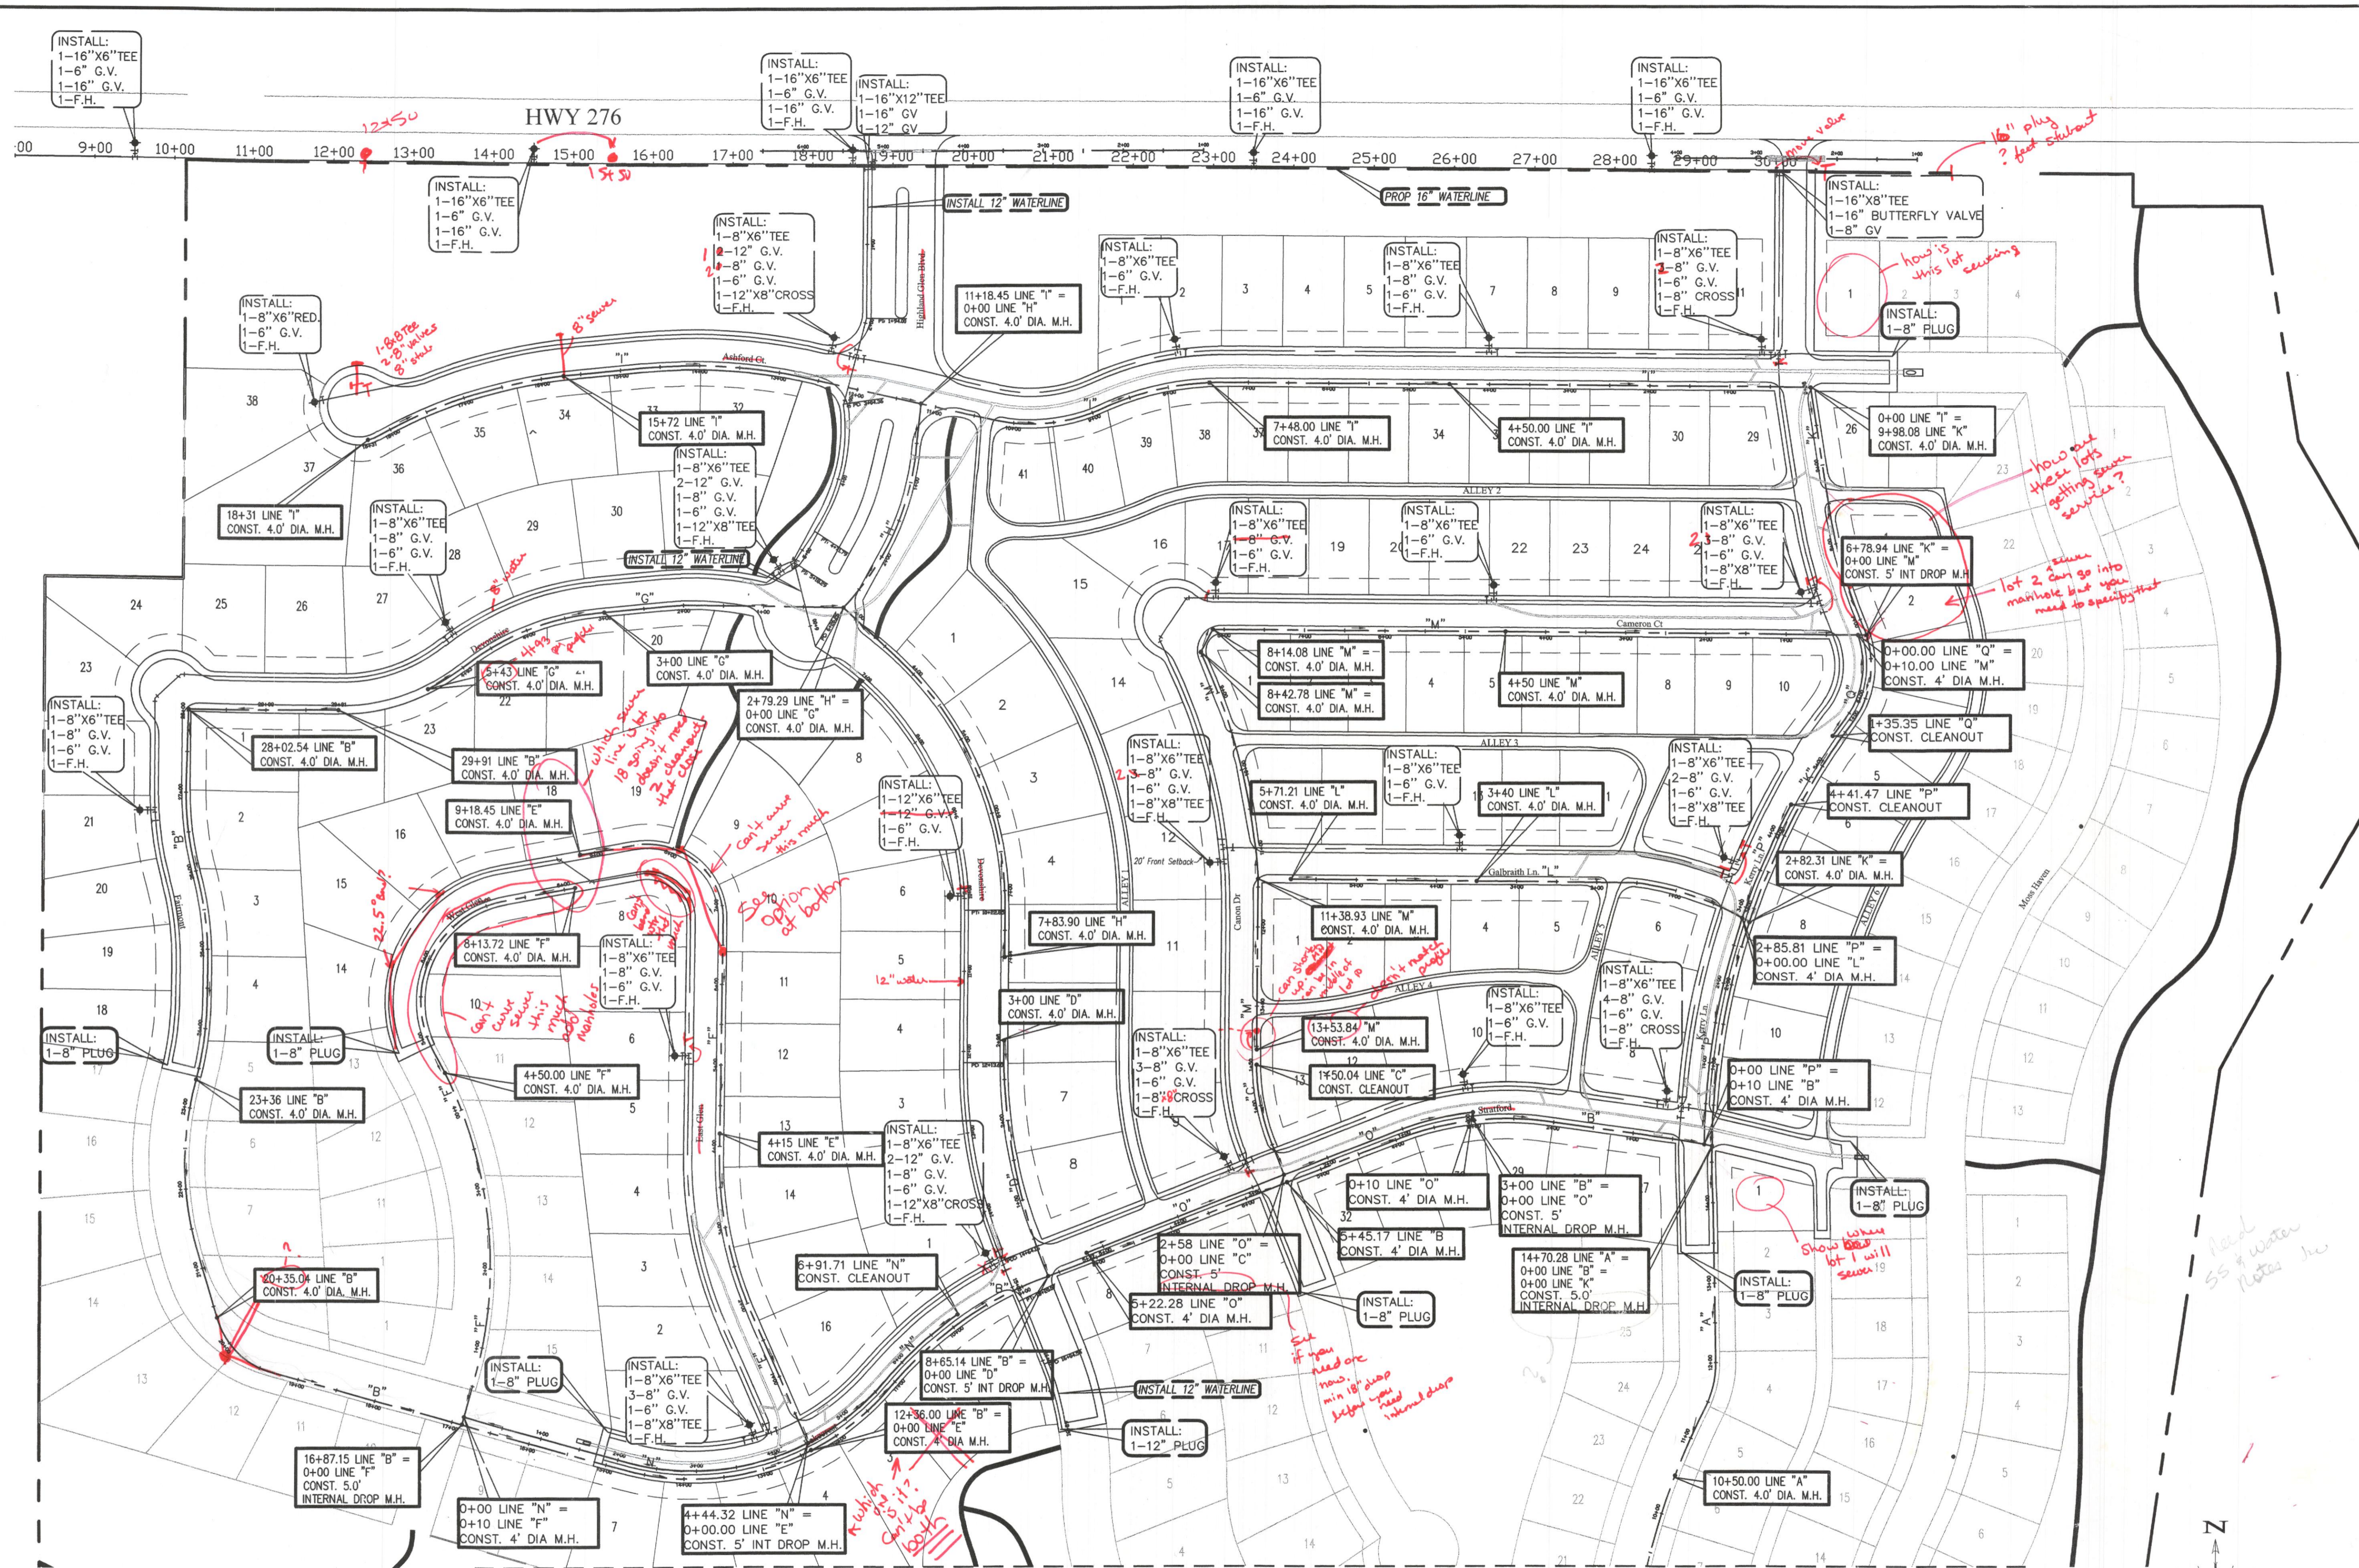

NOTE:
 NO SERVICE CONNECTIONS ON
 SEWER LINE A STA 0+00.00-14+70.28
 SEWER LINE B STA 3+25.00-14+75.00
 SEWER LINE K STA 0+00.00-8+50.00

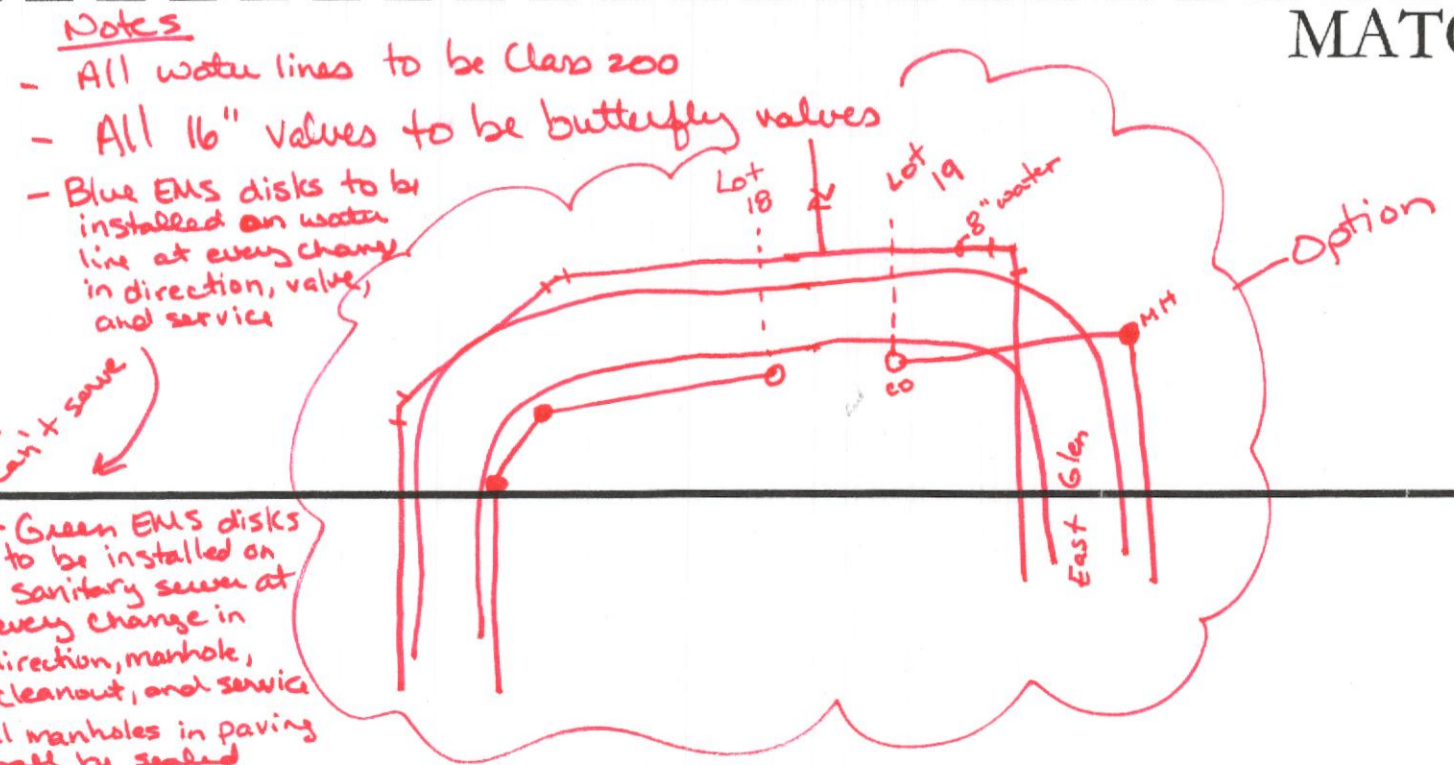

MATCHLINE SEWER LINE A

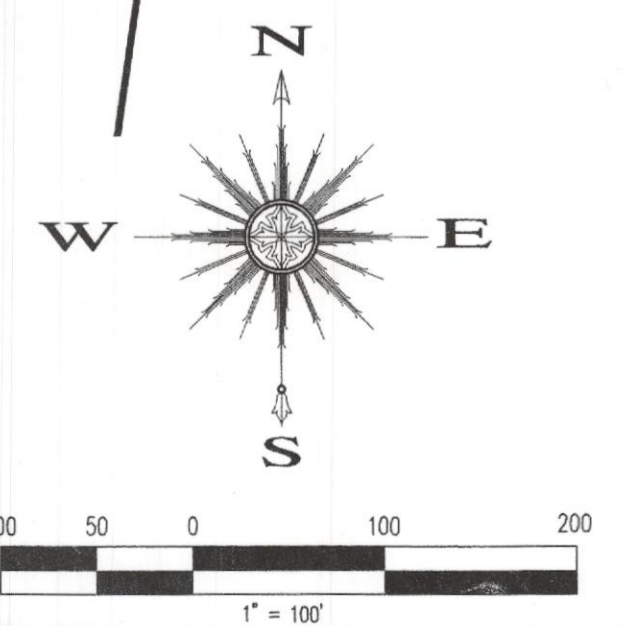

Need detail showing services and location of water and sewer behind curb

Sheet 59
 - change line with horizontal dimension
 - collection line in laboratory