
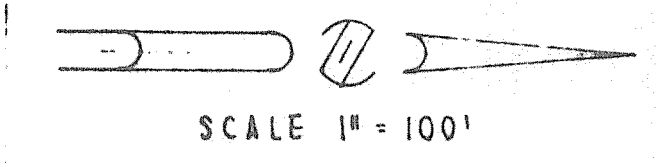


R. E. JOHNSON SURVEY  
ABSTRACT NO 129

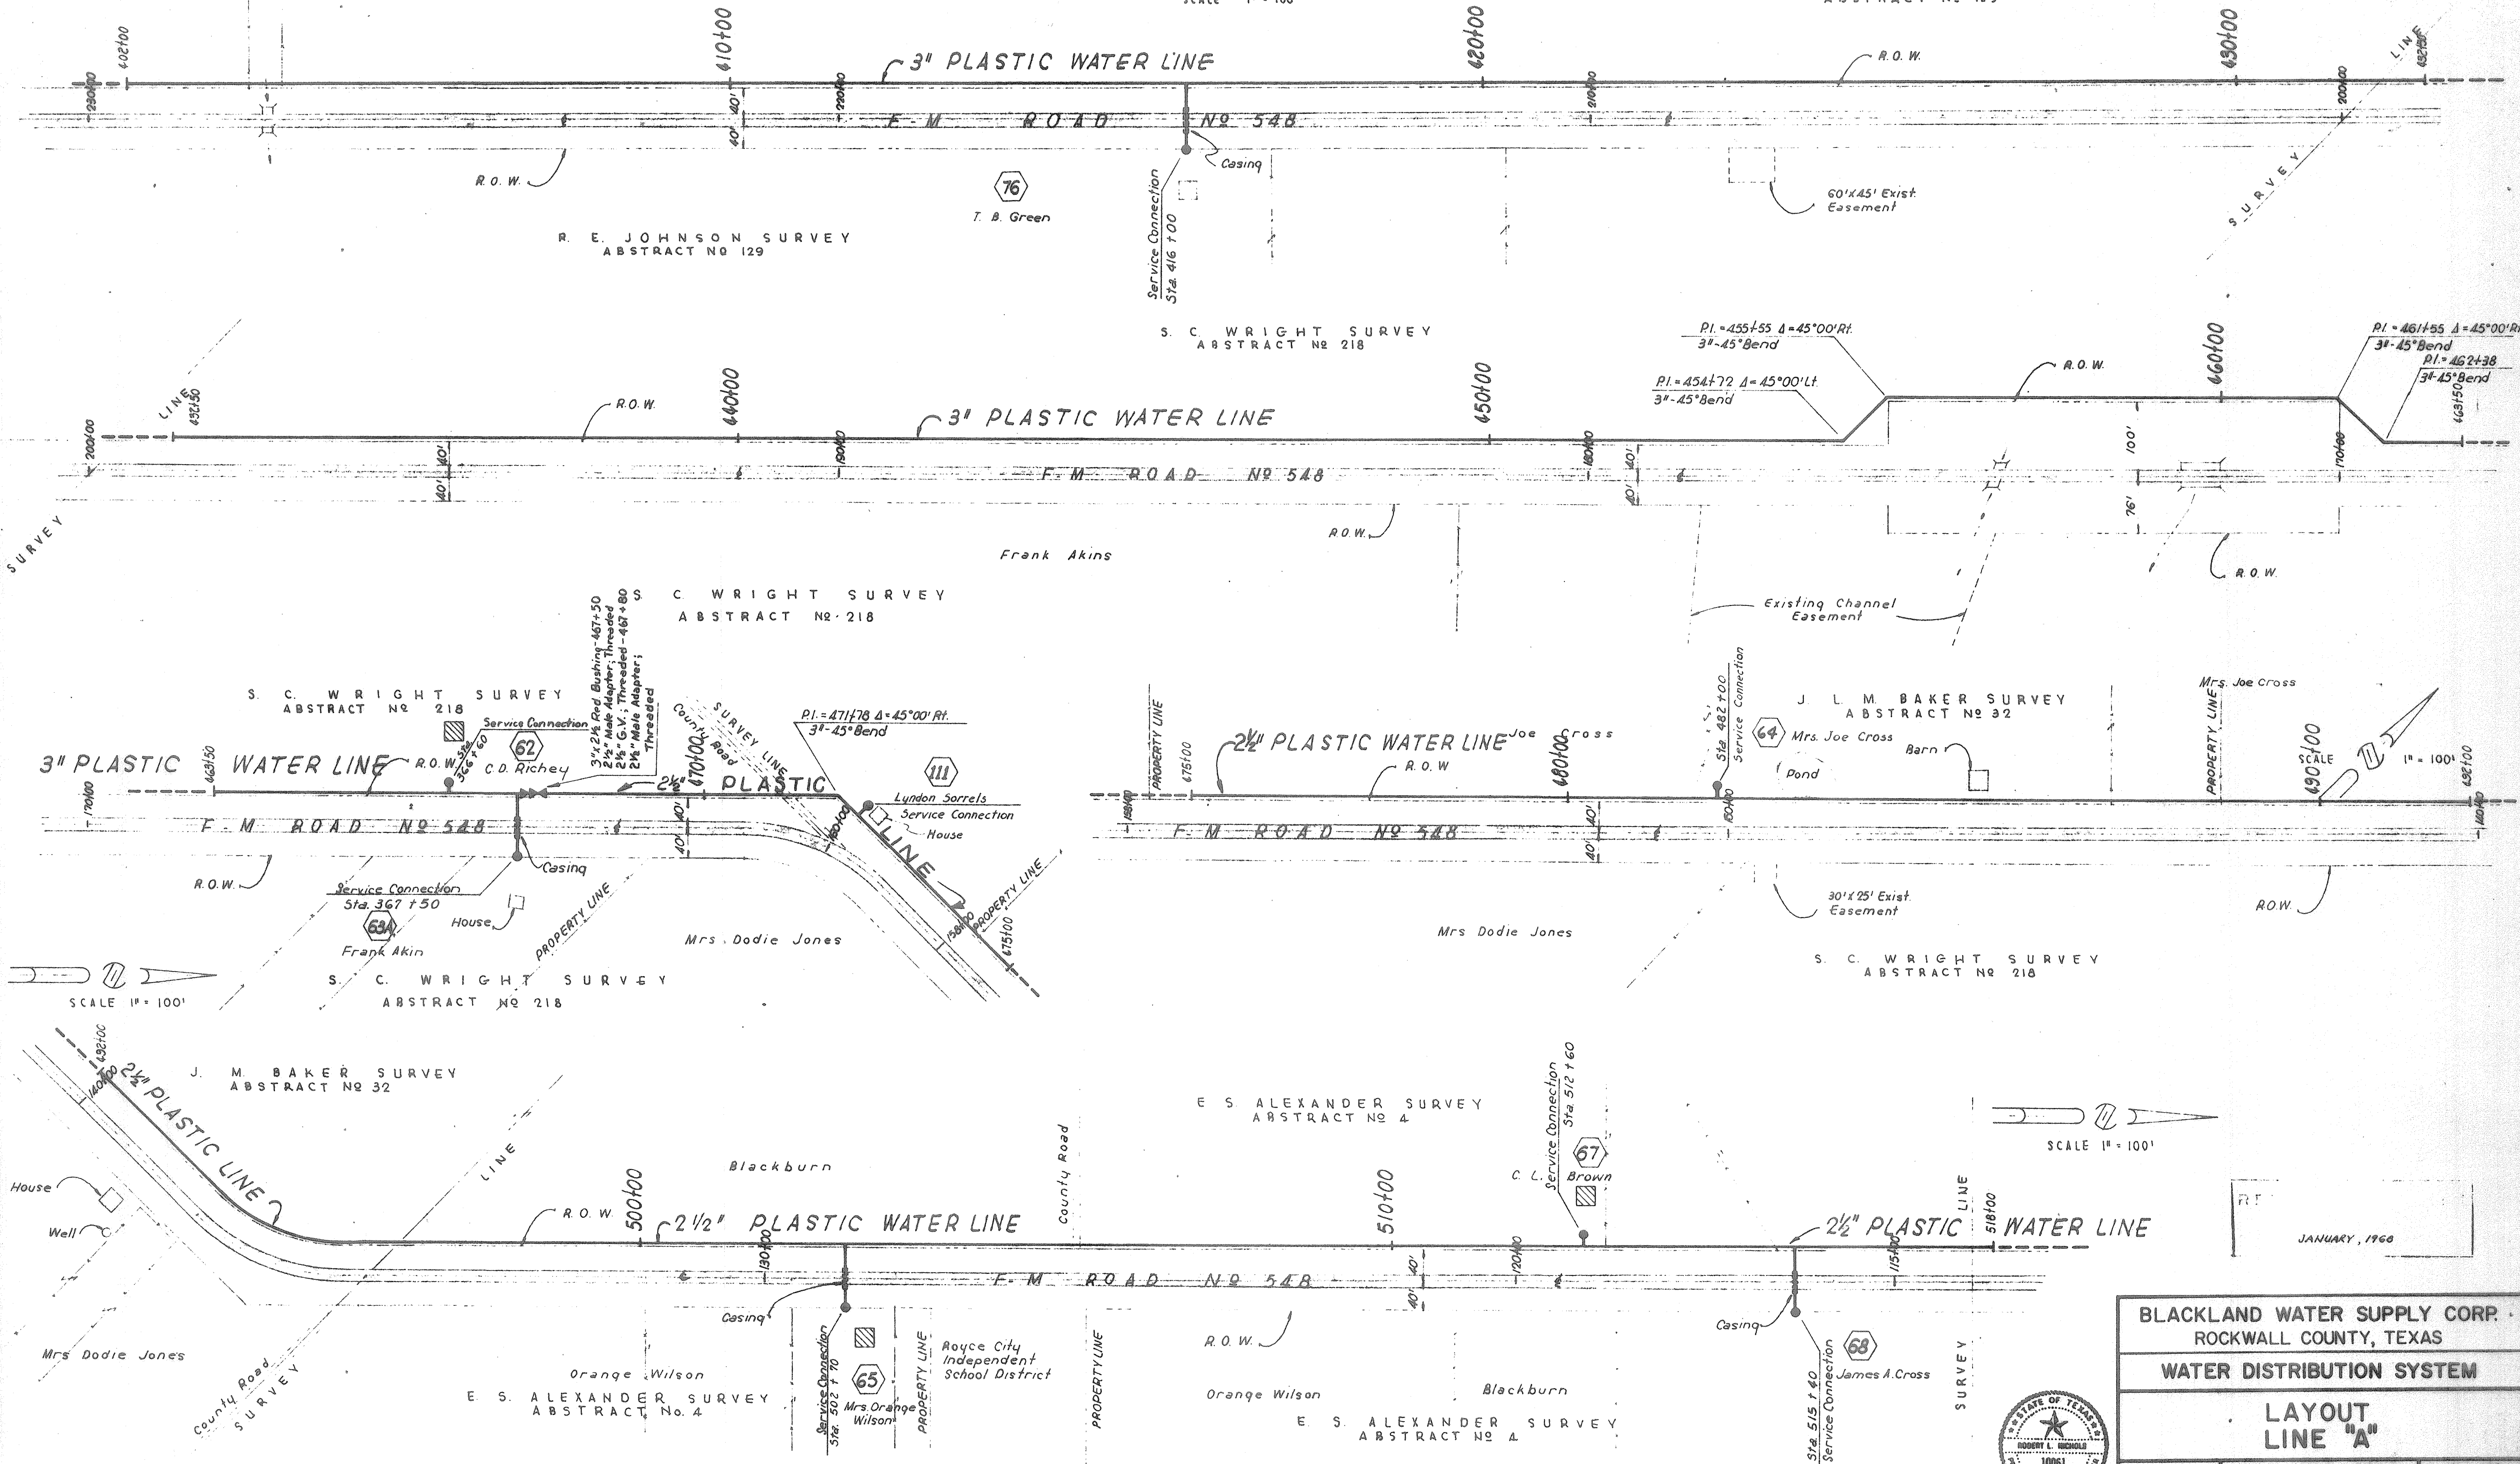

JANUARY, 1960

BLACKLAND WATER SUPPLY CORP.  
ROCKWALL COUNTY, TEXAS  
WATER DISTRIBUTION SYSTEM

LAYOUT  
LINE "A"



DESIGNED: D.L.D.  
DRAWN: C.D.G.  
TRACED: C.D.G.  
CHECKED: R.L.N.  
FREESE, NICHOLS & ENDRESS  
CONSULTING ENGINEERS  
FORT WORTH, TEXAS  
DATE: Dec. 1965  
SCALE: 1" = 100'  
Sheet No. of 22