

R. DICKERSON SURVEY
ABSTRACT No. 73

SCALE 1" = 100'

Robert Smith

Emma Crawford

Mrs. Pearl Hawks, et al.

Mrs. Fayrie Greene

Lorene Pelk

Annie Everett

Mrs. Bert Everett

J. N. BAILEY SURVEY
ABSTRACT No. 45

SAMUEL KELLEY SURVEY
ABSTRACT No. 132

R. DICKERSON SURVEY
ABSTRACT No. 73

Robert Smith

SCALE 1" = 100'

(See Sht. 4)
0+00 LINE "F"
= 256+68 LINE "A"
2" Galv. Nipple
2" Gate Valve
2" Male Adapter

0+00 Beg. Mrs. Fayrie Greene
Line "E" (See Sht. 4)

J. N. BAILEY SURVEY
ABSTRACT No. 45

NOTE:
See Sheet No. 14 for
Highway Crossing Detail, crossing
State Highway No. 276 (Hwy. Sta.
245+82).

3" x 6" Galv. Nipple
3" Gate Valve
3" Male Adapter, Slip Threaded

Service Connection
Sta. 3+95

Lawrence Jones

PI = Sta. 3+70
Δ = 89° 30' Lt.
2" 90° Bend

2" PLASTIC WATER LINE

LINE "F"

END LINE "F"

58+71
2" Male Adapter
2" Gate Valve
2" 6" Galv. Nipple
2" Galv. 90° Bend
2" Galv. Nipple
2" Cap

BLOWOFF

Pond

2" PLASTIC WATER LINE


SCALE 1" = 100'

JANUARY, 1968

Revised 11-19-66

BLACKLAND WATER SUPPLY CORP.
ROCKWALL COUNTY, TEXAS
WATER DISTRIBUTION SYSTEM

LAYOUT
LINES "E" & "F"

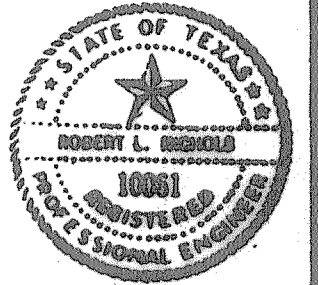

DESIGNED: D.L.D.	FRESE, NICHOLS & ENDRESS	DATE: Dec. 1965
DRAWN: C.G.G.	CONSULTING ENGINEERS	SCALE: 1" = 100'
TRACED: C.G.G.	FORT WORTH, TEXAS	Sheet No. of 22 10
CHECKED: R.L.N.		