
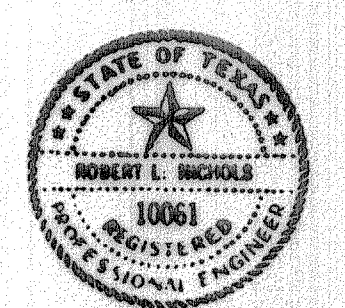
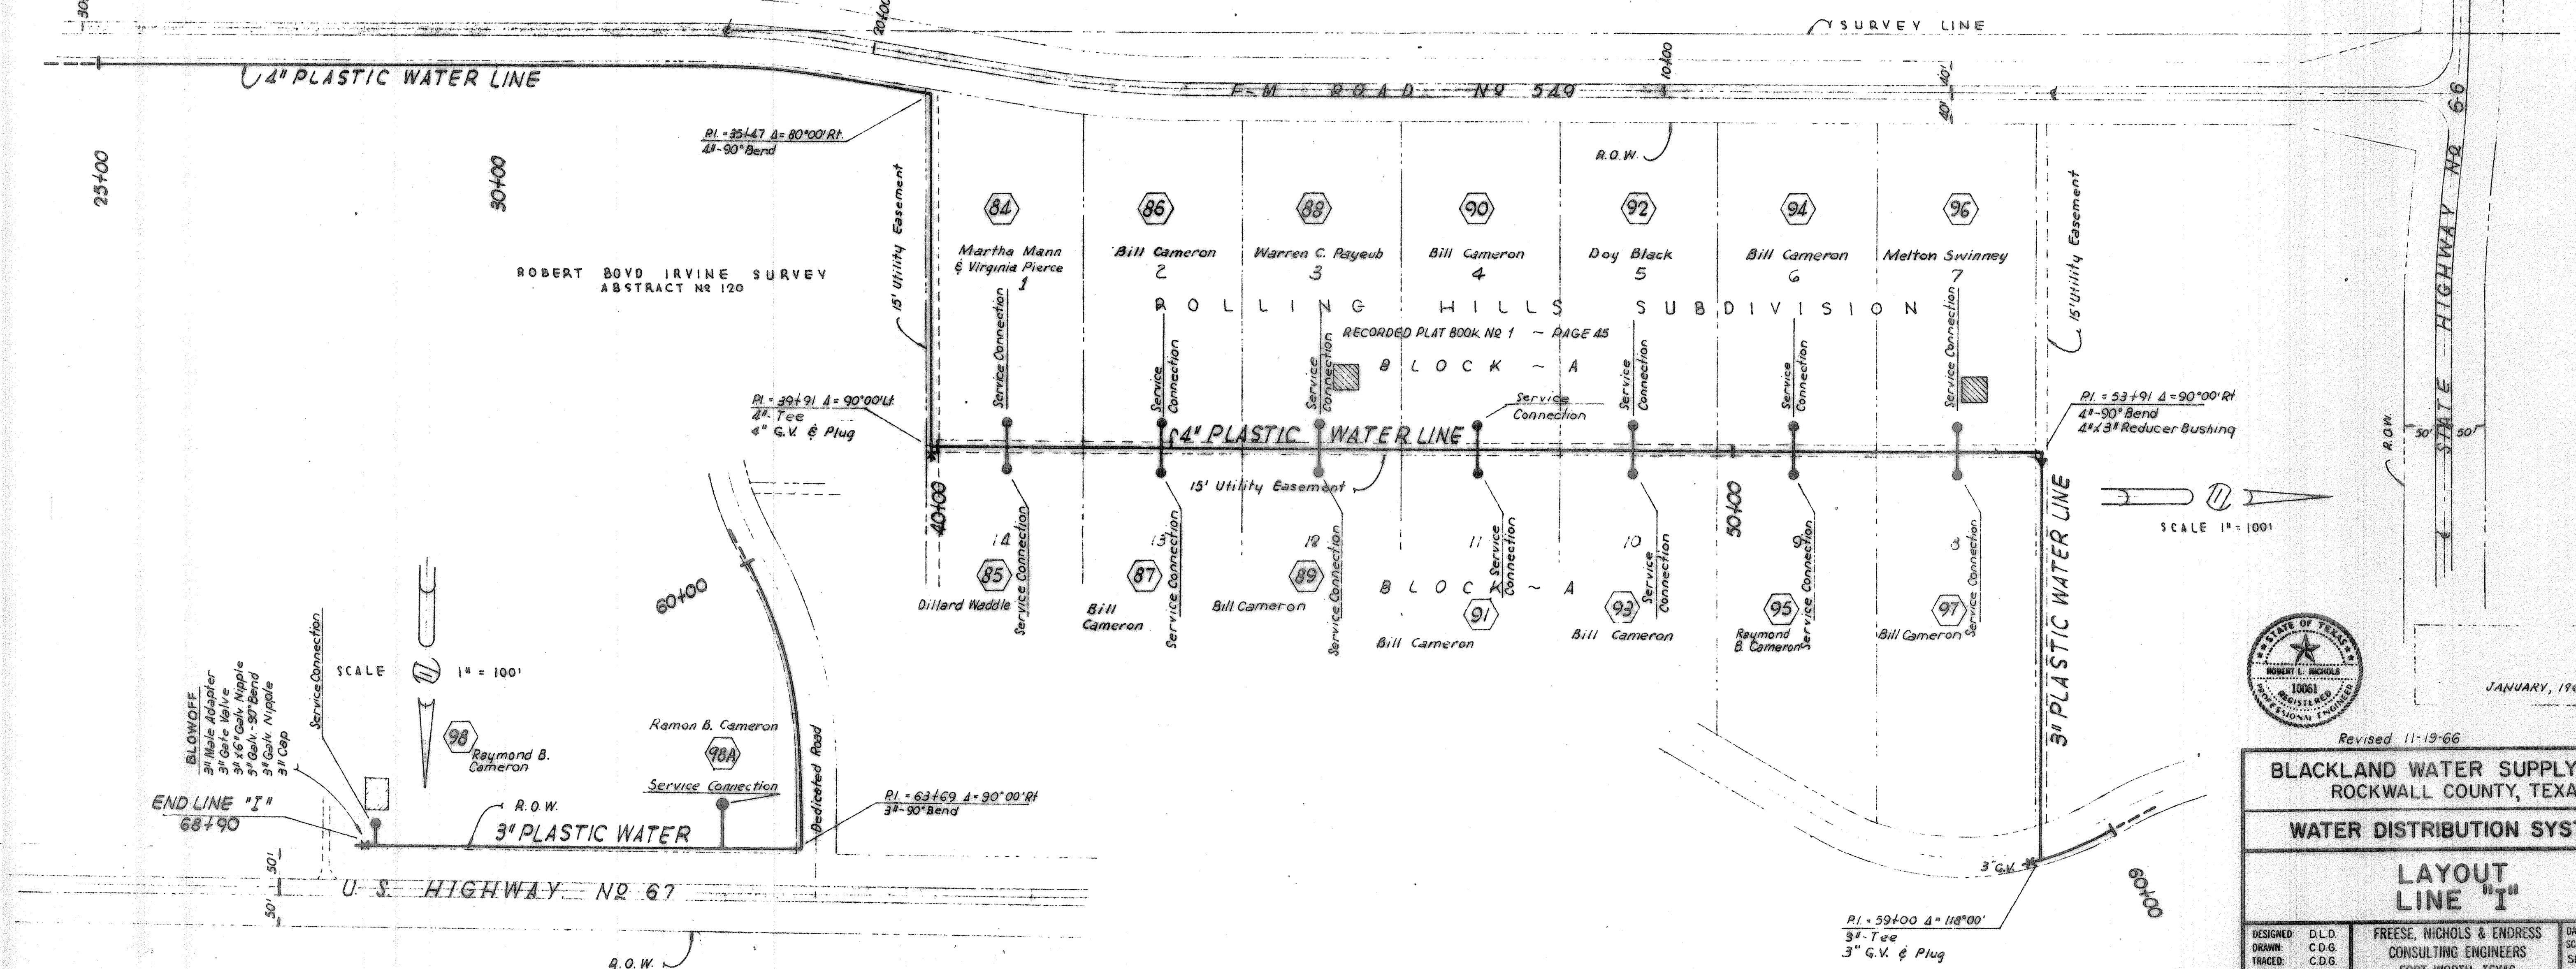
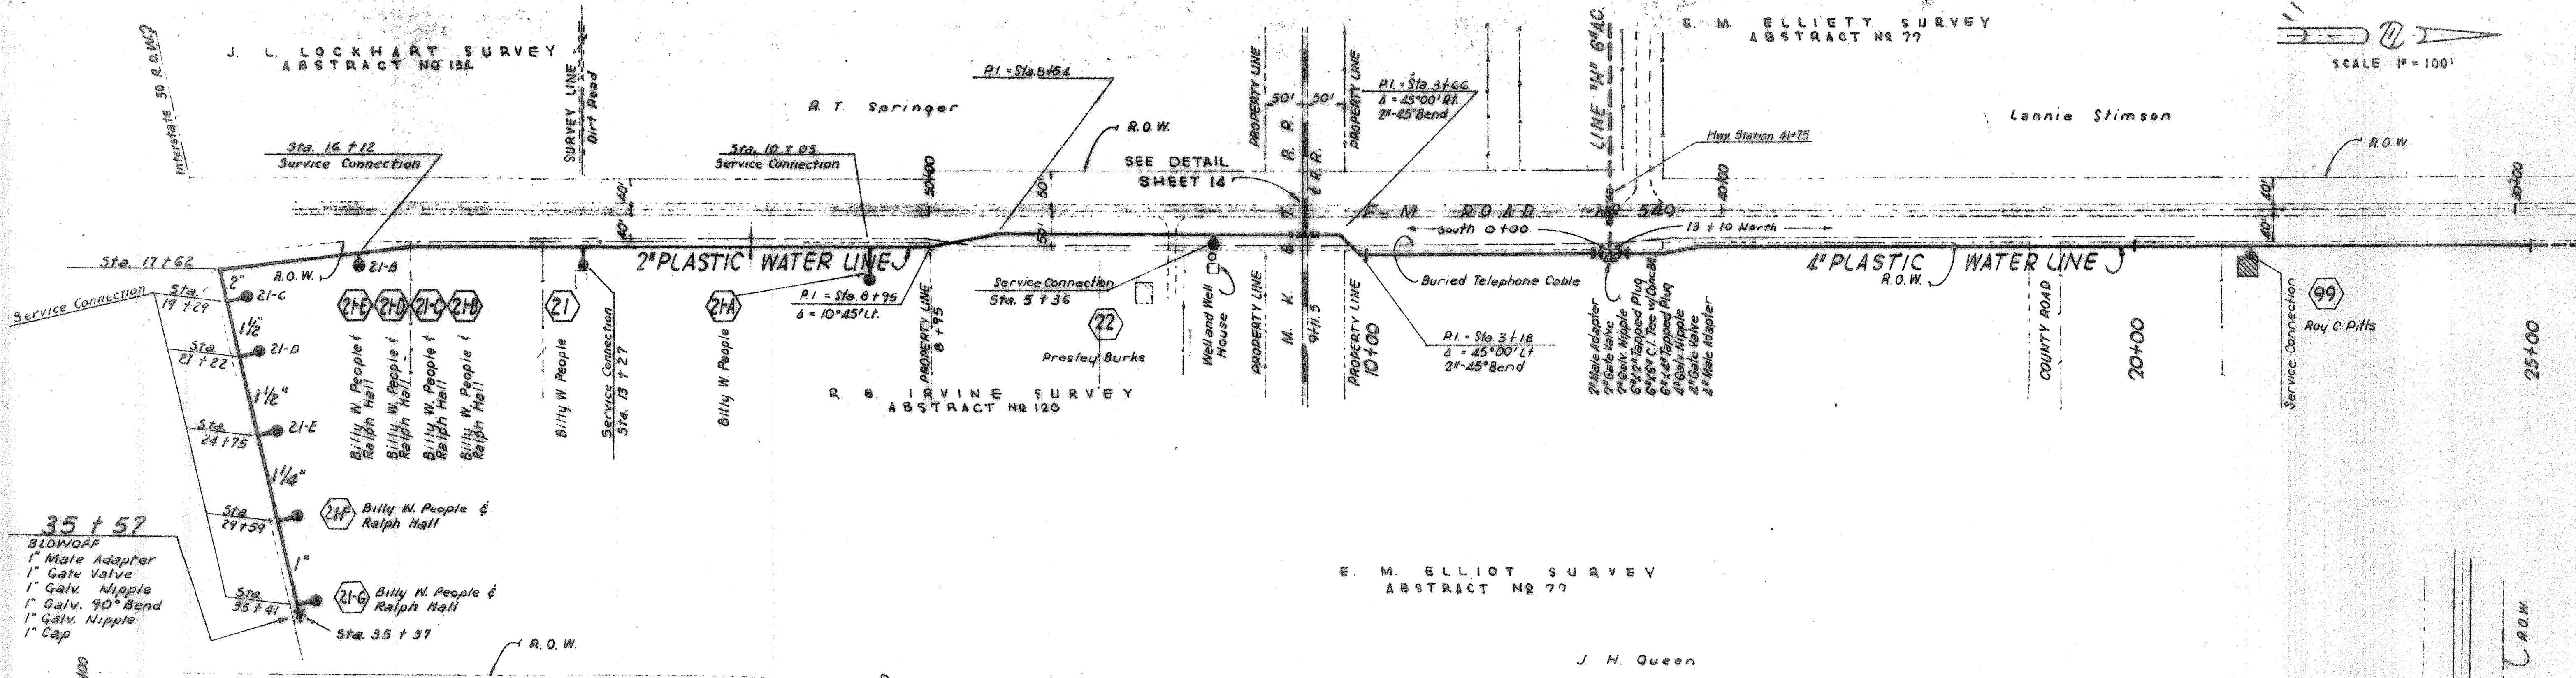


J. L. LOCKHART SURVEY  
ABSTRACT NO 134

E. M. ELLIOTT SURVEY  
ABSTRACT NO 77

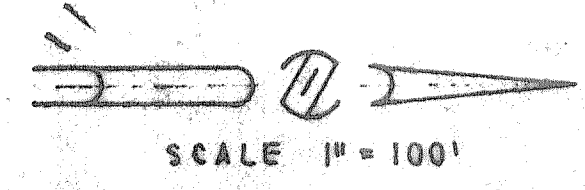

JANUARY, 1968

Revised 11-19-66  
**BLACKLAND WATER SUPPLY CORP.**  
ROCKWALL COUNTY, TEXAS  
**WATER DISTRIBUTION SYSTEM**

**LAYOUT LINE "I"**

DESIGNED: D.L.D.	FREESE, NICHOLS & ENDRESS	DATE: DEC. 1965
DRAWN: C.D.G.	CONSULTING ENGINEERS	SCALE: 1" = 100'
TRACED: C.D.G.	FORT WORTH, TEXAS	Sheet No. 13
CHECKED: R.L.N.		of 22