



WATER PLANT NO. 1  
Scale: 3/4" = 1'0"

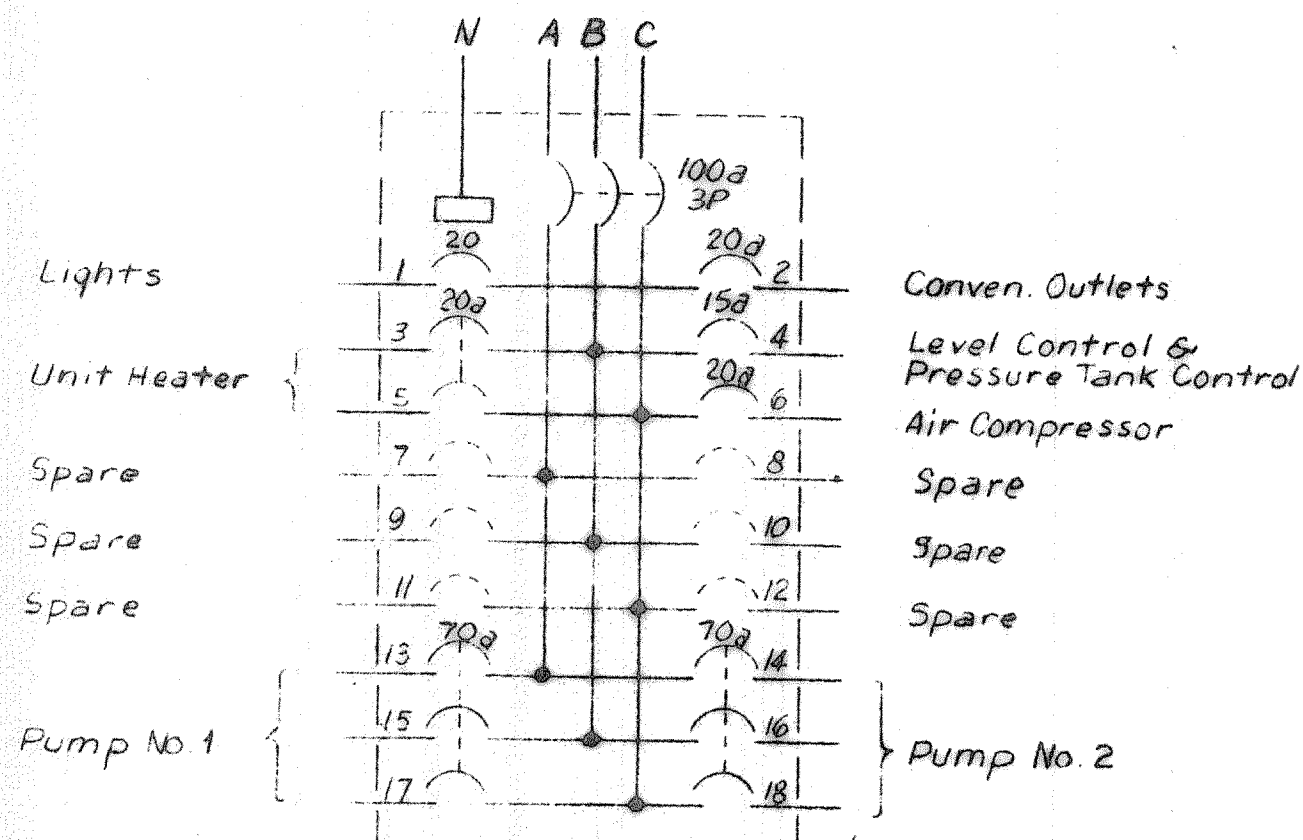


NOTE: BREAKERS FOR PUMPS ARE 30A FOR PLANT NO. 2 & 50A FOR PLANT NO. 3


TYPICAL POWER PANEL

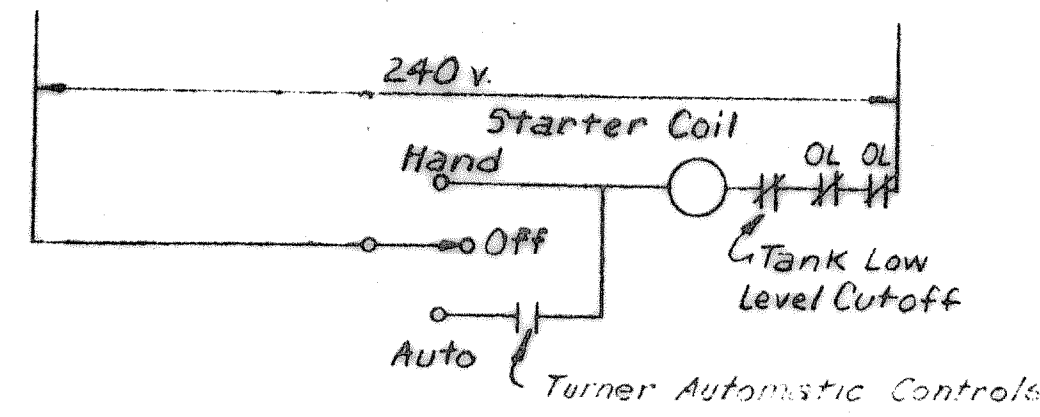


BOOSTER PUMP CONTROL SCHEMATIC

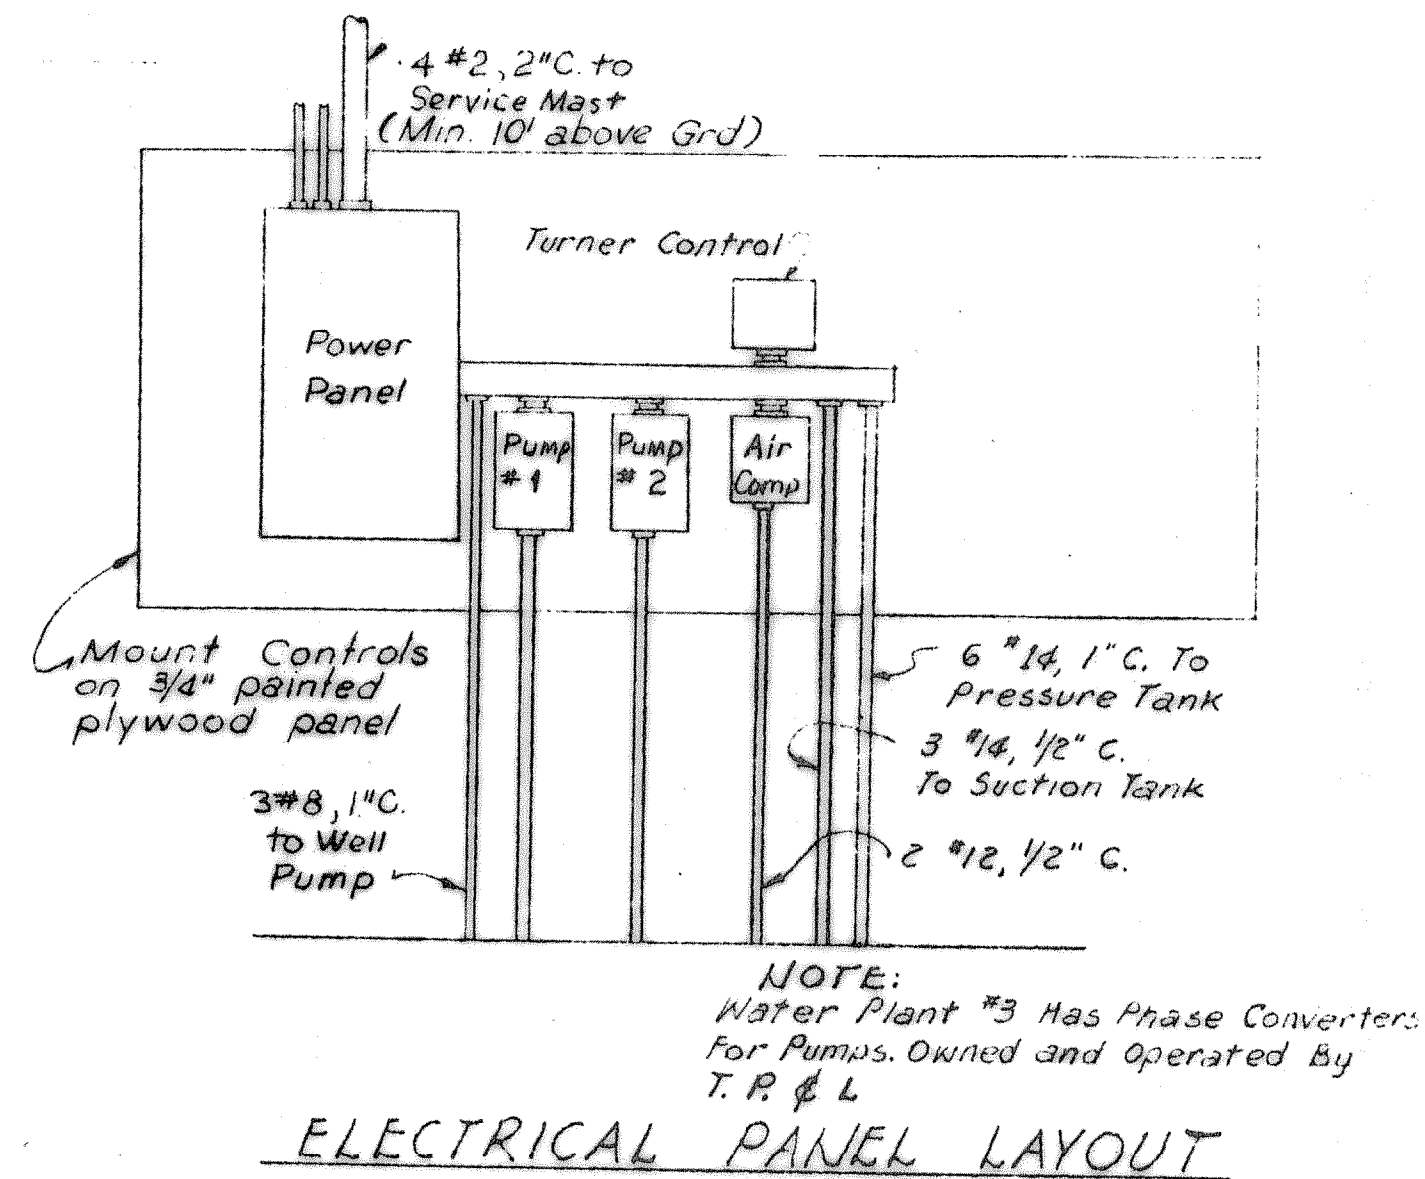


ELECTRICAL PANEL LAYOUT

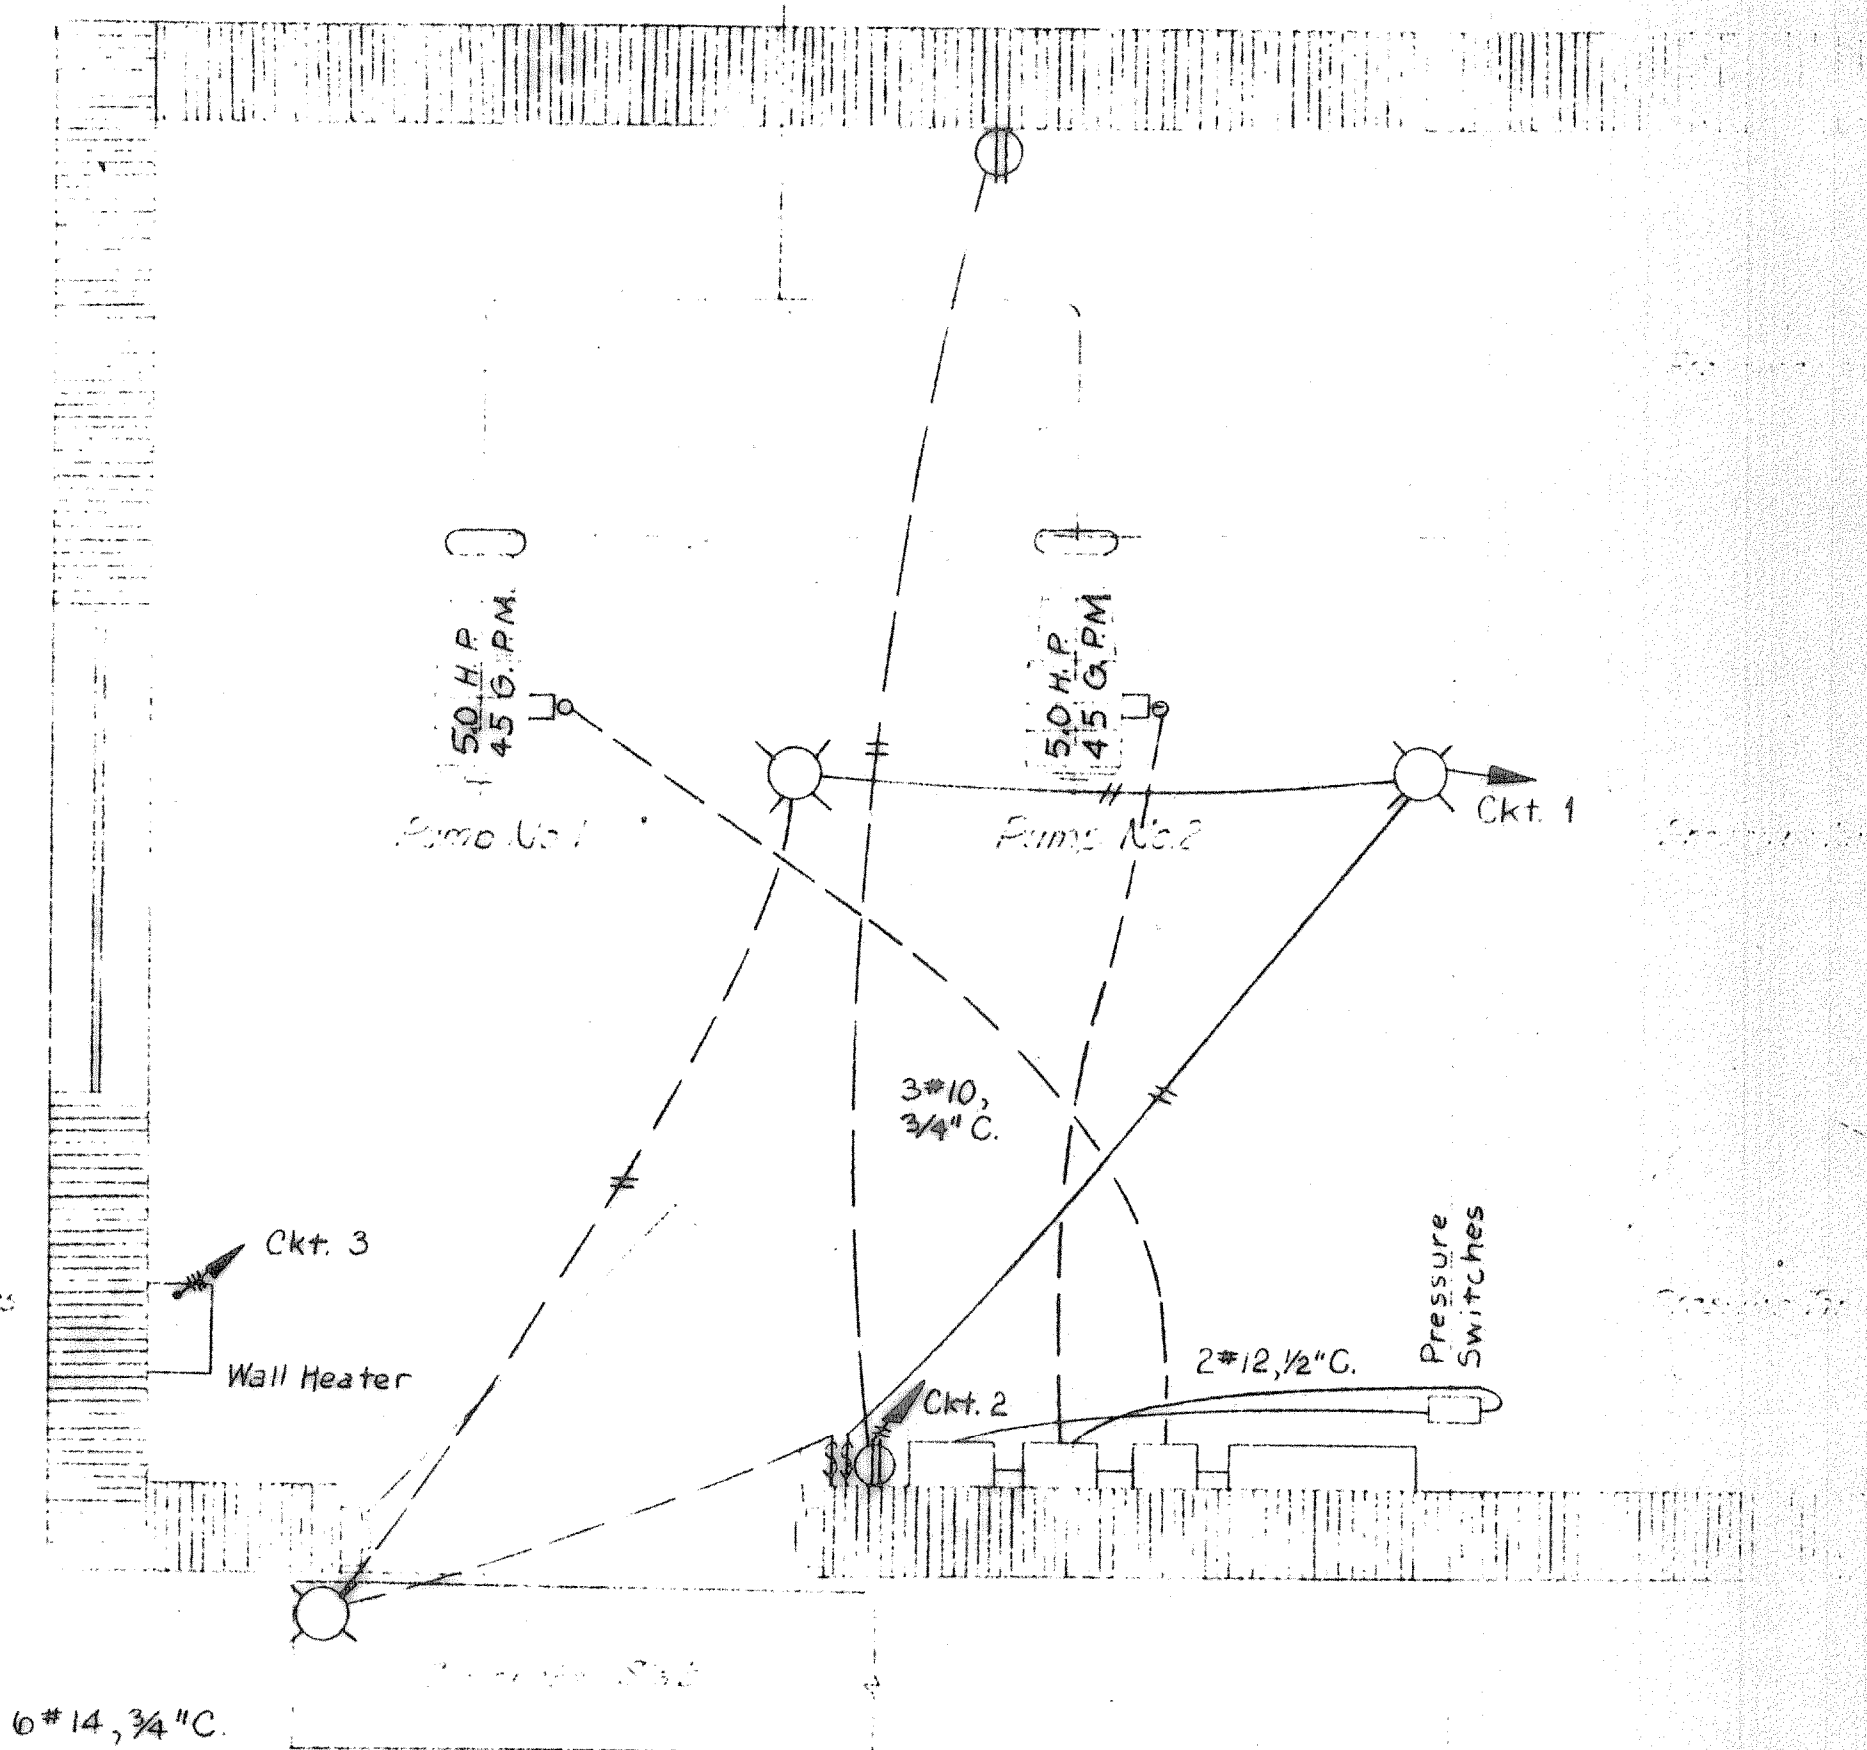

WATER PLANT NO. 2  
Scale: 3/4" = 1'0"

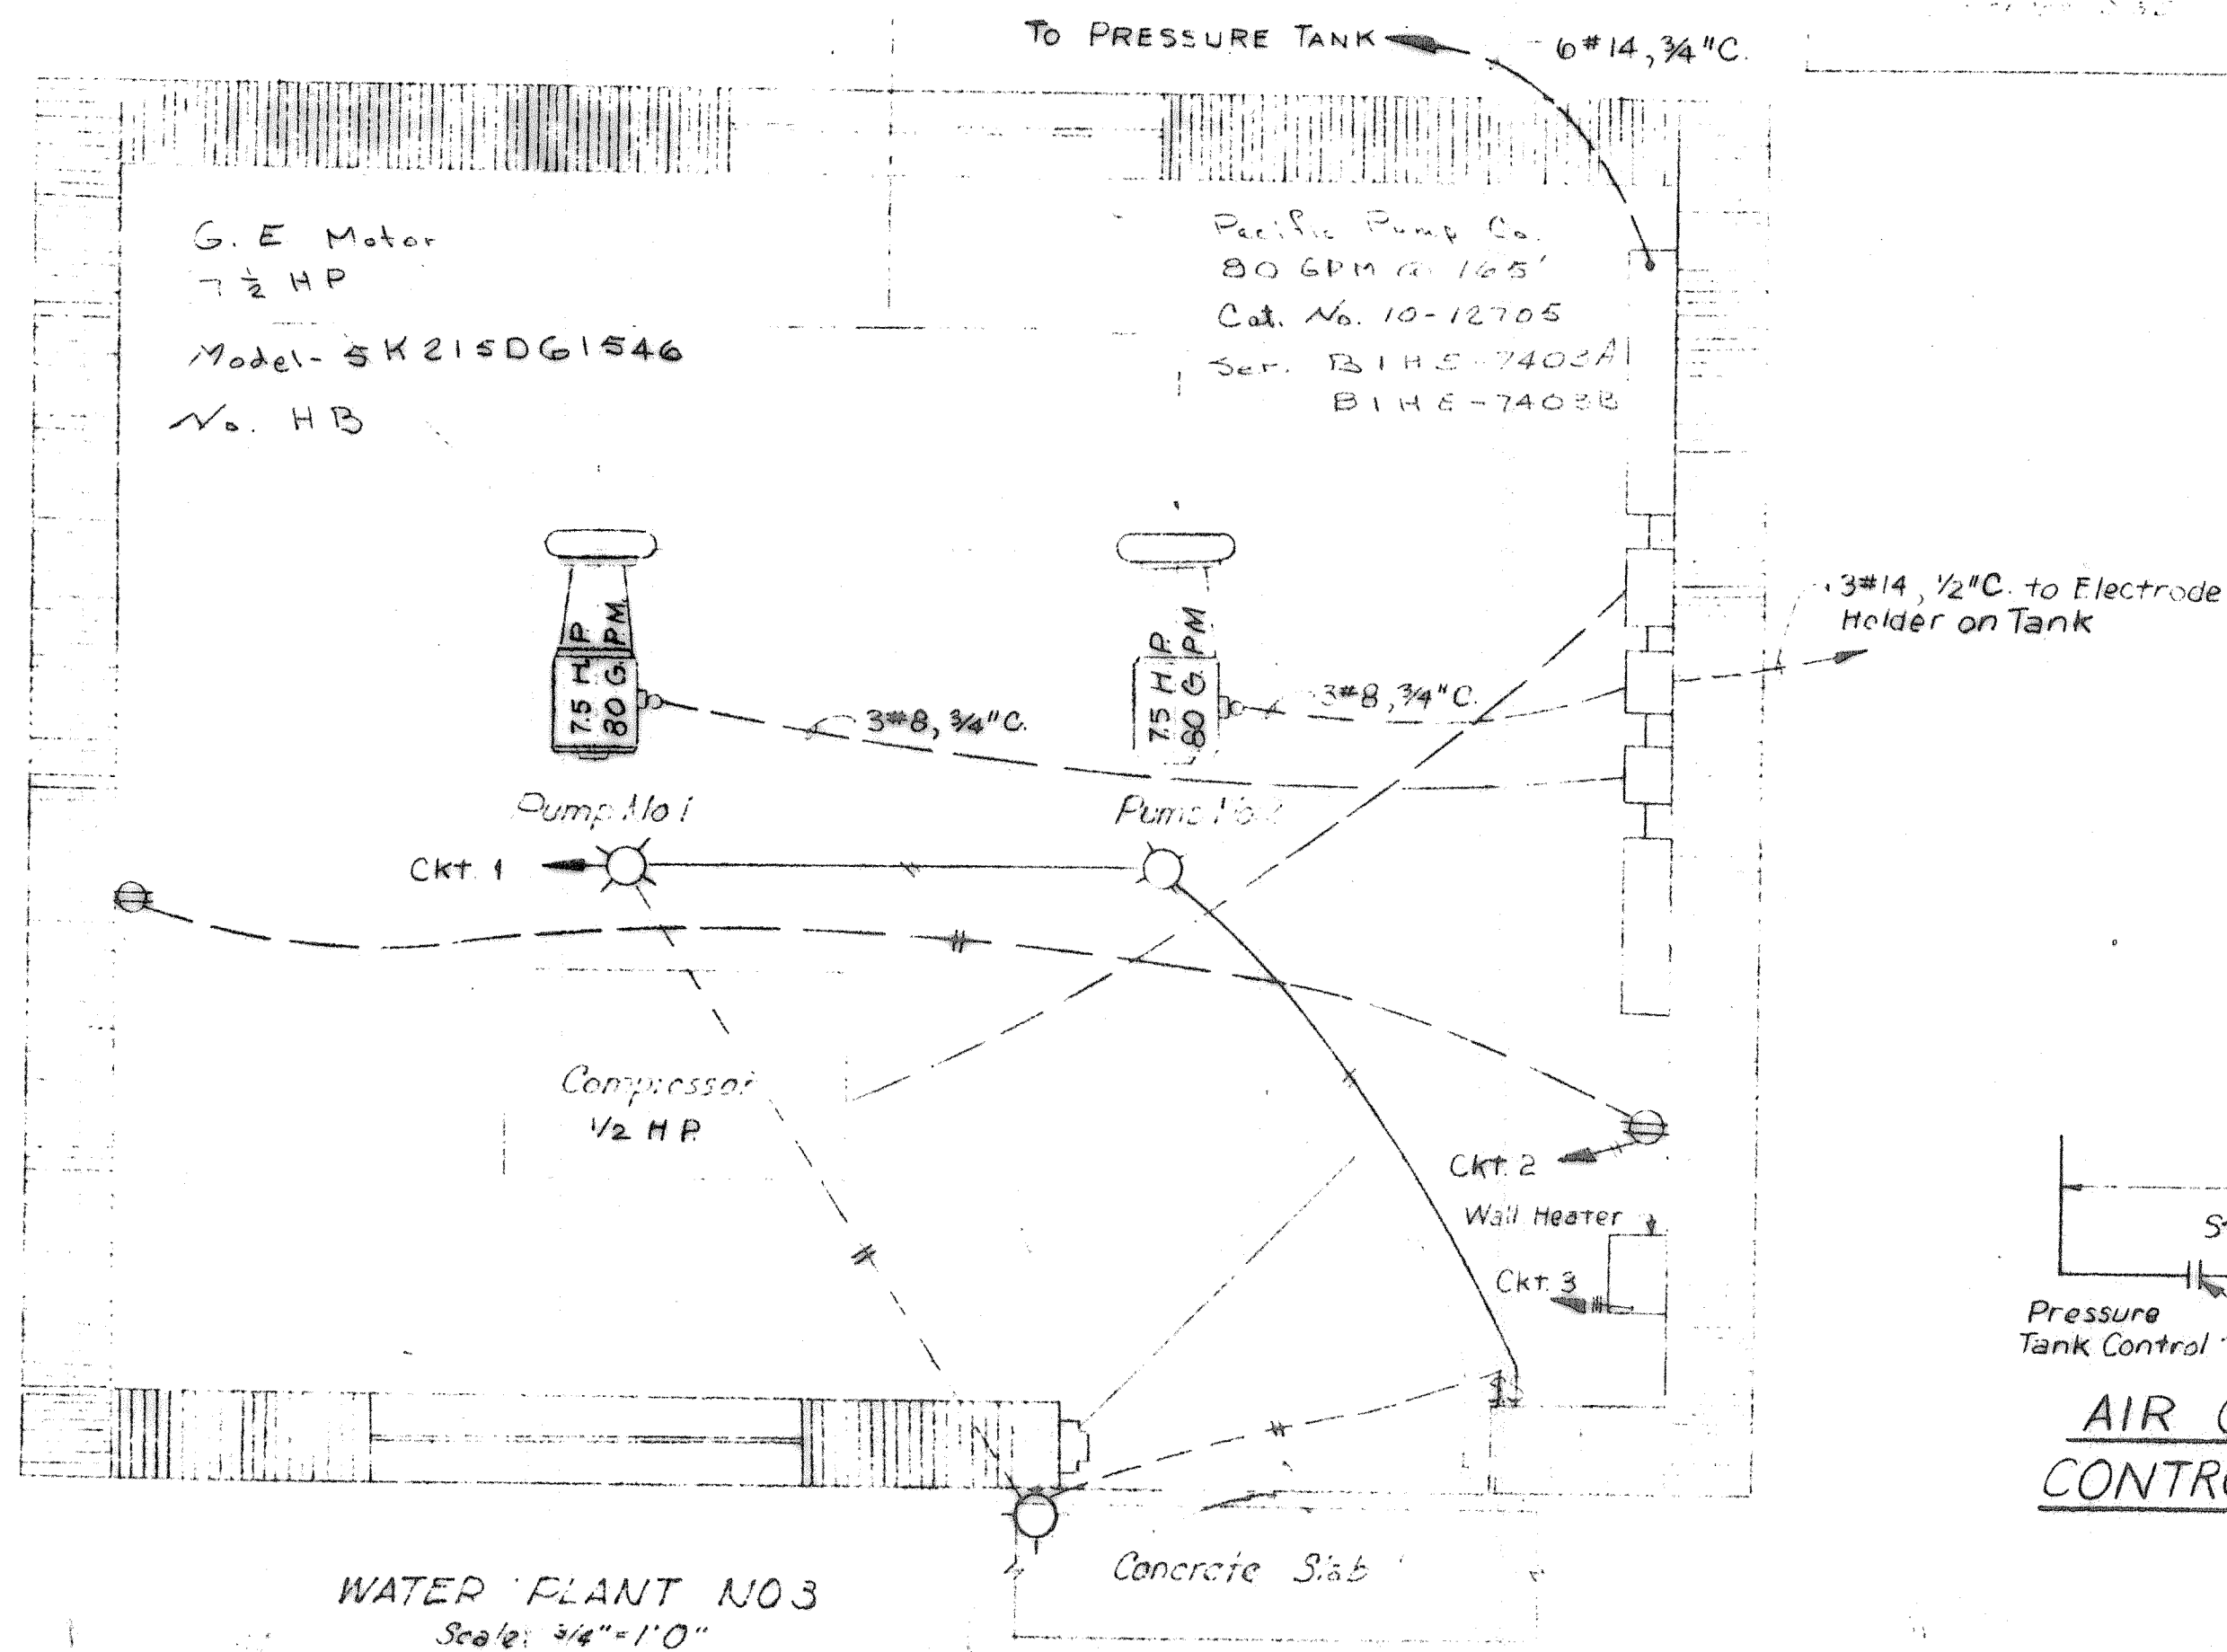


WATER PLANT NO. 3  
Scale: 3/4" = 1'0"

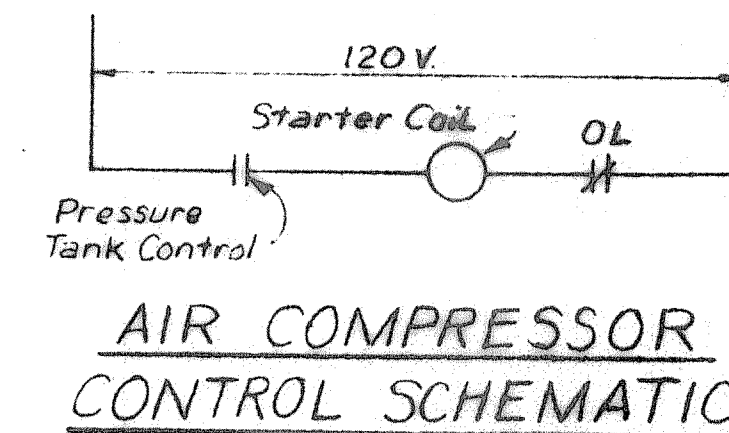

AIR COMPRESSOR CONTROL SCHEMATIC

JANUARY, 1968

BLACKLAND WATER SUPPLY CORP.  
ROCKWALL COUNTY, TEXAS  
WATER DISTRIBUTION SYSTEM  
ELECTRICAL DETAILS

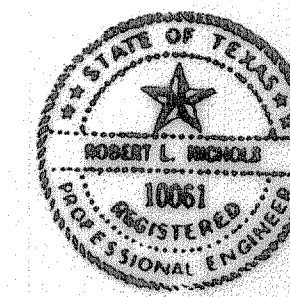

DESIGNED	D.L.D.	FREES, NICHOLS & ENDRESS CONSULTING ENGINEERS FORT WORTH, TEXAS	DATE	Feb. 1966
DRAWN	G.E.H.		SCALE	
TRACED	G.E.H.		Sheet No.	20
CHECKED	R.L.N.		of	