


REVISED-AS BUILT
DATE 12-30-69

TOP SLAB PLAN
SCALE 3/4" = 1'-0"

PLAN - LAYOUT
SCALE 3/4" = 1'-0"

CITY OF ROCKWALL, TEXAS
WATER SYSTEM IMPROVEMENTS
METERING STATION DETAILS
BLACKLAND WATER SUPPLY
CORPORATION CONNECTION

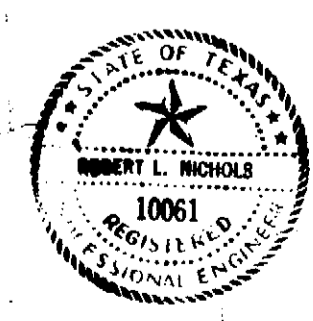

DESIGNED: D.L.D.	FRESE, NICHOLS & ENDRESS CONSULTING ENGINEERS FORT WORTH, TEXAS	DATE: 12-30-69
DRAWN: J.D.M.		SHEET: 2
TRACED: J.D.M.		OF: 2
CHECKED: J.R.N.		Scale: 1" = 1'-0"