

PRESSURE SYSTEM
 INSTALL:
 1- 12" x 12" TEE
 1- 12" VALVE
 1- 12" x 6" REDUCER
 1- 6" VALVE
 1- 6" x 6" TAPPING SLEEVE


FEED SYSTEM
 INSTALL:
 1- 12" 90° BEND
 1- 12" PLUG

AS BUILT

SHEET INDEX	
SHEET NO.	DESCRIPTION
1	WATER MAIN PLAN
2	PUMP HOUSE DETAILS
3	ARCHITECTURAL & ELECTRICAL DETAILS
4	PUMPS & PIPING DETAILS
5	STORAGE TANK DETAILS
6	PRESSURE TANK DETAILS

BLACKLAND WATER SUPPLY CORPORATION

9-16-85 REVISED (DESIGN REQUIREMENTS)
 8-13-85 REVISED AS PER BOARD MEETING

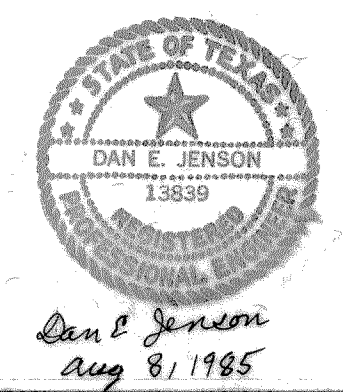

HAROLD L. EVANS
 CONSULTING ENGINEER
 2331 GUS THOMASSON RD. SUITE 102
 DALLAS, TEXAS 75228
 PHONE (214) 328-8133

SCALE	DATE	JOB NO.
1" = 100'	8-8-85	78144

BLACKLAND WATER SUPPLY CORP.
WATER DISTRIBUTION CENTER
 WATER MAIN PLAN
 ROCKWALL COUNTY, TEXAS

