


NOTE: Owners to select 1" Service Locations Before Pipe Prefabrication

NOTE: Contractor shall place Concrete Blocking behind all bands.

REVISED - AS BUILT
DATE 10-18-78 W.C.M.

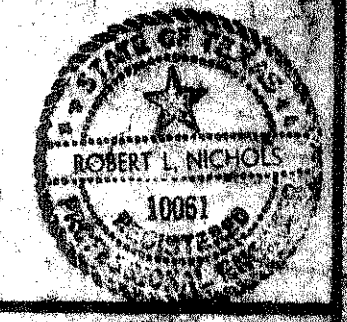

ROCKWALL, TEXAS
WATER SYSTEM IMPROVEMENTS
16" FEEDER MAIN
ALONG F.M. ROAD 740
PLAN & PROFILE

DESIGNED	R.I.N.	FREESE, NICHOLS & ENDRESS CONSULTING ENGINEERS	DATE: MAR 1971 SCALE: 1" = 100' SHEET 2 OF 2
DRAWN	T.C.F.		
CHECKED	R.L.N.		