


- LEGEND**
- EXISTING FIRE HYDRANT
  - PROPOSED FIRE HYDRANT
  - ⊗ WATER VALVE
  - ▽ REDUCER

OK - 10-14-74 M.C.M.

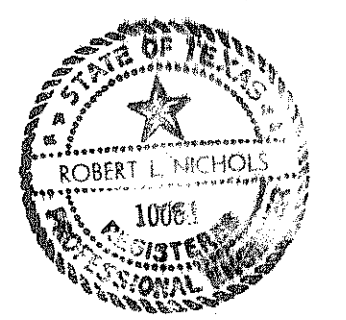

<b>ROCKWALL, TEXAS</b>		
<b>WATER SYSTEM IMPROVEMENTS</b>		
<b>16" FEEDER MAIN ALONG F.M. ROAD 740</b>		
<b>VICINITY MAP</b>		
DESIGNED	D.L.D.	<b>FREESE, NICHOLS &amp; ENDRESS</b> CONSULTING ENGINEERS
DRAWN	T.C.E.	
TRACED	---	
CHECKED	R.L.N.	
DATE		MAY 1973
SCALE		AS SHOWN
PROJECT NO.		ROK 73032
SHEET		1 OF 11