


NOTE: Existing 6" A.C. Water Line in same easement with proposed 16" Feeder Main between Sta. 98+72 to Sta. 118+03. Pipe line Contractor shall be responsible for keeping 6" water line in service and repair any breaks along this section during construction.

NOTE: Contractor shall place Concrete Blocking behind all bends.

ROCKWALL, TEXAS  
 WATER SYSTEM IMPROVEMENTS  
 16" FEEDER MAIN  
 ALONG F.M. ROAD 740  
 PLAN & PROFILE

DESIGNED	D.L.N.	DATE	MAY, 1973
DRAWN	T.C.E.	SCALE	AS SHOWN
TRACED		CONSULTING ENGINEERS	FREESE, NICHOLS & ENDRESS
CHECKED	R.L.N.		ROK 73032 SHEET 3 OF 11

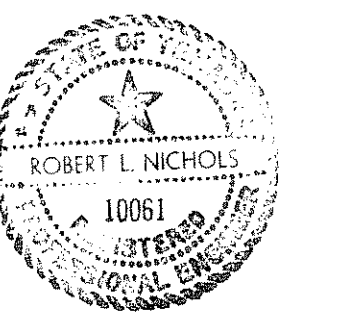

10-19-74 u.s.k.