


REVISED AS BUILT
DATE 10-12-79 W.C.N.

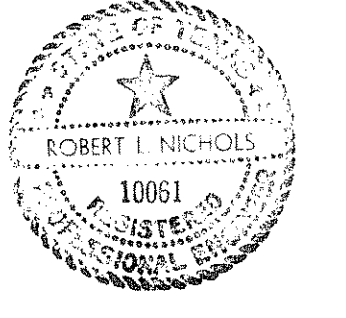

ROCKWALL, TEXAS
WATER SYSTEM IMPROVEMENTS
16" FEEDER MAIN
ALONG F.M. ROAD 740
PLAN & PROFILE

DESIGNED	D.L.D.	FREES, NICHOLS & ENDRESS	DATE: MAY, 1973
DRAWN	T.C.E.	CONSULTING ENGINEERS	SCALE: AS SHOWN
TRACED			ROK 73032
CHECKED	R.L.N.		SHEET 4 OF 11