


REVISIONS

NO.	DATE	DESCRIPTION
1	10-14-74	AS BUILT

DATE 10-14-74 W.C.N.

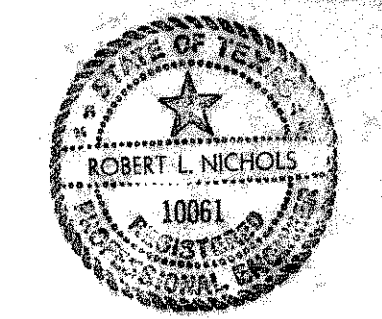

ROCKWALL, TEXAS
 WATER SYSTEM IMPROVEMENTS
 16" FEEDER MAIN
 ALONG F.M. ROAD 740
 PLAN & PROFILE

DESIGNED: D.L.D.
 DRAWN: T.C.E.
 TRACED: R.L.N.
 CHECKED: R.L.N.

FREES, NICHOLS & ENDRESS
 CONSULTING ENGINEERS

DATE: MAY, 1973
 SCALE: AS SHOWN
 ROK 73032
 SHEET 8 OF 11