


REVISED - AS BUILT  
DATE 10-14-74 W.C.N.

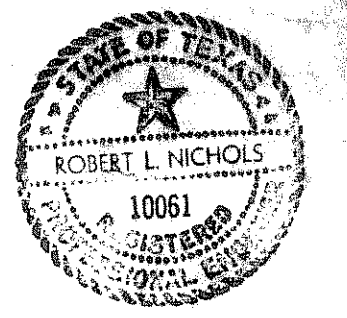

ROCKWALL, TEXAS  
WATER SYSTEM IMPROVEMENTS  
16" FEEDER MAIN  
ALONG F.M. ROAD 740  
REECE STREET 12" MAIN  
DETAILS

DESIGNED	D.L.D.	FREESE, NICHOLS & ENDRESS CONSULTING ENGINEERS	DATE: MAY 1973
DRAWN	T.C.F.		SCALE: AS SHOWN
TRACED			ROK 73032
CHECKED	R.L.N.		SHEET 6 OF 11