
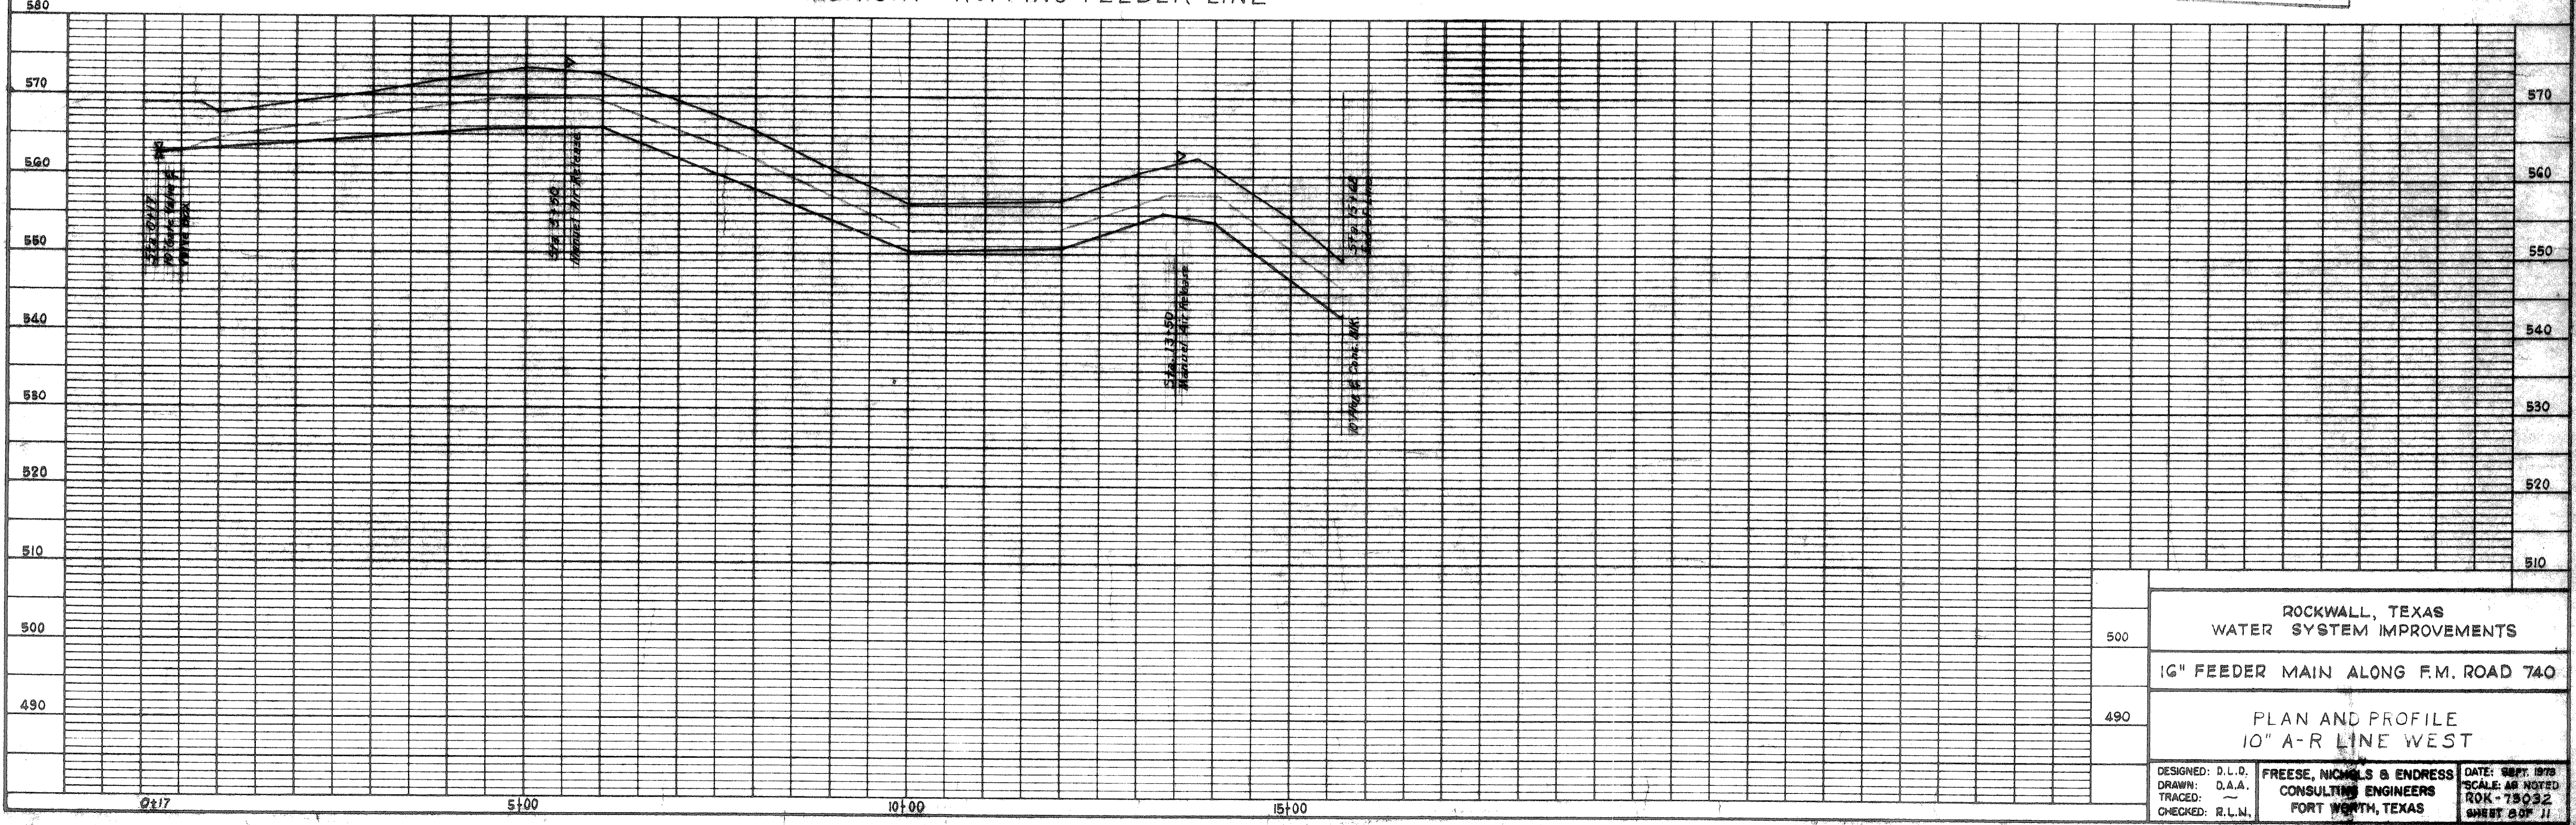


NOTE: Contractor shall place Concrete Blocking behind all bands.

10" ALBRIGHT - ROFFINO FEEDER LINE

REVISED - AS BUILT
DATE 10-17-74 W.C.N.

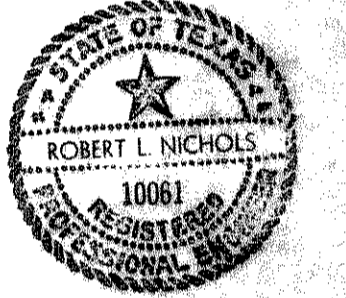

580	ROCKWALL, TEXAS WATER SYSTEM IMPROVEMENTS
570	10" FEEDER MAIN ALONG F.M. ROAD 740
560	PLAN AND PROFILE 10" A-R LINE WEST
550	DESIGNED: D.L.D. FREESE, NICHOLS & ENDRESS DATE: SEPT. 1978 DRAWN: D.A.A. CONSULTING ENGINEERS SCALE: AS NOTED TRACED: FORT WORTH, TEXAS ROK-73032 CHECKED: R.L.N. SHEET 807 11