
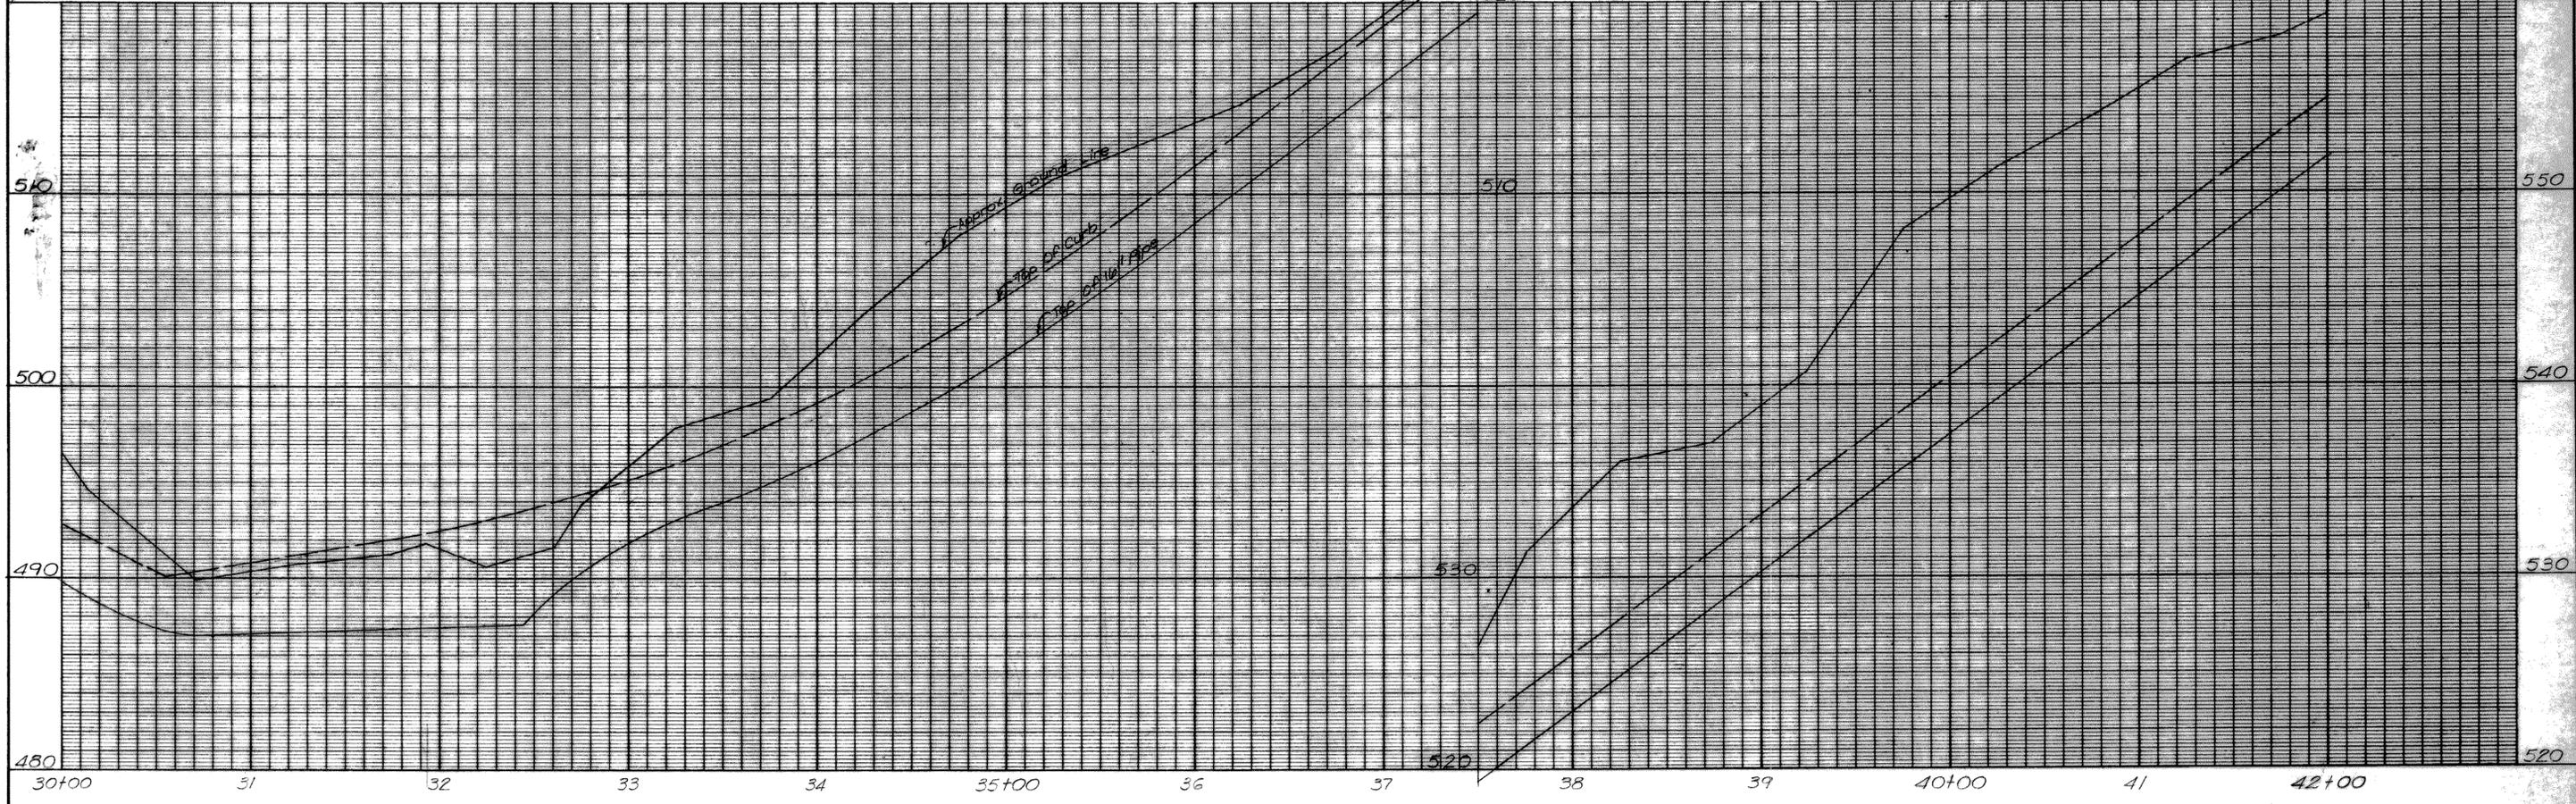


Scale: 1"=40'

RE. Bodin & N.W. Paschel
Goldencrest Condominiums
Lot 1 Block B

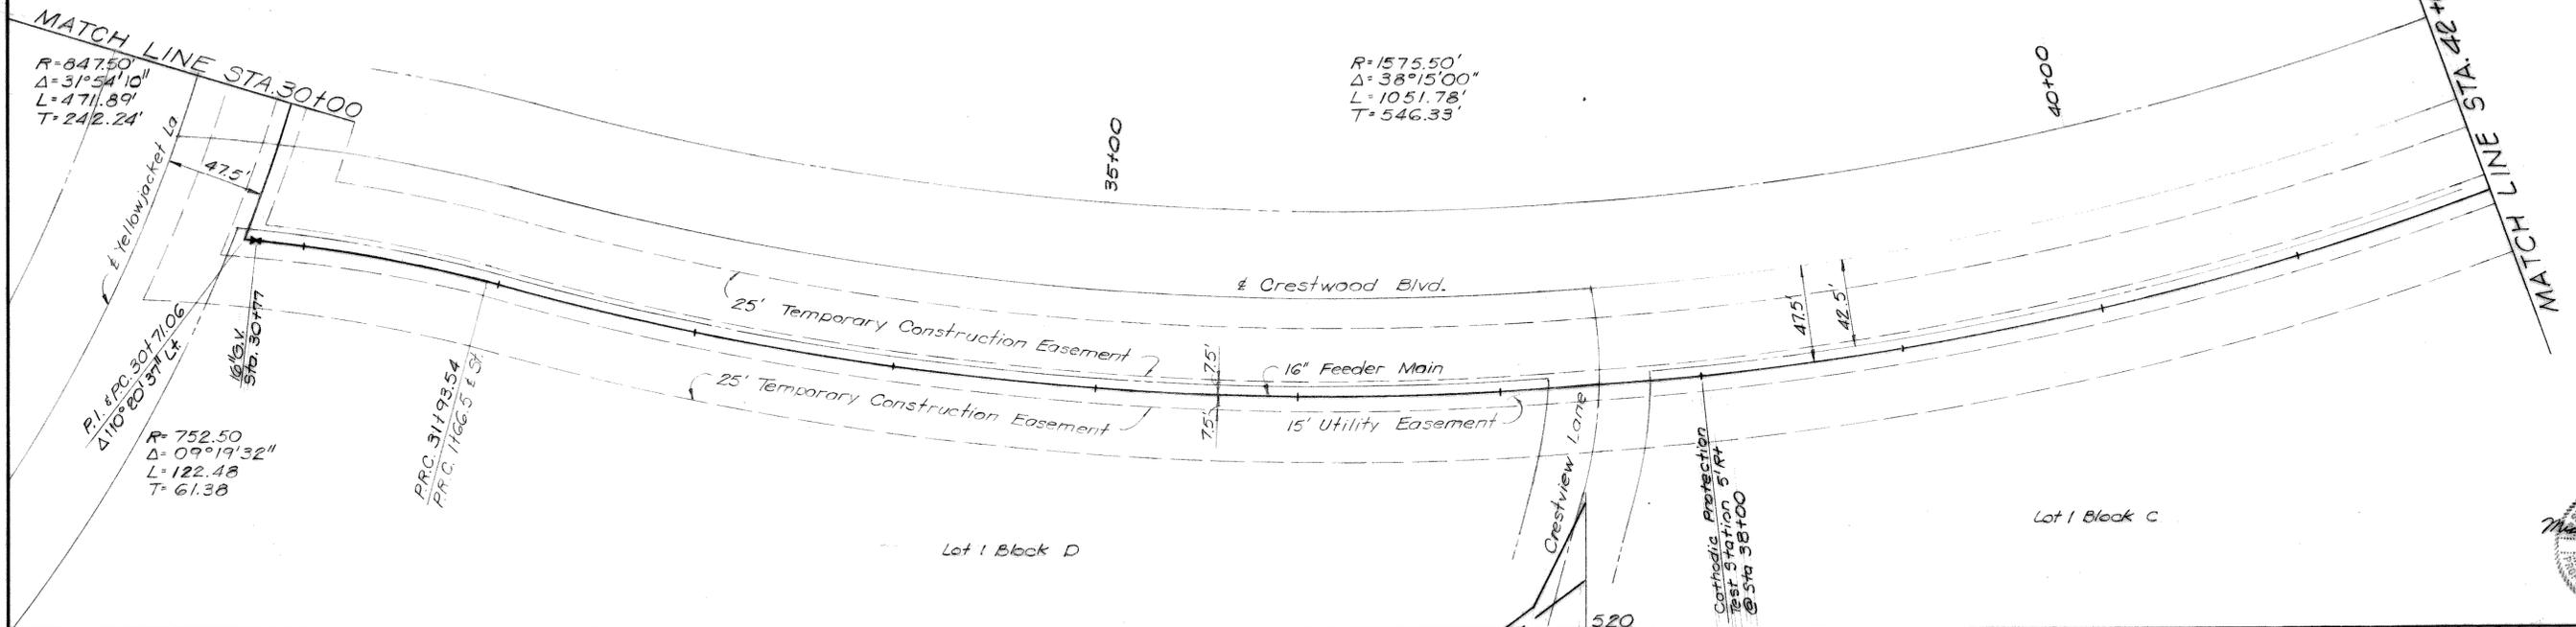

DESIGNED DRAWN TRACED CHECKED	DATE BY	JOB NO. ROK 84065 DATE SCALE H=40' V=4'	FRESE AND NICHOLS CONSULTING ENGINEERS FORT WORTH-AUSTIN, TEXAS	CITY OF ROCKWALL 16" FEEDER MAIN	PLAN AND PROFILE STA.30+00 TO STA.42+00	SHEET 10 of 15
--	------------	---	---	-------------------------------------	--	-------------------