

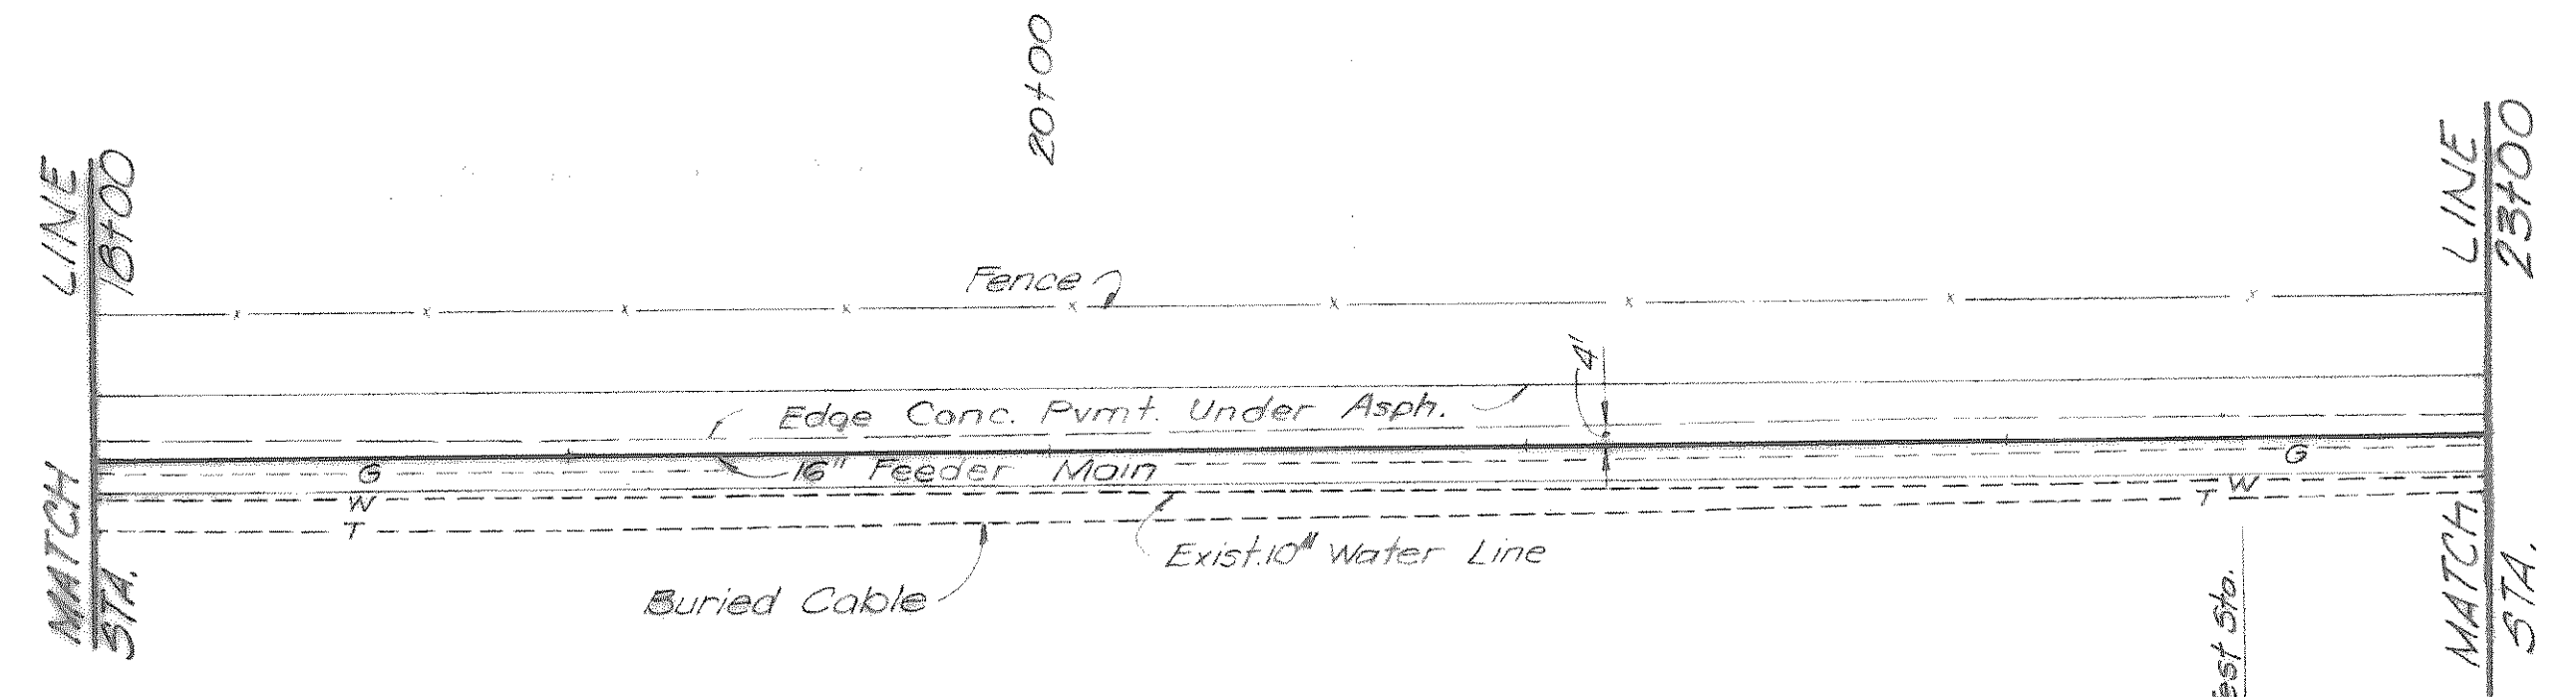


Scale: 1" = 40'-0"

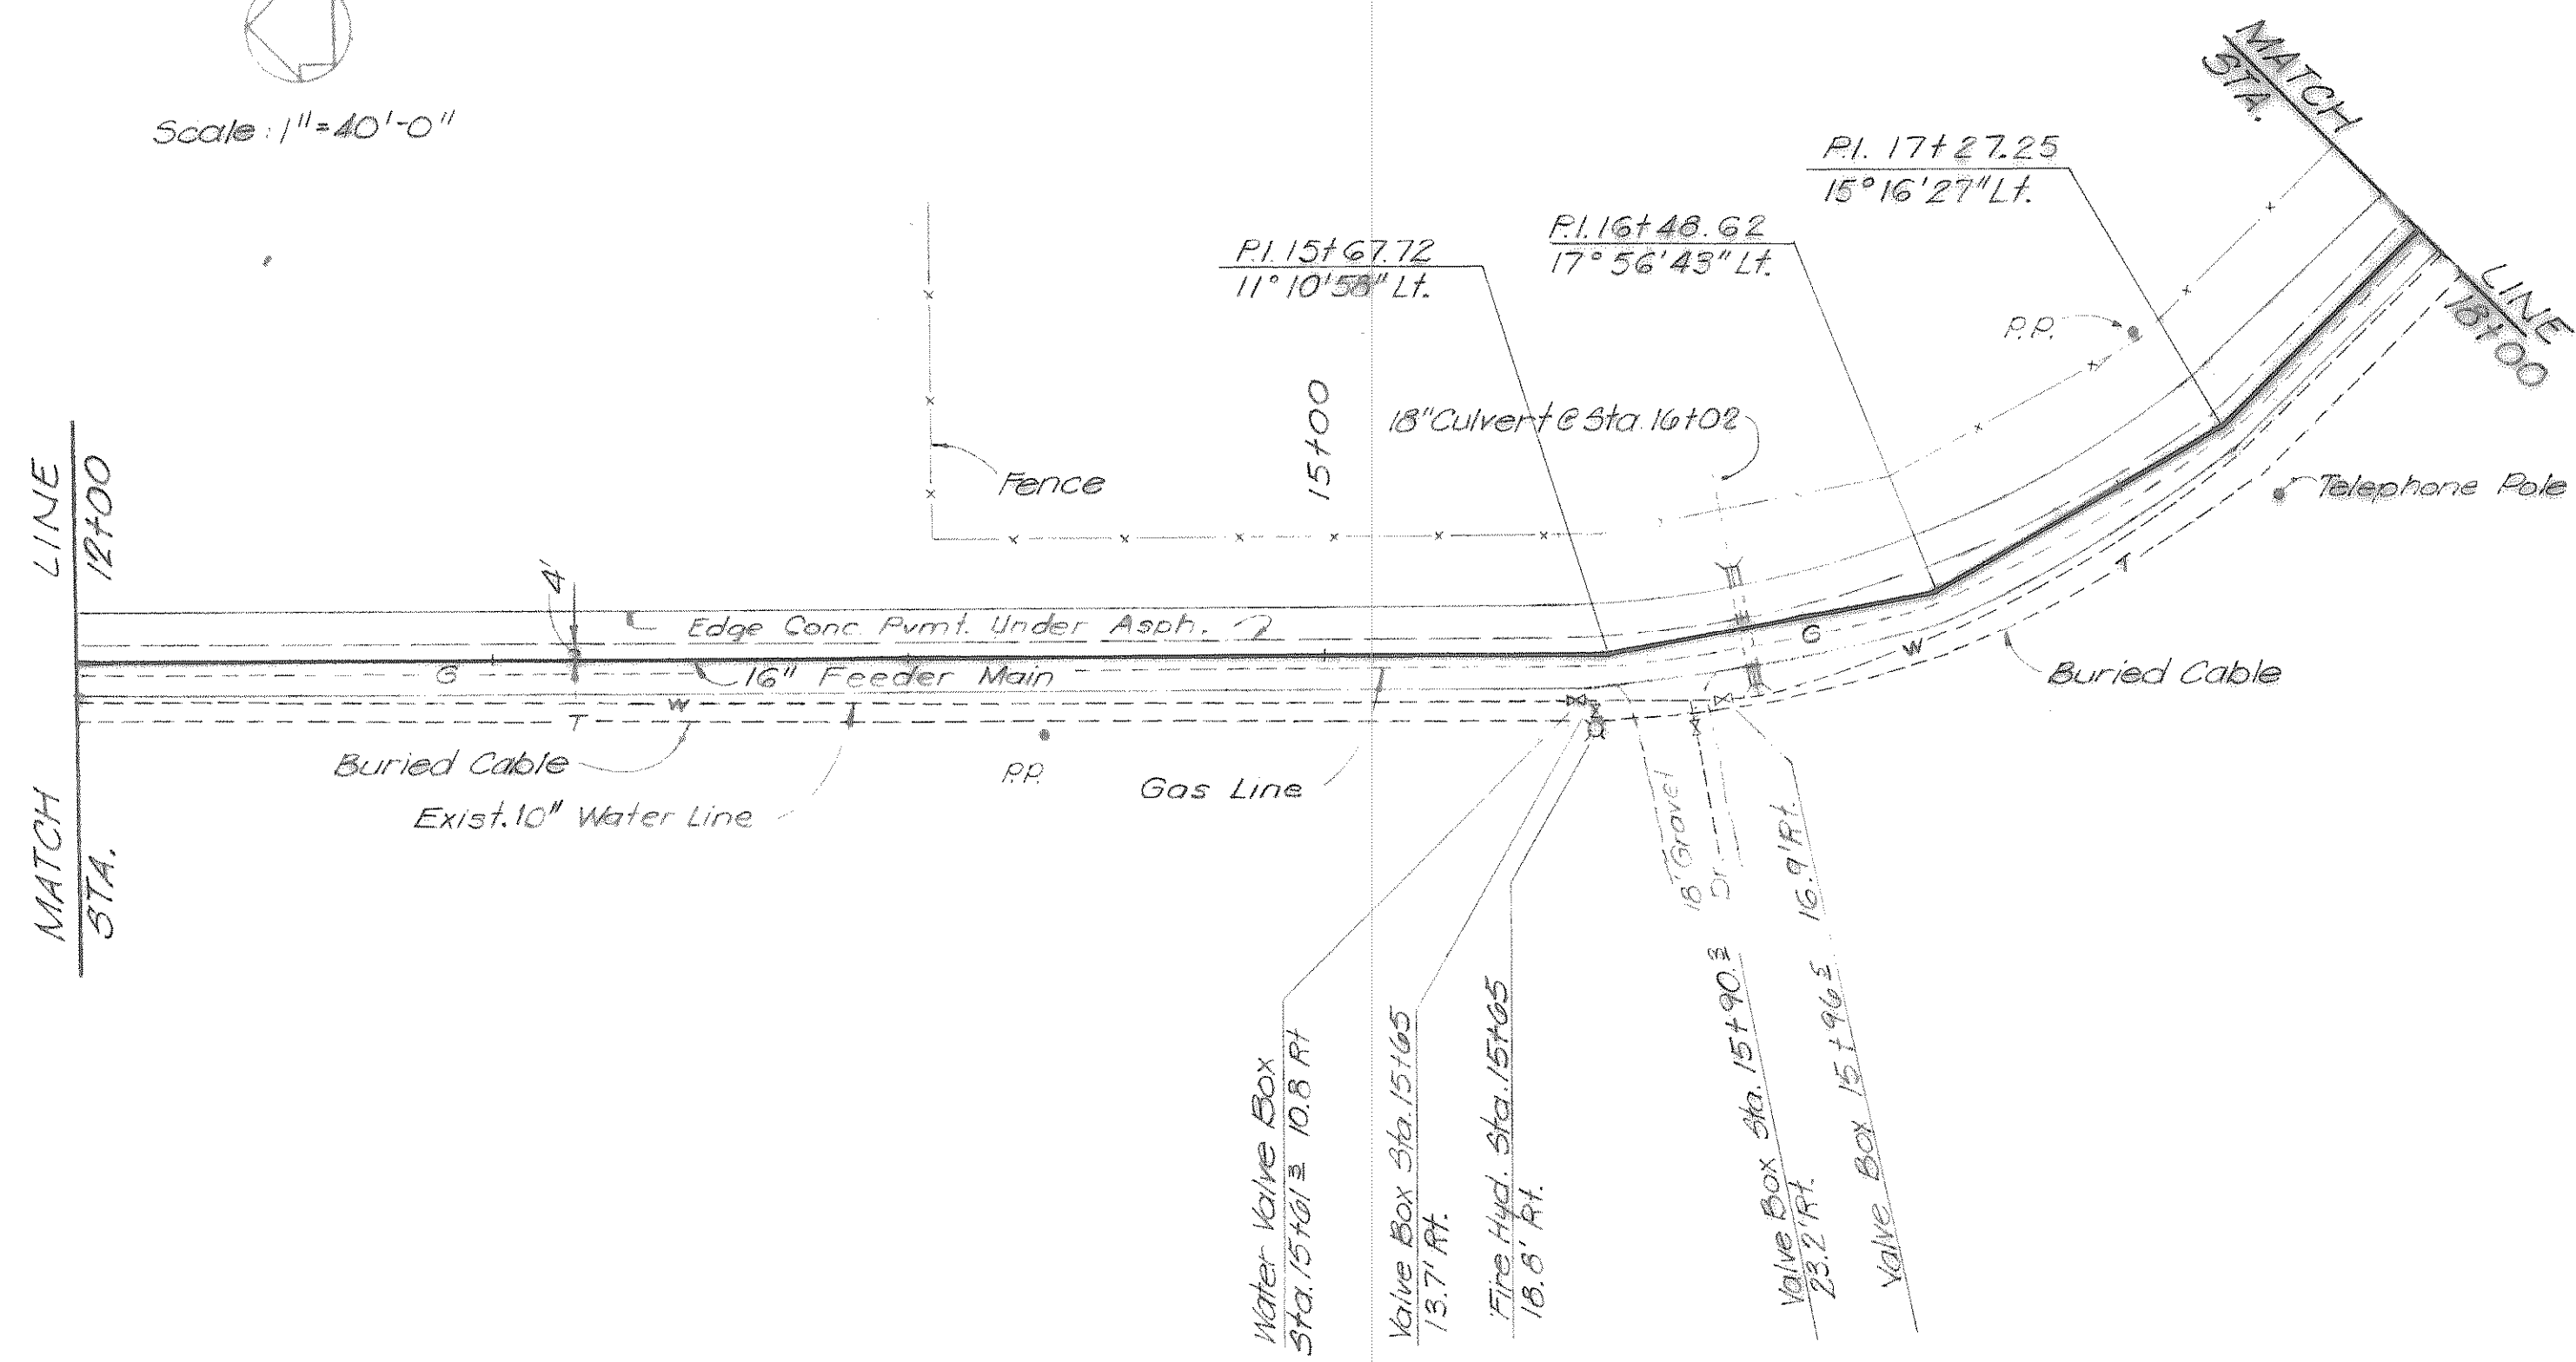

Cathodic Protection Test Sta.
15' RT @ Sta. 22+50

Michael J. Marshall
8-10-84

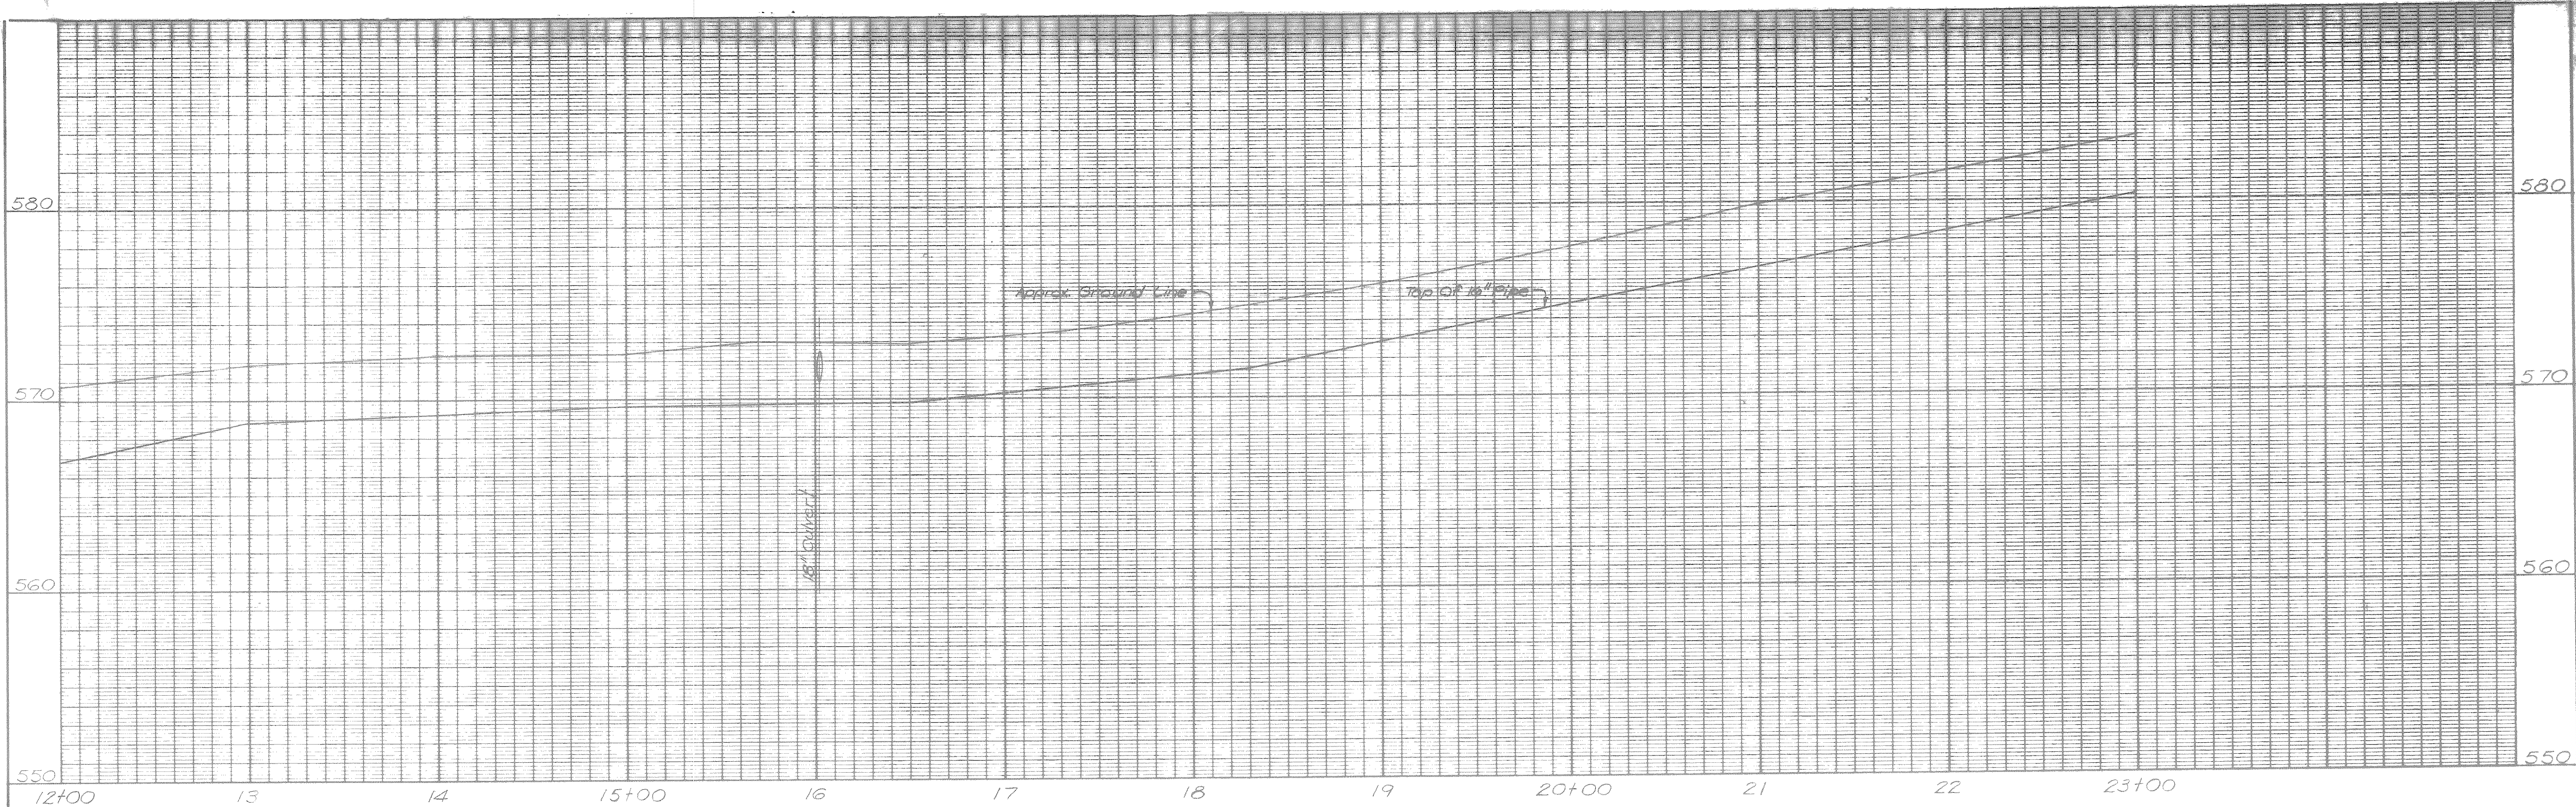

DESIGNED <i>MLN</i>	JOB NO. ROK 84065	FREES AND NICHOLS CONSULTING ENGINEERS FORT WORTH-AUSTIN, TEXAS	CITY OF ROCKWALL 16" FEEDER MAIN	PLAN AND PROFILE STA. 12+00 TO STA. 23+00	SHEET 3 of 15
DRAWN <i>BGD</i>	DATE				
TRACED	SCALE H=40' V=4'				
CHECKED	BY				
DATE	REVISION				