
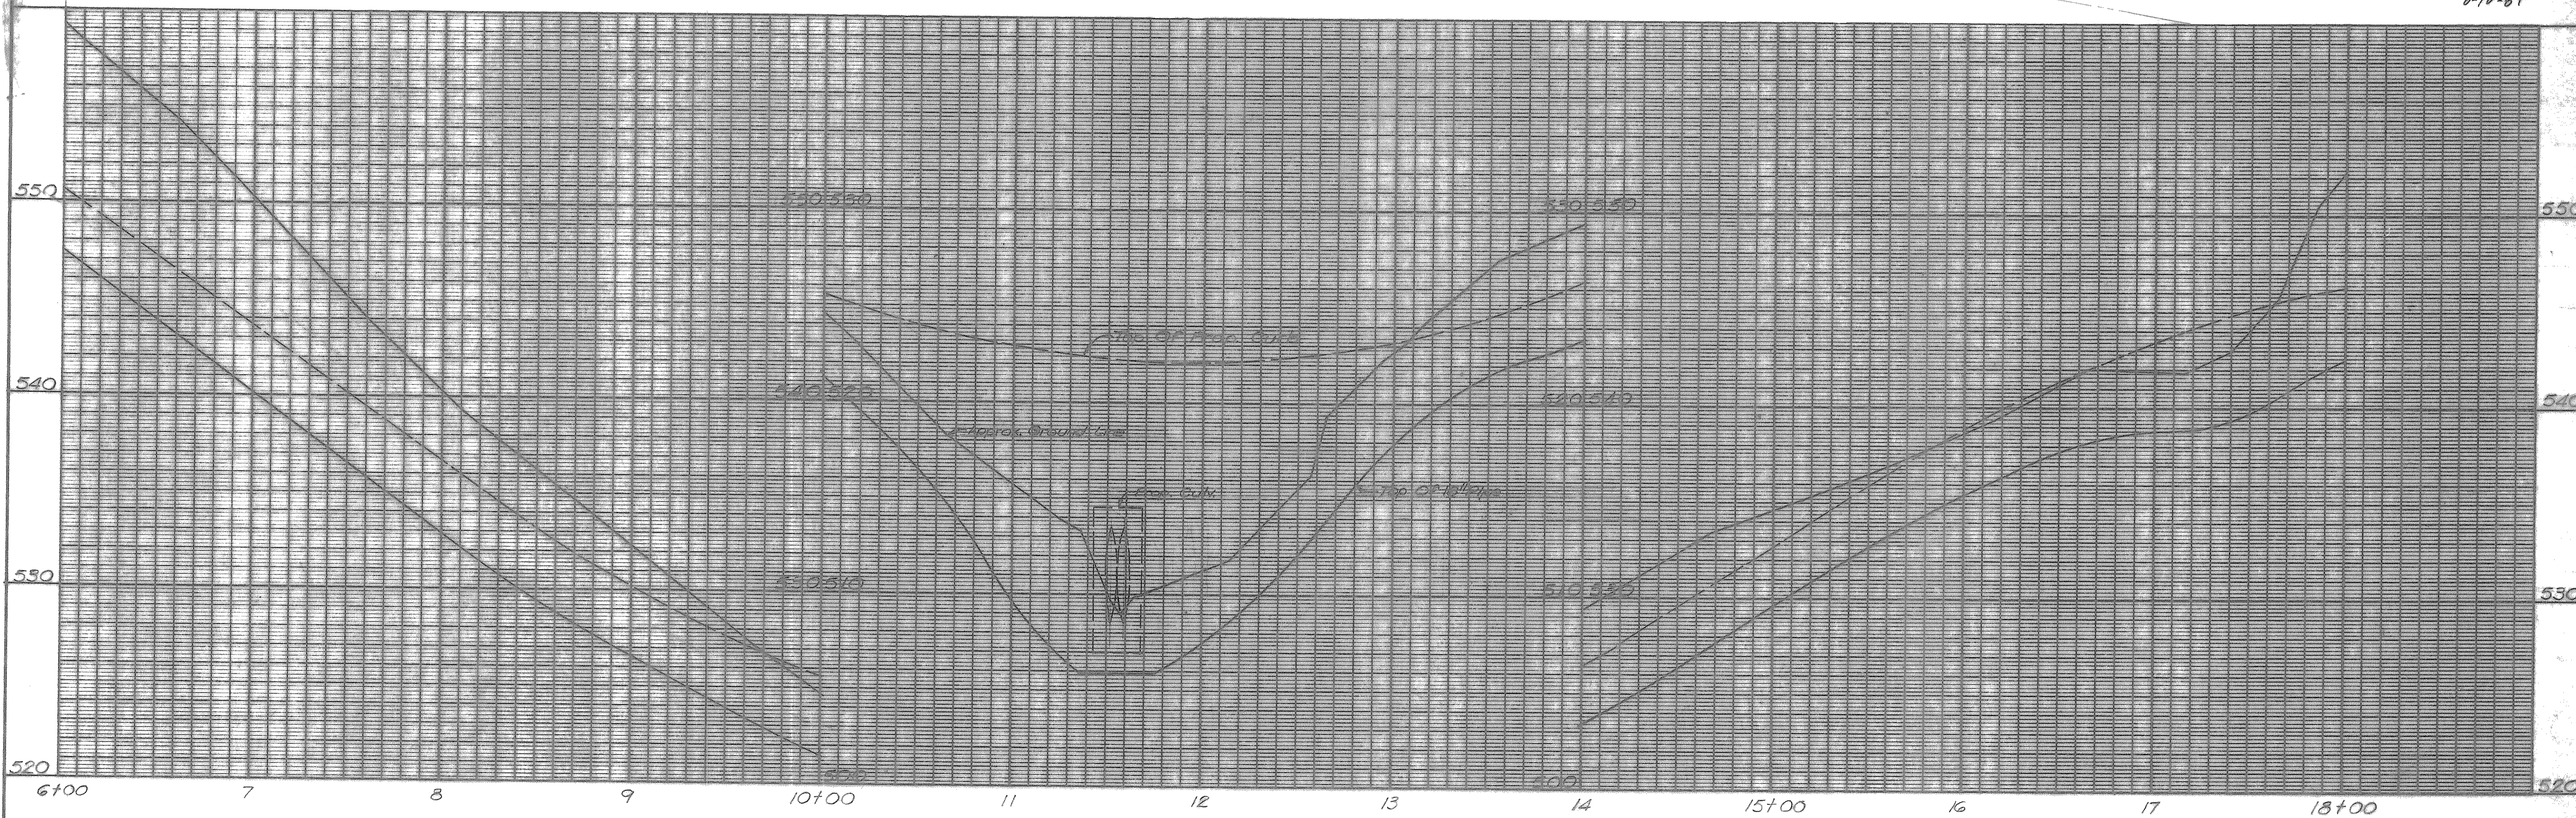
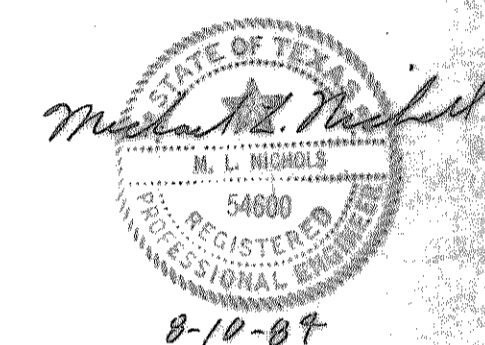


Scale: 1" = 40'

Henry S. Miller, Trustee
41.264 A.C.

P.E. Bedin & N.W. Paschal
Goldencrest Condominiums
Lot 1 Block B

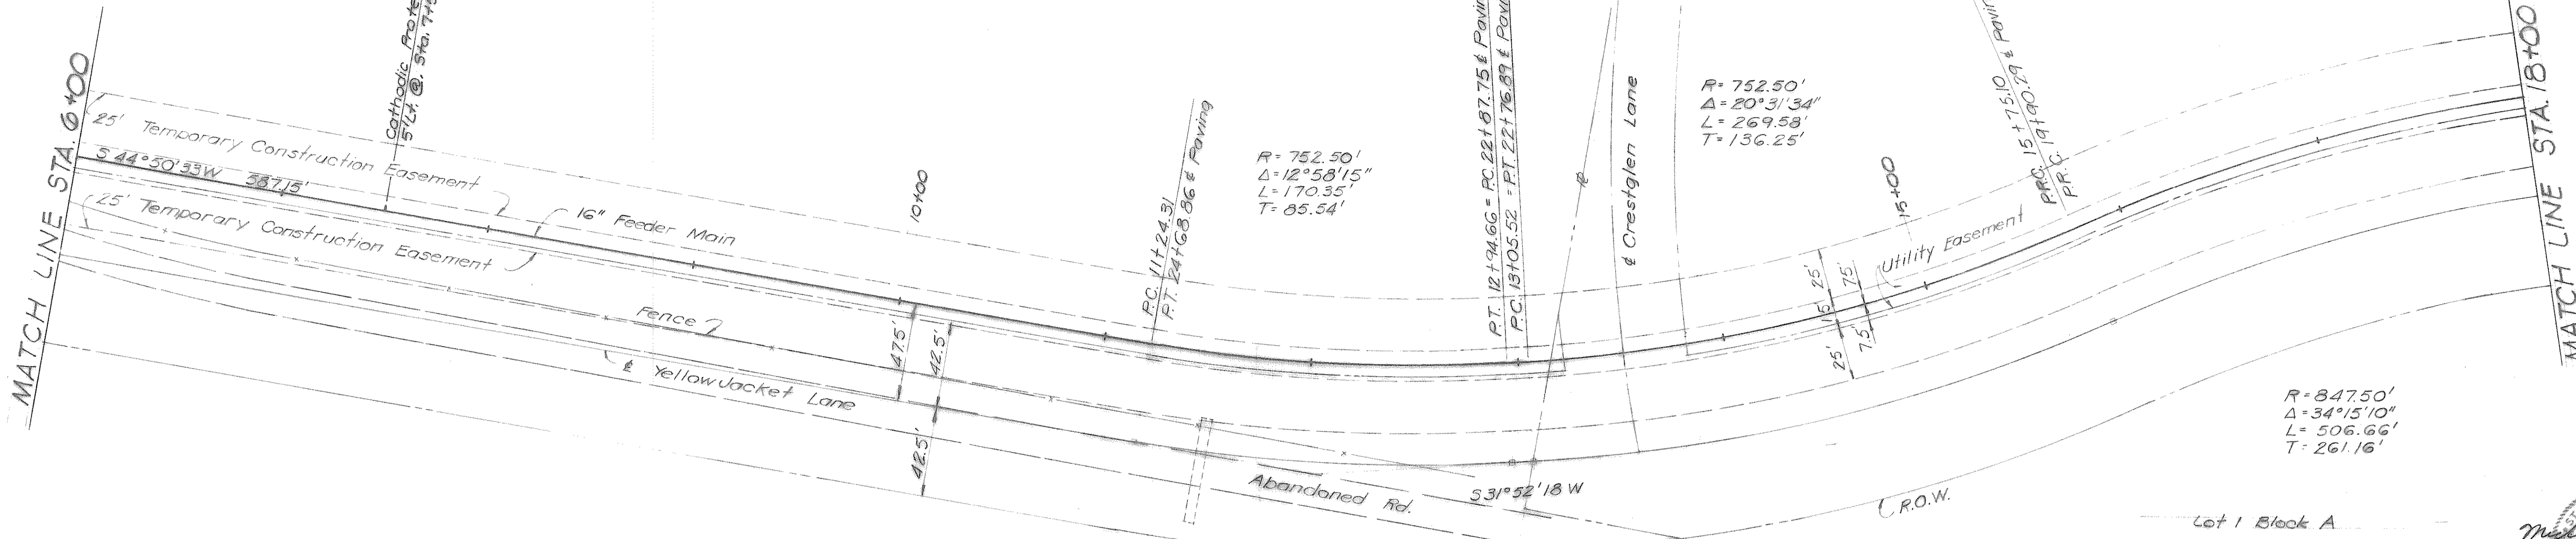

DESIGNED <i>MLN</i>	JOB NO. ROK 84069	FRESE AND NICHOLS CONSULTING ENGINEERS FORT WORTH-AUSTIN, TEXAS	CITY OF ROCKWALL 16" FEEDER MAIN	PLAN AND PROFILE STA. 6+00 TO STA. 18+00	SHEET 8 of 15
TRACED <i>MLN</i>	DATE				
CHECKED	SCALE H=40' V=4'				