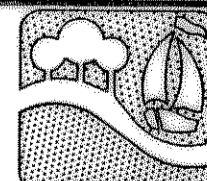



B.M.
600 NAIL IN POWER POLE EAST
SIDE OF HWY. 205, 15' SOUTH
OF DARRIN (NO. POLE #--POWER
POLE WITH RISER. ASSUMED ELEV.=100.00

**16' WATERLINE EXTENSION
AND REACTIVATION**

From Heath Street Pump Station to N. Alamo Street

 **CITY OF ROCKWALL**
"THE NEW HORIZON"

REVISION NO.	REMARKS	DATE

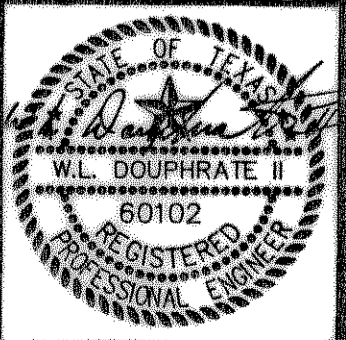DESIGNED: W.L.D.	THE SEAL APPEARING ON THIS DOCUMENT WAS AUTHORIZED BY W.L. DOUPHRADE II, TEXAS P.E. No. 60102 ON 7/8/91	
DRAWN: ACAD		
JOB NO. 91005		
DATE: 6/91	SHEET NO. 3 of 4	