
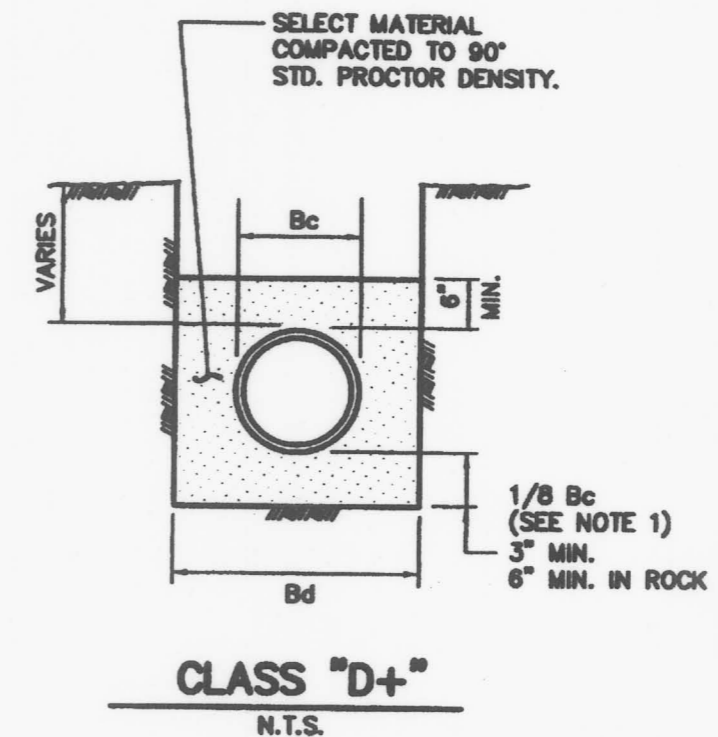


NOTES:
1. D = INSIDE DIAMETER OF PIPE
2. Bd = TRENCH WIDTH

| | | | | |
|------------------------------|--|--|----------------------------------|----------------------|
| EMBEDMENT | | | STANDARD SPECIFICATION REFERENCE | |
| CLASS "G" & "G-1" | | | 6.2 | |
| | | | DATE | STANDARD DRAWING NO. |
| | | | NOV. '96 | 3080 |

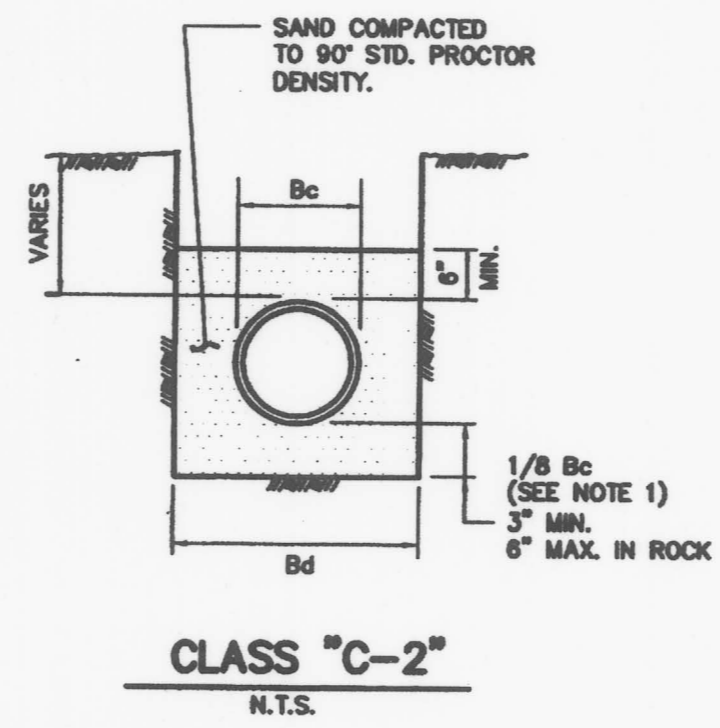

NOTES:
1. FOR MAINS 42" DIAMETER AND LARGER, 1/8 Bc SHALL BE TAKEN AS 6".
2. Bc = OUTSIDE DIAMETER OF PIPE
3. Bd = TRENCH WIDTH

| | | | | |
|-------------------------------|--|--|----------------------------------|----------------------|
| EMBEDMENT | | | STANDARD SPECIFICATION REFERENCE | |
| CLASS "C-2" & "D+" | | | 6.2 | |
| | | | DATE | STANDARD DRAWING NO. |
| | | | NOV. '96 | 3050 |


DATE: SEPTEMBER 12, 2002
DRAWN BY: TUC
CHECKED: RAH
COM NO: 144101044
REVISED:

16" & 20" WATER LINE CONSTRUCTION

ROCKWALL INDEPENDENT SCHOOL DISTRICT


ROCKWALL, TEXAS

FINAL PLANS FOR BIDDING AND CONSTRUCTION

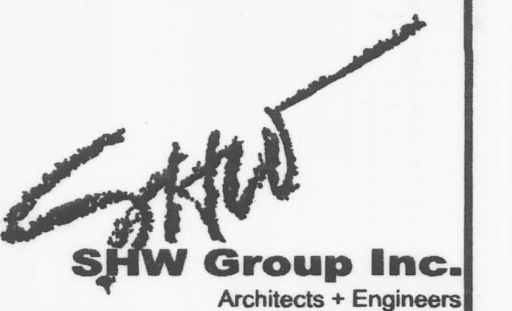

| | |
|--------------|------|
| SHEET NUMBER | C |
| OF | 2.10 |
| SET NUMBER | |

DETAILS
SCALE: AS NOTED

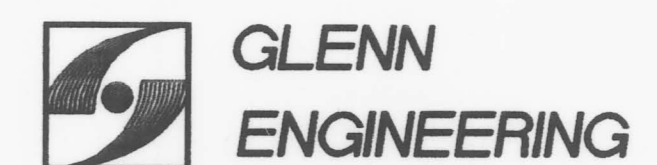

PHONE 972-717-5151 FAX 972-719-4229
100 DECKER COURT - SUITE 250 IRVING, TEXAS 75062