




These plans and related specifications were prepared for construction of this specific project only. Reuse of these documents is not permitted without written authorization of Birkhoff, Hendricks & Conway, L.L.P.

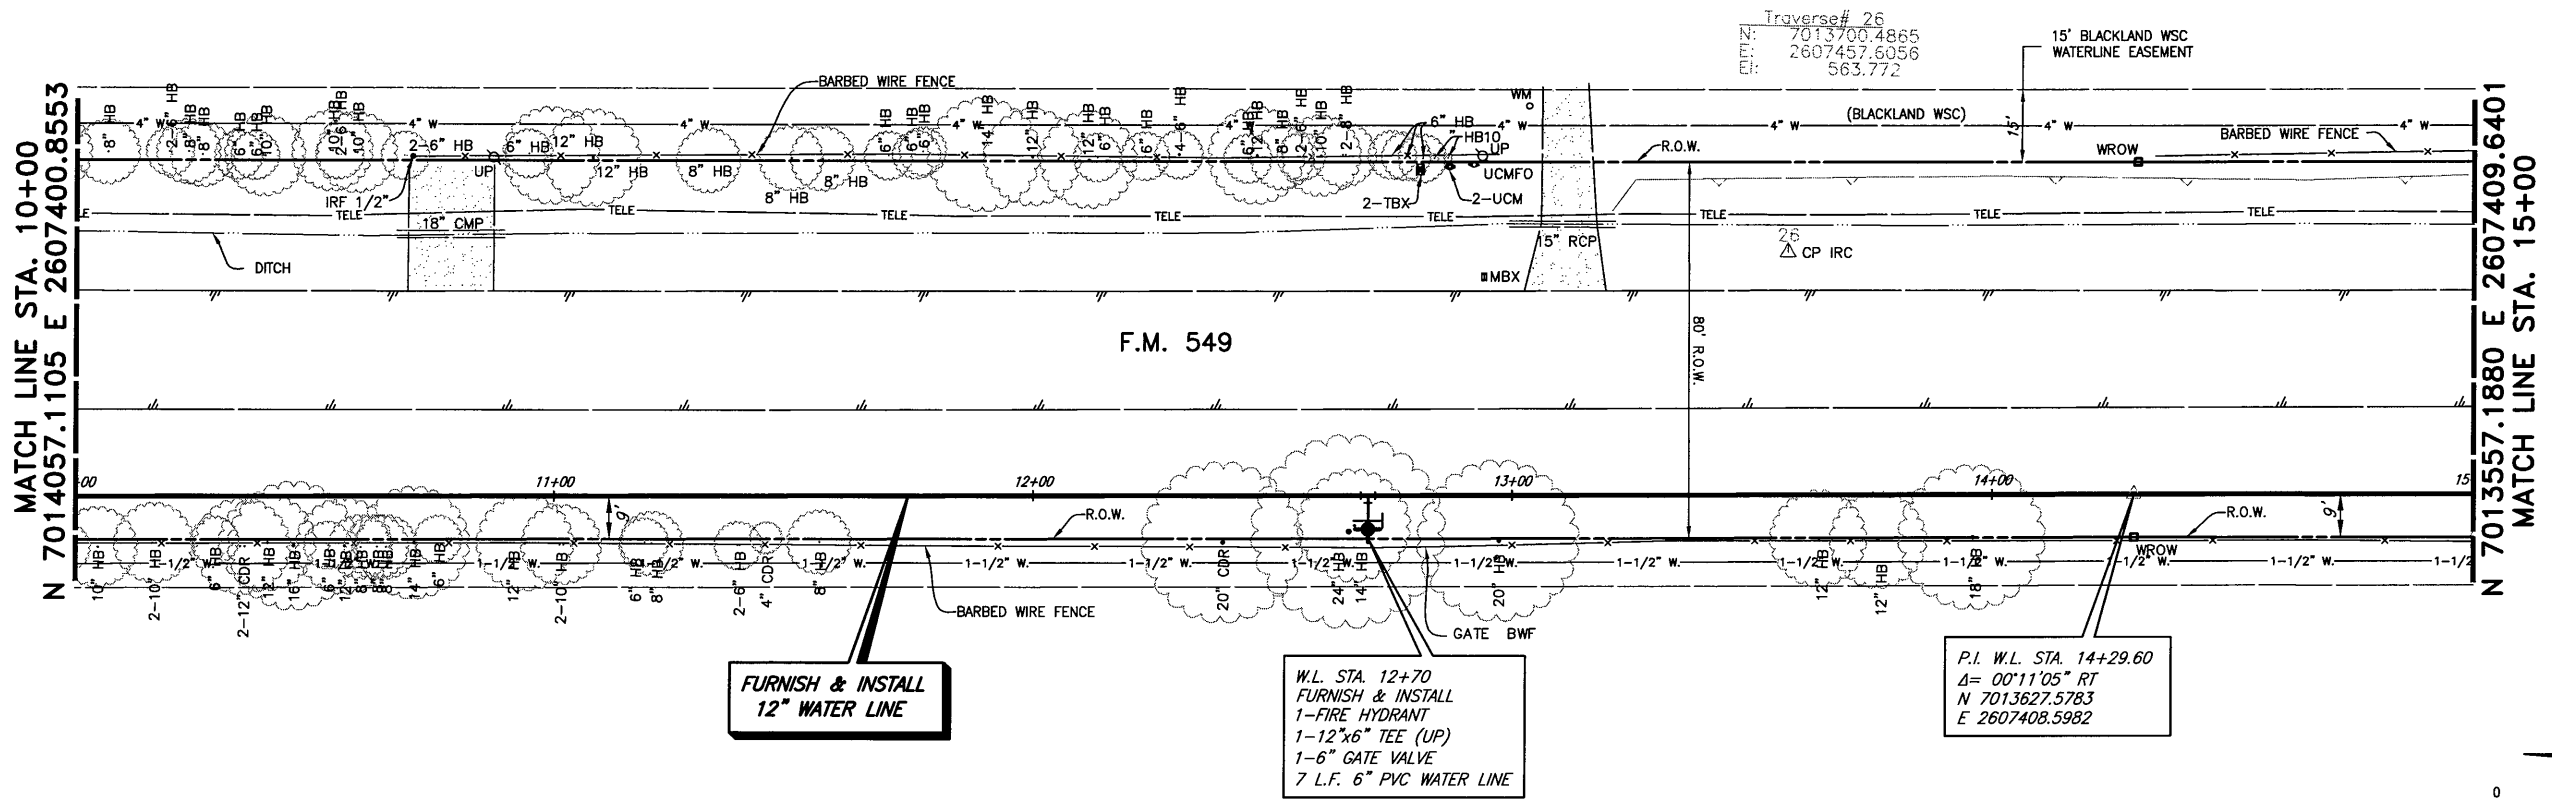


TREE REMOVAL = (NO PAY ITEM)

This record drawing is a compilation of the sealed engineering drawing for this project; modified by addenda, change orders and information furnished by the contractor. The information shown on the record drawings that was provided by the contractor or others not associated with the design engineer cannot be verified for accuracy or completeness. This original sealed drawings are on file at the offices of Birkhoff, Hendricks & Conway, L.L.P.  
 BY PAC DATE 4/10/08

**CAUTION!!**  
 BLACKLAND WSC WATER LINES IN AREA. CONTACT BLACKLAND WSC FOR LOCATES PRIOR TO CONSTRUCTION.

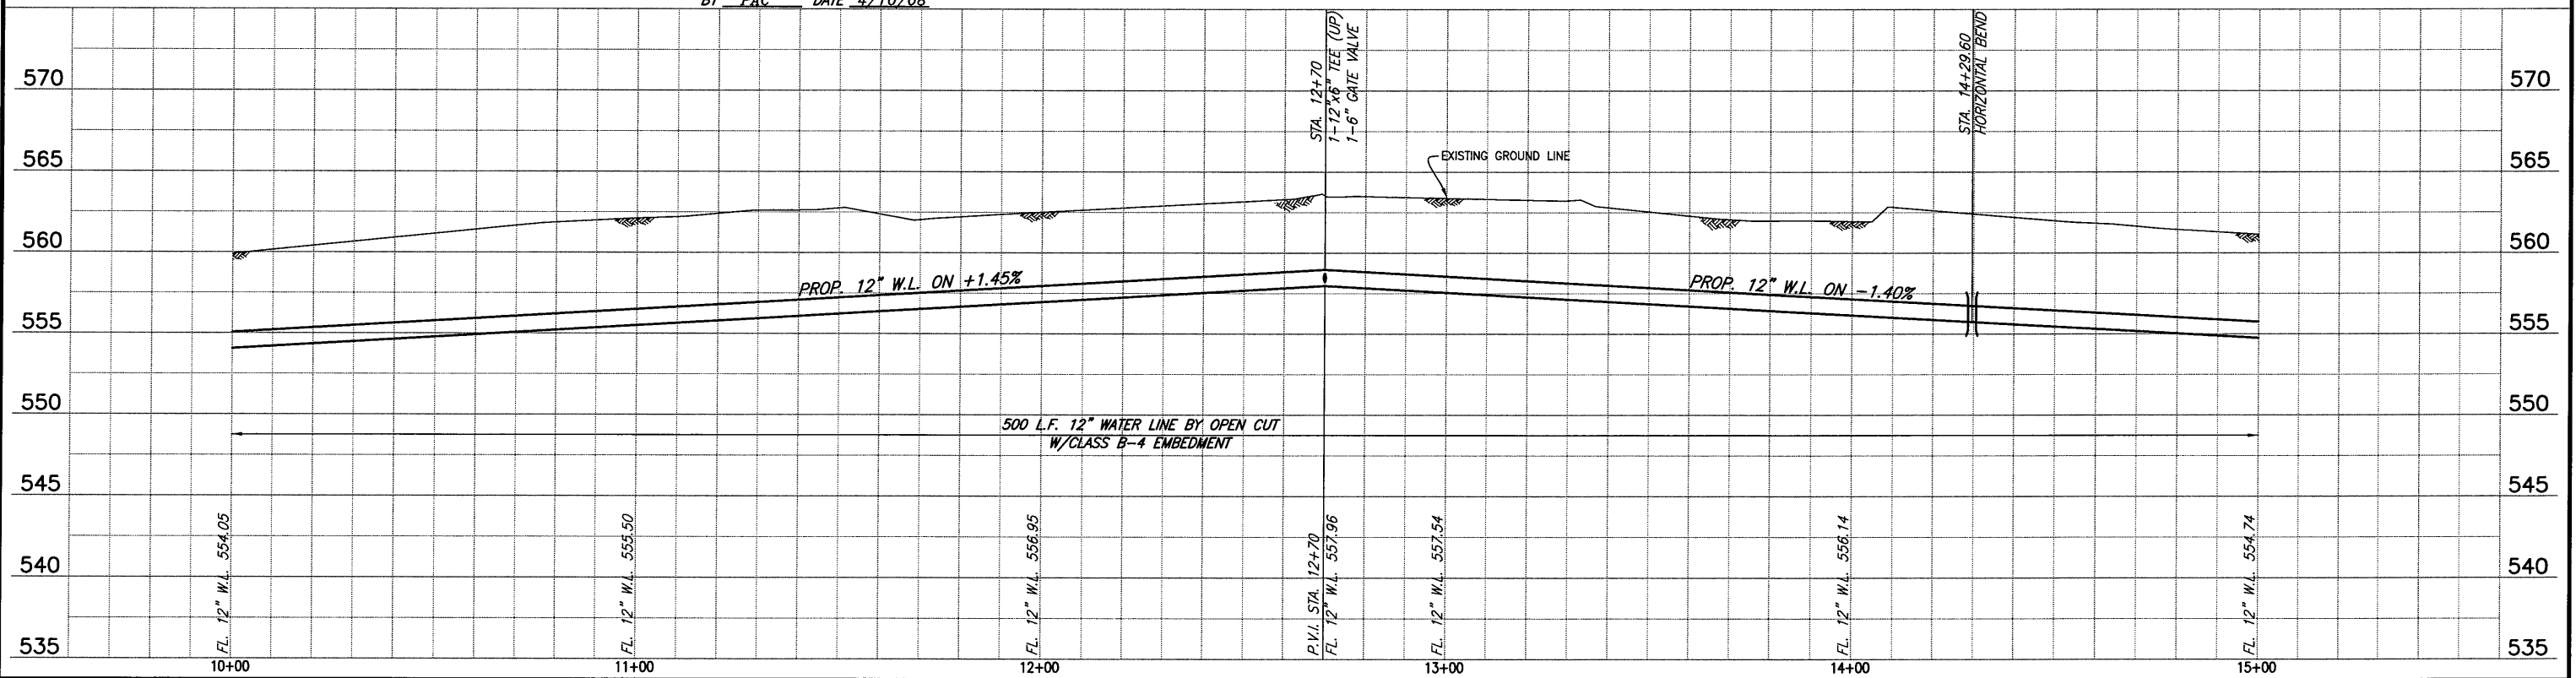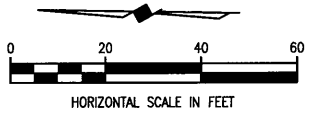

**BIRKHOFF, HENDRICKS & CONWAY, L.L.P.**  
 CONSULTING ENGINEERS  
 7502 Greenville Ave., Suite 220  
 Dallas, Texas  
 (214) 361-7900

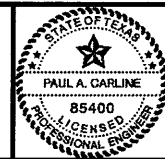

THESE DOCUMENTS ARE FOR BIDDING, CONSTRUCTION, AND PERMIT PURPOSES.  
 DATE: 6/12/07

**CITY OF ROCKWALL, TEXAS**  
 F. M. 549 WATER LINE  
 12" WATER LINE (LINE A)  
 PLAN-PROFILE  
 STA. 10+00 TO STA. 15+00

BHC PROJECT NO. 2006-150  
 June, 2007  
 SHEET NO. 4