



City of Rockwall, Texas

CONSTRUCTION PLANS
FOR
AIRPORT ROAD
FROM INDUSTRIAL BLVD TO JOHN KING BLVD

AECOM

AUGUST 2012

MAYOR
Bill Cecil


MAYOR PRO-TEM
Cliff Sevier

CITY COUNCIL
David Sweet
Mark Russo
Glen Farris
Mathew R. Scott
Margo Nielsen

CITY MANAGER
Julie Couch

CITY ENGINEER
Chuck Todd

AECOM TECHNICAL SERVICES, INC.
16000 DALLAS PARKWAY, SUITE 350
DALLAS TEXAS 75248
WWW.AECOM.COM
TBPE REG. NO. F-3580

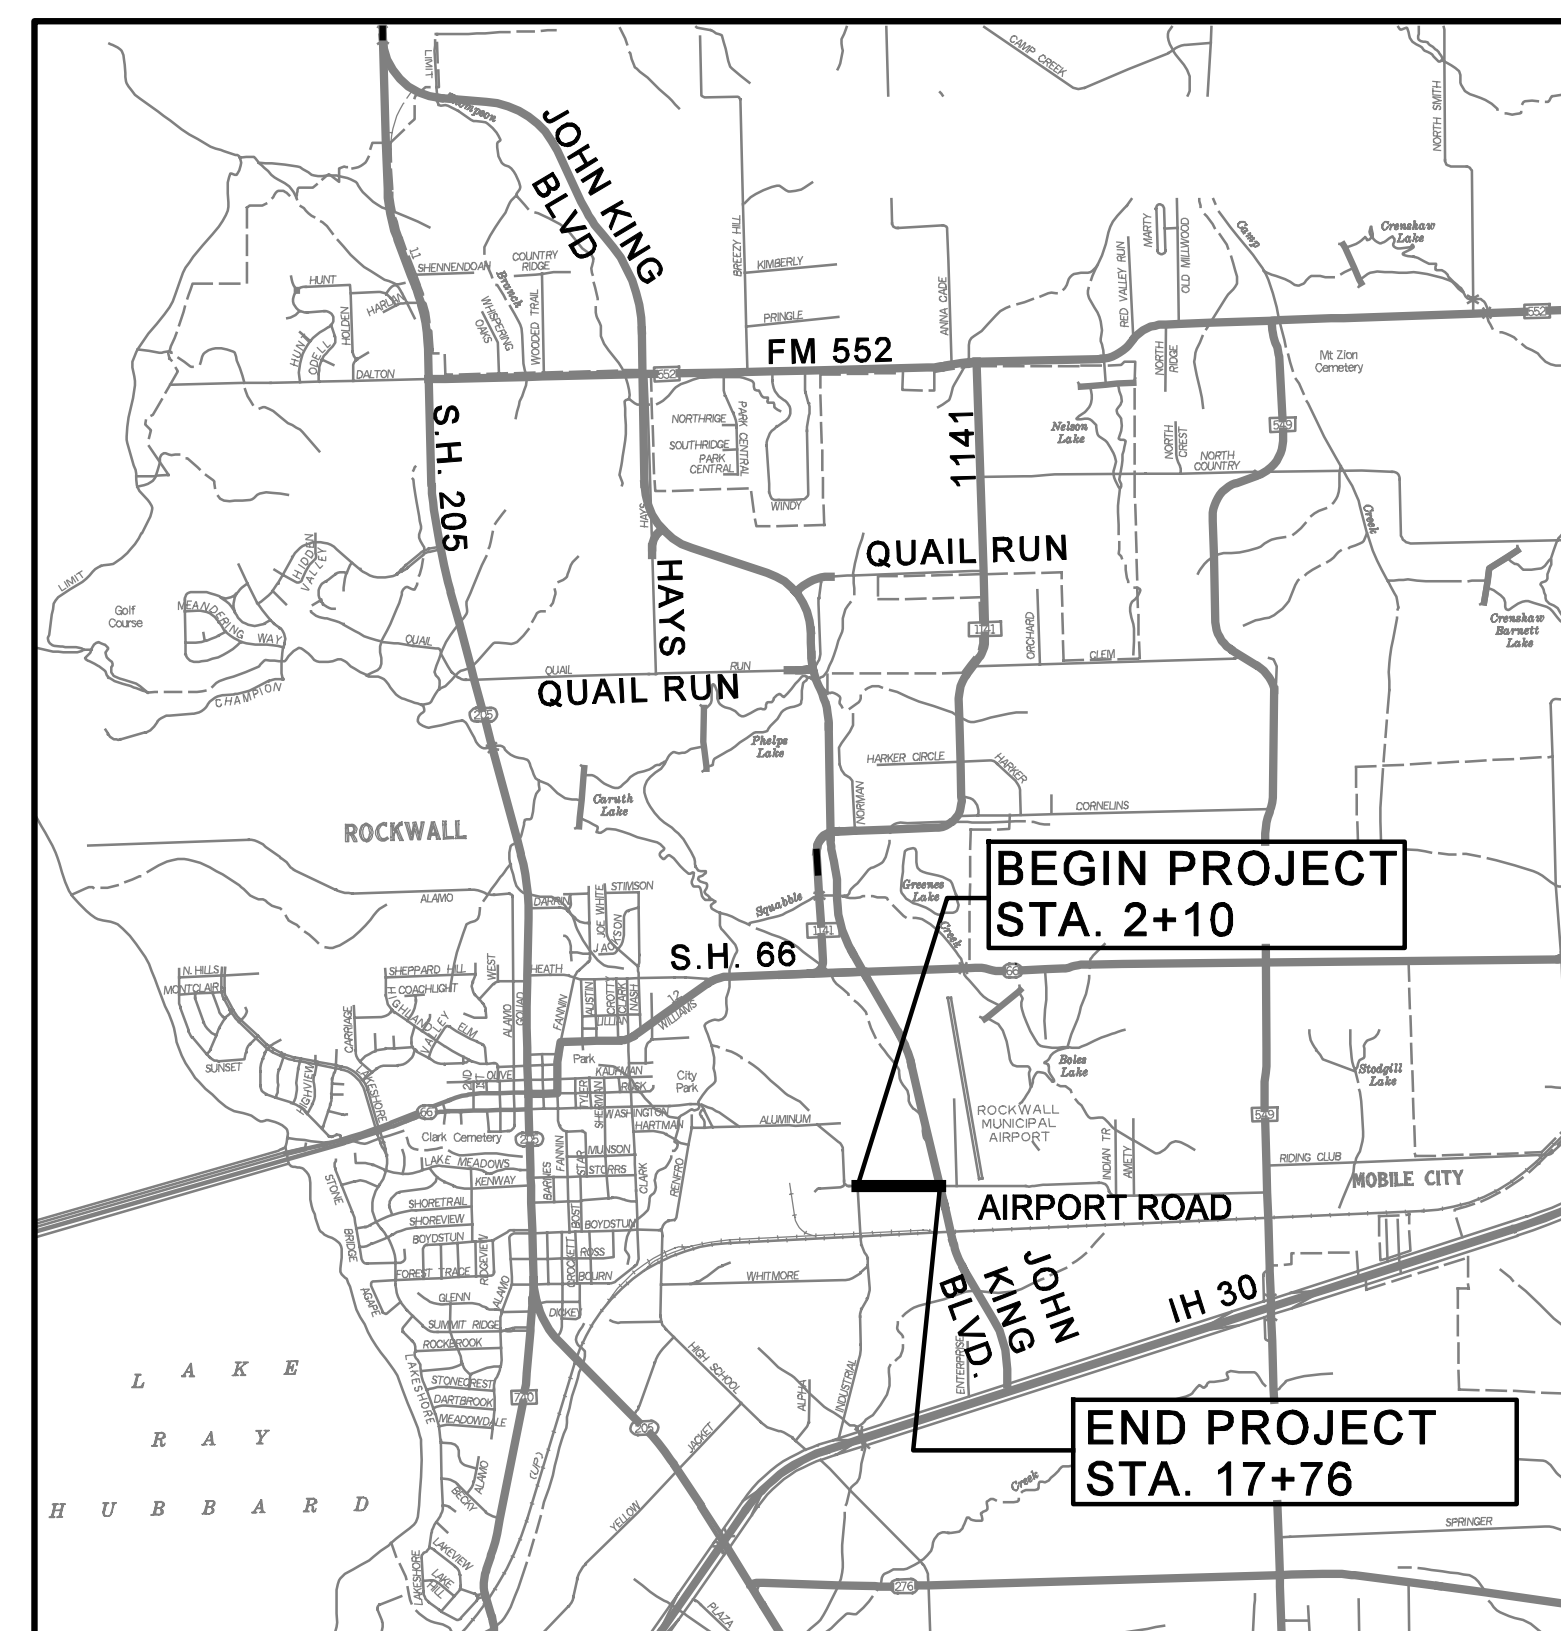

PROJECT LENGTH = 1566 LF

VICINITY MAP
SCALE: N.T.S.

RECORD DRAWING

This drawing is a compilation of the original sealed engineering drawing and modifications by addenda, change orders and information furnished by the contractor. Information shown that was provided by the contractor and others not associated with the design engineer cannot be verified for accuracy or completeness. Original sealed drawing is on file at the office of AECOM Technical Services, Inc., TBPE REG. NO. F-3580

ORIGINAL DRAWING
SEALED & SIGNED BY
Gregory G. Hooten, P.E.
TX NO. 83936

ORIGINAL DRAWING
SEALED & SIGNED BY
T.H. Gaertner, P.E.
TX NO. 37124