

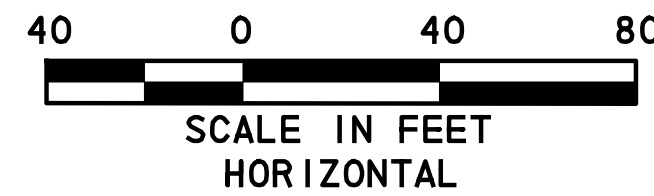


\\usda11fp002\PM\4328\Airport\Road\CADD\Sheet\Airport_Road_Record Drawings_8-3-10\08_TCF_02.dgn
8/7/2012

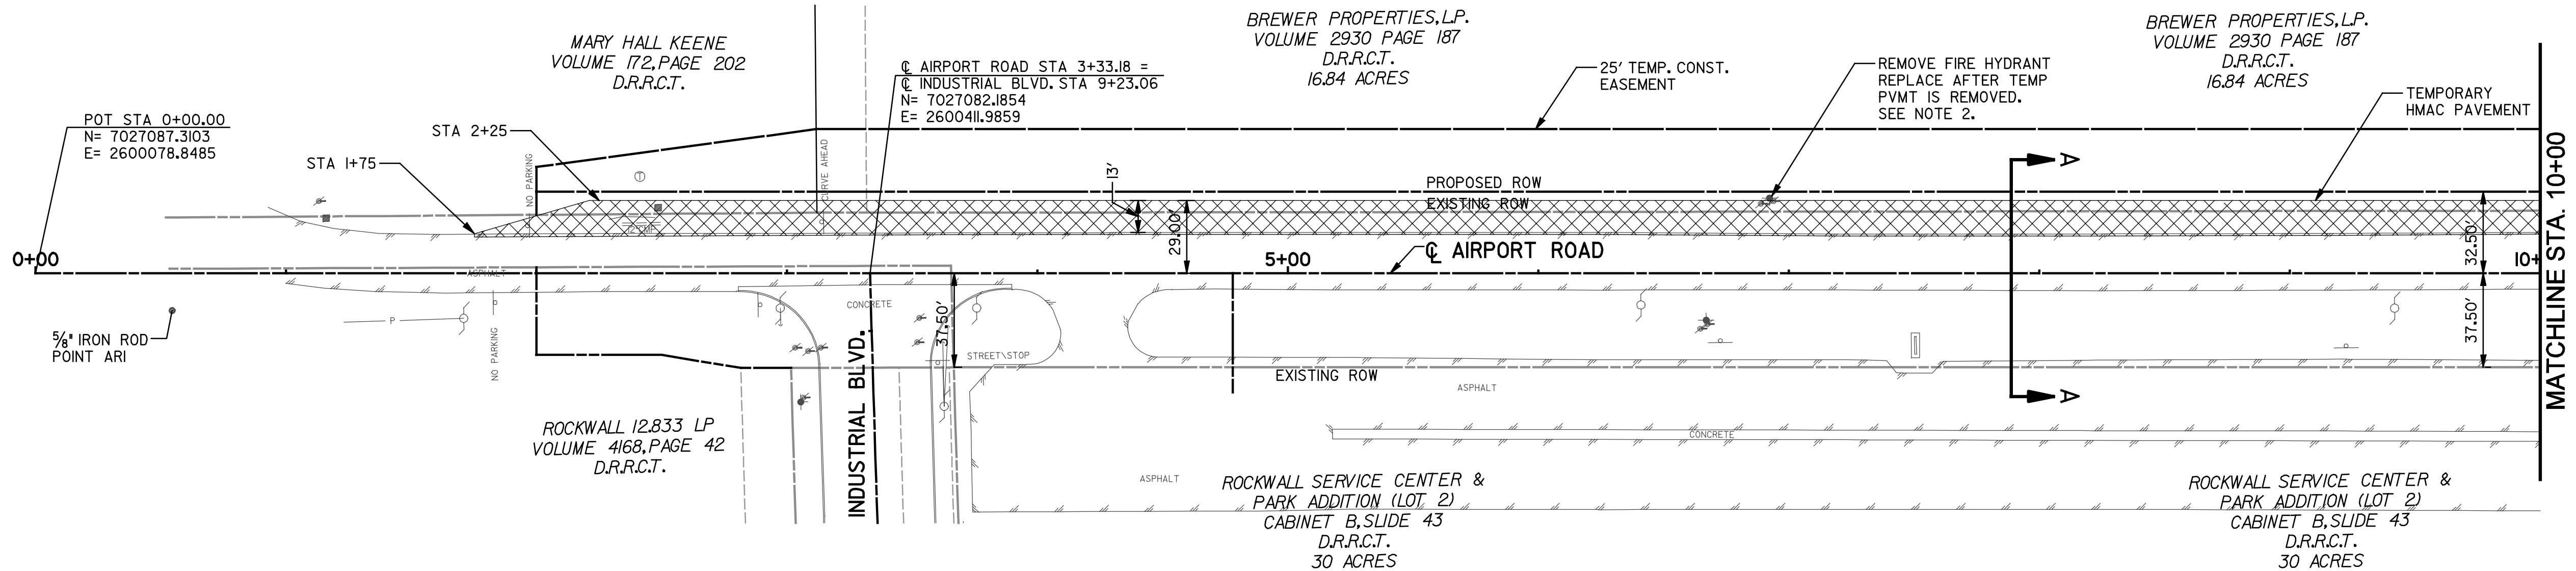

LEGEND


- TEMPORARY HMAC PVMT
- TYPE III BARRICADE
- CHANNELIZING DRUM

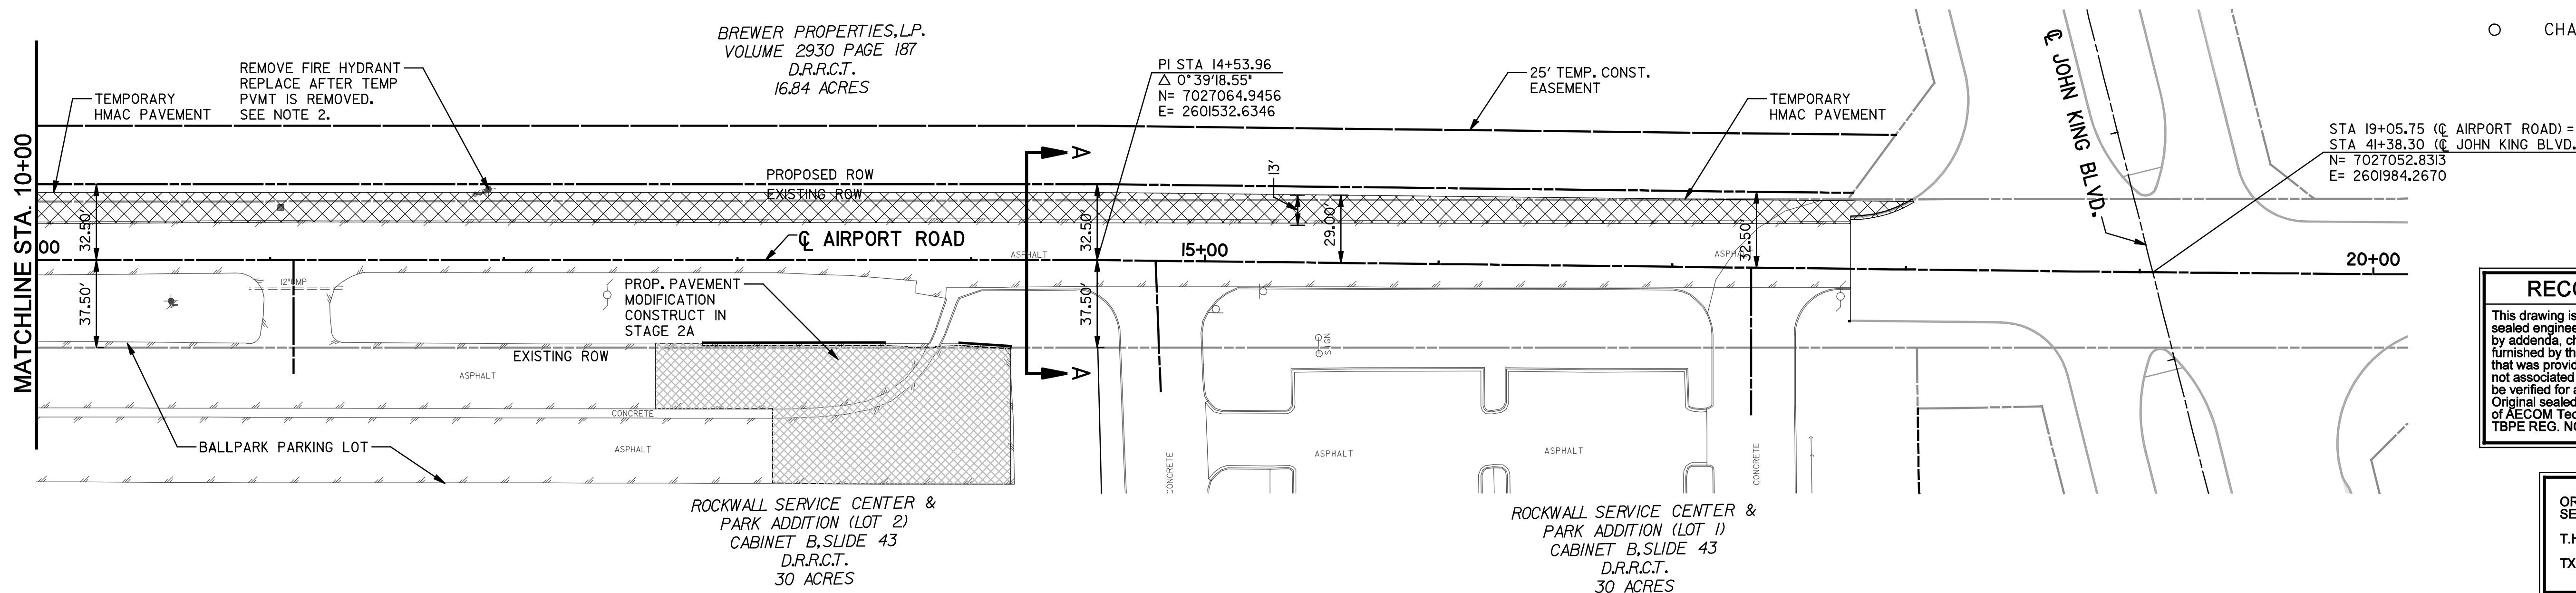

RECORD DRAWING

This drawing is a compilation of the original sealed engineering drawing and modifications by addenda, change orders and information furnished by the contractor. Information shown that was provided by the contractor and others not associated with the design engineer cannot be verified for accuracy or completeness. Original sealed drawing is on file at the office of AECOM Technical Services, Inc., TBPE REG. NO. F-3580


ORIGINAL DRAWING
SEALED & SIGNED BY
T.H. Gaertner, P.E.
TX NO. 37124

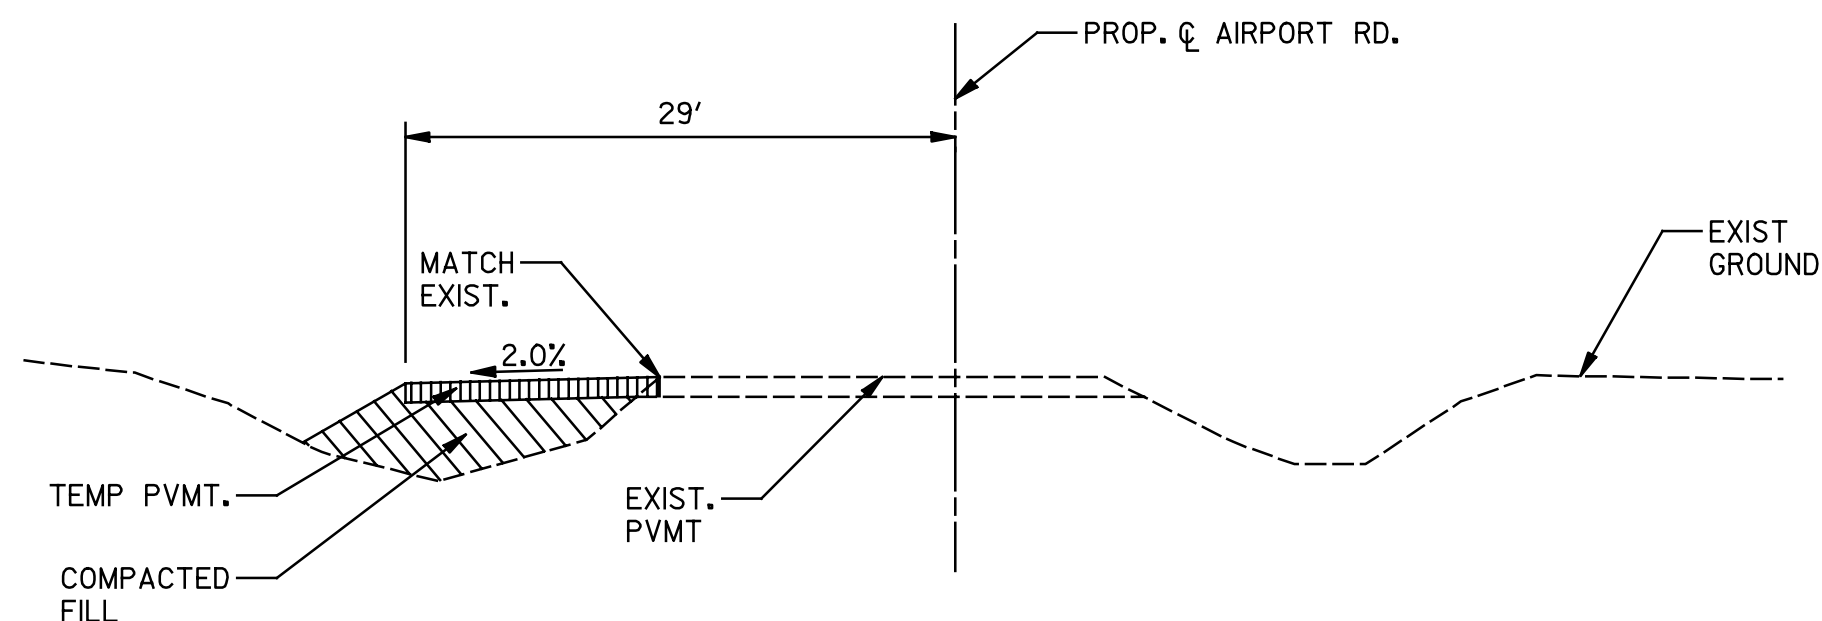

SECTION A-A

NOTES:

- PHASE 2-STAGE 1 CONSISTS OF CONSTRUCTING TEMPORARY PVMT. ALONG NORTH EDGE OF EXISTING PAVEMENT AND BALLPARK PARKING LOT MODIFICATIONS.
- TWO WAY TRAFFIC MUST BE MAINTAINED BETWEEN 4:00 PM AND 9:00 AM.
- TRAFFIC MAY BE REDUCED TO ONE LANE BETWEEN 9:00 AM AND 4:00 PM WITH THE USE OF FLAGMEN AND APPROPRIATE SIGNAGE.
- FIRE HYDRANTS ALONG NORTH R.O.W. LINE SHALL BE ROMOVED TO ALLOW CONSTRUCTION OF TEMPORARY PAVEMENT. SALVAGE ALL MATERIALS AND RE-INSTALL FIRE HYDRANT AFTER TEMP PVMT HAS BEEN REMOVED AND ROUGH GRADING FOR NEW PAVEMENT HAS BEEN COMPLETE.

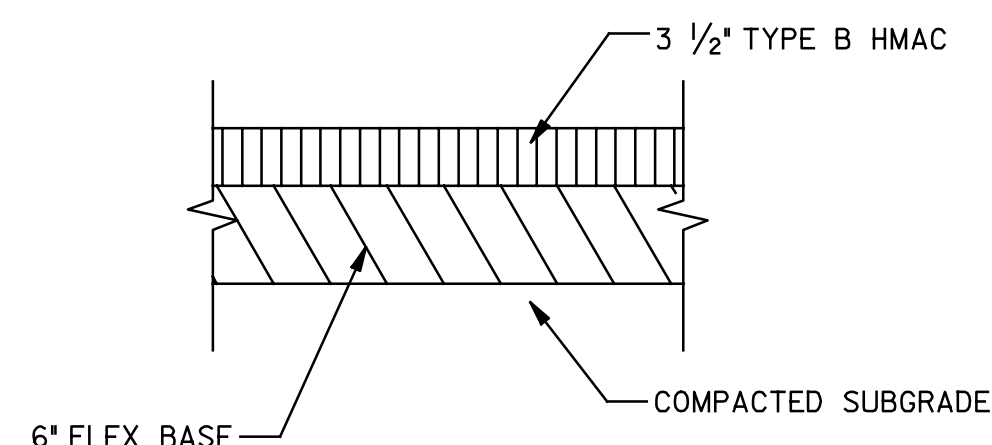

TEMPORARY HMAC PAVEMENT

NO.	REVISION	BY	DATE
AIRPORT ROAD			
PHASING & TRAFFIC CONTROL PLAN CONSTRUCTION PHASE 2 - STAGE 1			
City of Rockwall, Texas			
AECOM AECOM TECHNICAL SERVICES, INC. 16000 DALLAS PARKWAY, SUITE 350 DALLAS TEXAS 75248 WWW.AECOM.COM TBPE REG. NO. F-3580			
Unit	PW-DAL	Scales Horz AS SHOWN Vert AS SHOWN	Date 8/2/2012
Designed	THG	Checked THG	Project No. 60004153
Drawn	FG	Approved THG	Sheet 8 of 26