

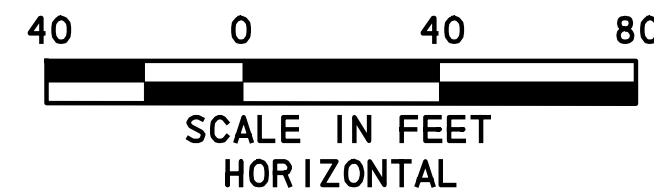


\\usda11fp002\PM\4328\Airport-Road\CADD\Sheet\Airport-Road_Record Drawings-8-3-10\11_TCF_05.dgn
8/7/2012

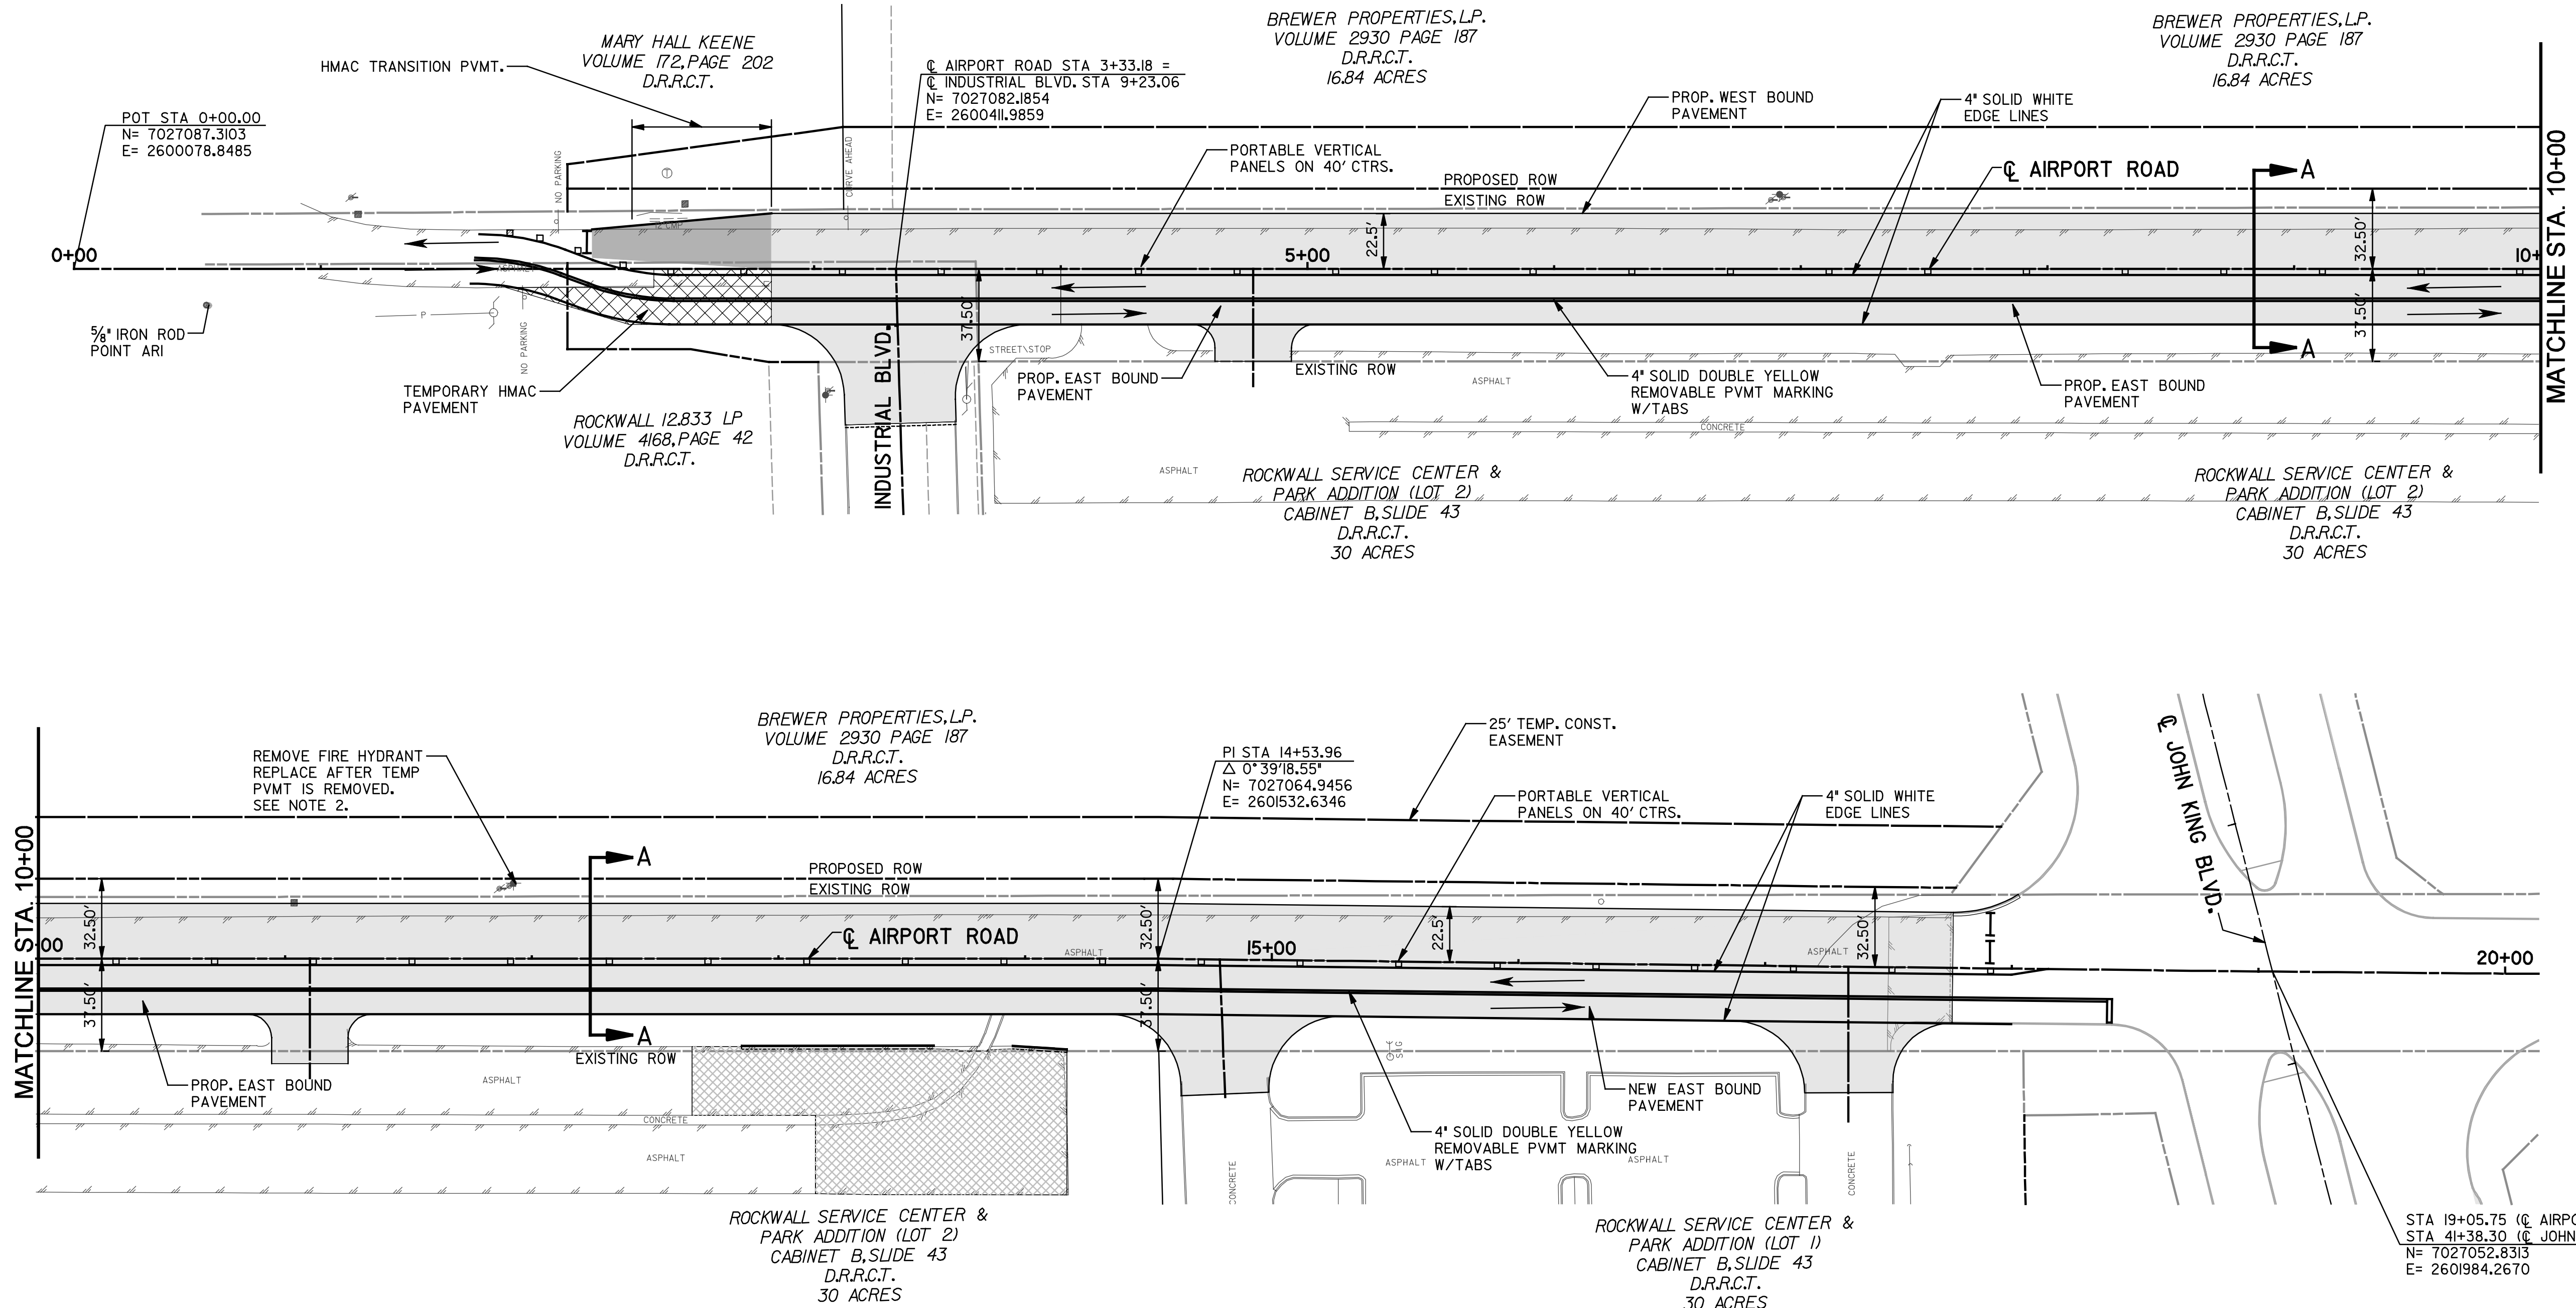

LEGEND

- STAGE I
- TEMP HMAC PVMT
- TYPE III BARRICADE
- PORTABLE VERTICAL PANELS

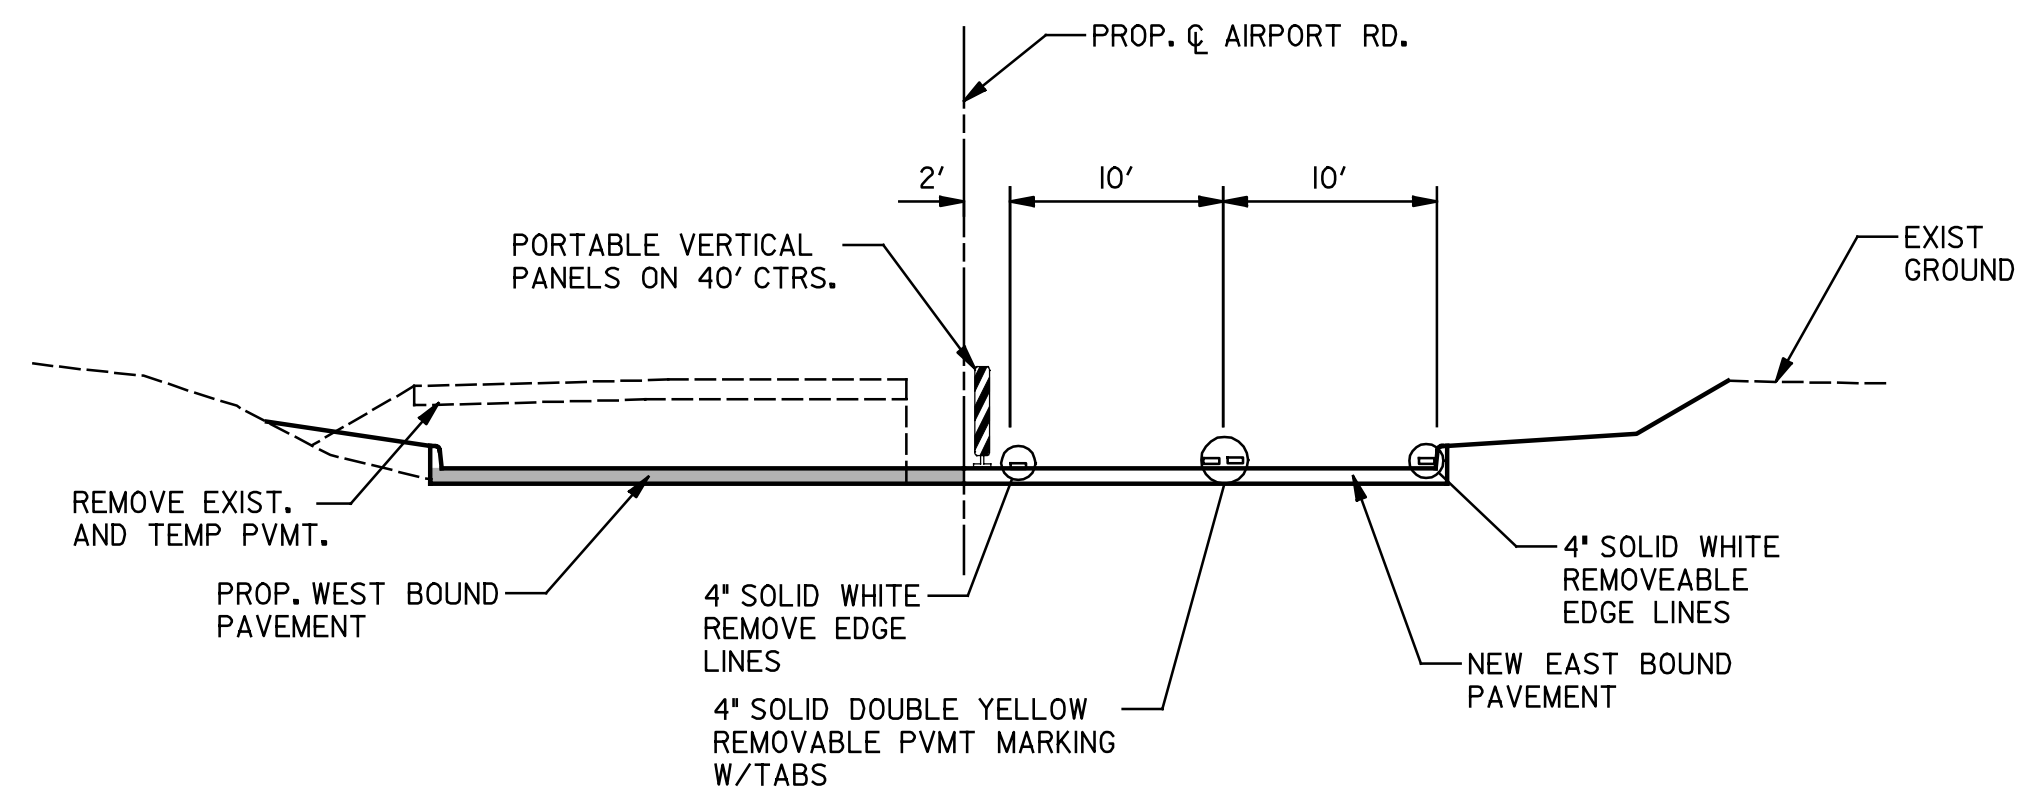

NOTES:

- PHASE 3, STAGE 1 CONSISTS OF INSTALLING TEMP. PVMT. MARKINGS, CHANNALIZING DEVICES AND SHIFTING ALL TRAFFIC OVER TO SOUTH SIDE OF PROPOSED CENTERLINE. THEN CONSTRUCT NEW WEST BOUND PAVEMENT.
- PHASE 3, STAGE 2 CONSISTS OF CONSTRUCTING REMAINDER OF HMAC TRANSITION PVMT. AT WEST END OF PROJECT AND INSTALLING PERMANENT PVMT. MARKINGS AND SIGNAGE.

RECORD DRAWING

This drawing is a compilation of the original sealed engineering drawing and modifications by addenda, change orders and information furnished by the contractor. Information shown that was provided by the contractor and others not associated with the design engineer cannot be verified for accuracy or completeness. Original sealed drawing is on file at the office of AECOM Technical Services, Inc., TBPE REG. NO. F-3580

ORIGINAL DRAWING
SEALED & SIGNED BY
T.H. Gaertner, P.E.
TX NO. 37124

AIRPORT ROAD			
PHASING & TRAFFIC CONTROL PLAN CONSTRUCTION PHASE 3			
City of Rockwall, Texas			
AECOM AECOM TECHNICAL SERVICES, INC. 16000 DALLAS PARKWAY, SUITE 350 DALLAS TEXAS 75248 WWW.AECOM.COM TBPE REG. NO. F-3580			
Unit	PW-DAL	Scales HORIZ AS SHOWN VERT AS SHOWN	Date 8/2/2012
Designed	THG	Checked THG	Project No. 60004153
Drawn	FG	Approved THG	Sheet 11 of 26